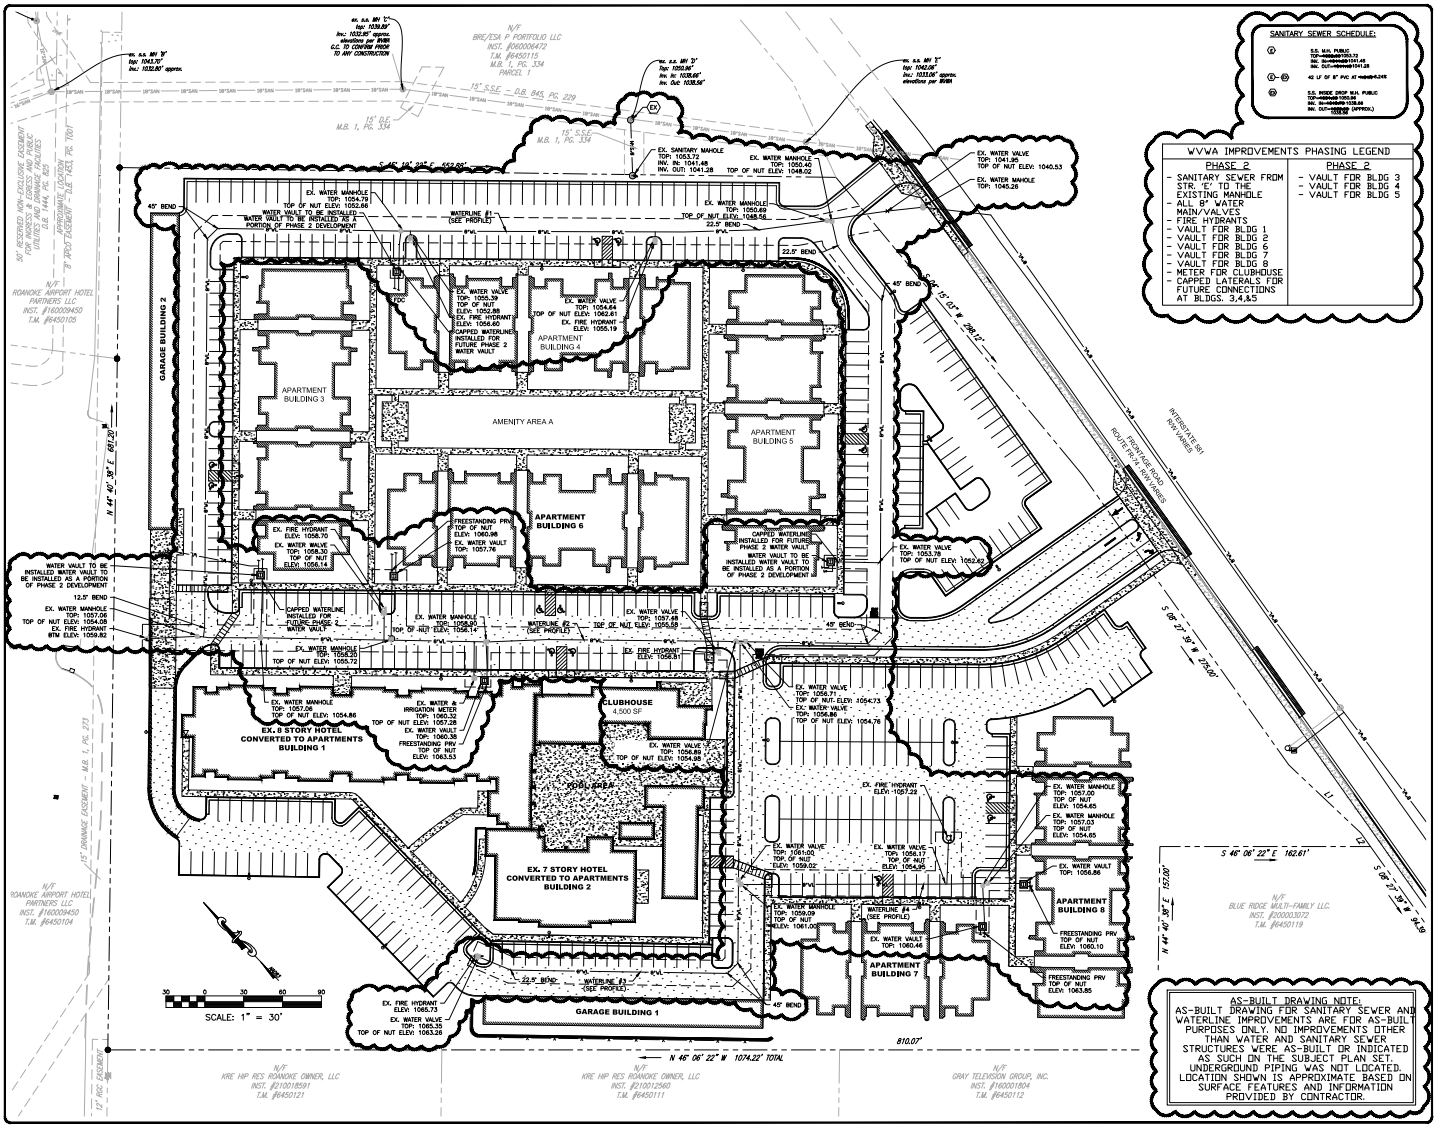

AS-BUILT DRAWING NOTE:
AS-BUILT DRAWING FOR SANITARY SEWER AND WATERLINE IMPROVEMENTS ARE FOR AS-BUILT PURPOSES ONLY. NO IMPROVEMENTS OTHER THAN WATER AND SANITARY SEWER STRUCTURES WERE AS-BUILT OR INDICATED AS SUCH ON THE SUBJECT PLAN SET. UNDERGROUND PIPING WAS NOT LOCATED. LOCATION SHOWN IS APPROXIMATE BASED ON SURFACE FEATURES AND INFORMATION PROVIDED BY CONTRACTOR.

BALZER & ASSOCIATES
PLANNERS / ARCHITECTS ENGINEERS / SURVEYORS
Roanoke / Richmond
New River Valley / Staunton
Harrisonburg / Lynchburg
www.balzer.cc
1208 Corporate Circle
Roanoke, VA 24018
540.772.2688

CERTIFICATE OF TITLE
CHRISTOPHER P. BURNS
Lic. No. 47058
09/19/2022
PROFESSIONAL ENGINEER

THE VIEW AT BLUE RIDGE COMMONS

2801 HERSHBERGER ROAD NW

WATER & SANITARY SEWER AS-BUILT

CITY OF ROANOKE, VIRGINIA

DRAWN BY	EJP
DESIGNED BY	EJP
CHECKED BY	CPB
DATE	09/19/2022
SCALE	1"=30'
REVISIONS	

AS-BUILT

PROJECT NO. 04200035.00