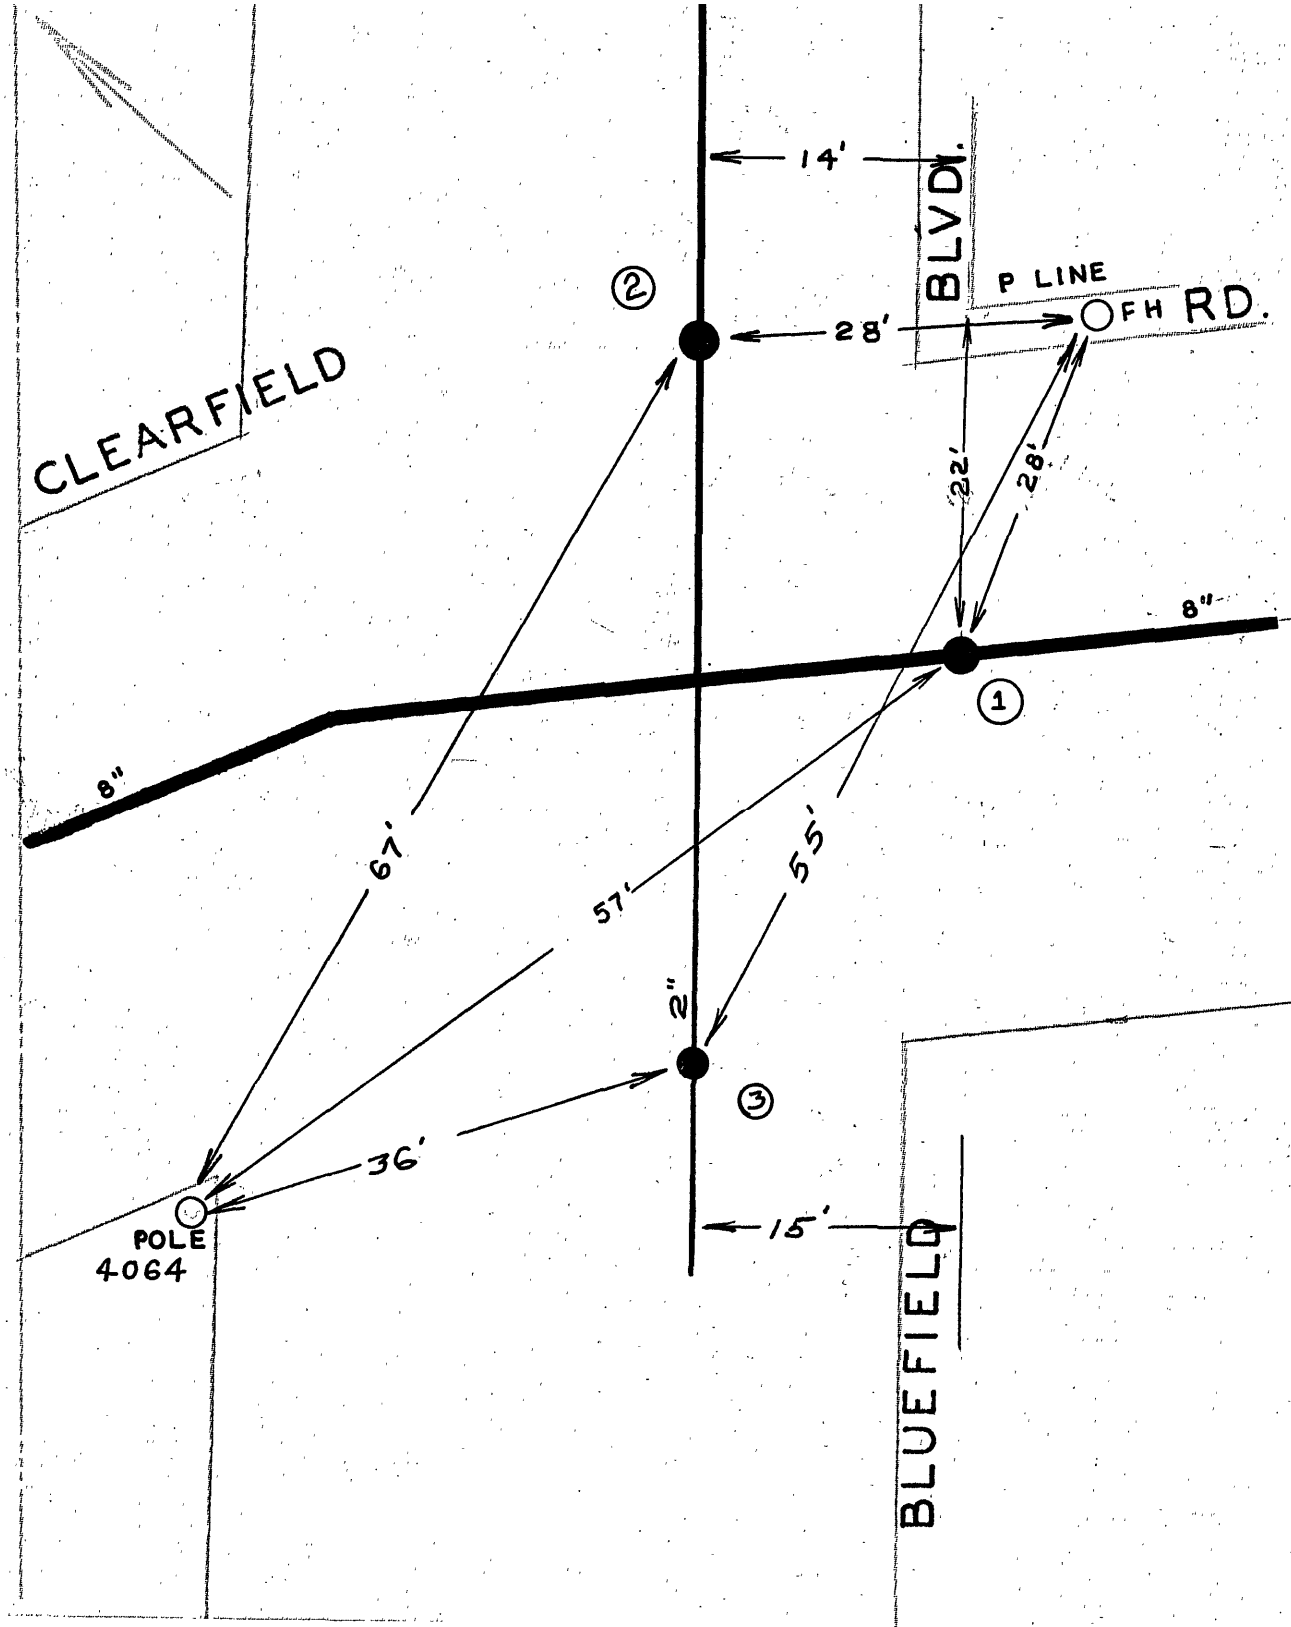

DATE	NO.	SIZE	MAKE	DECM.	TURNS
1950	1	8"	DARLING	R	27
3-54	2	2"	DARLING	R	7
8-56	3	2"	DARLING	R	7
	1	0	SPL		
	2	0	EPL		
	3	0	S.E.P.L.		

CITY OF ROANOKE—WATER DEPT'
VALVE DIAGRAM

BLUEFIELD BLVD. &
CLEARFIELD ROAD
S.W.

SEC. MAP 136

DATE [illegible] PAGE NO. S.W.584