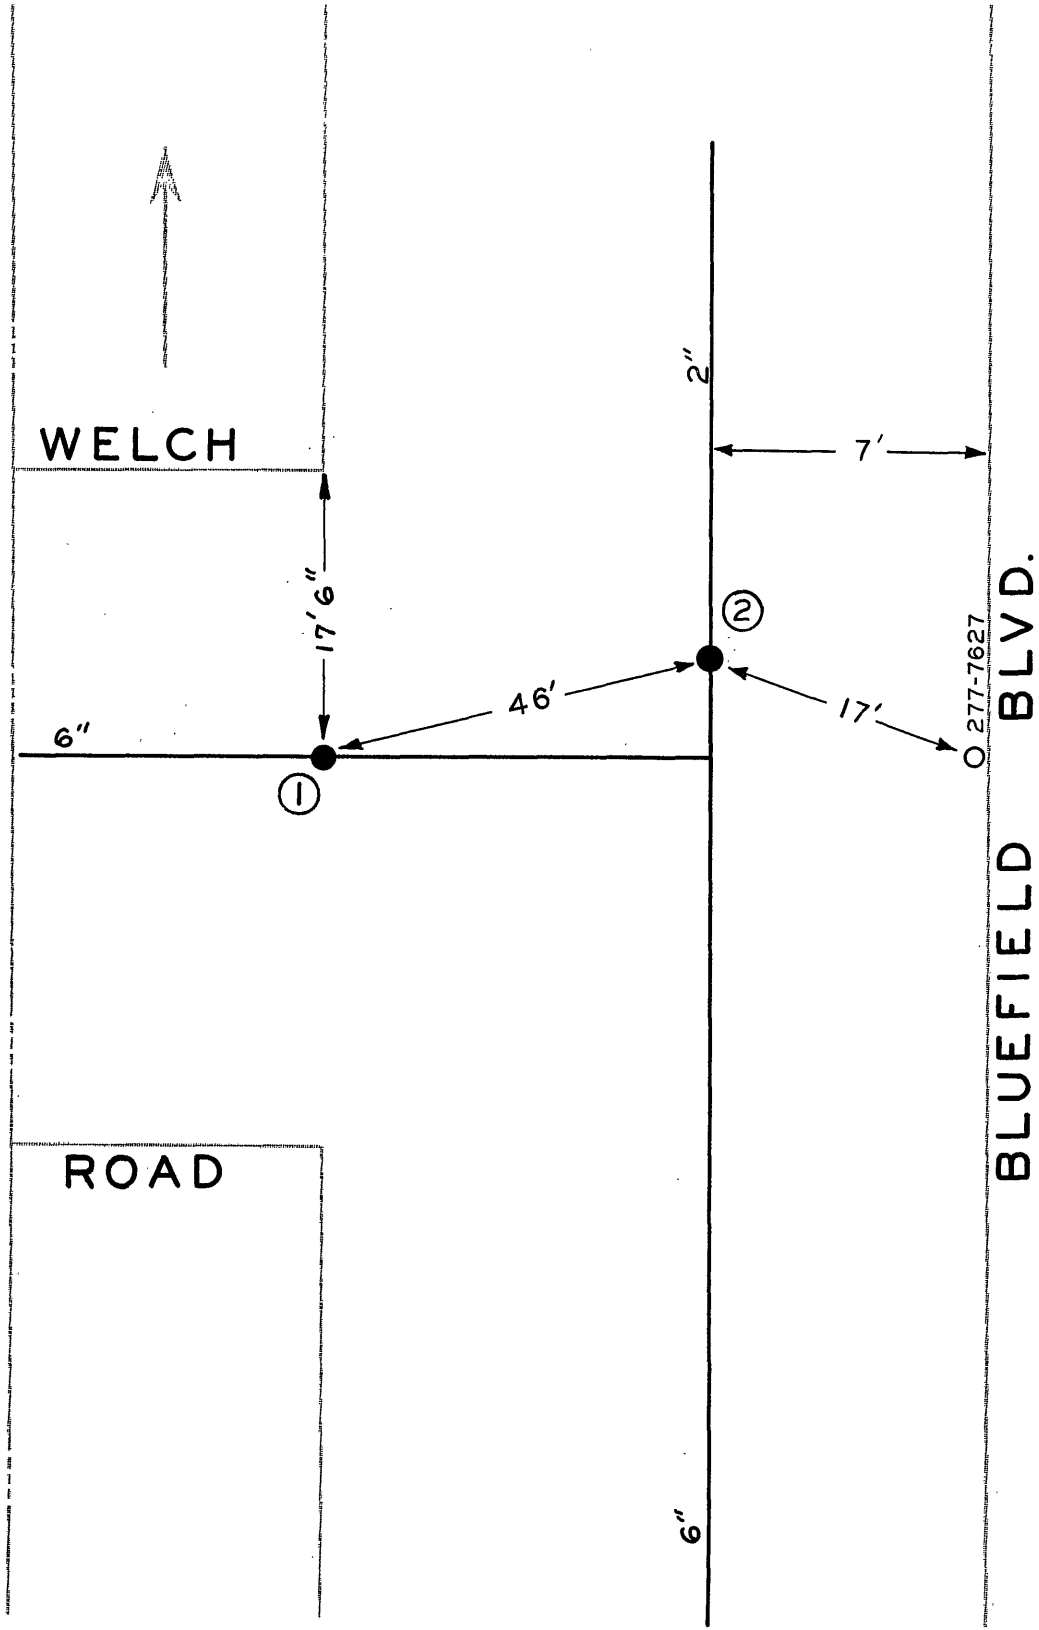

DATE	NO.	SIZE	MAKE	OPEN	TURNS
'59	1	6"	MUELLER	R	
1-69	2	2"	MUELLER	R	
	1	0	WPL		
	2	0	NPL		

CITY OF ROANOKE—WATER DEP'T

VALVE DIAGRAM

BLUEFIELD BLVD. &

WELCH ROAD S.W.

SEC. MAP 136

DATE PAGE NO.