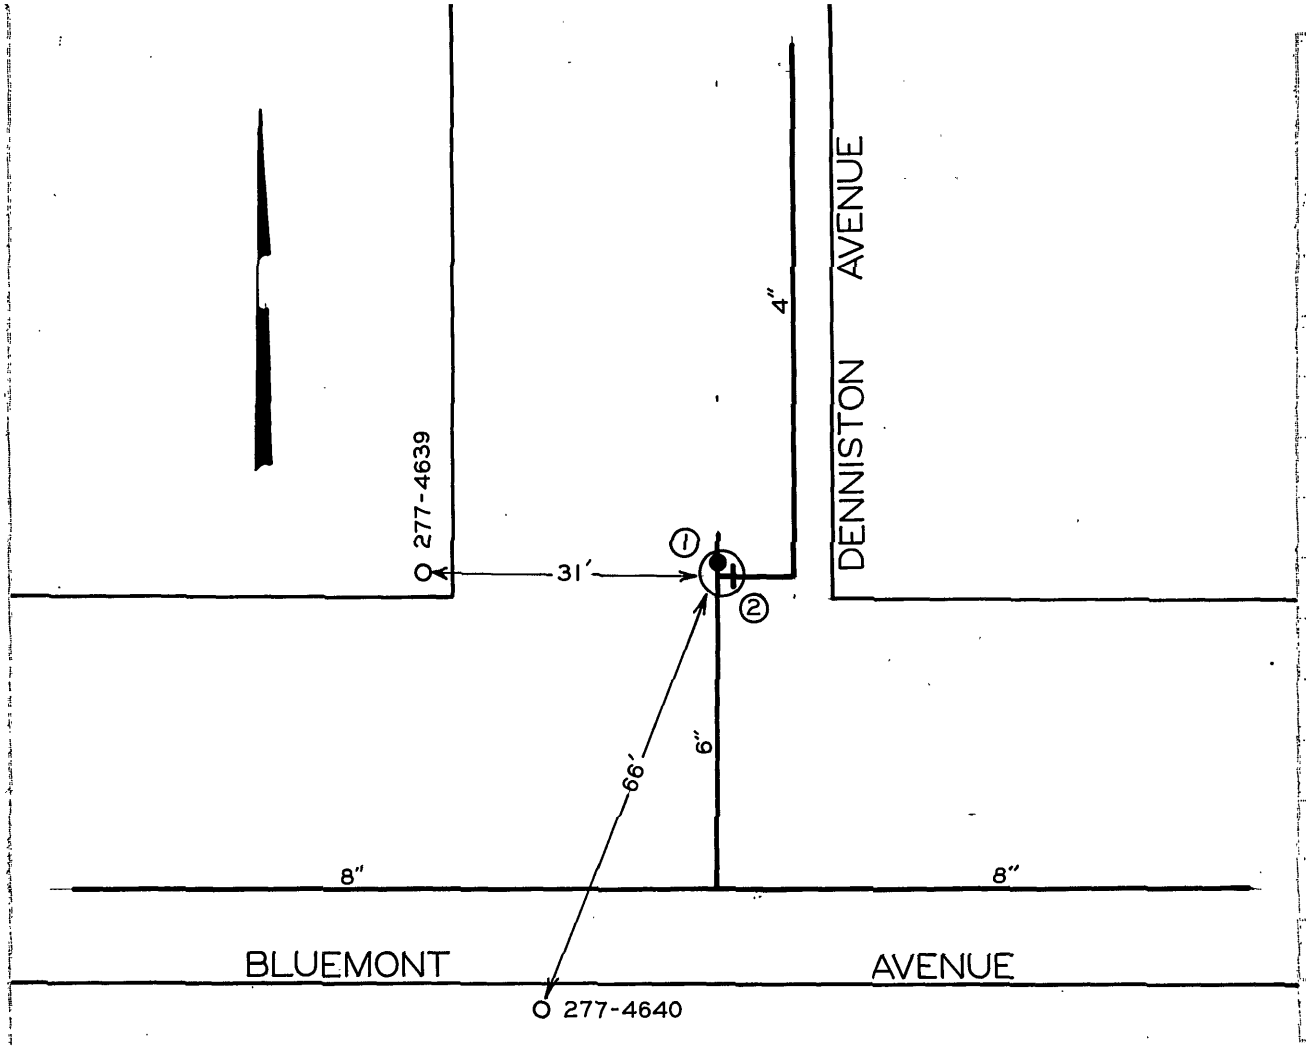

DATE	NO.	SIZE	MAKE	OPEN	TURNS
74	1	6"	MUELLER	R	
74	2	2"	MISC.	L	

CITY OF ROANOKE—WATER DEPT.

VALVE DIAGRAM

BLUEMONT AVENUE &

DENNISTON AVENUE S.W.

SEC. NO. 133

DATE PAGE NO.