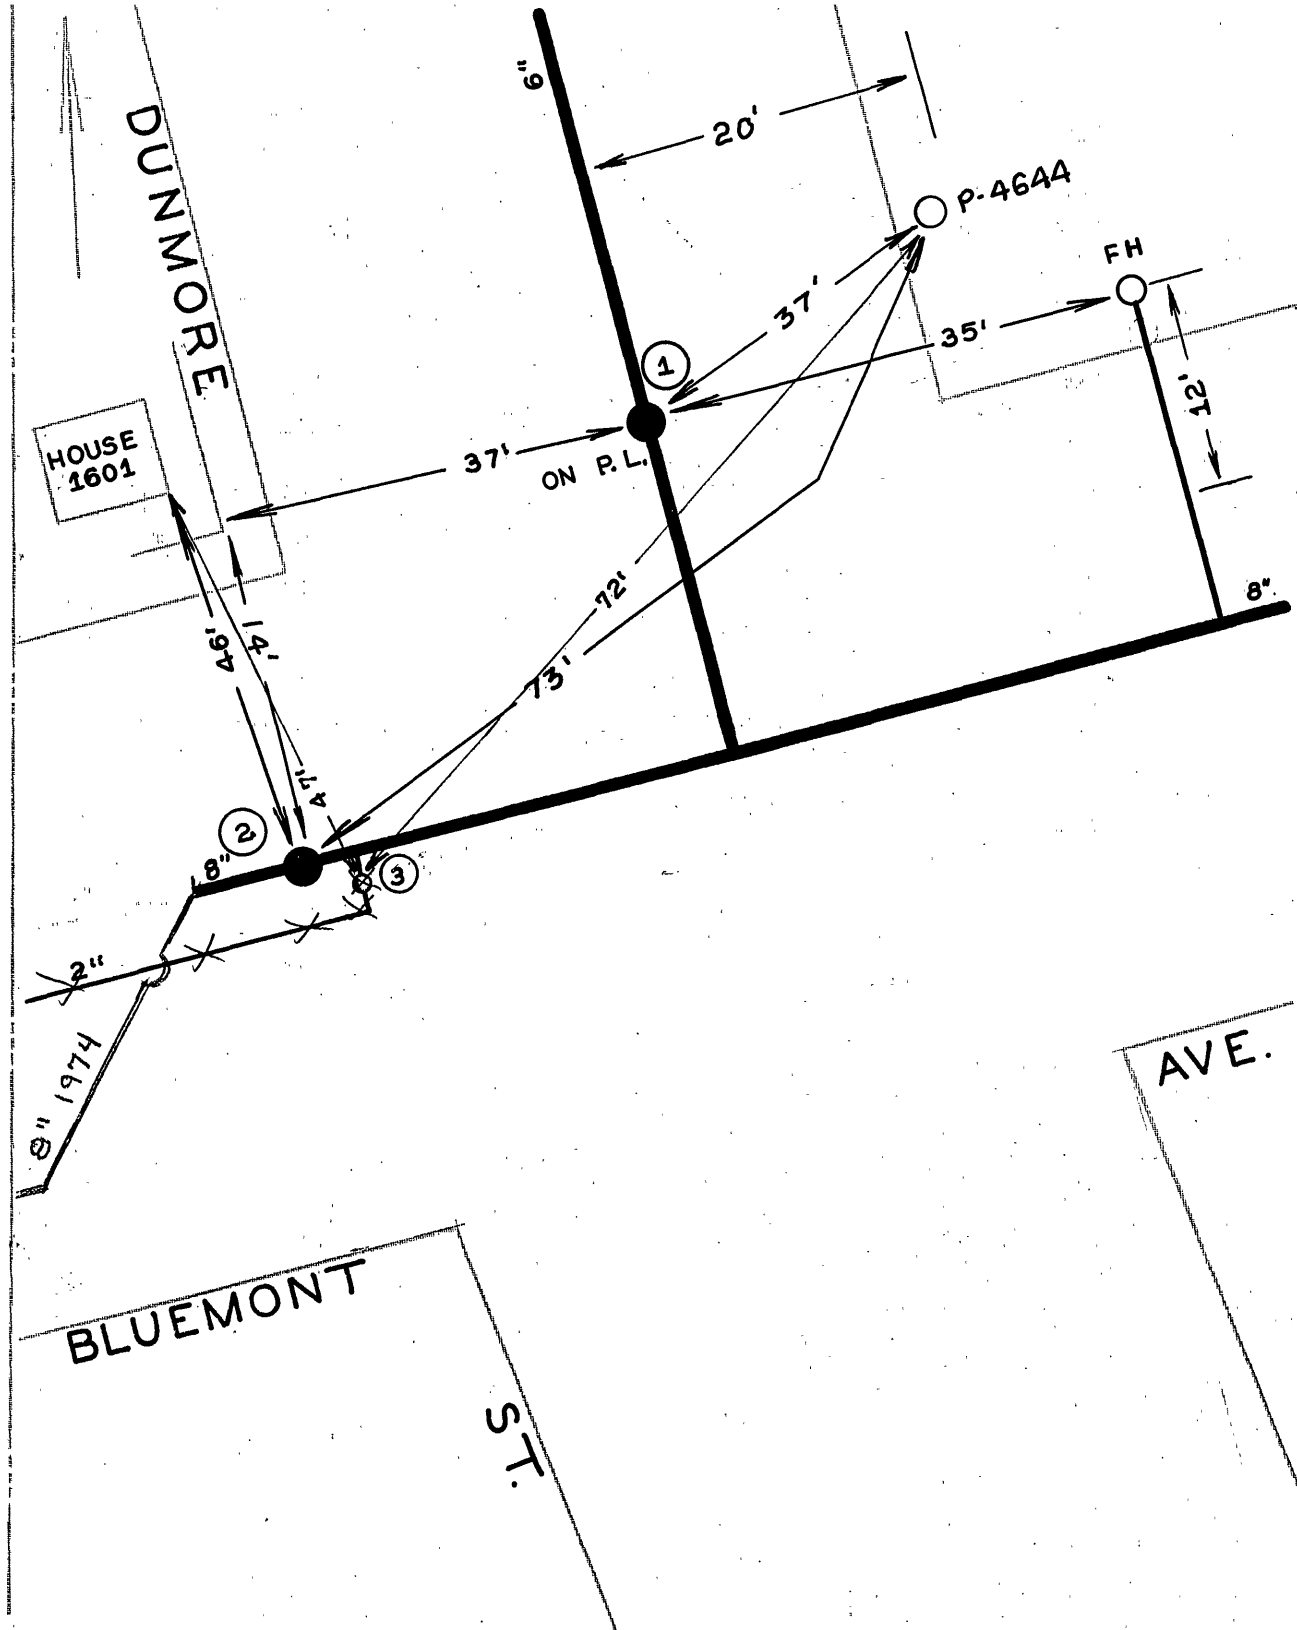

DATE	NO.	SIZE	MAKE	OPEN	TURNS
1950	1	6"	DARLING	R	20
1950	2	8"	DARLING	R	27
~~8-63~~	~~3~~	~~2"~~	~~CRANE~~	~~L~~	~~8½~~

CITY OF ROANOKE—WATER DEP'T

VALVE DIAGRAM

BLUEMONT AVENUE &

DUNMORE STREET S.W.

SEC. MAP 123

DATE

PAGE NO. SW593