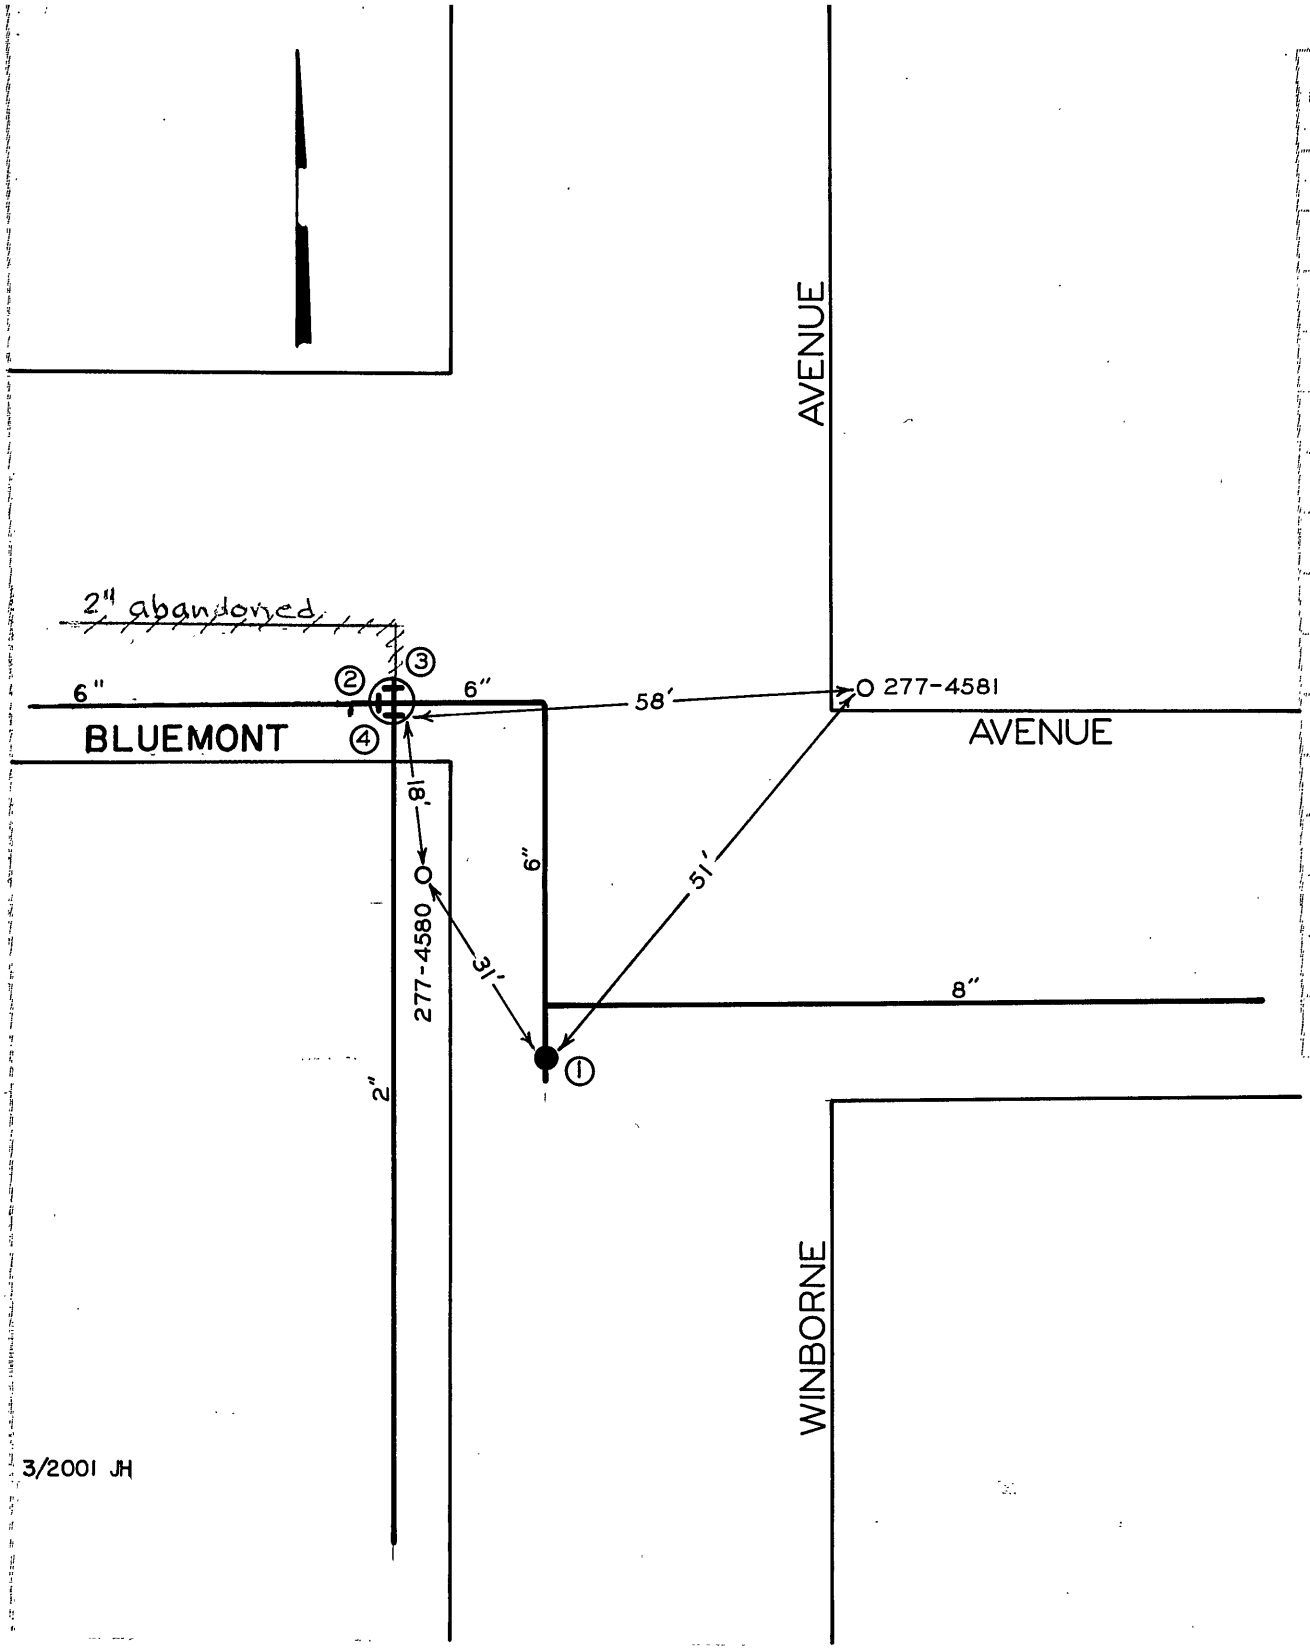

DATE	NO.	SIZE	NAME	VIEW	TURNS
74	1	6"	MUELLER	R	
74	2	6"	MUELLER	R	
74	3	2"	MISC.	L	
74	4	2"	MISC.	L	


VALVE DIAGRAM

BLUEMONT AVENUE &

WINBORNE STREET

SEC. MAP 133 S.W.

DATE PAGE NO.