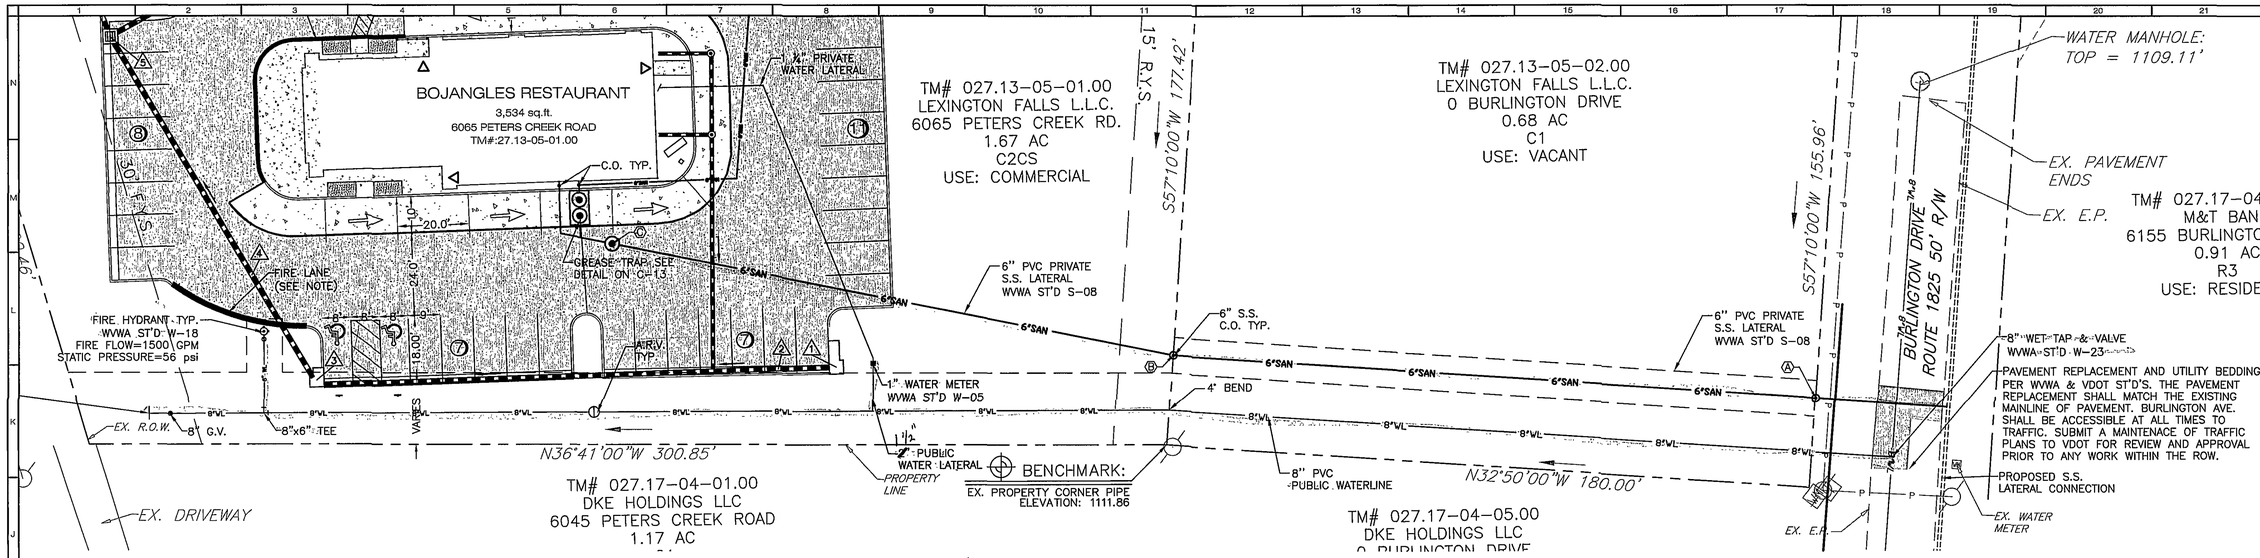

WATERLINE/SANITARY SEWER UTILITIES

SCALE: 1"=20'

Pressure tested water main 6/10/08
Bacteria samples passed 6/13/08

WATERLINE PROFILE

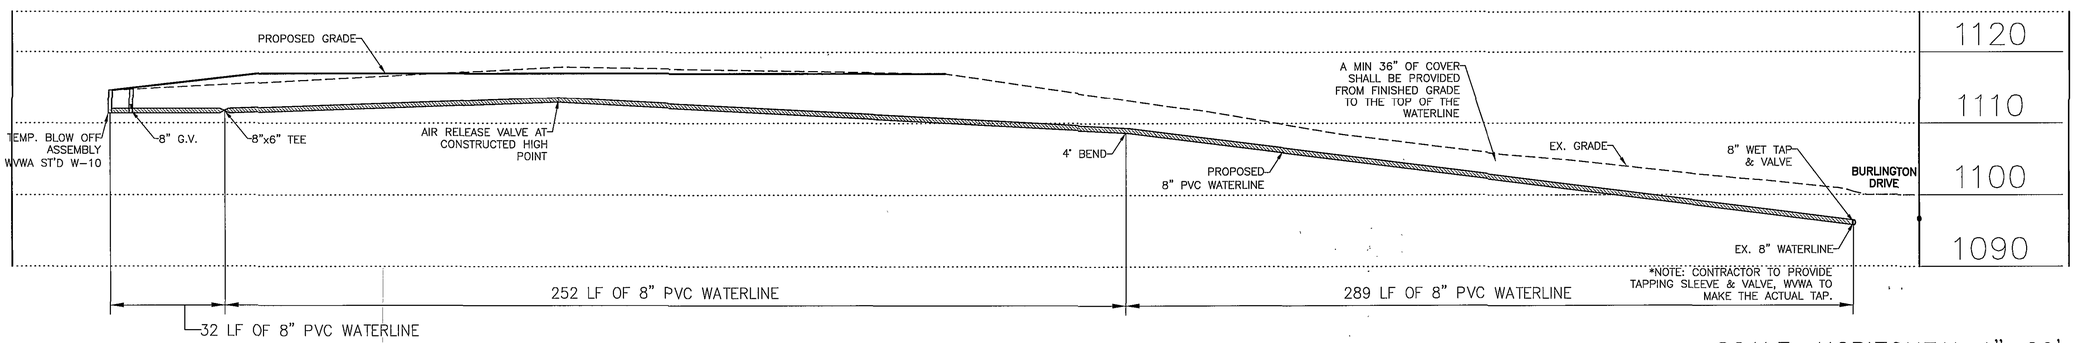

SCALE: HORIZONTAL 1"=20'
VERTICAL 1"=10'

SANITARY SEWER STRUCTURE SCHEDULE	
A	CLEAN OUT TYP. TOP=1100.91 INV=1094.8
B	CLEAN OUT TYP. TOP=1111.53 INV=1103.52
D	CLEAN OUT TYP. TOP=1116.75 INV=1111.48

SANITARY SEWER PROFILE

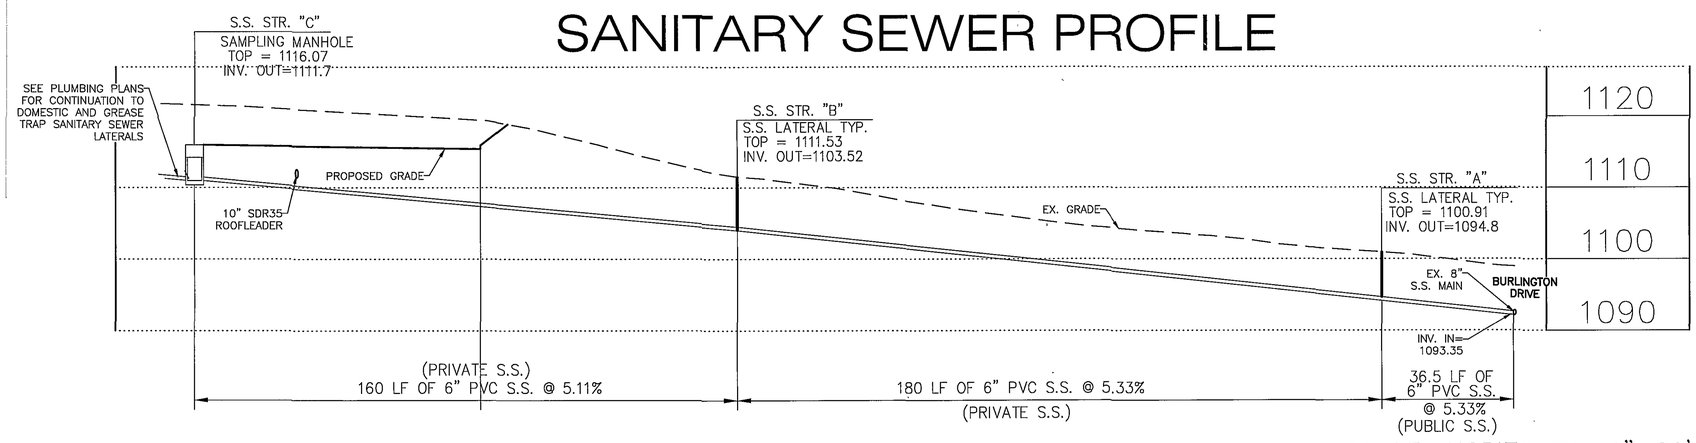

SCALE: HORIZONTAL 1"=20'
VERTICAL 1"=10'

EX. SANITARY MANHOLES:

S.S. MANHOLE TO EAST OF PROPOSED LATERAL TIE IN
TOP=1113.20
INV IN=1101.28
INV. OUT=1101.12
SHELF=1101.93

S.S. MANHOLE TO WEST OF PROPOSED LATERAL TIE IN
TOP=1083.90
INV IN=1075.21
INV. OUT=1074.91
SHELF=1075.80

APPROVED

COMMONWEALTH OF VIRGINIA
ROGER I. STURGILL
No. 033058
PROFESSIONAL ENGINEER

BALZER AND ASSOCIATES INC.
REFLECTING TOMORROW
www.balzer.cc
PLANNERS • ARCHITECTS
ENGINEERS • SURVEYORS

1208 Corporate Circle
Roanoke, Virginia 24018
Phone: 540/772-9580
FAX: 540/772-8050

601 Branchway Road
Richmond, Virginia 23236
Phone. 804/794-0571
FAX: 804/794-2635

880 Technology Park Drive
Suite 200
Glen Allen, Virginia 23059
Phone. 804/553-0132
FAX: 804/553-0133

448 Peppers Ferry Road, NW
Christiansburg, Virginia 24073
Phone. 540/381-4290
FAX. 540/381-4291

1561 Commerce Road
Suite 401
Verona, Virginia 24482
Phone: 540/248-3220
FAX: 540/248-3221

BOJANGLES RESTAURANT
WATERLINE PLAN/PROFILE
HOLLINS
COUNTY OF ROANOKE, VIRGINIA

DRAWN BY: BTC
DESIGNED BY: BTC
CHECKED BY: RIS
DATE: 2-15-07
REVISIONS:
4-18-07
6-5-07
6-29-07

AS - BUILT
06/13/2008

SCALE: 1"=20'

SHEET NO. C-11

JOB NO. R0600307.00