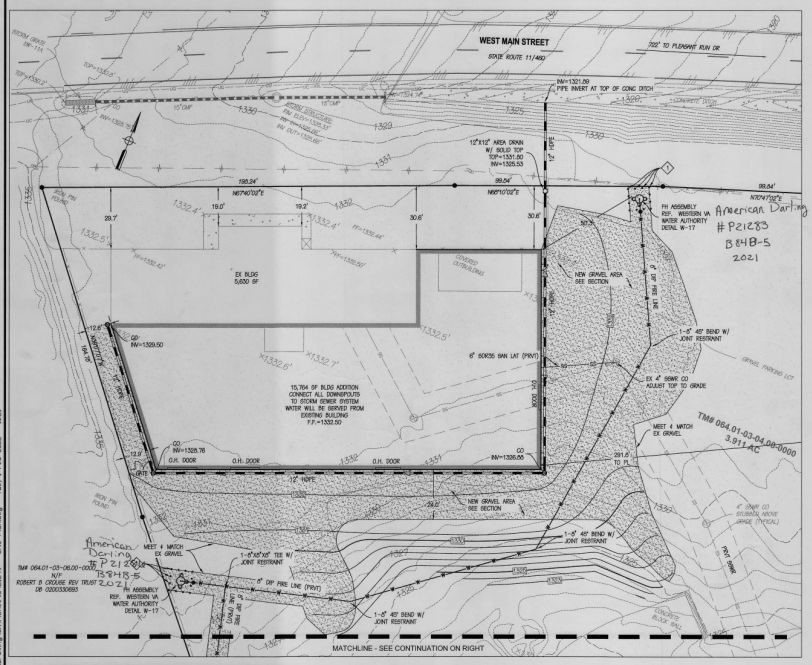

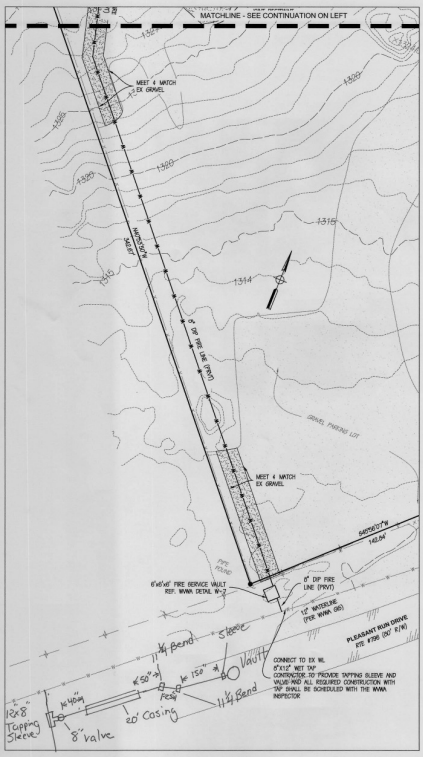

KEYNOTES

1. BOLLARD (SEE DETAIL), PER ROANOKE COUNTY REQUIREMENTS. BOLLARDS AROUND PROPOSED FIRE HYDRANTS SHALL BE AT LEAST 3' ABOVE GROUND, SPACED NO MORE THAN 4' APART, AND LOCATED AT LEAST 4' FROM THE HYDRANT.

NOTES:

1. FIRE LINES WILL BE EVALUATED ONSITE WITH THE CONTRACTOR TO DETERMINE IF NEEDED.
2. KNOX LOCKING KEY BOX SHALL BE INSTALLED. CONTRACTOR SHALL COORDINATE LOCATION WITH BRIAN SIMMONS OF ROANOKE COUNTY (540) 777-5721.
3. THE BARREL THE PROPOSED FIRE HYDRANTS SHALL BE PAINTED WHITE AND THE TOPS SHALL BE PAINTED IN ACCORDANCE WITH THE FLOW THAT HYDRANT IS CAPABLE OF PROVIDING. CONTRACTOR SHALL COORDINATE WITH BRIAN SIMMONS OF ROANOKE COUNTY (540) 777-5721.

PERKINS & ORRISON
ENGINEERS ▲ PLANNERS ▲ SURVEYORS

317 BROOK PARK PL, FOREST, VIRGINIA 24551
PHONE: 434-525-5566 FAX: 434-525-5566
EMAIL: pno@perkins-orrison.com

17 W. NELSON STREET LEXINGTON, VIRGINIA 24450
PHONE: 540-464-6501 FAX: 540-464-5026
EMAIL: pno@perkins-orrison.com

CONSULTANTS

SEAL:

COMMONWEALTH OF VIRGINIA
RUSSELL H. ORRISON
Lic. No. 031849
02/01/2022
PROFESSIONAL ENGINEER

JOB:

BOONE TRACTOR ADDITION
CATAWBA MAGISTERIAL DISTRICT
ROANOKE COUNTY, VIRGINIA

CLIENT:

BOONE TRACTOR

MARK	DATE	DESCRIPTION
1	02/01/2022	OWNER CHANGES/COUNTY COMMENT

ISSUE:	10/21/2021
CONTOUR INTERVAL:	2'
DESIGNED BY:	RHO
DRAWN BY:	BDB/FWS
CHECKED BY:	RHO

SHEET TITLE

SITE & UTILITY PLAN

GRAPHIC SCALE
0 20 40
1"=20'

SHEET: C200

ANDERSON PROJECT #

JOB NO.: 21249

SHEET NO.: 4 of 12

APPROVED, 5/25/2022

ID - P:\2021\21249 - Boone Tractor\Drawing\Out\Sheets\21249 - Site Plan.dwg - Tue, 1 Feb 2022 - 10:21