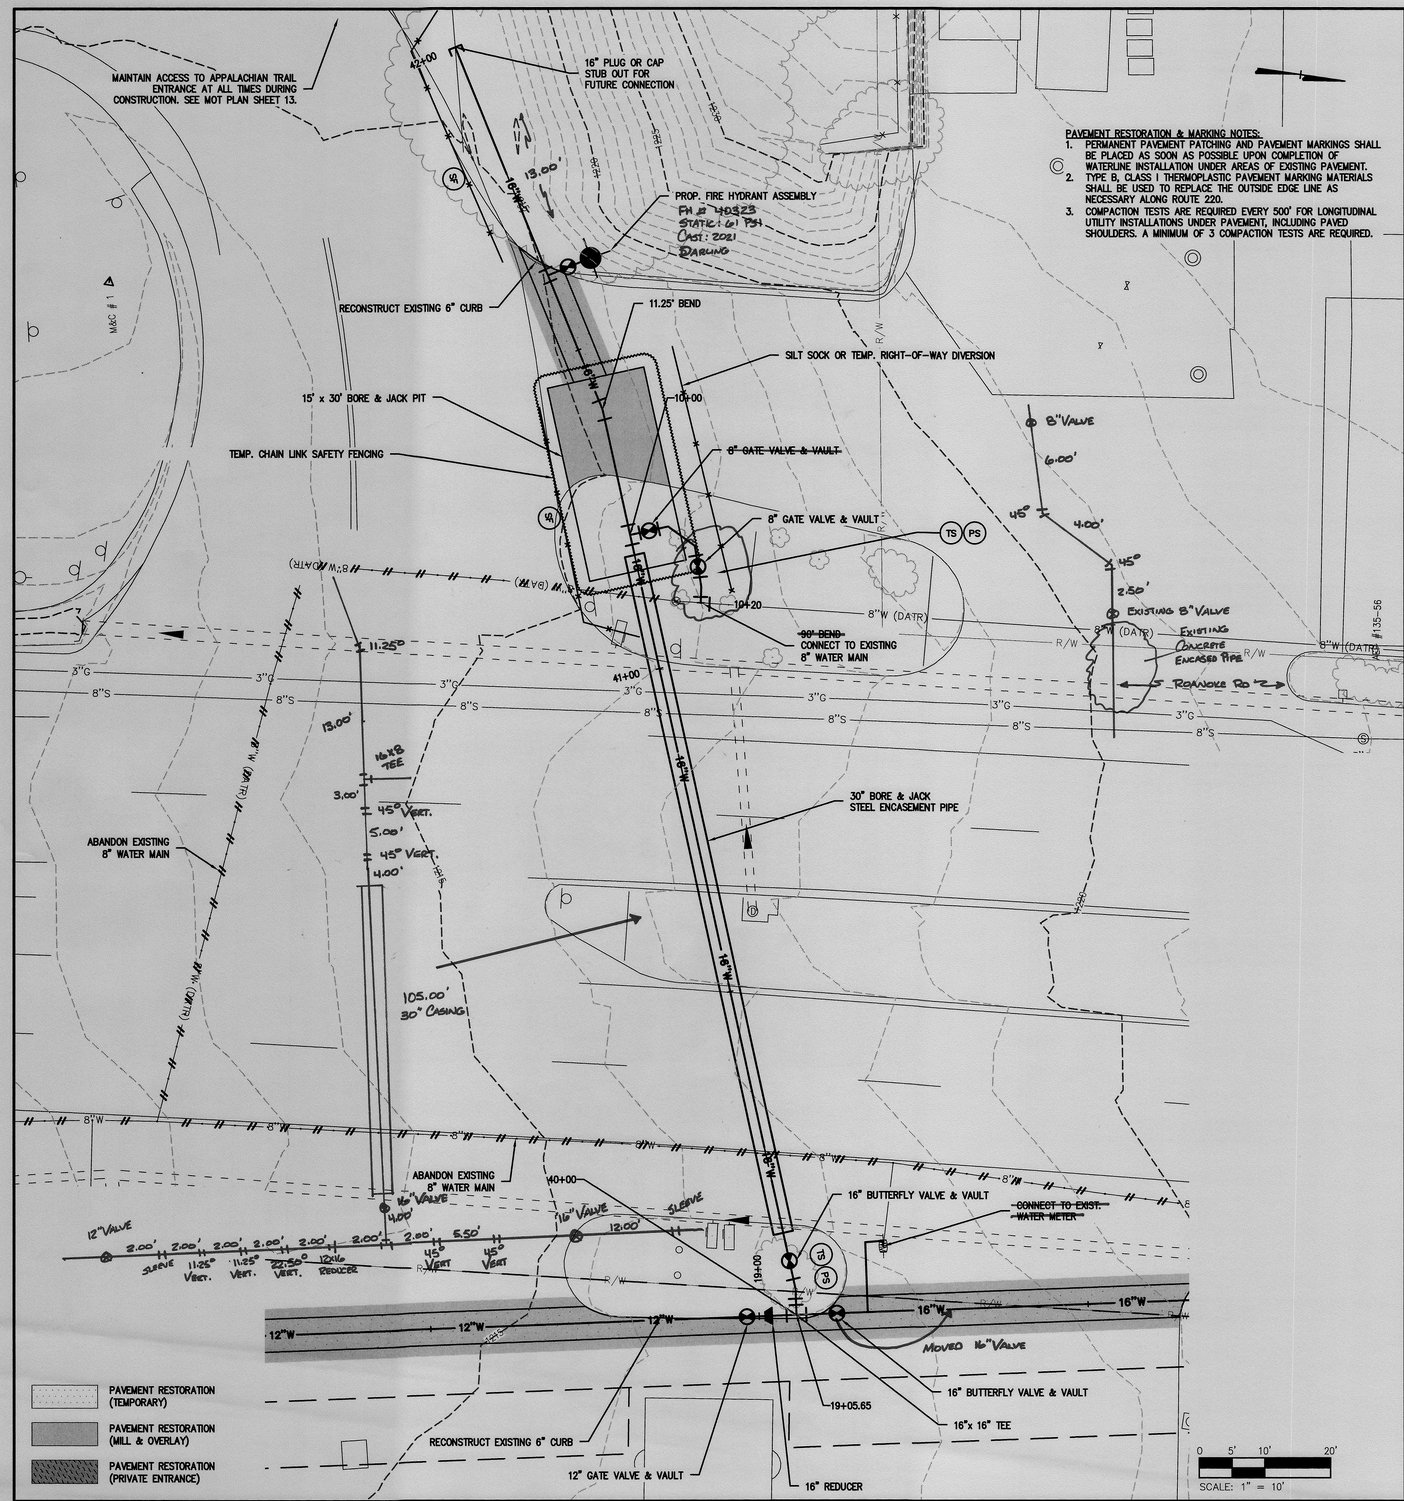

PAVEMENT RESTORATION & MARKING NOTES:

1. PERMANENT PAVEMENT PATCHING AND PAVEMENT MARKINGS SHALL BE PLACED AS SOON AS POSSIBLE UPON COMPLETION OF WATERLINE INSTALLATION UNDER AREAS OF EXISTING PAVEMENT.
2. TYPE B, CLASS I THERMOPLASTIC PAVEMENT MARKING MATERIALS SHALL BE USED TO REPLACE THE OUTSIDE EDGE LINE AS NECESSARY ALONG ROUTE 220.
3. COMPACTION TESTS ARE REQUIRED EVERY 500' FOR LONGITUDINAL UTILITY INSTALLATIONS UNDER PAVEMENT, INCLUDING PAVED SHOULDERS. A MINIMUM OF 3 COMPACTION TESTS ARE REQUIRED.

PROP 16" RTE 220 CROSSING PROFILE

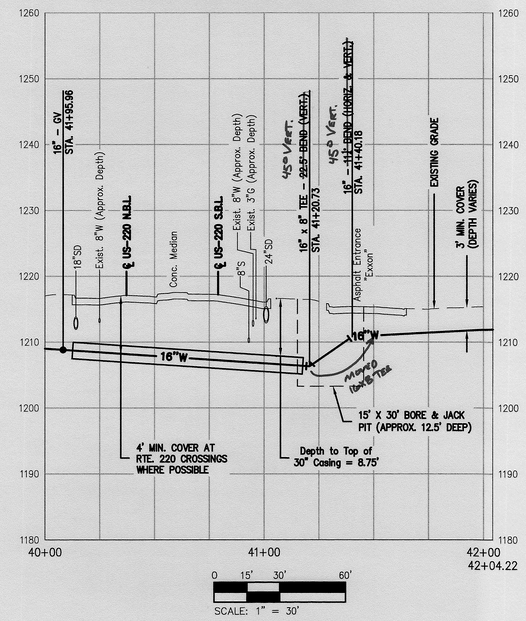

8" WATER MAIN CONNECTION PROFILE

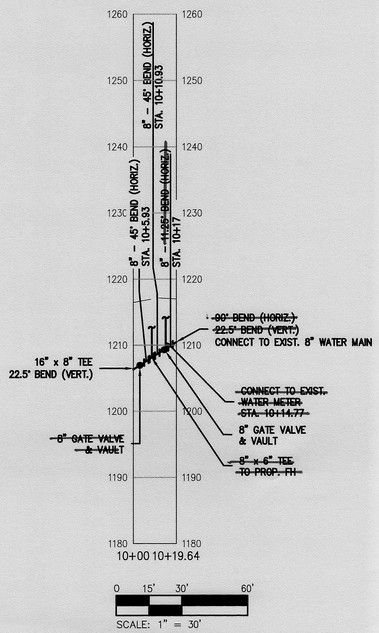

COMMONWEALTH OF VIRGINIA
RYAN P. KINCER
Lic. No. 69119
8/28/23
PROFESSIONAL ENGINEER

Revisions	Date

Issue Date: AUG. 28, 2023
Drawn By: BAD
Designed By: RPK
Checked By: RPK
Date: 8/28/2023

Mattern & Craig
ENGINEERS • SURVEYORS
701 FIRST STREET, S.W.
ROANOKE, VIRGINIA 24016
(540) 345-3342
FAX (540) 345-7691

EXIT 150 WATERLINE REPLACEMENT
RTE. 220 CROSSING BLOW-UP & PROFILES
BOTETOURT COUNTY, VIRGINIA

Vertical Scale: 1"=10'
Horizontal Scale: AS NOTED
Commission Number: 4230A
Sheet No.: 7