



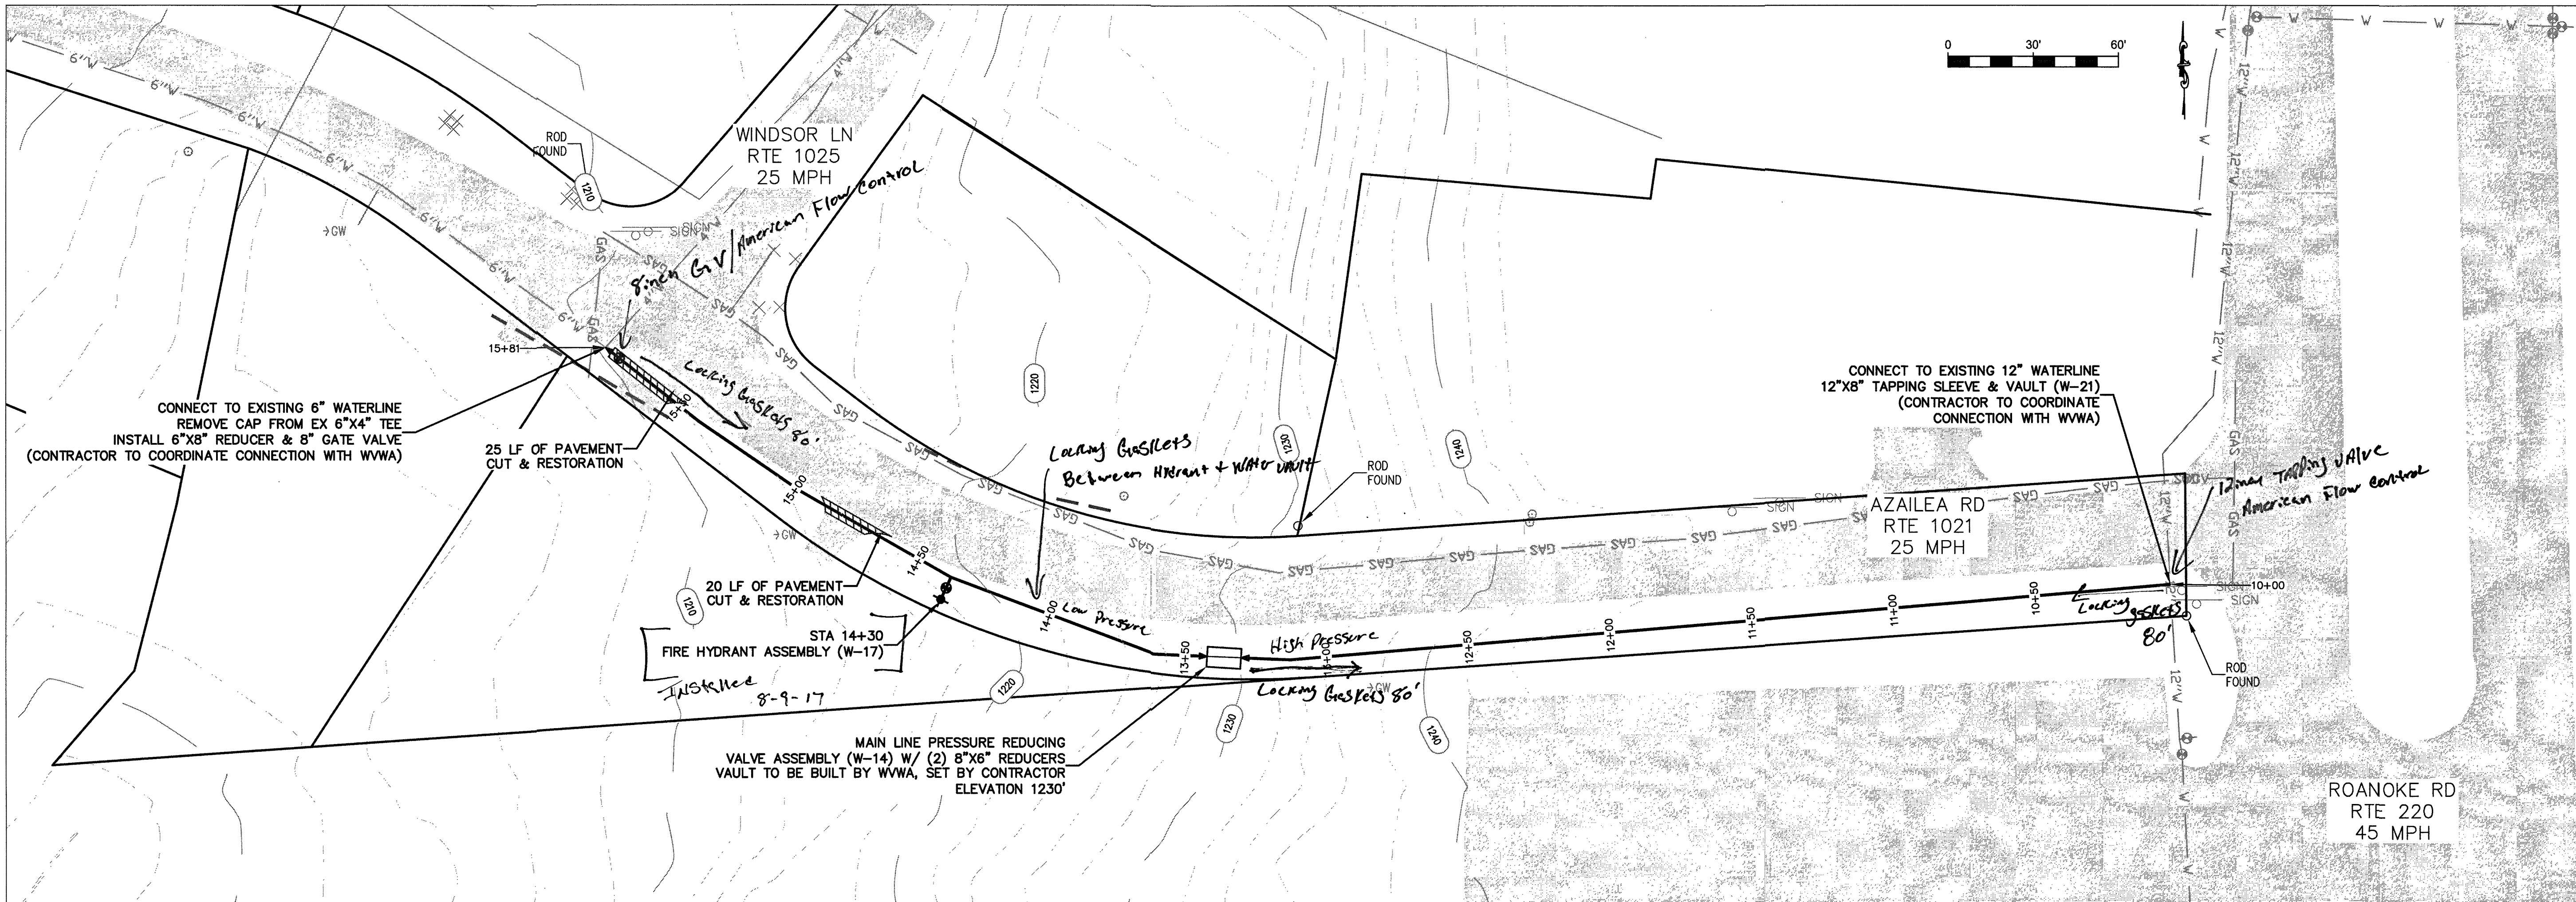

- WATERLINE NOTES:
1. ALL UTILITY CROSSINGS SHALL BE POTHOLED AHEAD OF CONSTRUCTION TO VERIFY CROSSING ELEVATIONS.
 2. MINIMUM COVER ON ALL WATERLINES SHALL BE 3'.
 3. WATERMAIN SHALL BE INSTALLED 3' OFF EDGE OF PAVEMENT.
 4. ALL UTILITY CROSSINGS SHALL HAVE 18" MIN. SEPARATION OR CONTRACTOR SHALL UTILIZE WVWA STANDARD G-8 CONCRETE PIER DETAIL.

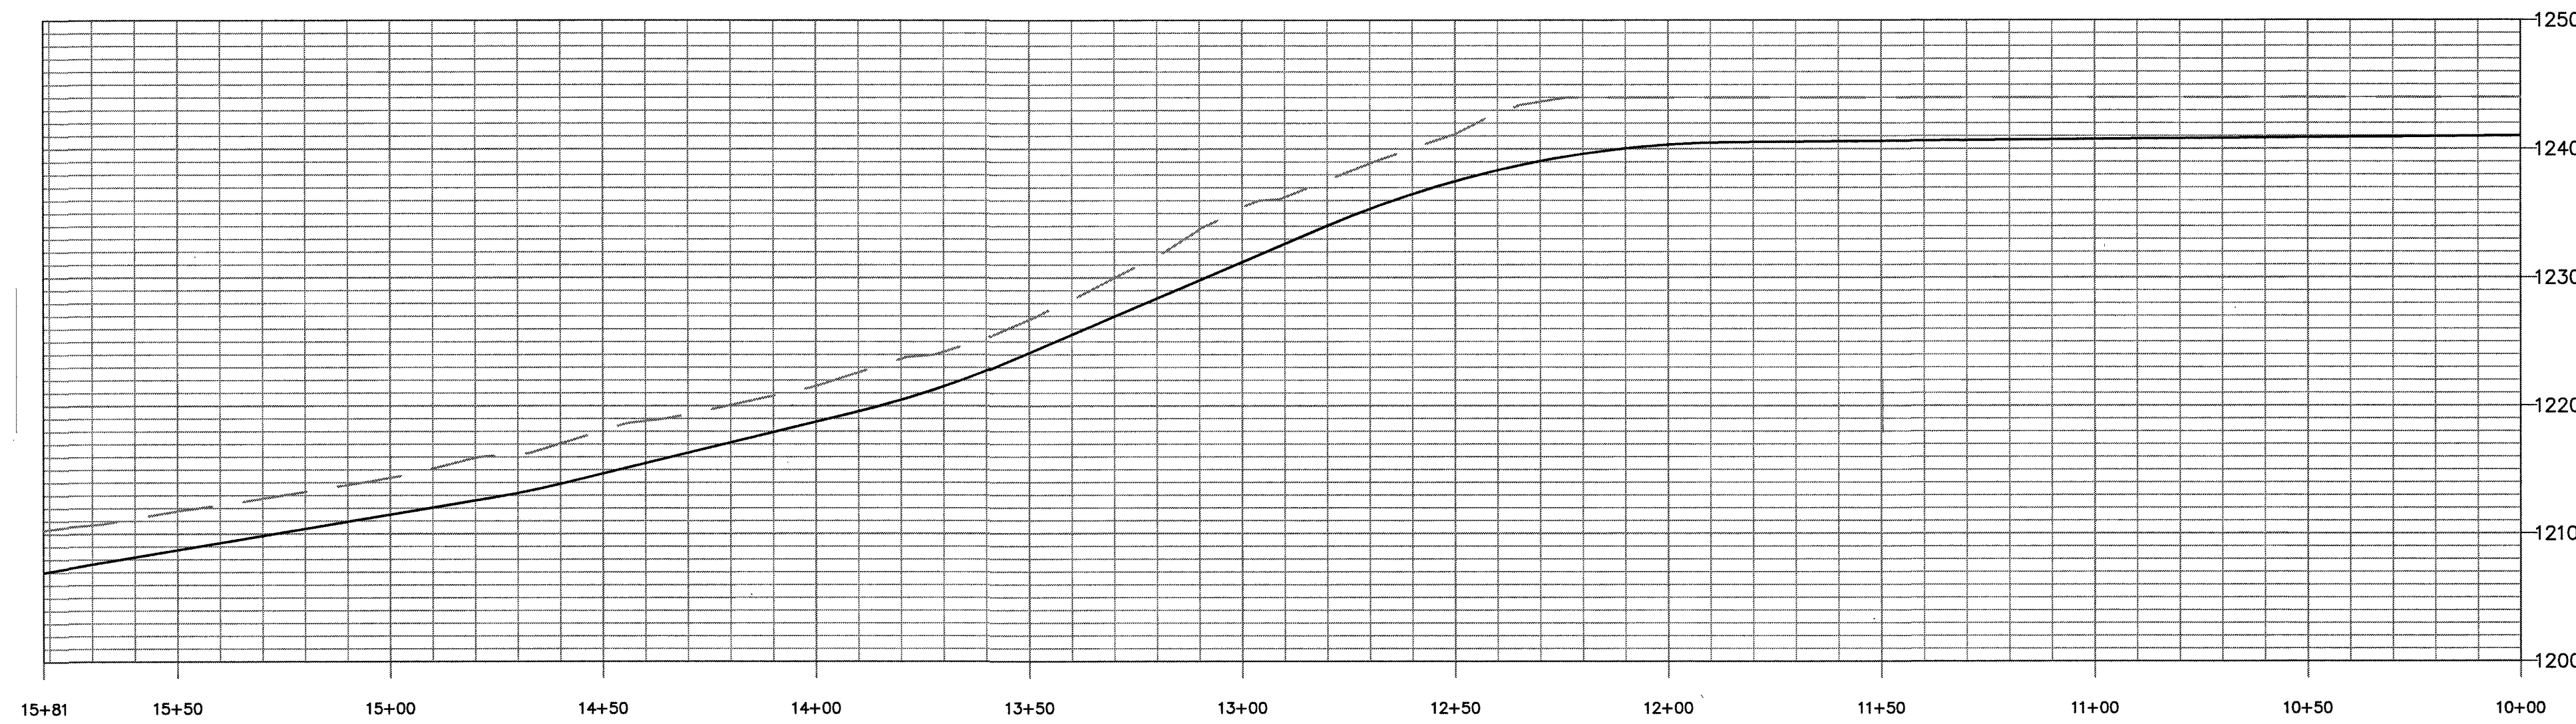

SCALE
VERTICAL: 1" = 10'
HORIZONTAL: 1" = 30'

8" US PIPE = CL-350
Hydrant - American Derling
40257 - 2017
6" valve - 21 turns - CCW = ON
12" valve - 39 turns - CCW = ON

AS - Builds 8-25-17 J. CARTER

WESTERN VIRGINIA
WATER AUTHORITY
ENGINEERING SERVICES
601 S JEFFERSON ST, SUITE 300
ROANOKE, VA 24011
540-853-5641 or 540-853-5770

NICHOLAS ROBERTSON
Lic. No. 0402052204
PROFESSIONAL ENGINEER

AZALEA WATER

PLAN & PROFILE

Rev	Description	Date	By

Designed: AAS

Drawn: AAS

Checked: WNR

Approved:

Date: 7/11/17

Project:

2

Sheet 2 of 3