


LEGEND (EXISTING)			
WATER/FORCEMAIN		STORM	
VALVE		DROP INLET	
AIR RELEASE		LARGE CURB INLET	
BLOW-OFF/FLUSHING ASSEMBLY		SMALL CURB INLET	
SINGLE METER BOX		MANHOLE	
DOUBLE METER BOX			
FIRE HYDRANT			
WELL			
SEWER		OTHER	
MANHOLE		POWER POLE	
CLEAN OUT		POWER POLE WITH GUY WIRE	
GAS VALVE		LAMP POST	
UTILITY PEDESTAL		TRAFFIC POLE	
MAILBOX		SIGN	

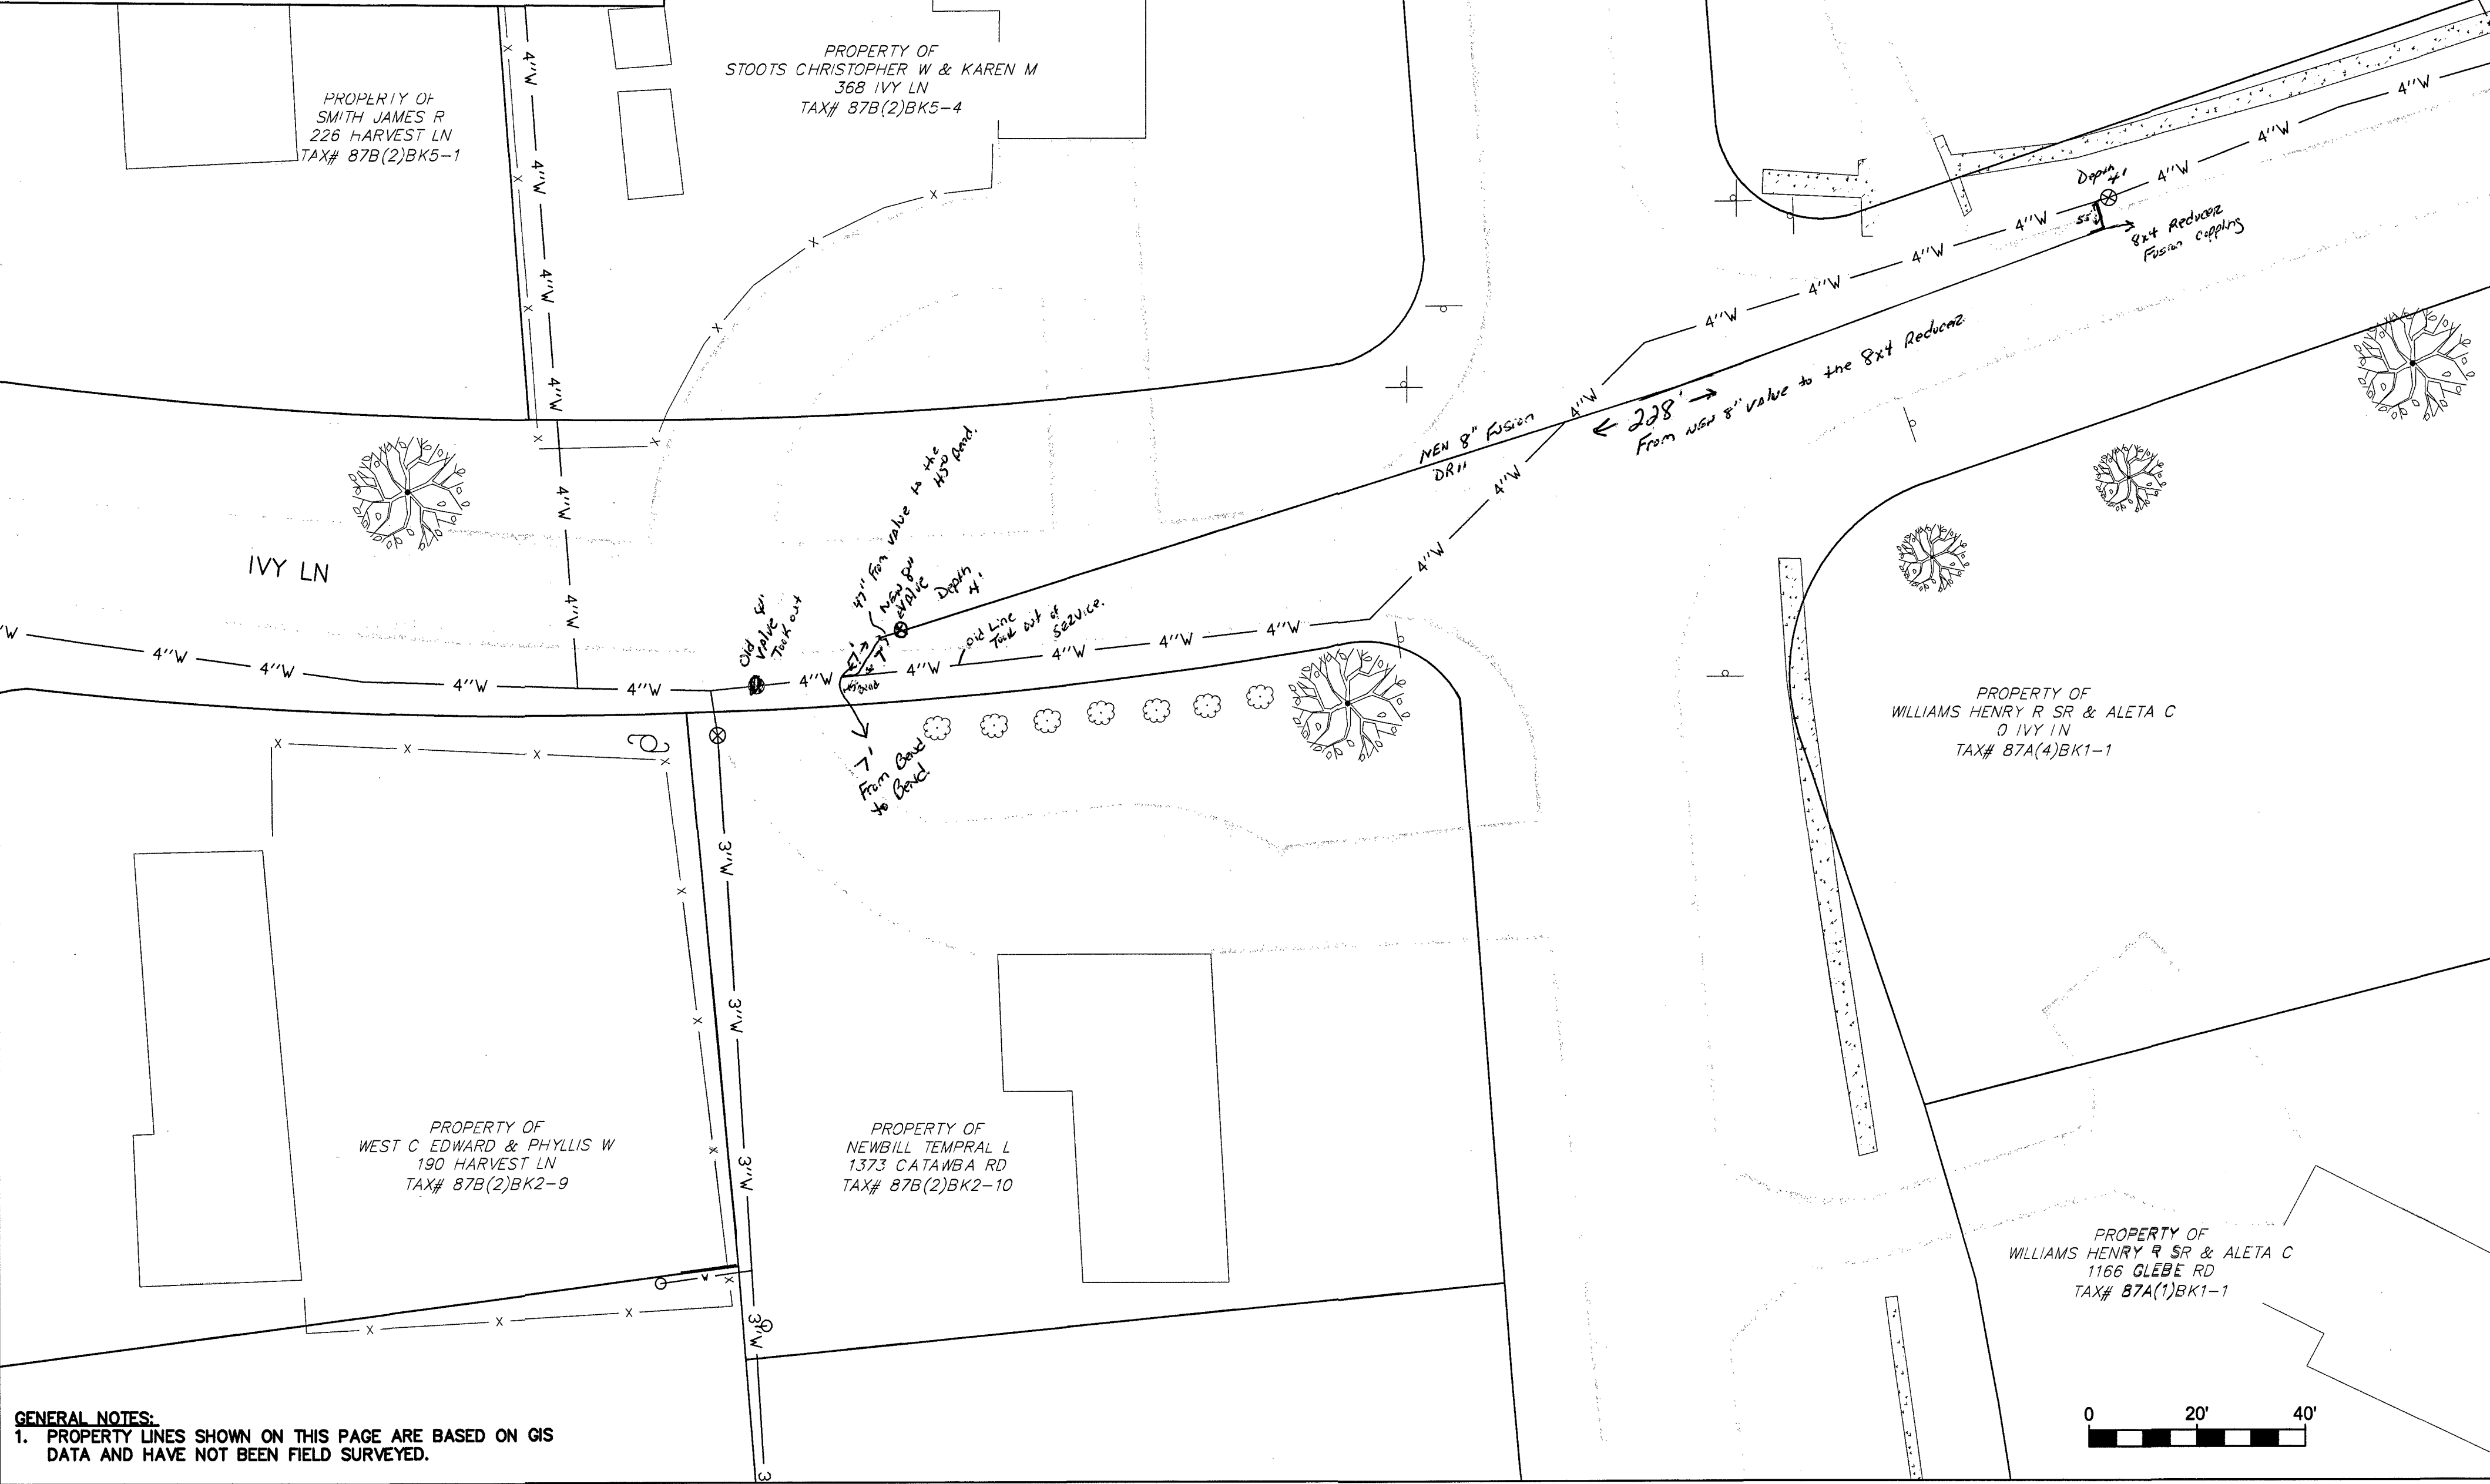

GENERAL NOTES:
1. PROPERTY LINES SHOWN ON THIS PAGE ARE BASED ON GIS DATA AND HAVE NOT BEEN FIELD SURVEYED.

Project Name			
Install Contractor	WVWP CIP4		
Construction Start Date	1-28-20		
Completion Date	2-20-2020		
		Water Main(s)	
Manufacturer	Consolidate		
Diameter	8"	4"	
Pipe Class	DR11		
Material	Fusion	PVC	
Comments			
		Water Service(s)	
Manufacturer			
Diameter			
Pipe Class			
Material			
Comments			
		Water Valve(s) 1	
Manufacturer	Avk		
Valve Type	MS mechanical		
Diameter	8"		
Direction to Open / Turns to Close			
Comments			
		Water Valve (s) 2	
Manufacturer			
Valve Type			
Diameter			
Direction to Close / Turns to Close			
Comments			

WESTERN VIRGINIA

WATER AUTHORITY

ENGINEERING SERVICES

601 S JEFFERSON ST, SUITE 300

ROANOKE, VA 24011

540-853-5700

CATAWBA ROAD WATERLINE

REPLACEMENT DIRECTIONAL

DRILL

BASEMAP

By

Date

Description

Rev

Designed:

Drawn: AJC

Checked: NSS

Approved:

Date: DEC 2018

Project: PVT. MNTC

1

Sheet 1 of 1