



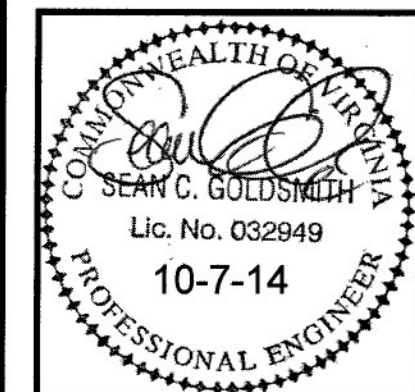

Revisions By	Date
1-WTR&SWR RVNS	10/7/14

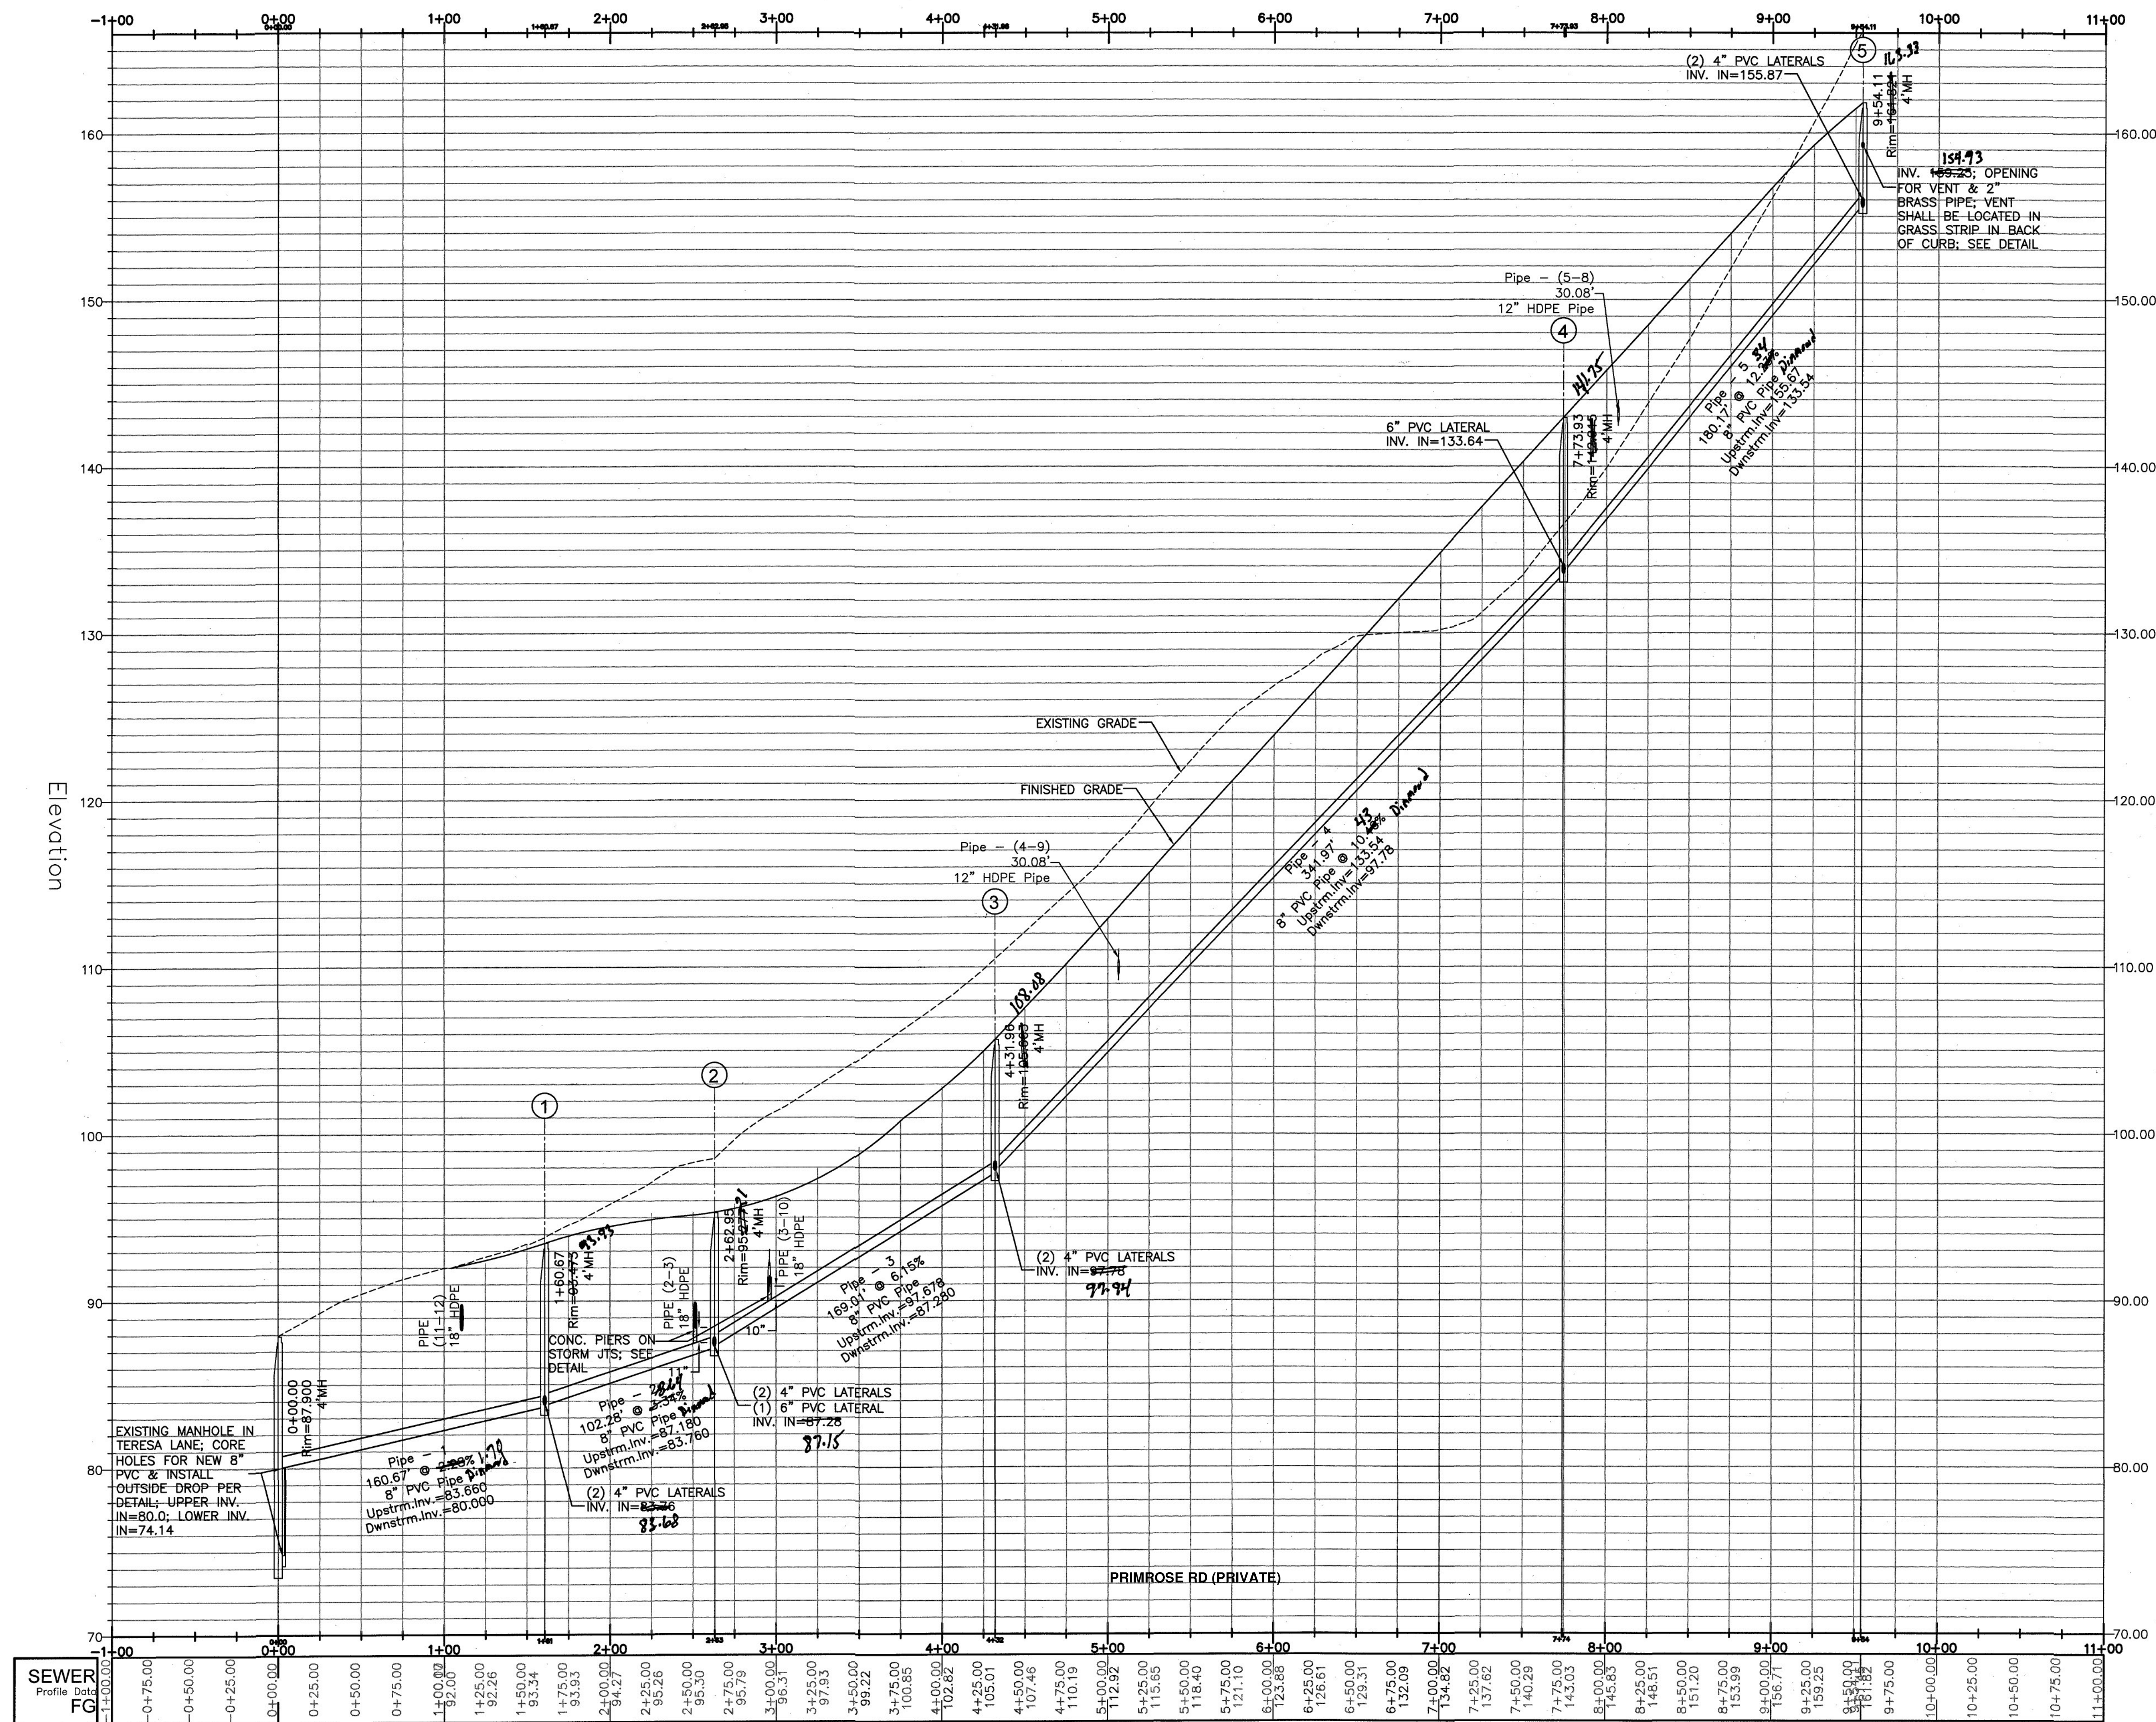

SANITARY SEWER PROFILE 1-5
PHASE 1 - TERESA LN - PVT. RD.1
COTTAGES OF STEEPLECHASE
BOTETOURT COUNTY, VIRGINIA

Scale: H:1"=50' V:1"=5'
Date: 8/13/14
Design By: SCG
CAD By: SCG
Checked By:
Project No.: 12052