


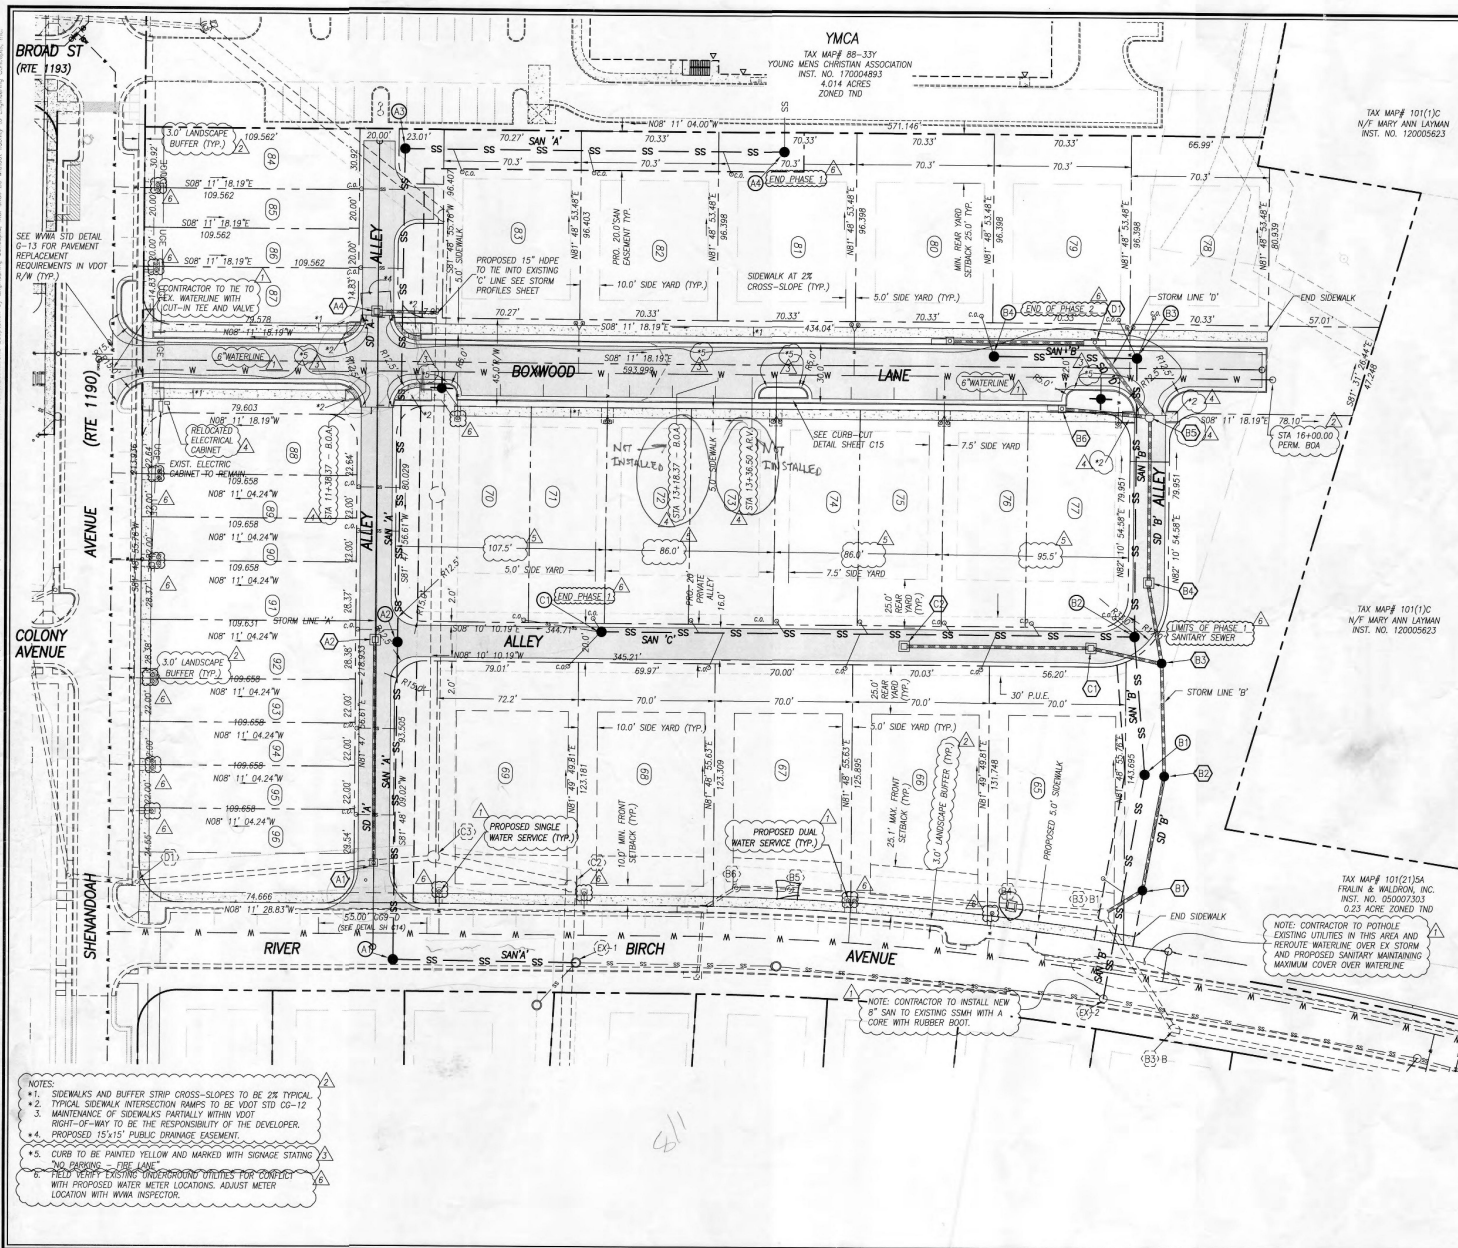

- EX-3 RM 1340.37
INV IN 1327.11 8" PVC
INV OUT 1327.07 8" PVC
SHELF 1327.77
- EX-4 RM 1341.39
INV IN 1329.66 8" PVC
INV OUT 1329.62 8" PVC
SHELF 1330.65
- EX-5 RM 1341.44
INV IN 1330.02 8" PVC
INV OUT 1329.94 8" PVC
SHELF 1330.74
- EX-6 RM 1342.30
INV IN 1331.7 8" PVC
SHELF 1332.55


SANITARY SEWER LATERALS			
LOT	c.o. TOP	MIN. INVERT	PLANNED MIN FFE
65	1315.00	1303.53	1315.05
66	1314.50	1309.46	1318.37
67	1318.50	1313.13	1321.51
68	1322.90	1316.79	1325.31
69	1324.90	1321.19	1328.70
70	1327.50	1320.69	1338.48
71	1325.20	1319.85	1336.48
72	1322.70	1317.28	1333.19
73	1320.30	1314.99	1332.52
74	1318.10	1312.72	1330.01
75	1315.80	1313.38	1329.34
76	1313.90	1308.03	1326.80
77	1313.90	1305.37	1326.80
78	1327.50	1319.38	1329.72
79	1327.80	1319.37	1329.34
80	1328.0	1319.64	1330.80
81	1333.00	1327.83	1333.00
82	1336.50	1327.14	1336.27
83	1337.80	1326.48	1336.97
84	1345.40	1326.10	1349.00
85	1345.03	1326.10	1349.00
86	1344.71	1325.69	1348.33
87	1344.50	1325.69	1348.33
88	1342.40	1324.54	1346.67
89	1342.10	1324.31	1346.00
90	1341.80	1324.31	1345.33
91	1341.50	1323.80	1344.67
92	1341.10	1323.80	1343.33
93	1340.80	1323.21	1343.33
94	1340.50	1323.21	1342.67
95	1340.20	1322.77	1342.67
96	1339.80	1322.77	1342.00

ENGINEERING CONCEPTS, INC.
94 GREENFIELD STREET
DALEVILLE, VIRGINIA 24083
540.473.1253



No.	Description	Date
1	WMA 7/2/19 COMMENTS	07/23/19
2	VDOT COMMENTS (8/28/19)	09/03/19
3	FIRE FMS ACCESS COMMENT	10/31/19
4	VDOT COMMENTS 12/13/19	12/16/19
5	SHIFT DUPLICATION LINES	02/27/20
6	WMA COMMENTS	3/30/20

DALEVILLE TOWN CENTER PH 3
BOTETOURT CO. - VIRGINIA
BOXWOOD LANE
SITE DIMENSIONAL PLAN

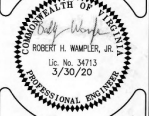

0 30 60
GRAPHIC SCALE
PROJECT: 18038

C04

P-20213
CS

Strong
adjustment