




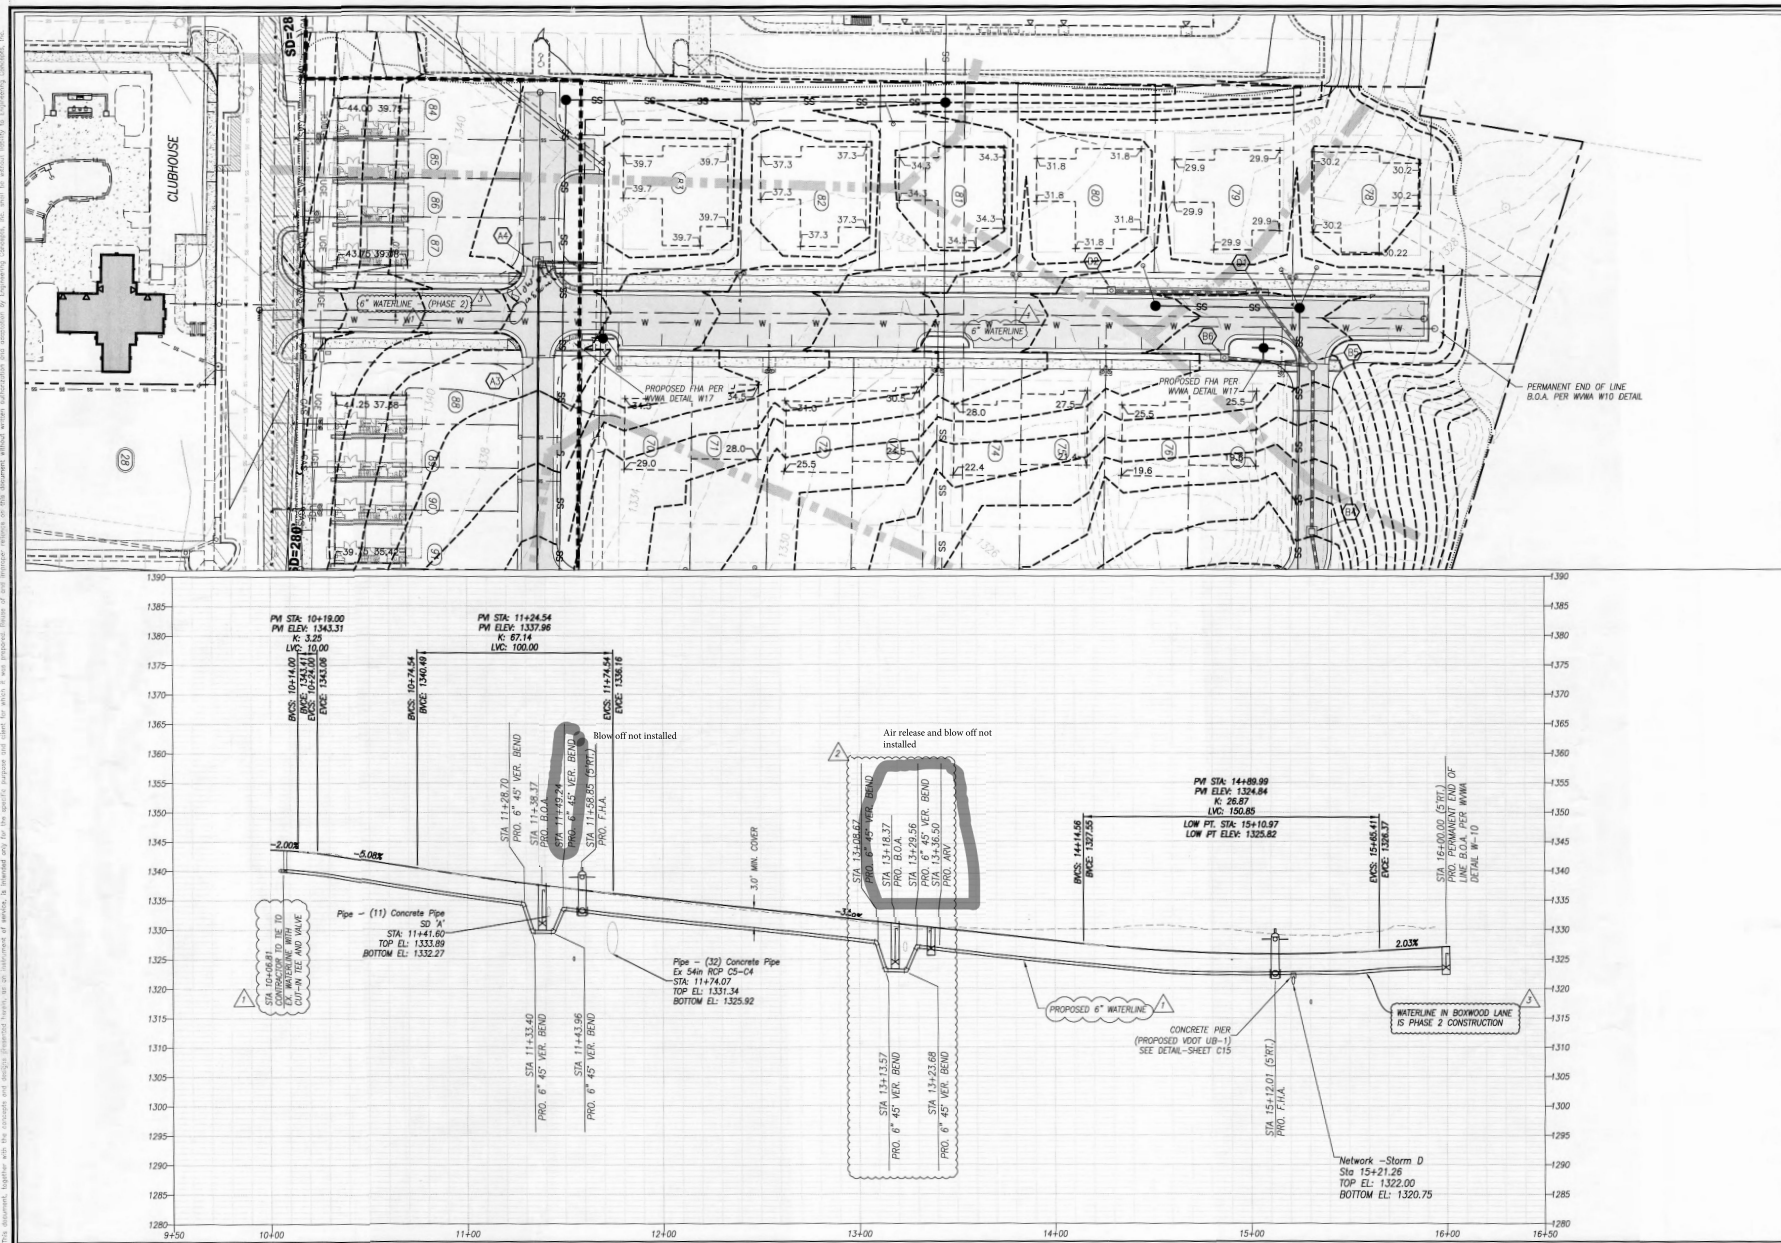


**ENGINEERING
CONCEPTS, INC.**
94 GREENFIELD STREET
DALEVILLE, VIRGINIA 24069
540-473-1253

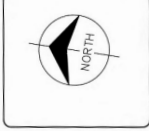

No.	Description	Date
1	WMA 7/2/19 COMMENTS	7/2/19
2	WMA 12/13/19 COMMENTS	12/13/19
3	WMA 12/13/19 COMMENTS	12/13/19
4	ADJUST LOT GRADES	04/10/20

**DALEVILLE TOWN CENTER PH 3
BOTETOURT CO. VIRGINIA
BOXWOOD LANE PROFILE
WATERLINE PROFILE**

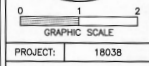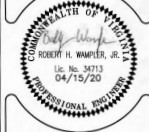

C13