


P.O. BOX 311
44 CATAWBA ROAD
DALEVILLE, VA 24083



(540) 966-3027 TEL
(540) 966-5906 FAX
e-mail rplerson@rbnet.com

**DALECOURT WATER SYSTEM
NEW WATERLINE CONNECTION**

PLAN SHEET

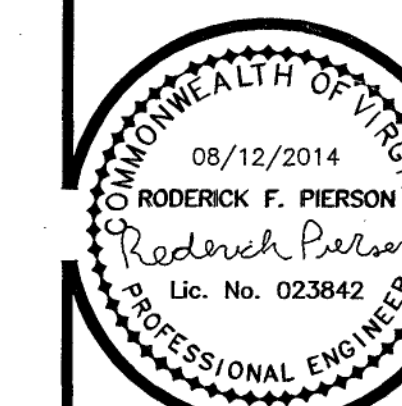

COMMISSION No.
R201250
SHEET
C3

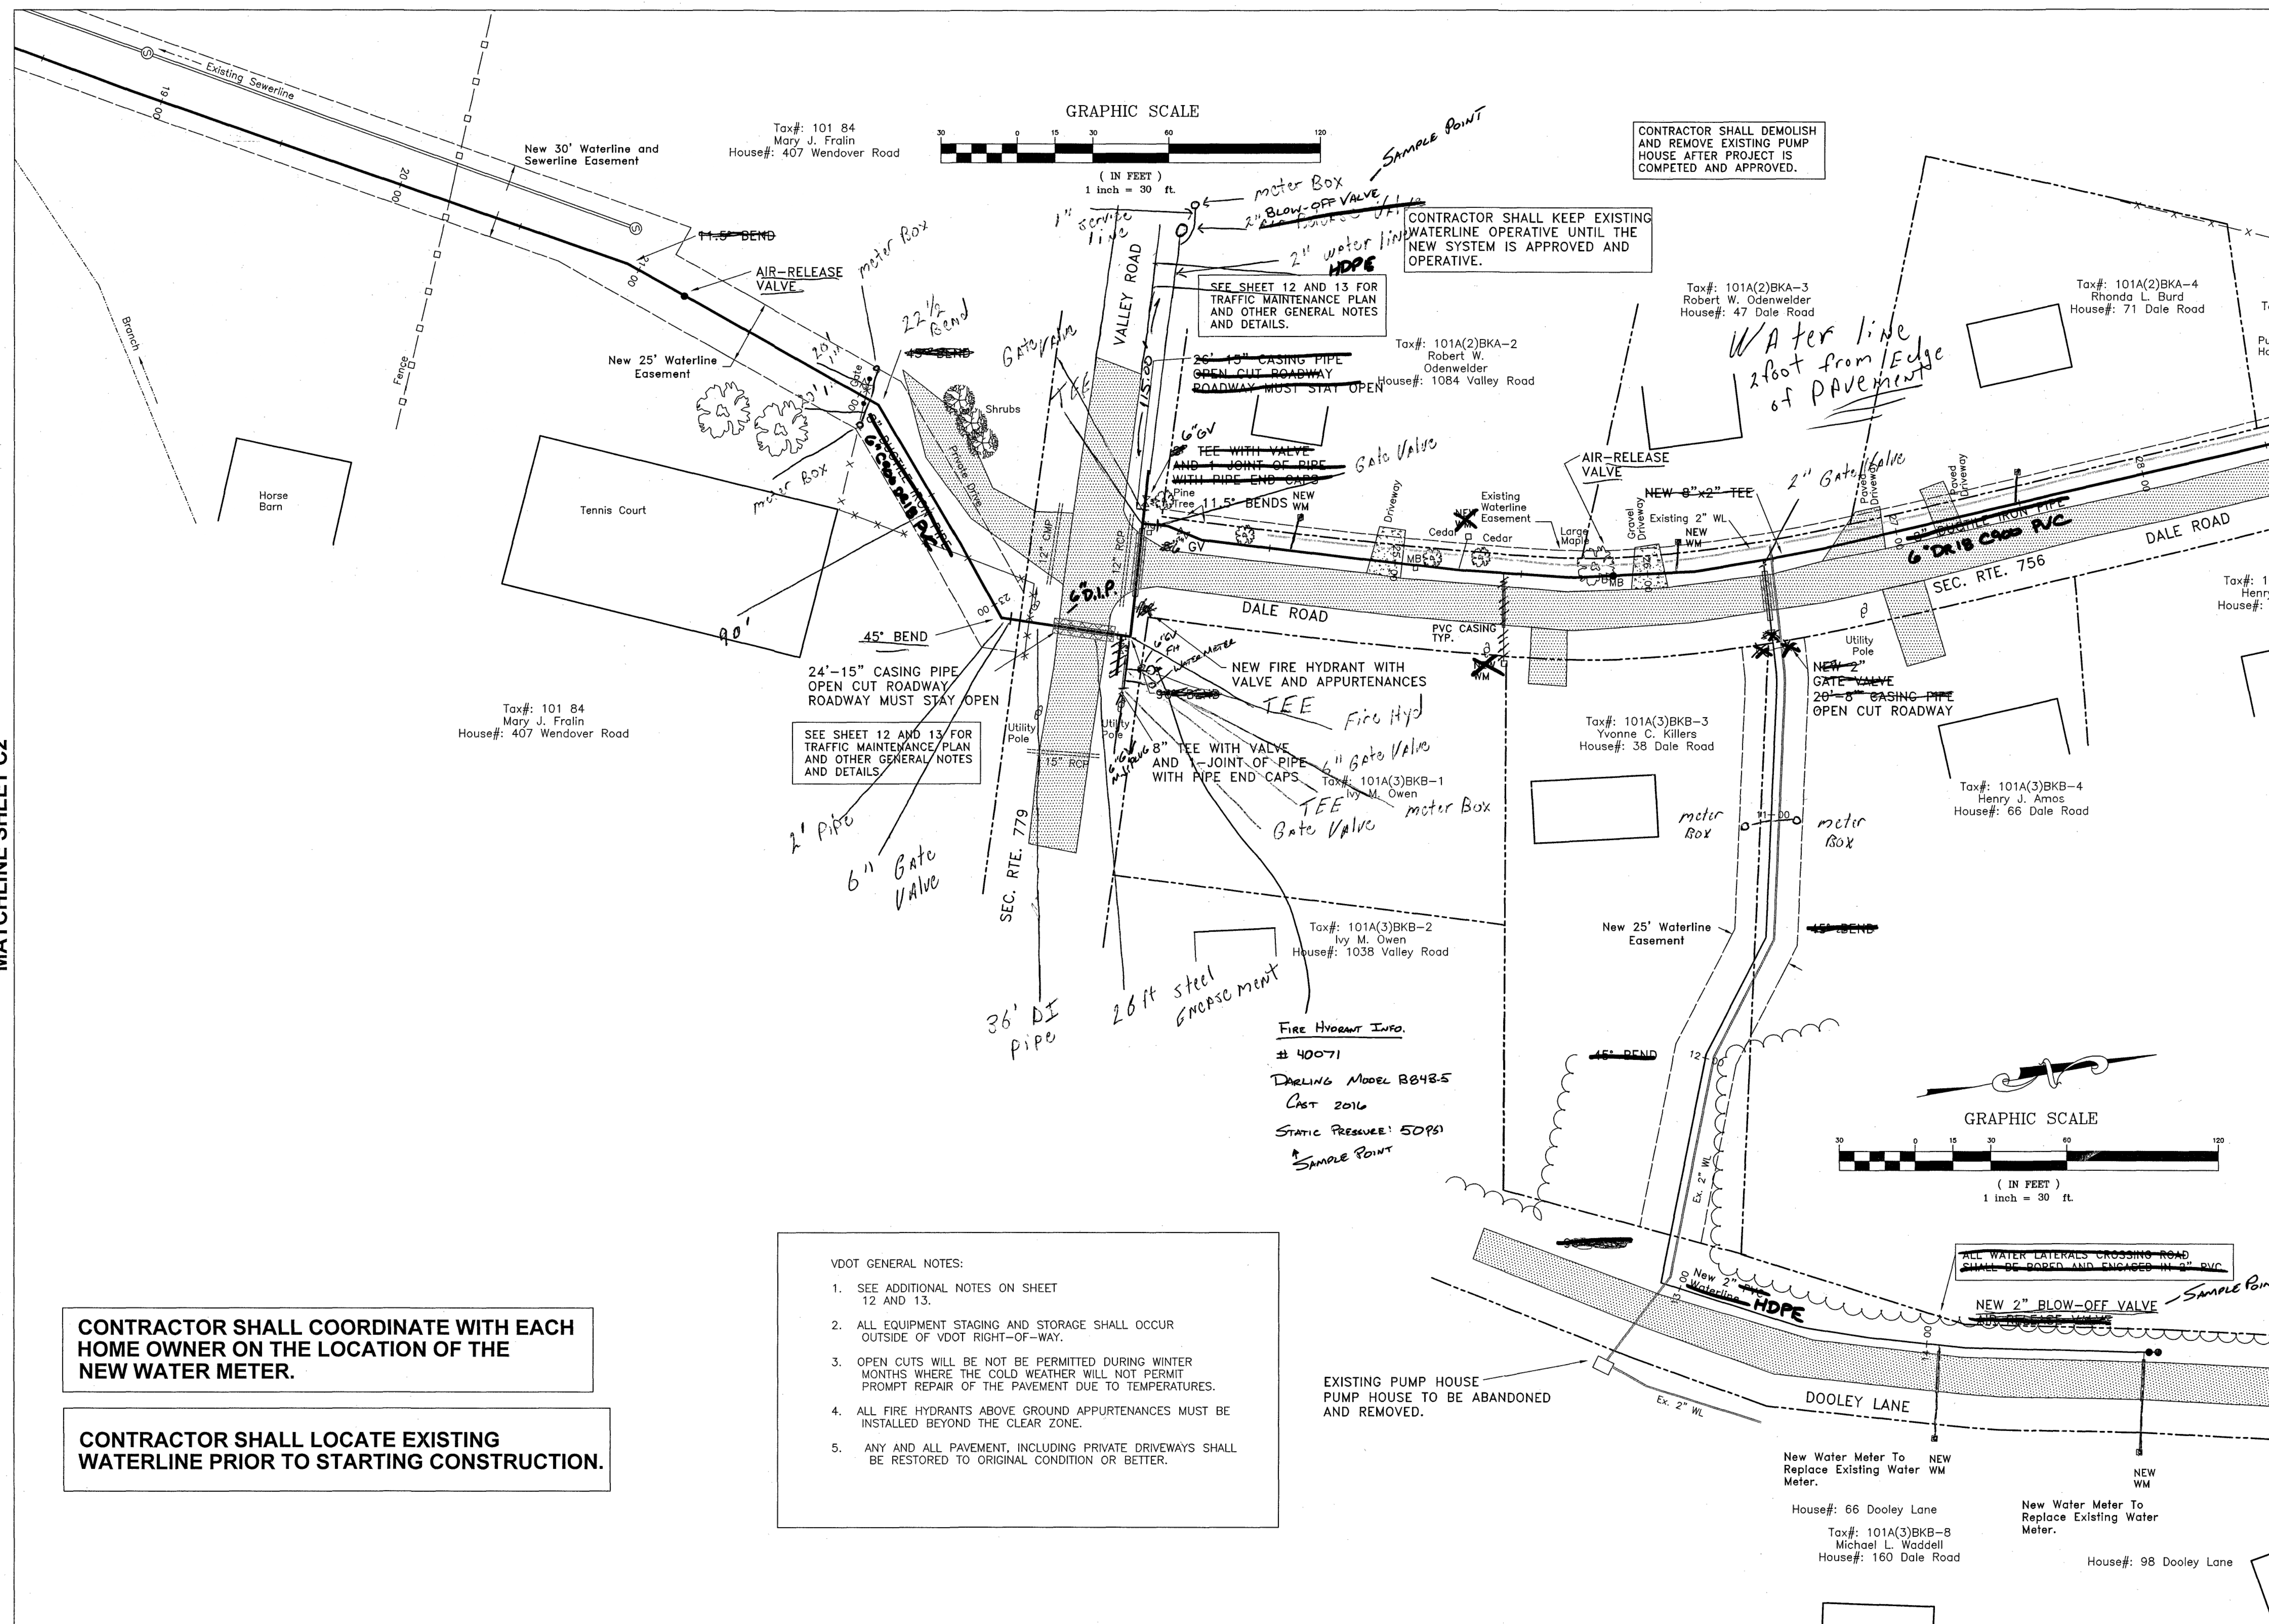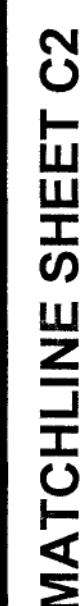

CONTRACTOR SHALL COORDINATE WITH EACH HOME OWNER ON THE LOCATION OF THE NEW WATER METER.

CONTRACTOR SHALL LOCATE EXISTING WATERLINE PRIOR TO STARTING CONSTRUCTION.

VDOT GENERAL NOTES:

1. SEE ADDITIONAL NOTES ON SHEET 12 AND 13.
2. ALL EQUIPMENT STAGING AND STORAGE SHALL OCCUR OUTSIDE OF VDOT RIGHT-OF-WAY.
3. OPEN CUTS WILL BE NOT BE PERMITTED DURING WINTER MONTHS WHERE THE COLD WEATHER WILL NOT PERMIT PROMPT REPAIR OF THE PAVEMENT DUE TO TEMPERATURES.
4. ALL FIRE HYDRANTS ABOVE GROUND APPURTENANCES MUST BE INSTALLED BEYOND THE CLEAR ZONE.
5. ANY AND ALL PAVEMENT, INCLUDING PRIVATE DRIVEWAYS SHALL BE RESTORED TO ORIGINAL CONDITION OR BETTER.

EXISTING PUMP HOUSE
PUMP HOUSE TO BE ABANDONED
AND REMOVED.