



 

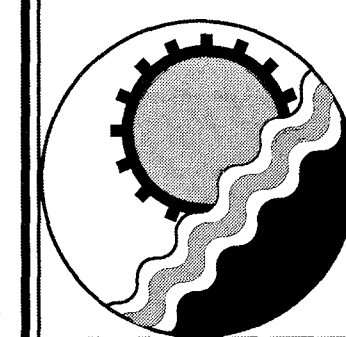

ENGINEERING CONCEPTS, INC.
94 GREENFIELD STREET
DALEVILLE, VIRGINIA 24083
540.473.1253

No.	Revision	By	Appd.	Date	Drawn	ECI	STORM DRAIN PLAN BROAD STREET & CHARTER AVENUE DALEVILLE TOWN CENTER BOTETOURT COUNTY, VIRGINIA	SCALE: 1"=50'
					Designed	ECI		DATE: FEB 7, 2018
					Checked	ECI		PROJECT: 17056
					Approved	ECI		C06
PER WYMA LETTER DATED 3/16/18					MwL	3/19/18		