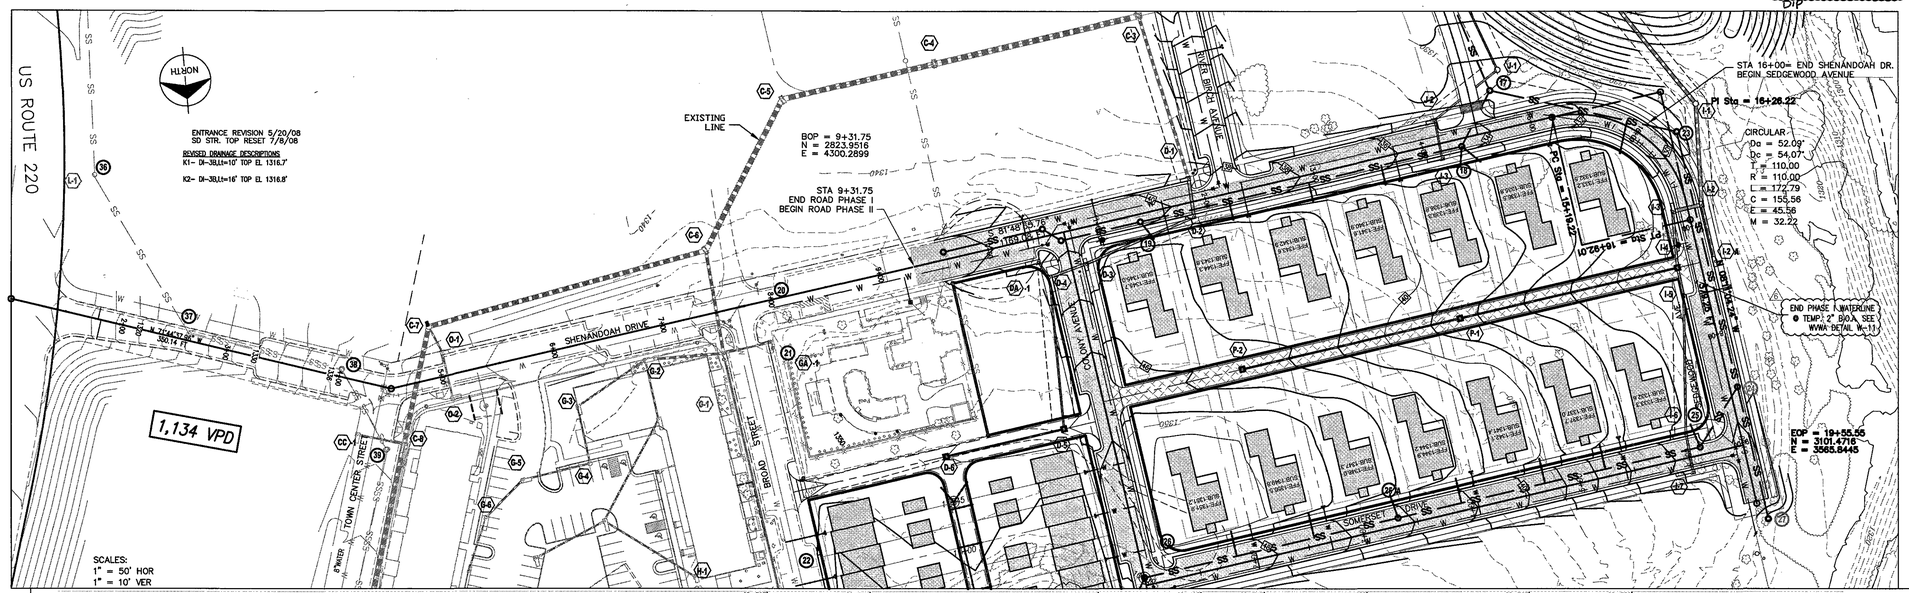

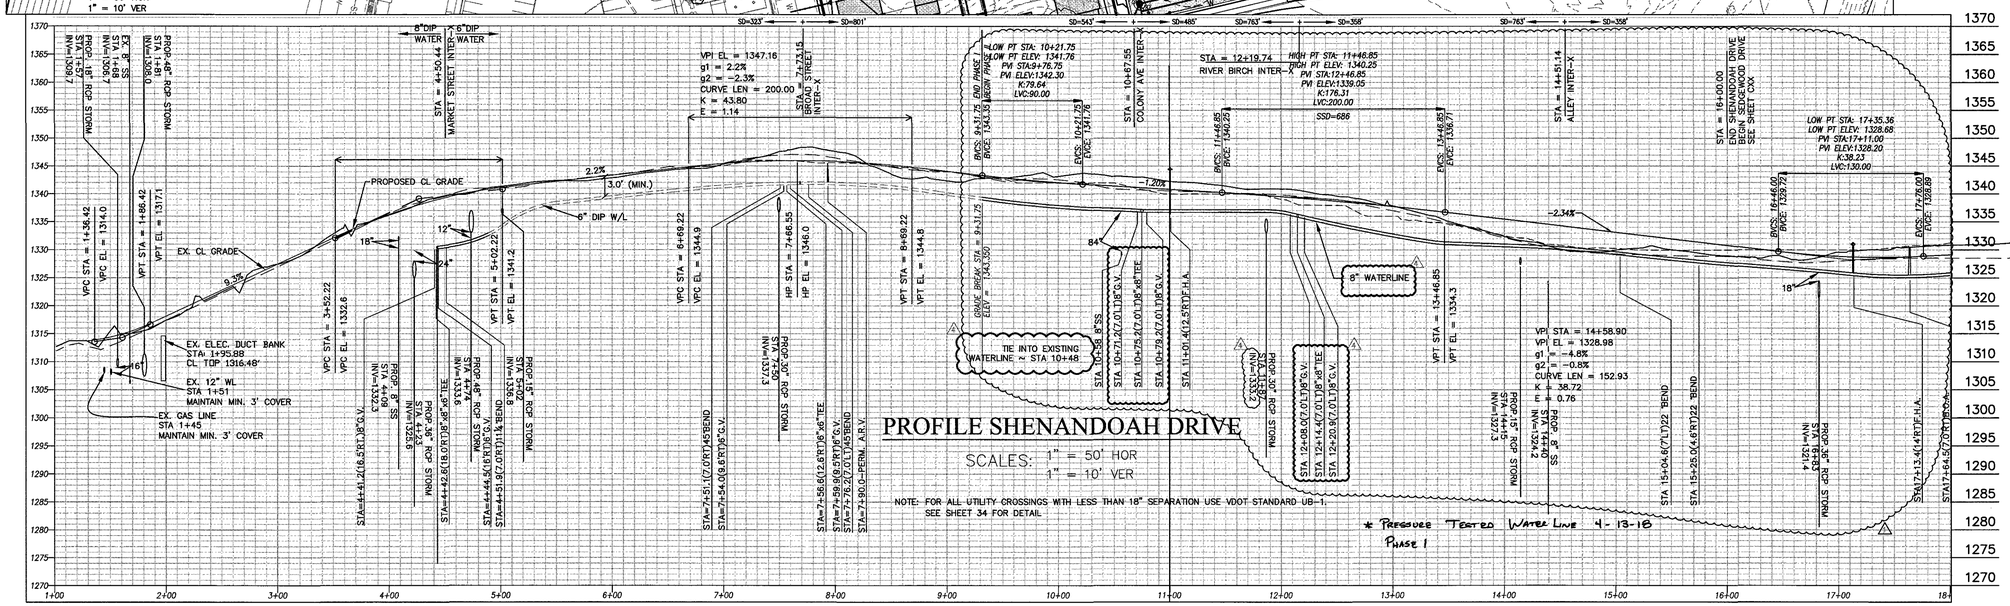

MARK	DATE	BY	REVISIONS
1	12/11/17	MSMJ	WVWA COMMENTS - PHASING
2	7/21/17	MSMJ	WVWA COMMENTS
3	7/19/17	MSMJ	WVWA COMMENTS
4	5/24/17	MSMJ	WWVUS DEVELOPMENT REVISIONS

DATE	5/8/08
PROJECT	03083
DESIGNED	RHW
DRAWN	MSMJ
CHECKED	RHW

ENGINEERING CONCEPTS, INC.
"Creating Success"

COMMONWEALTH OF VIRGINIA
ROBERT H. WAMPLER, JR.
No. 34713
7/21/17
PROFESSIONAL ENGINEER

PROJECT FRALIN AND WALDRON
DALEVILLE TOWN CENTER

DRAWING SHENANDOAH AVE. & SEDGEWOOD AVE. PLAN / PROFILE

SHEET
C-24