


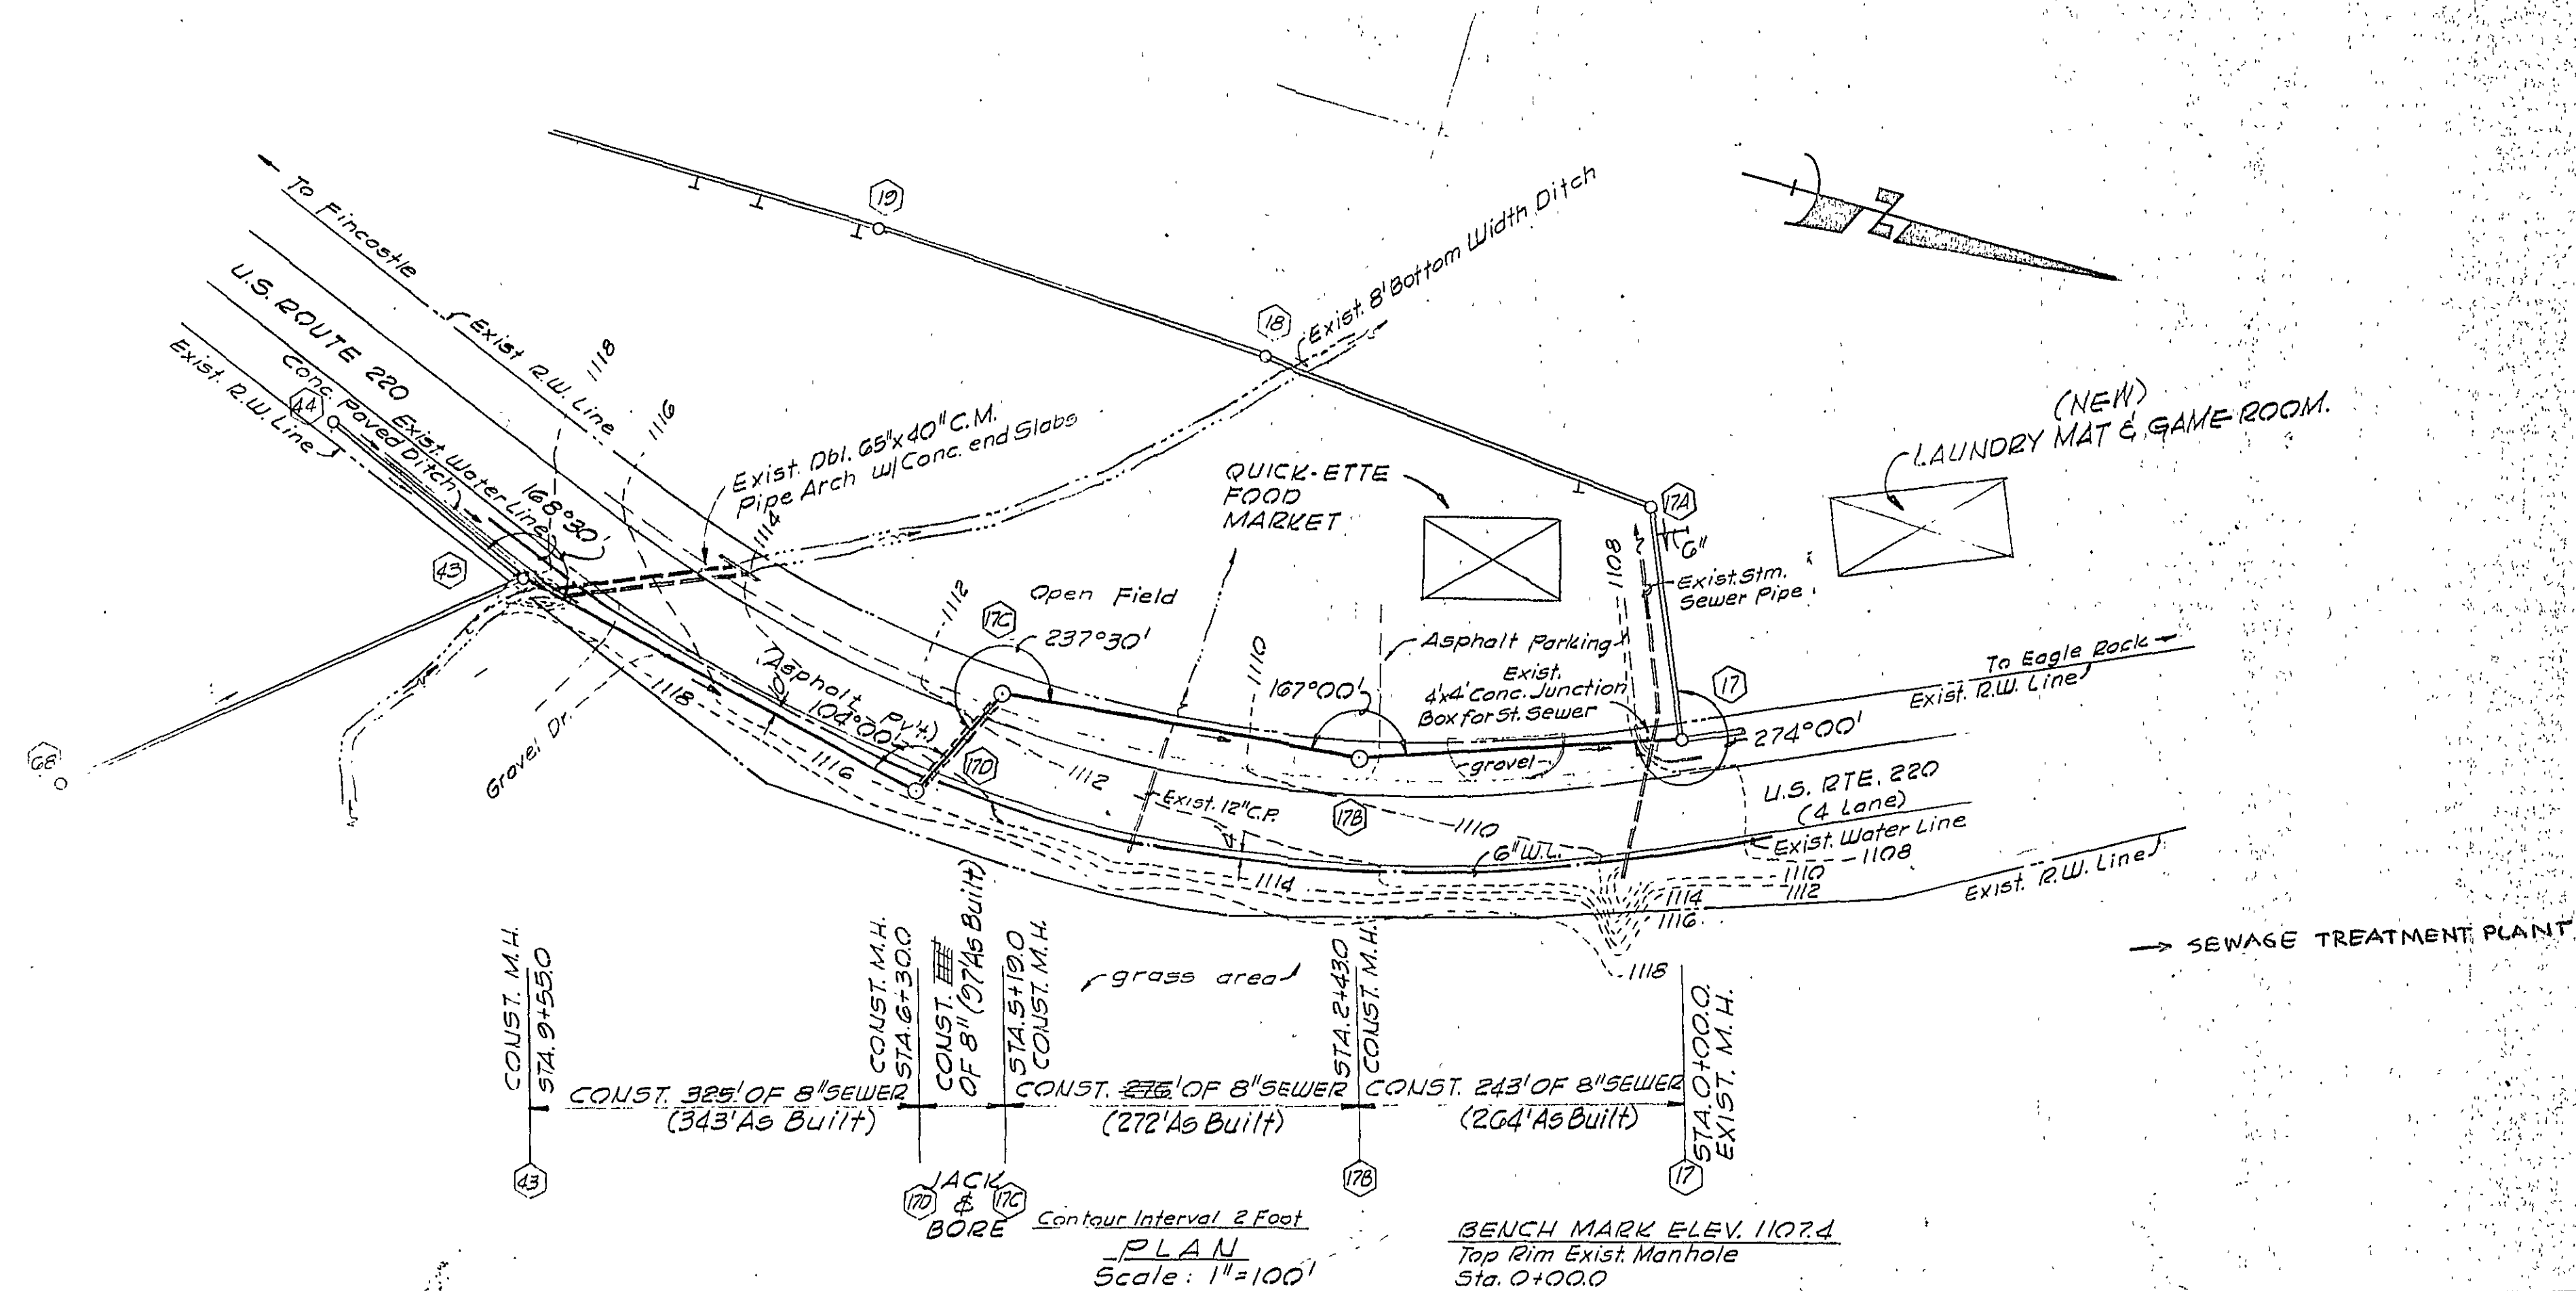

Notes:
 All proposed Sewer Lines to be 8" Diameter
 Reference to Draper Aden and Assoc. Sewer System
 Plan No. T75-194, Sheets G and 13A of 25
 Reference to V.D. of H. Project 0220-Q11-101, PE-101
 C-504
 12W-204
 Sheets 7, 8, & 9
 There shall be a Min. of 10' Horizontal Separation
 between water and sewer lines, and 18' Minimum
 Vertical separation where specified.

