


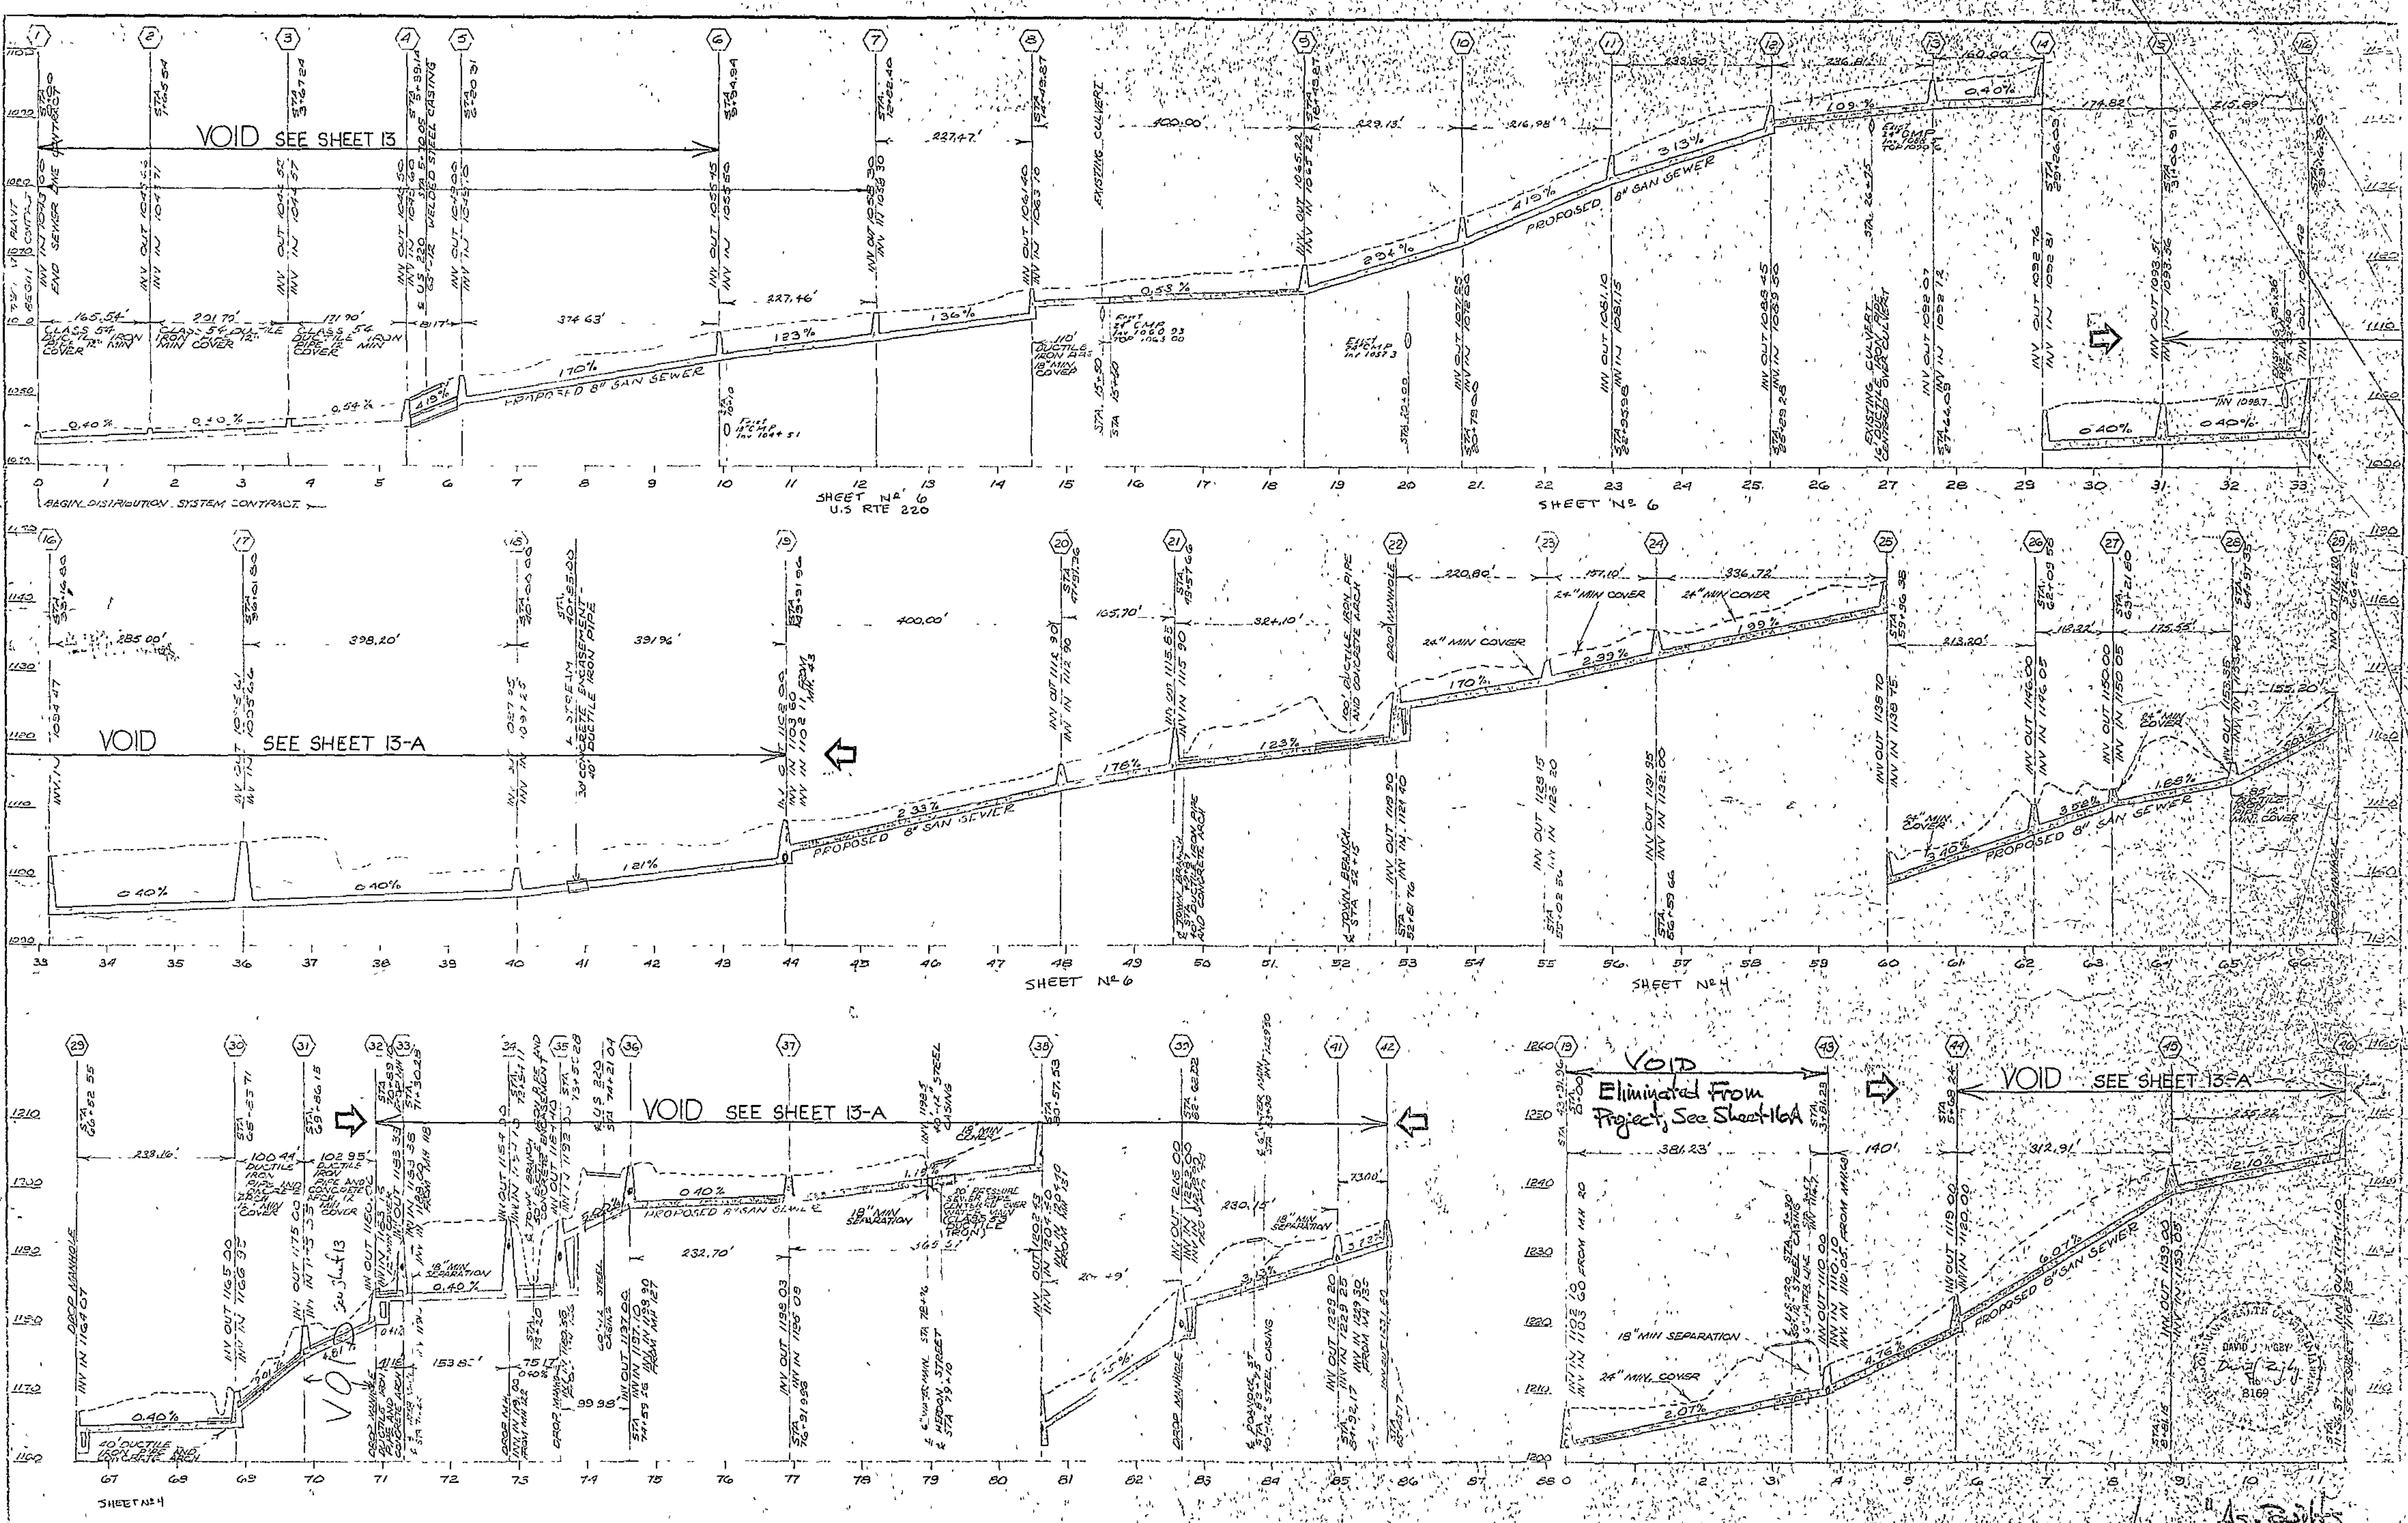

DRAPER - ADEN ASSOCIATES, INC.
ENGINEERS - SURVEYORS - PLANNERS
BLACKSBURG, VIRGINIA

DESIGNED DJR, E.A.T.
DRAWN EAT
CHECKED DJR
DATE SEPTEMBER 1, 1977

TOWN OF FINCASTLE
WASTEWATER COLLECTION AND TREATMENT SYSTEM
BOTETOUR COUNTY, VIRGINIA

REVISIONS
1. 3-27-79, SEE SHEET 13-A

SCALE: HORIZ. 1"=100'
VERT. 1"=10'
PLAN N° 7-75-10-2

SHEET
40 OF 25