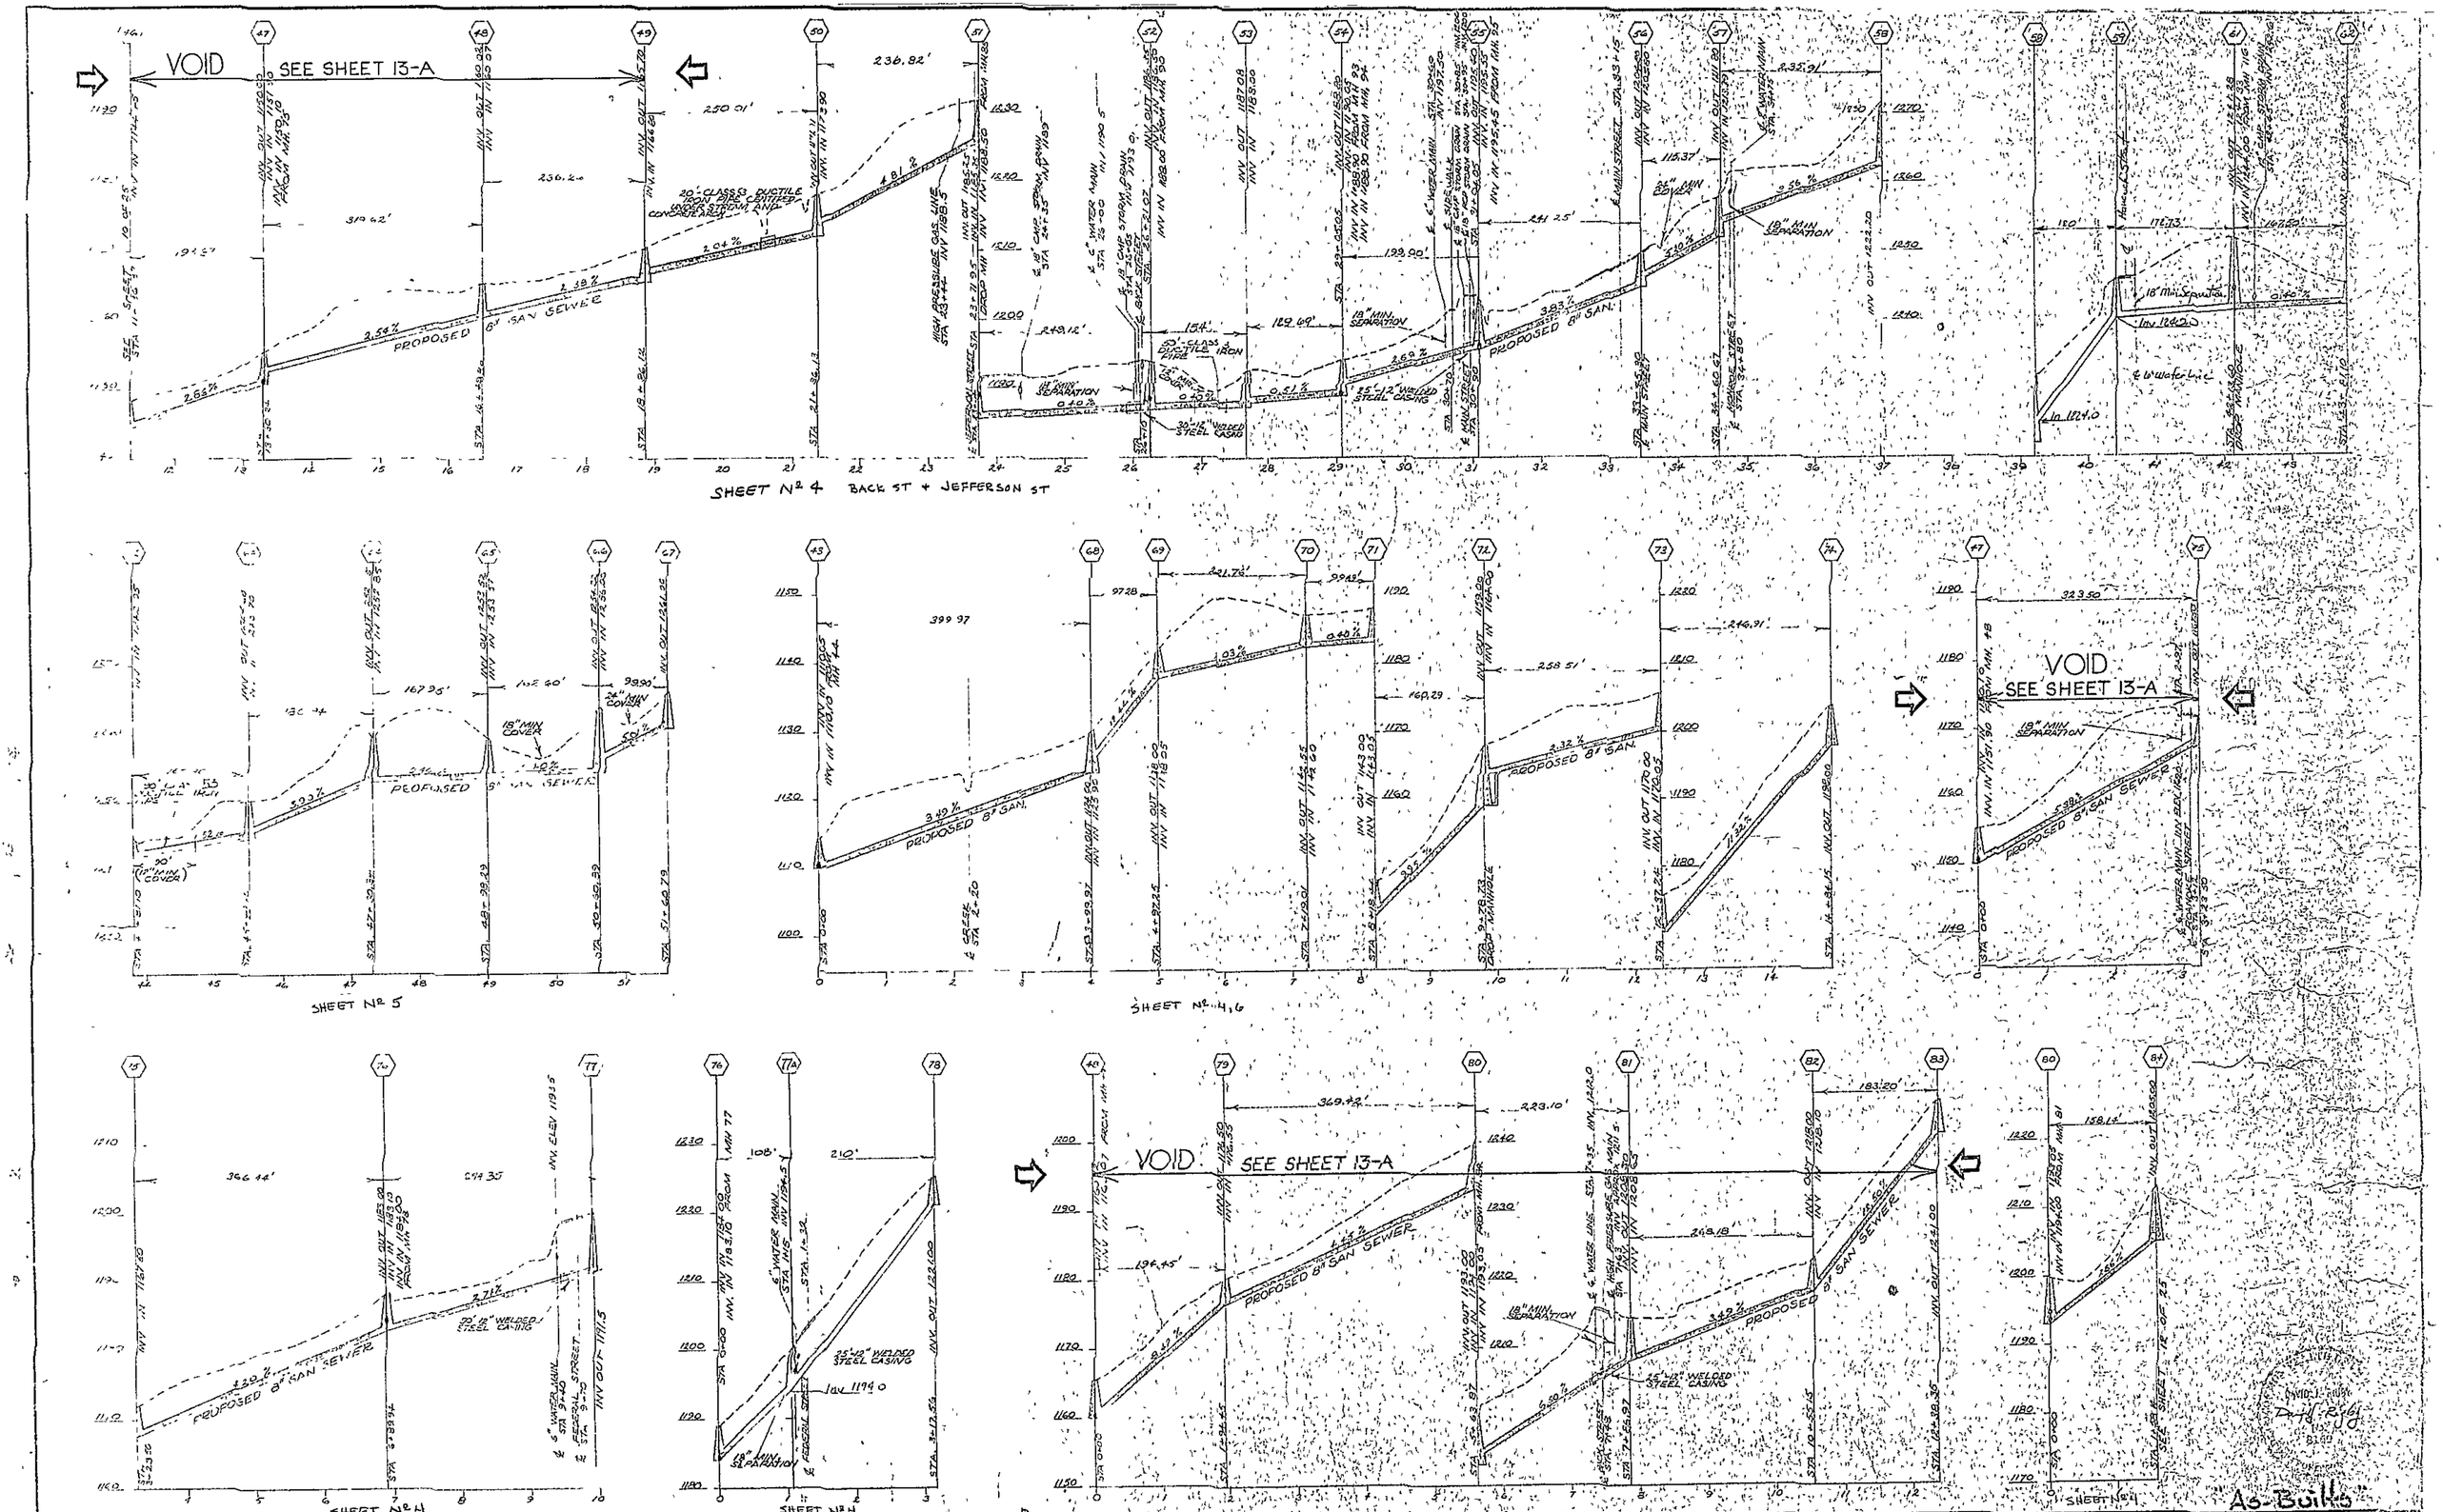

DRAPER – ADEN ASSOCIATES, INC.
ENGINEERS · SURVEYORS · PLANNERS
BLACKSBURG, VIRGINIA

DESIGNED EAT
DRAWN EAT
CHECKED DJR
DATE SEPTEMBER 1, 1977

TOWN OF FINCASTLE
WASTEWATER COLLECTION AND TREATMENT SYSTEM
BOTETOURT COUNTY, VIRGINIA

REVISIONS: 3-27-79 See Sh 13-A

SCALE: HORIZ. 1" = 100' VERT. 1" = 10'

PLAN Nº T-75-194

SHEET 11 OF 25