


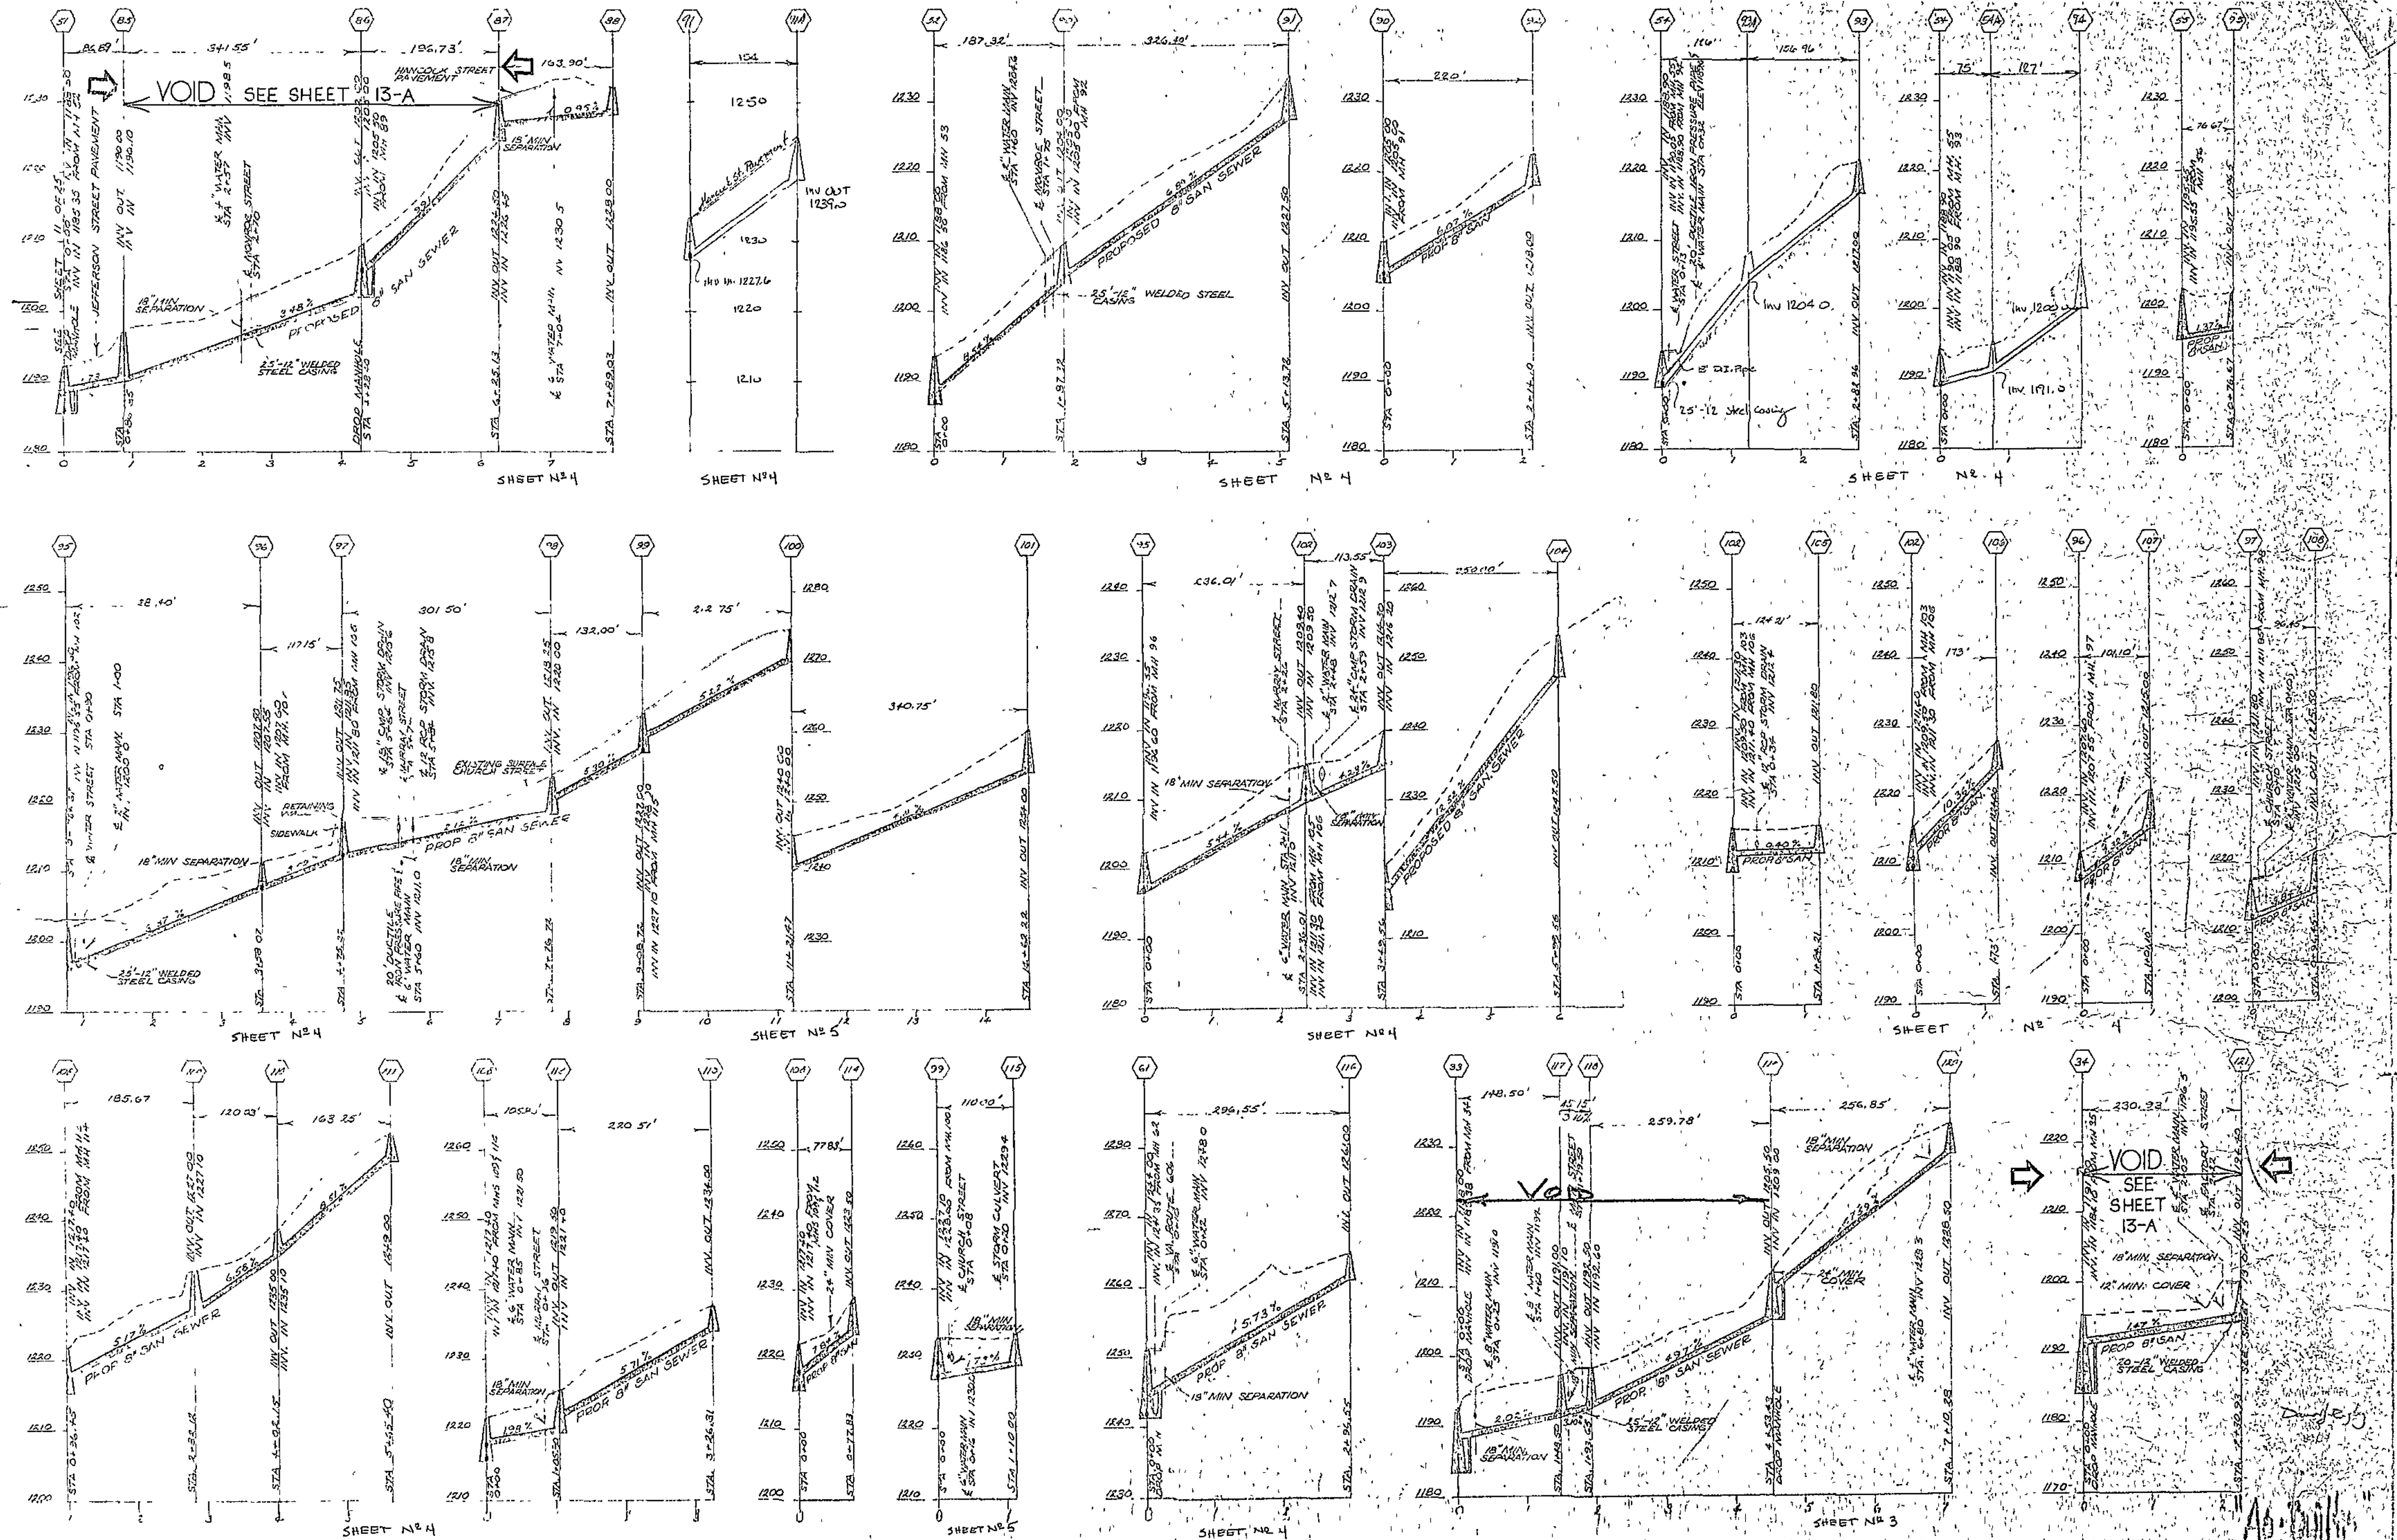

DRAPER - ADEN ASSOCIATES, INC.
ENGINEERS - SURVEYORS - PLANNERS
BLACKSBURG, VIRGINIA

DESIGNED D.J.R., EAT
DRAWN E.A.T.
CHECKED D.J.R.
DATE SEPTEMBER 1, 1977

TOWN OF FINCASTLE
WASTEWATER COLLECTION AND TREATMENT SYSTEM
BOTETOURT COUNTY, VIRGINIA

REVISIONS:
3-27-79 SET 34 13A

SCALE: HORIZ. 1"=100'
VERT. 1"=10'
PLAN NO. T-75-194

SHEET
12 OF 25