


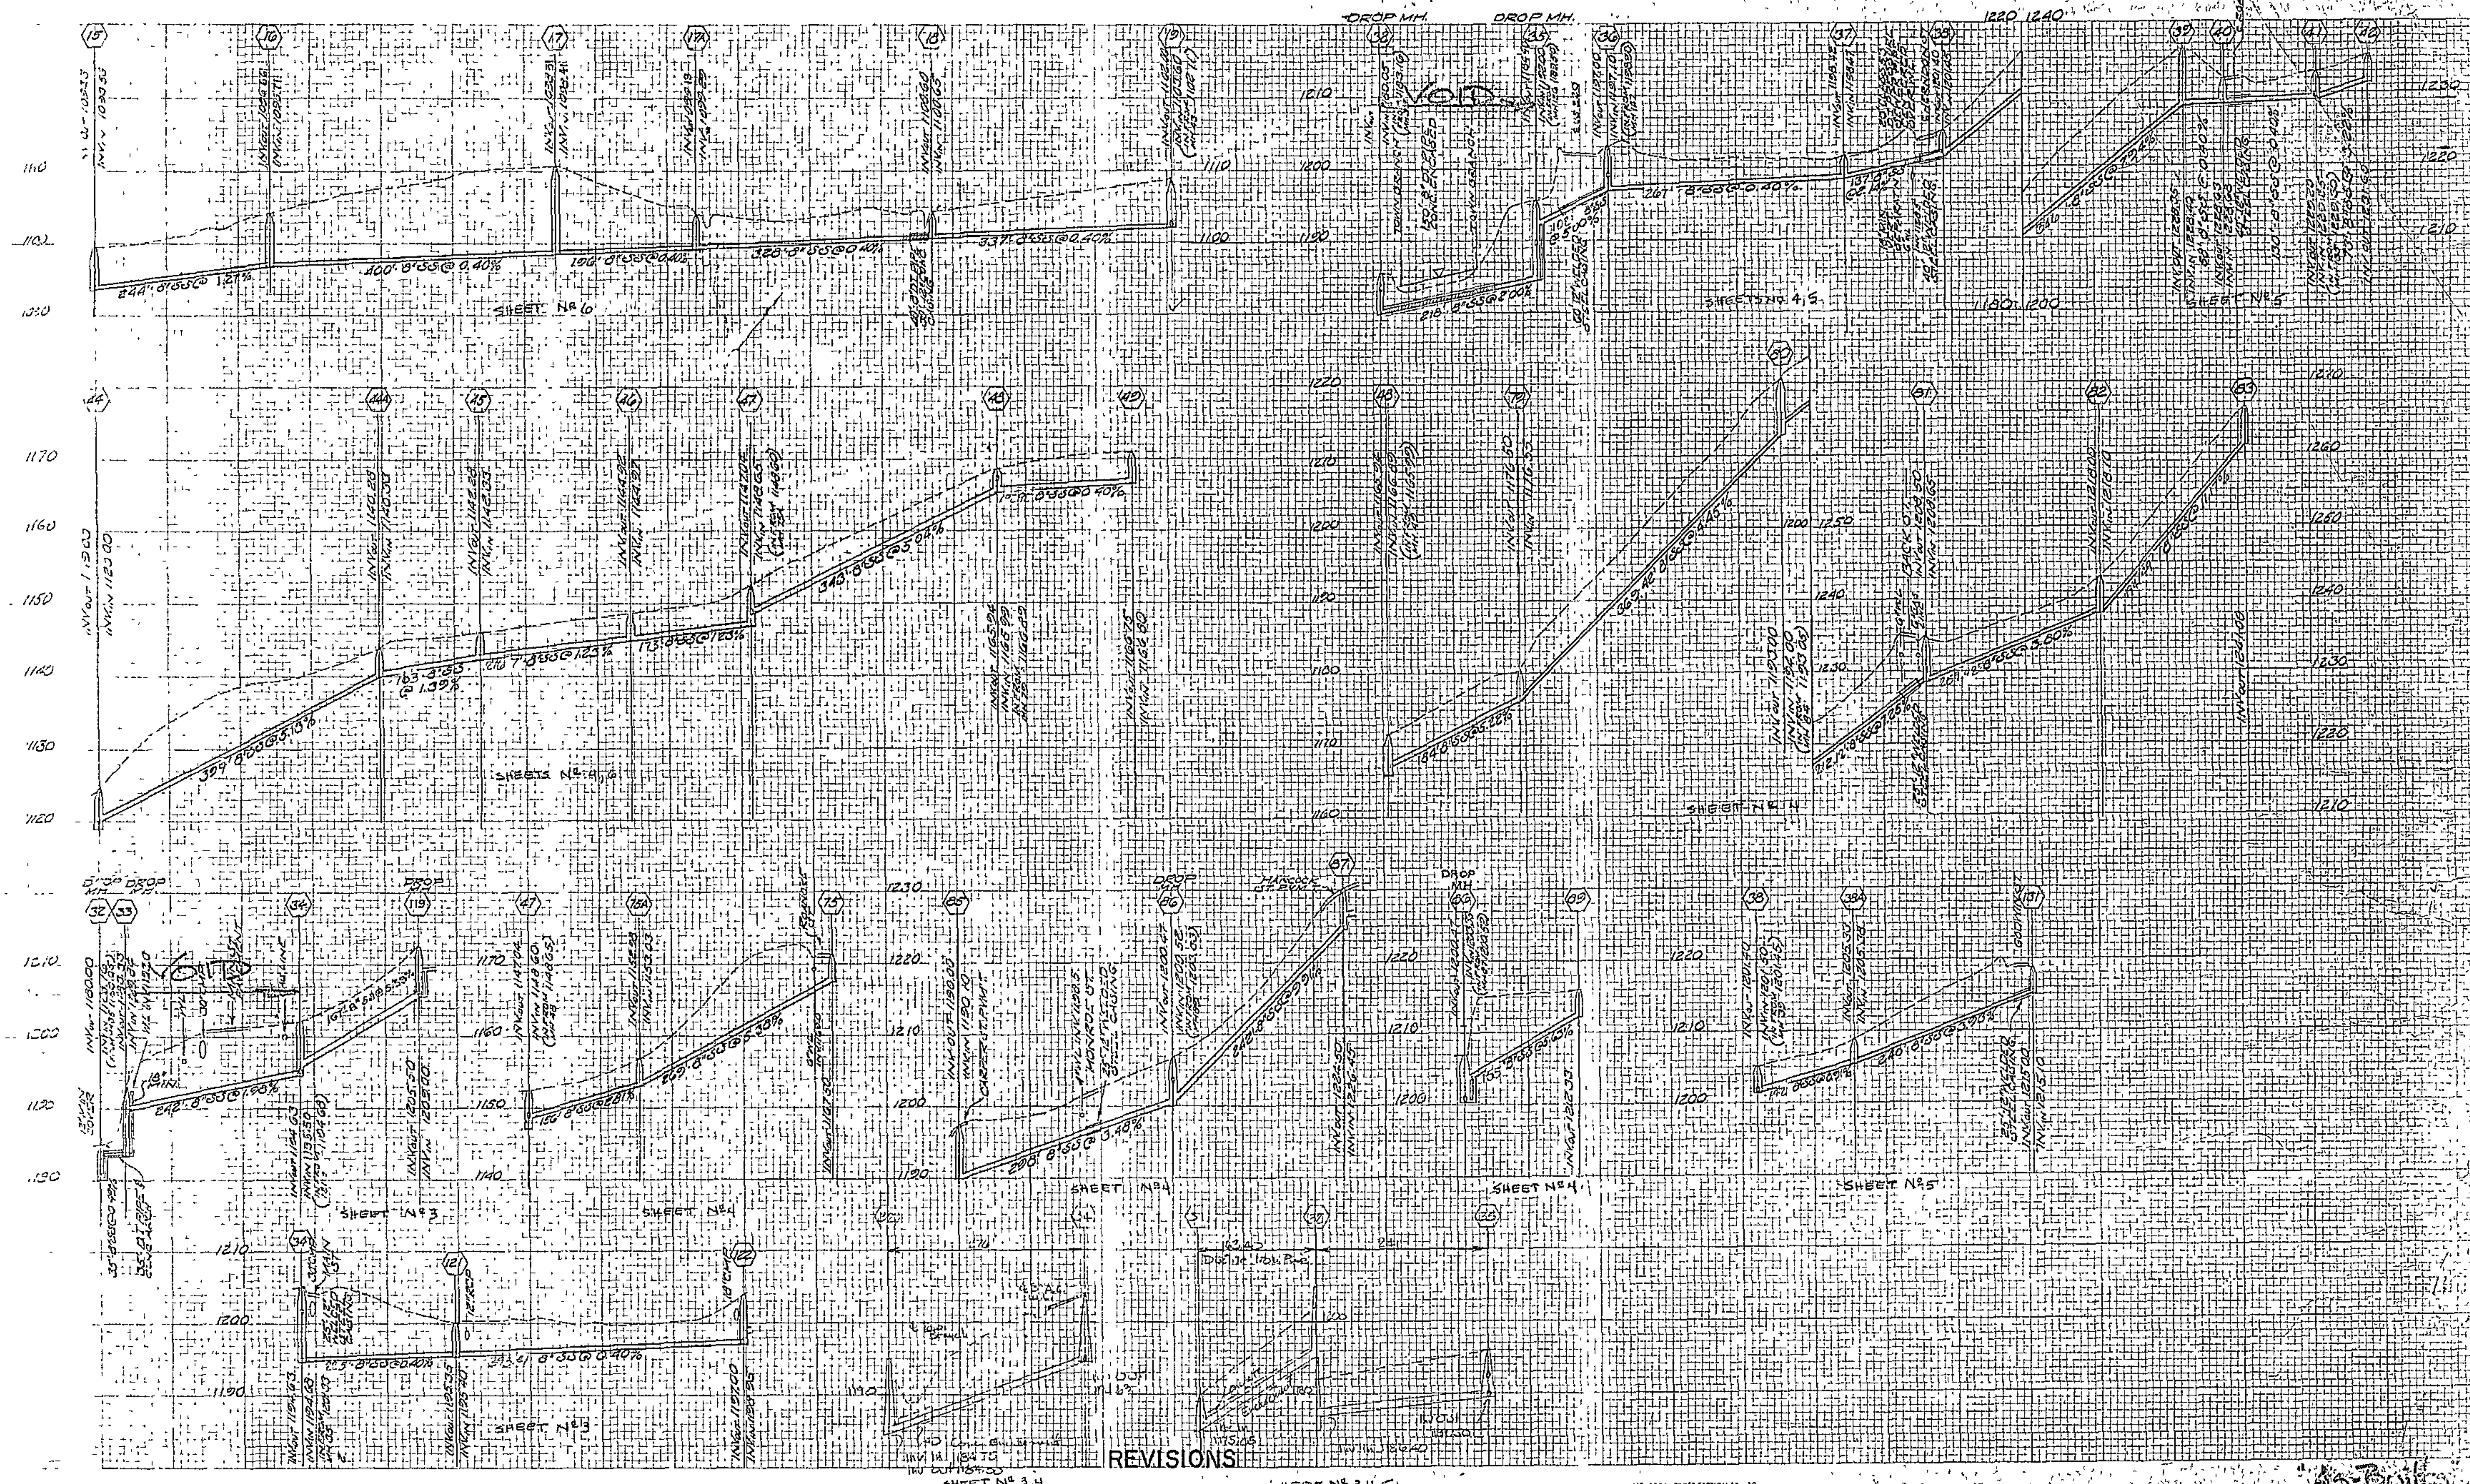

REVISIONS

DRAPER - ADEN ASSOCIATES, INC.
ENGINEERS - SURVEYORS - PLANNERS
BLACKSBURG, VIRGINIA

DESIGNED DJR, LHW
DRAWN LHW
CHECKED DJR
DATE MARCH 27, 1979

TOWN OF FINCASTLE
WASTEWATER COLLECTION AND TREATMENT SYSTEM
BOTETOUR COUNTY, VIRGINIA

REVISIONS

SCALE: HORIZ. 1"=100'
VERT. 1"=10'
PLAN NO. T-75-194

SHEET 13A OF 25