


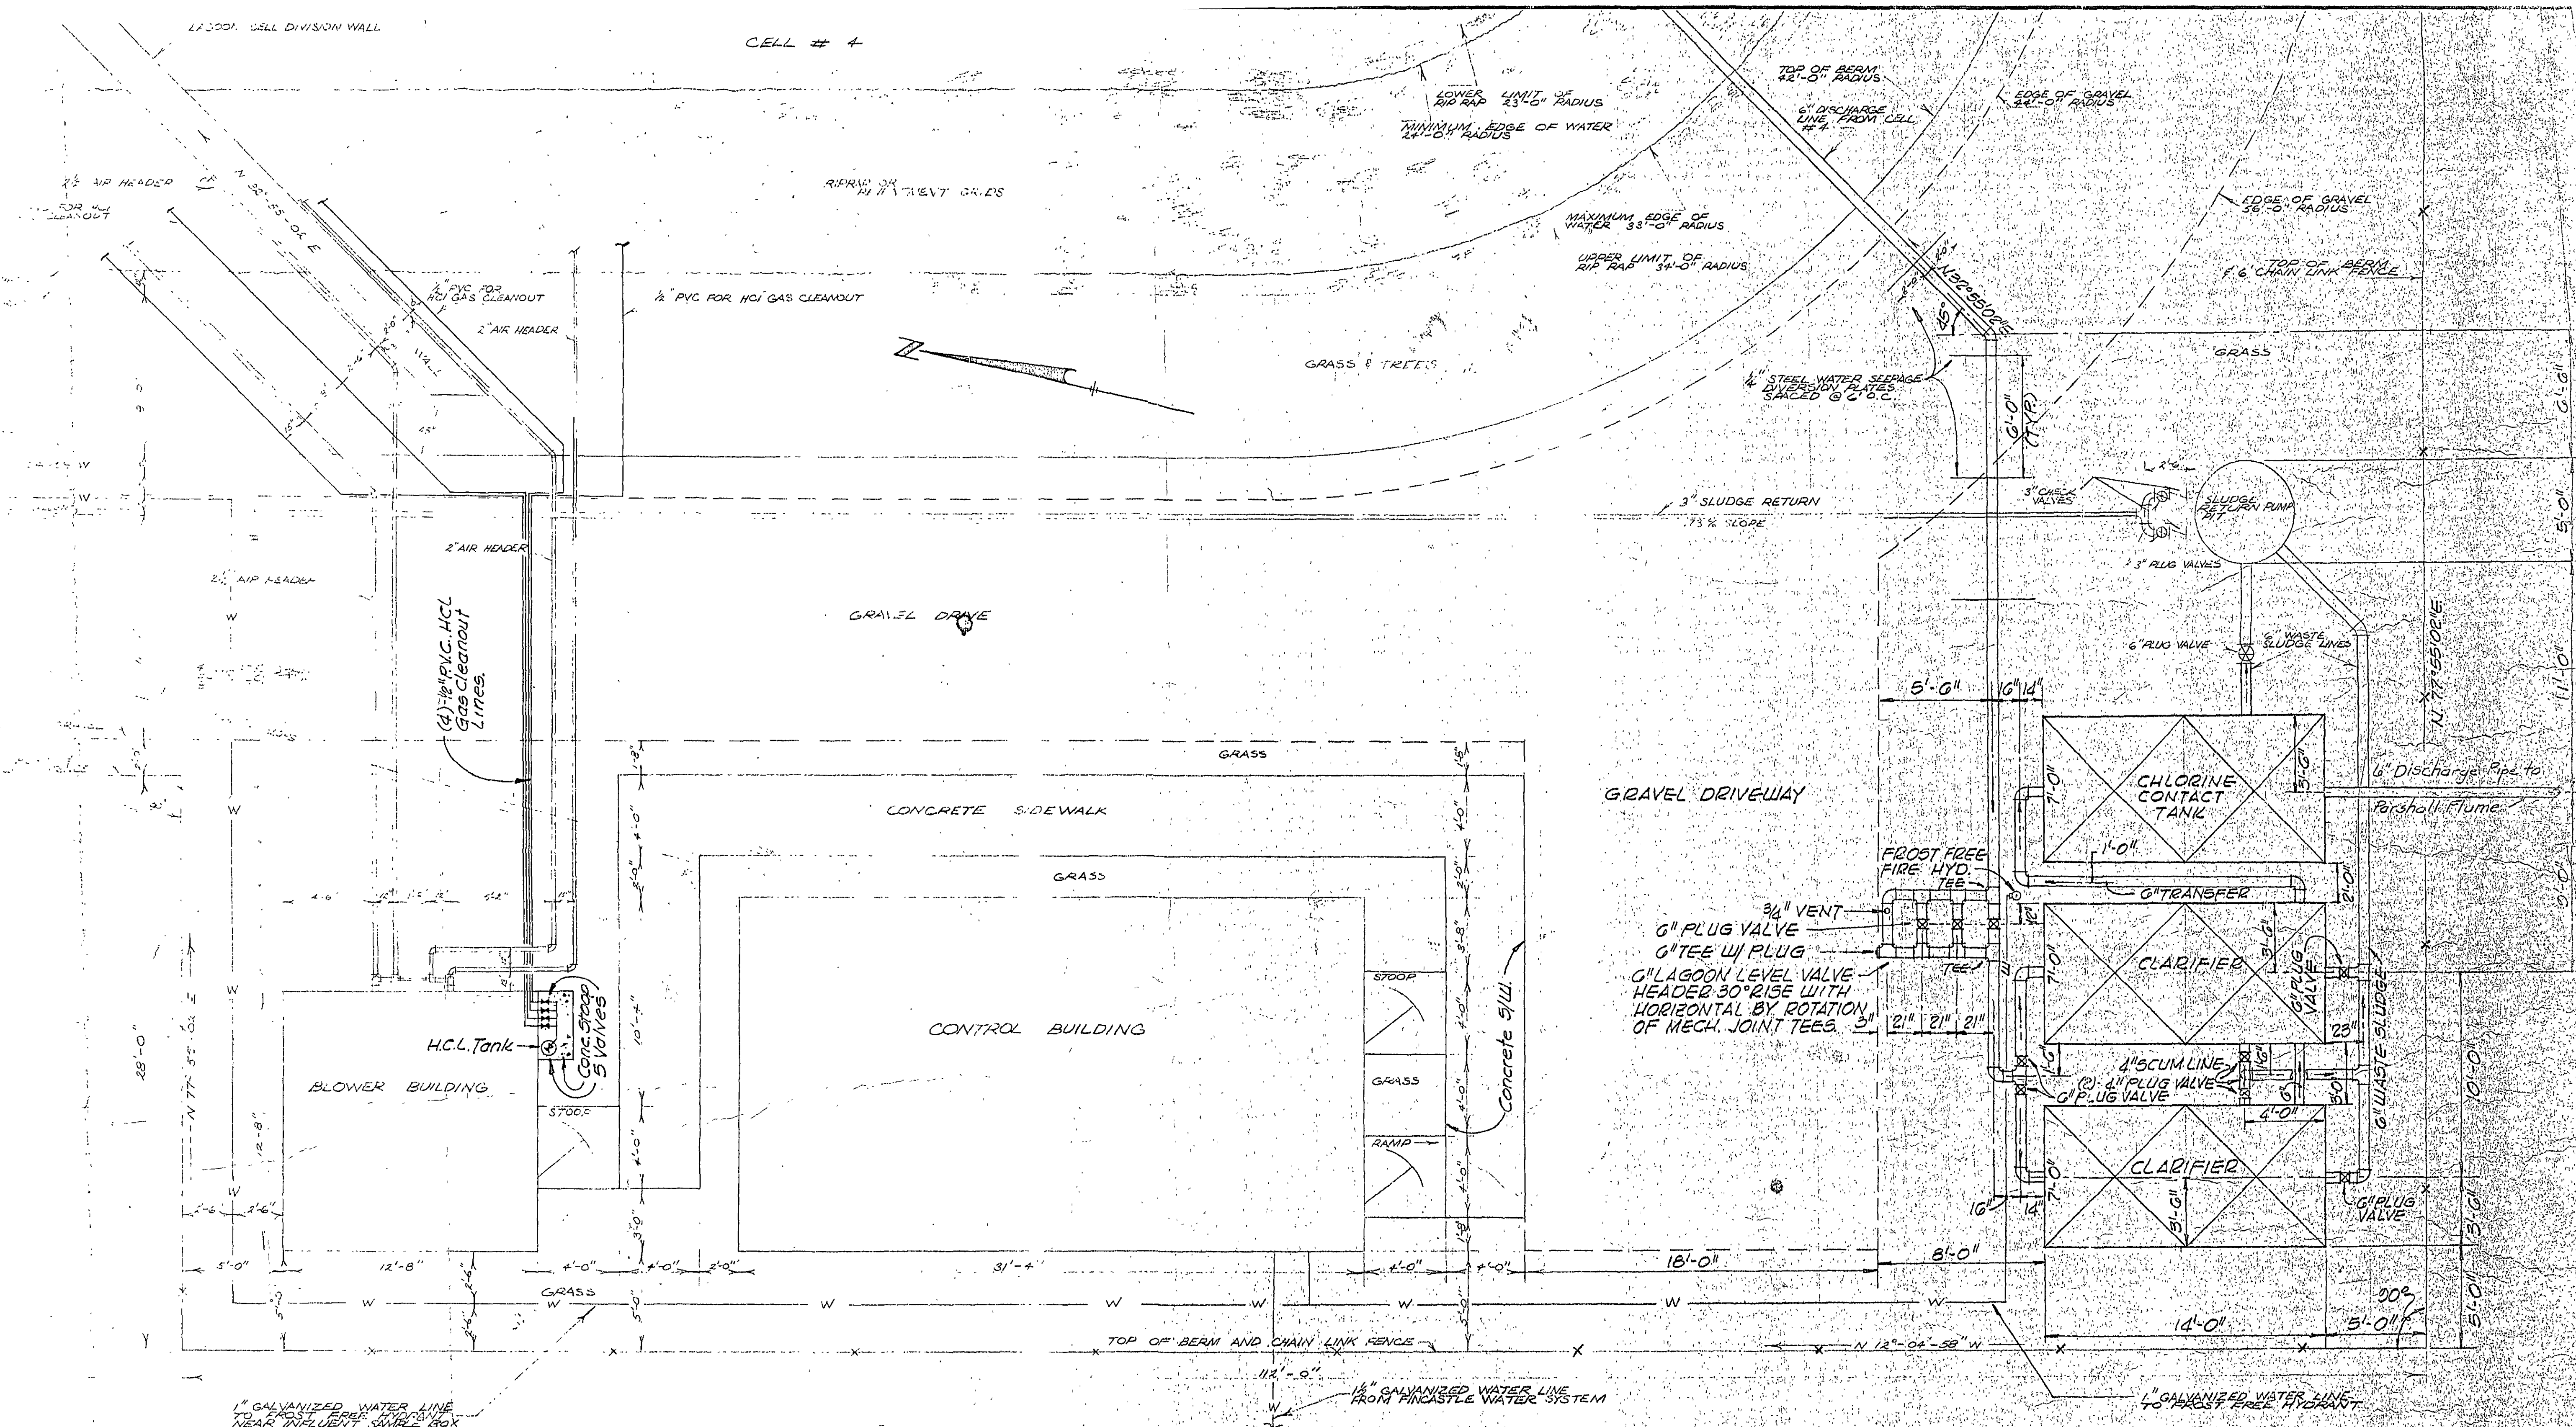

— CONTROL AREA STAKEOUT DETAIL
SCALE: 1/4" = 1'-0"

ADEN ASSOCIATES, INC.
ENGINEERS • SURVEYORS • PLANNERS
BLACKSBURG, VIRGINIA

DESIGNED D.J.R.
DRAWN E.A.T.
CHECKED D.J.R.
DATE SEPTEMBER 1, 1977

TOWN OF FINCASTLE
WASTEWATER COLLECTION AND TREATMENT SYSTEM

REVISIONS:
SHOWING NEW CLARIFIER
LOCATIONS 2-2-B, C, E, F

SCALE: 1/4" = 1'-0"
PLAN No. T-75-194

SHEET
19 OF 25