N:\DWGS\96XXX\96081\SEWER\ESCPLAN2.DWG

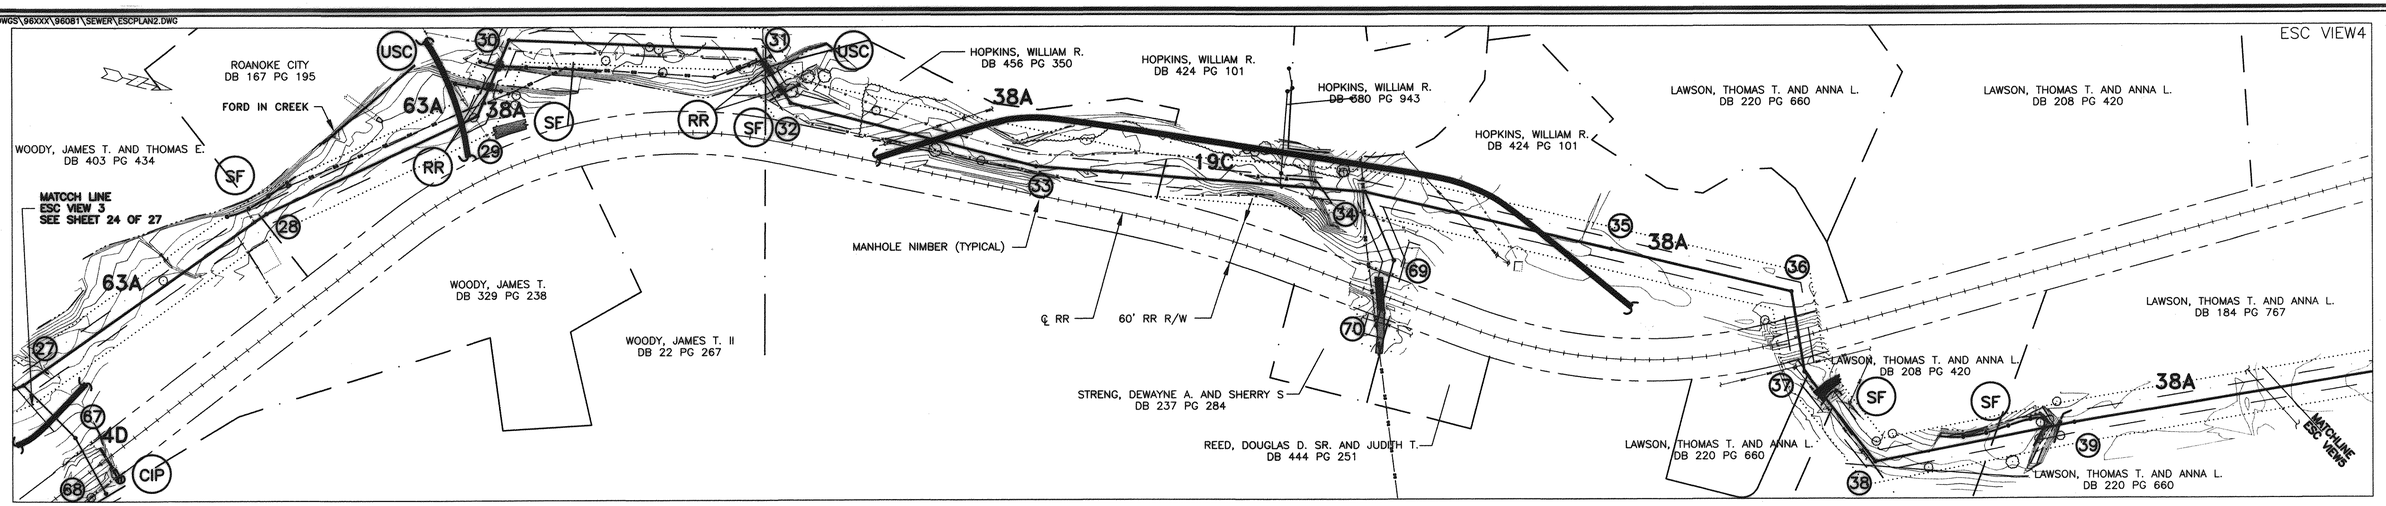

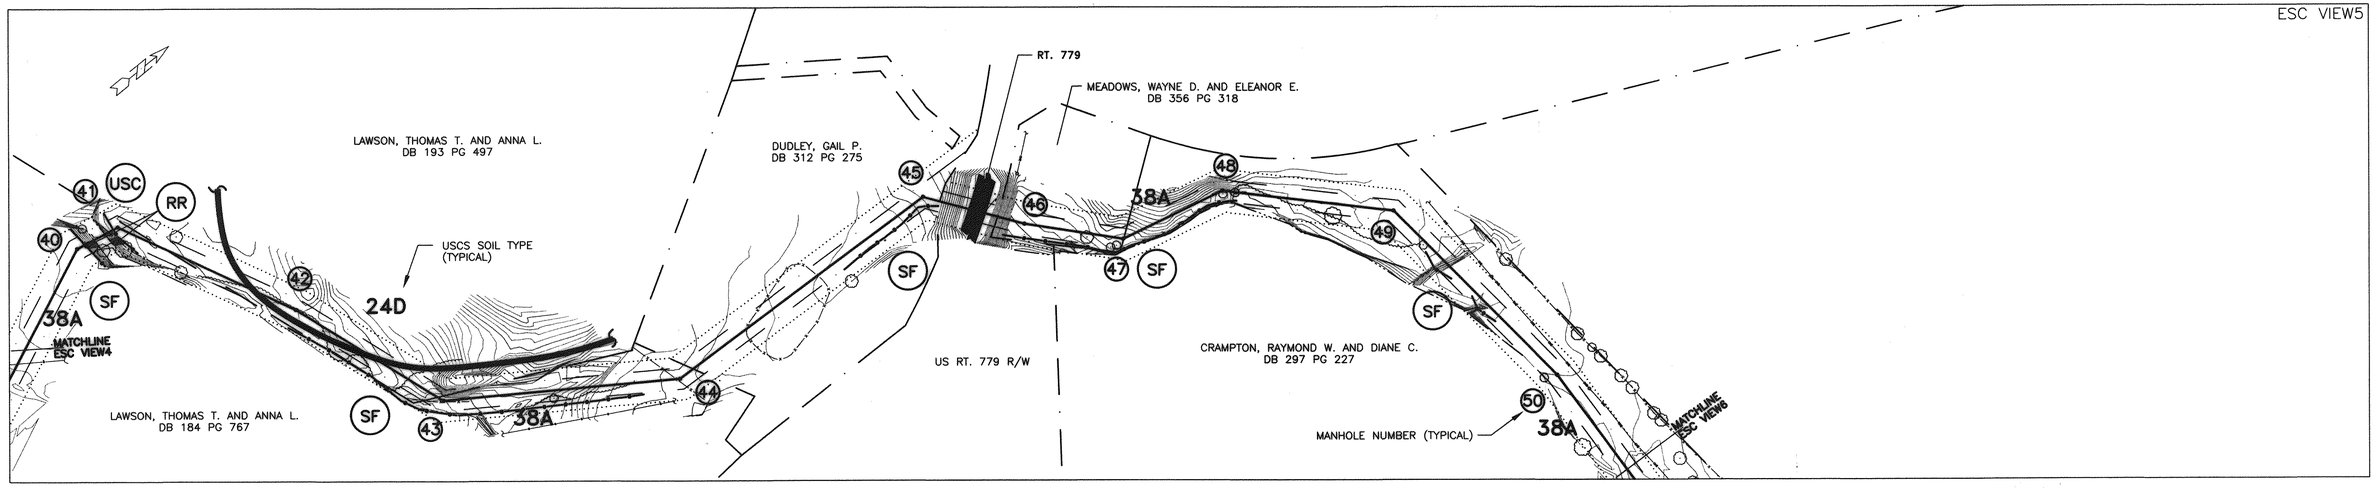

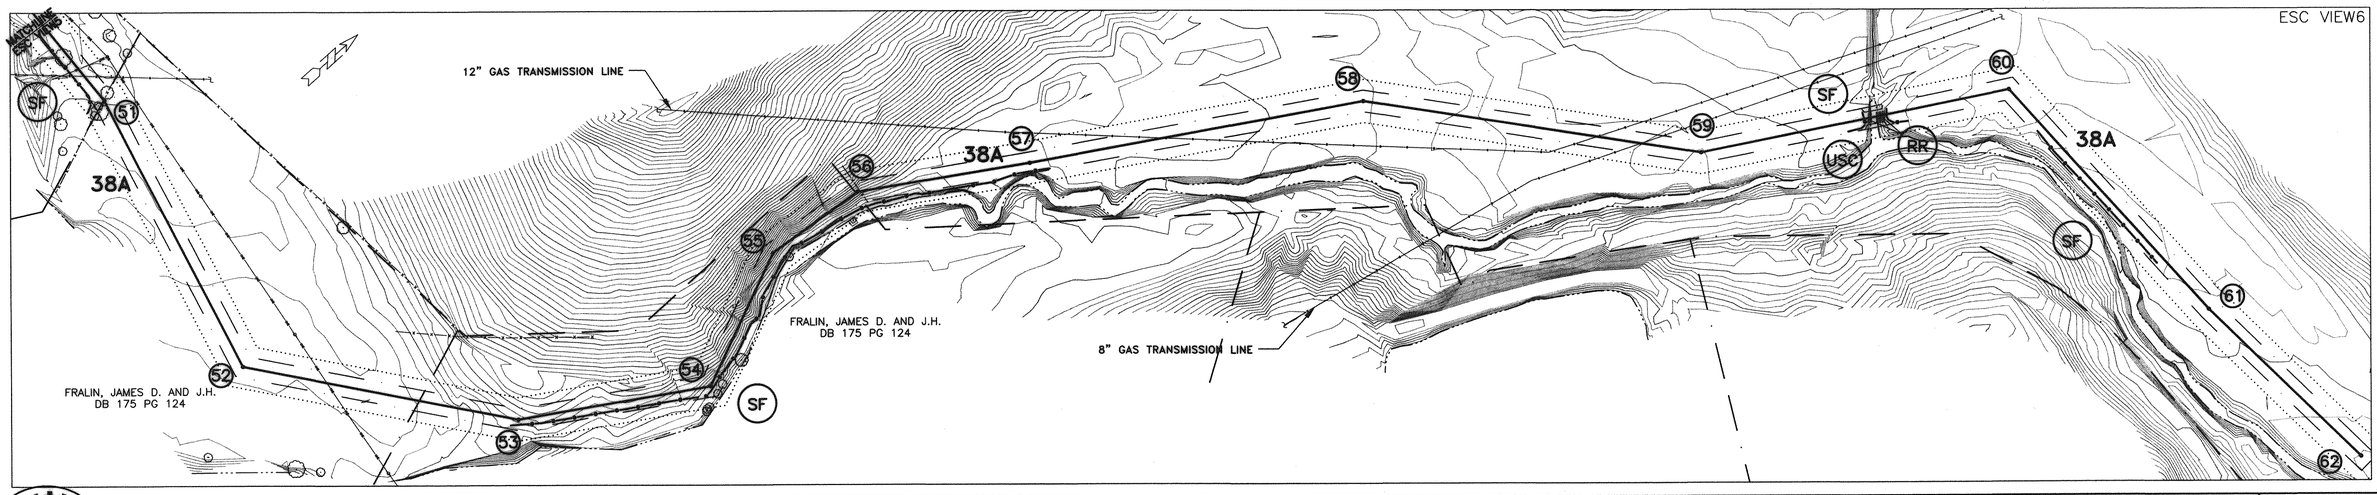

ENGINEERING CONCEPTS, INC.
20 S. ROANOKE ST., PO BOX 619
FINCASTLE, VIRGINIA 24090
540.473.1253 FAX: 540.473.1254

AS-BUILT

Drawn	PSN
Designed	SCG
Checked	WPJ/JST
Approved	WPJ

GREENFIELD COLLECTOR AND TINKER CREEK EXTENSION

EROSION & SEDIMENT CONTROL PLAN

1"=100'

DECEMBER 1996

PROJECT: 96081