
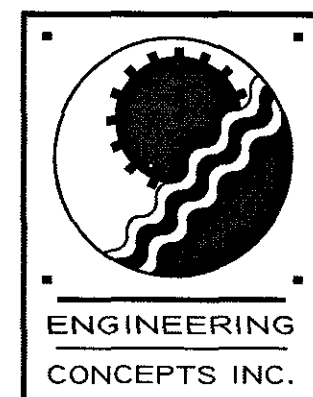


ZONED: M-2
MIN. LOT SIZE: 5 AC. (24.6 AC. PROVIDED)
SETBACK REQ'D: 50' (176' PROVIDED)
MAX. BLDG. COVERAGE: 40% (2.4% PROVIDED)
MAX. LOT COVERAGE: 70% (14.6% PROVIDED)
PARKING REQ'D PER CLIENT: 200 SPACES (200 PROVIDED)

 DENOTES STANDARD PAVEMENT SECTION
 DENOTES HEAVY DUTY PAVING SECTION

SEE MISC. DETAIL SHEET
C5 FOR EXTERIOR STAIR
SPECIFICATIONS

STAIR INSET
SCALE: 1" = 10'

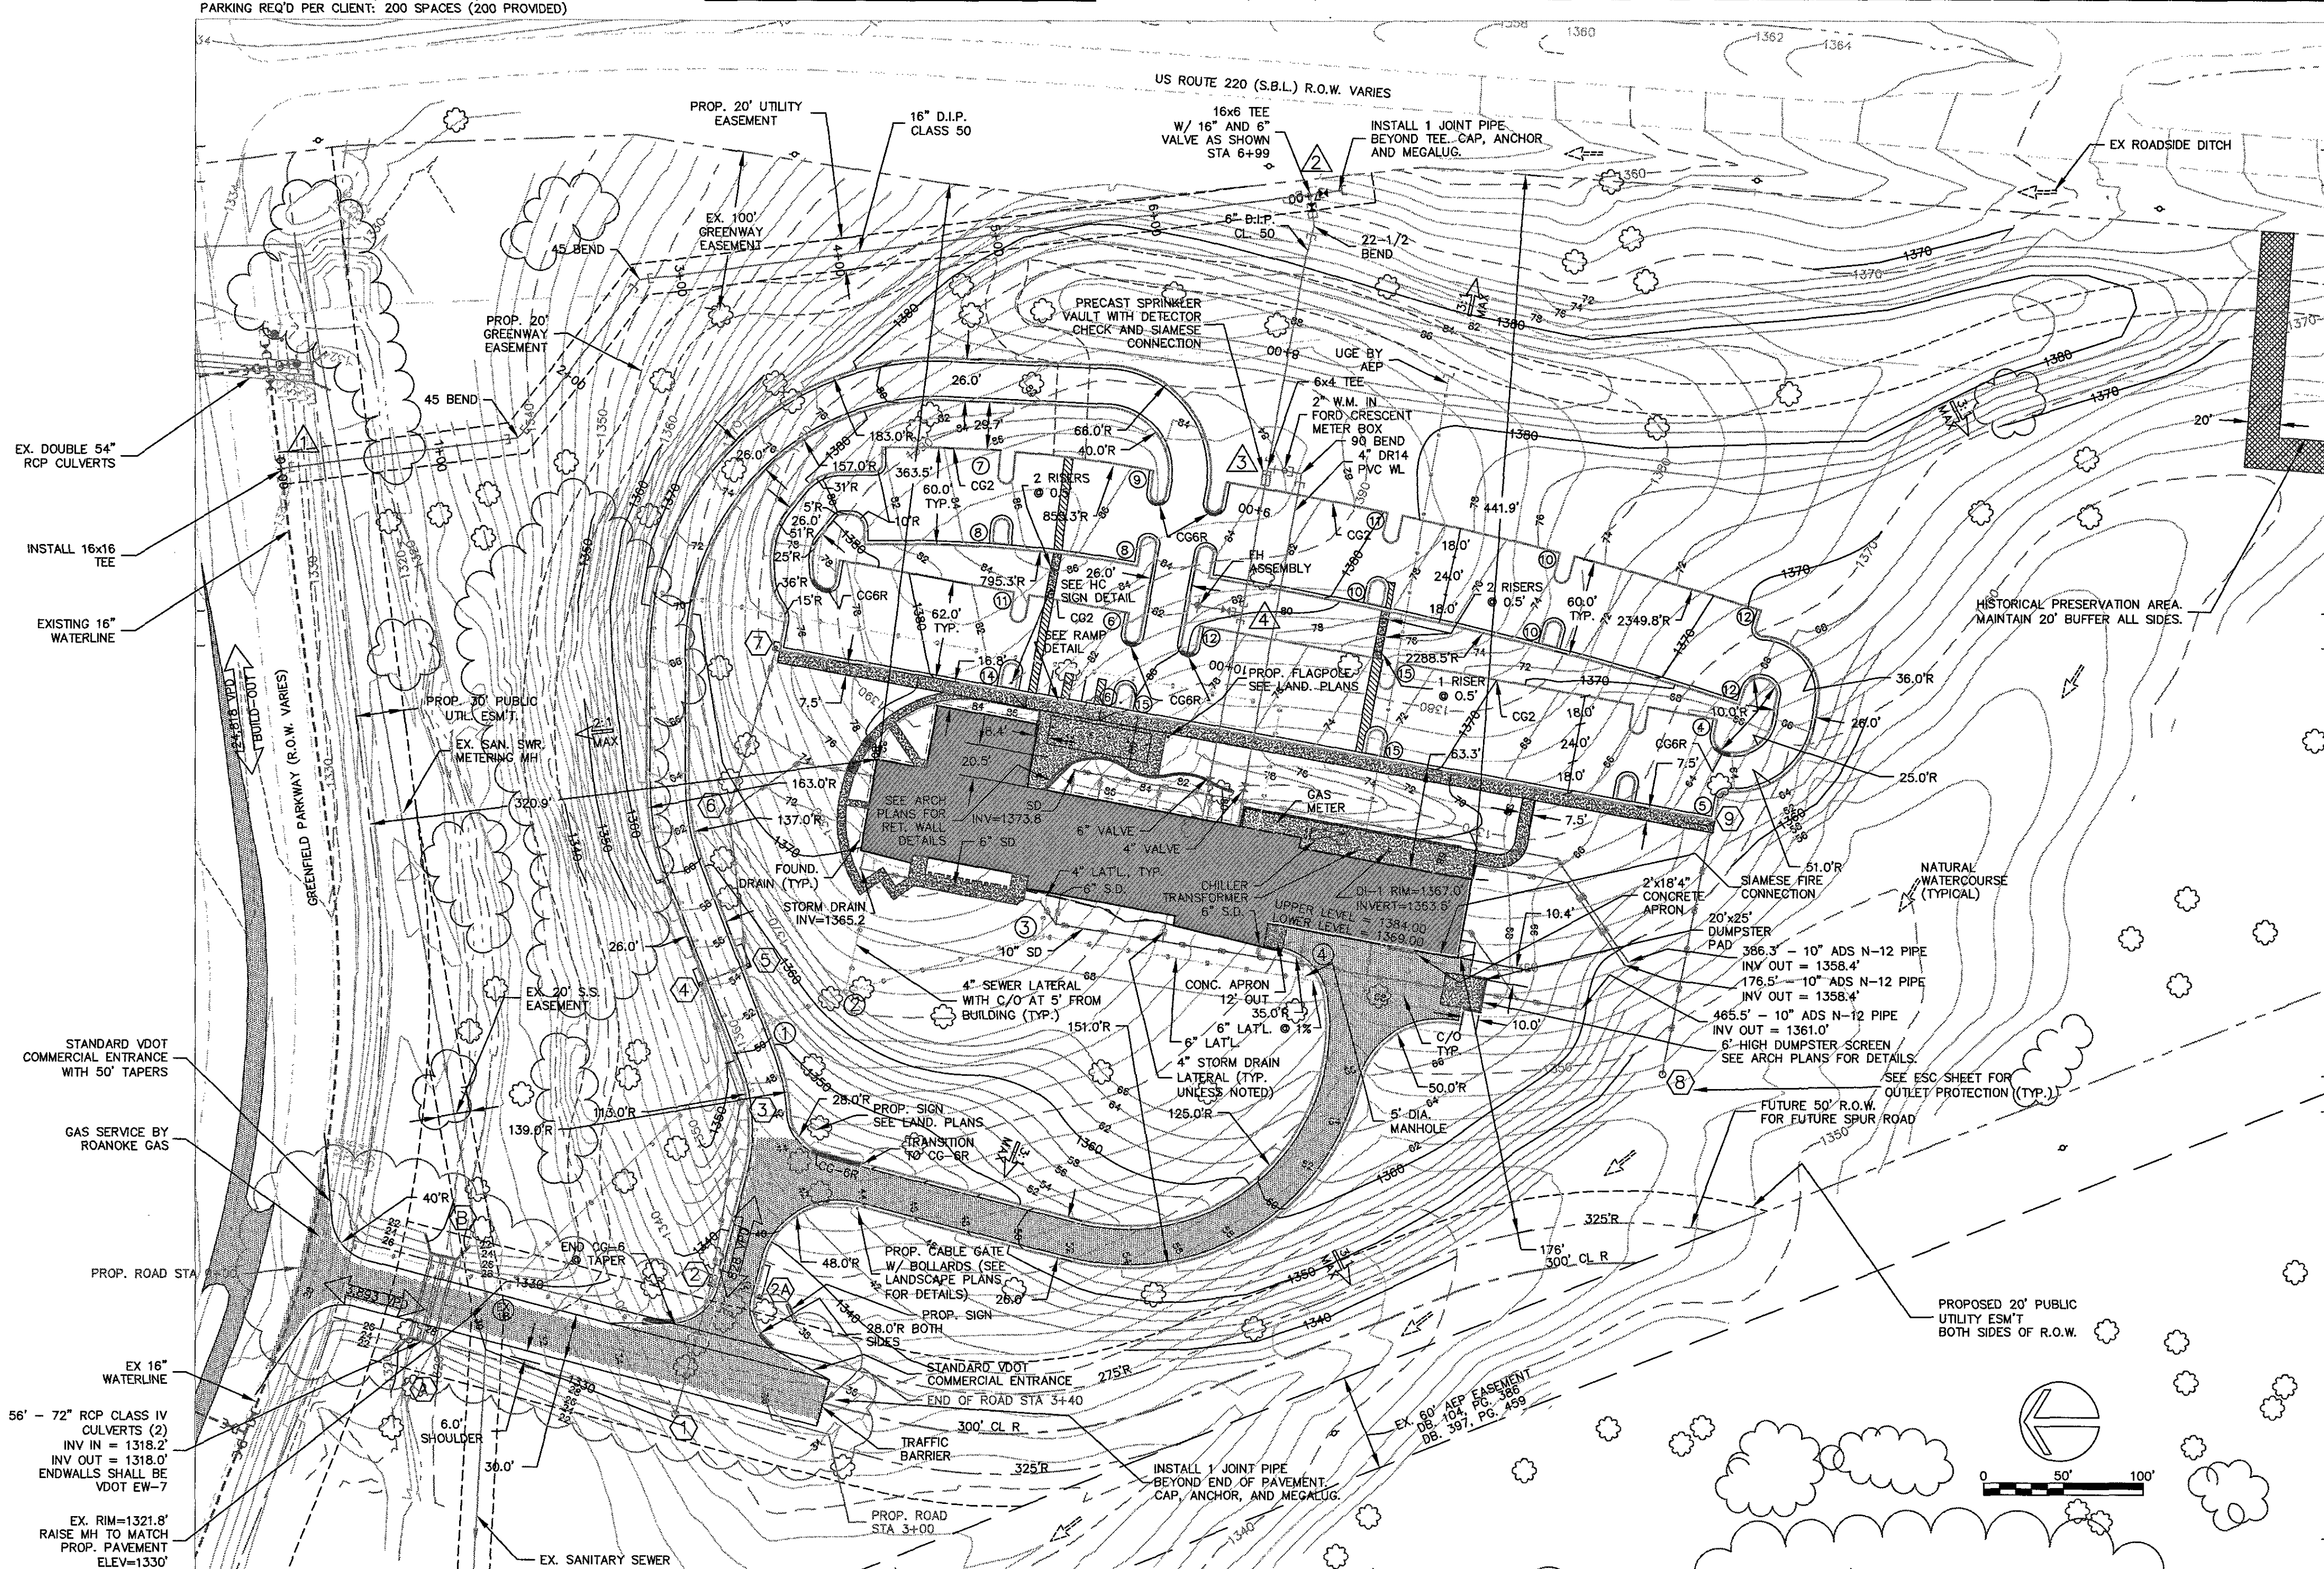

PROJECT TITLE

EDUCATION AND
TRAINING CENTER
AT GREENFIELD
BOTETOURT COUNTY,
VIRGINIA

Architecture
Engineering
Planning
Interiors

SFCS

Sherertz Franklin Crawford Shaffner Inc.
305 S. Jefferson St., Roanoke, VA 24011

Phone 540 344-6664
FAX 540 343-8925
eMail sfcs.com

PROJECT DESIGNER :		
PROJECT ARCHITECT :		
PROJECT ENGINEER :	RHW/JDE	
DRAWN BY :	RHW	
CHECKED BY :	JDE/WPJ	
APPROVED BY :	WPJ	

NO.	REVISION	DESCRIPTION	DATE
1	NEW WATERLINE ALIGNMENT		2/24/99
2	ADDED 5' DIA. MH NO. 4		2/24/99
3	REDIRECTED LATERAL TO MH 2		2/24/99
4	REVISED TURNING LANE SHOWN SEE C-2		3/15/99
5	WIDEN SPUR ROAD TO 30'		4/14/99

DRAWING TITLE
UTILITY AND
DIMENSION PLAN

ECI PROJECT 98113	SFCS COMM. 98308.00	DATE JANUARY 28, 199
DRAWING		SHEET

C-1

1 OF 1