



GREENFIELD TO WETHERWOOD WATERLINE

VIA U.S. ROUTE 220


BOTETOURT COUNTY
DEPARTMENT OF PUBLIC FACILITIES
AND PROGRAMS

BOTETOURT COUNTY, VIRGINIA
DECEMBER, 2000

AS-BUILT
MARCH, 2002

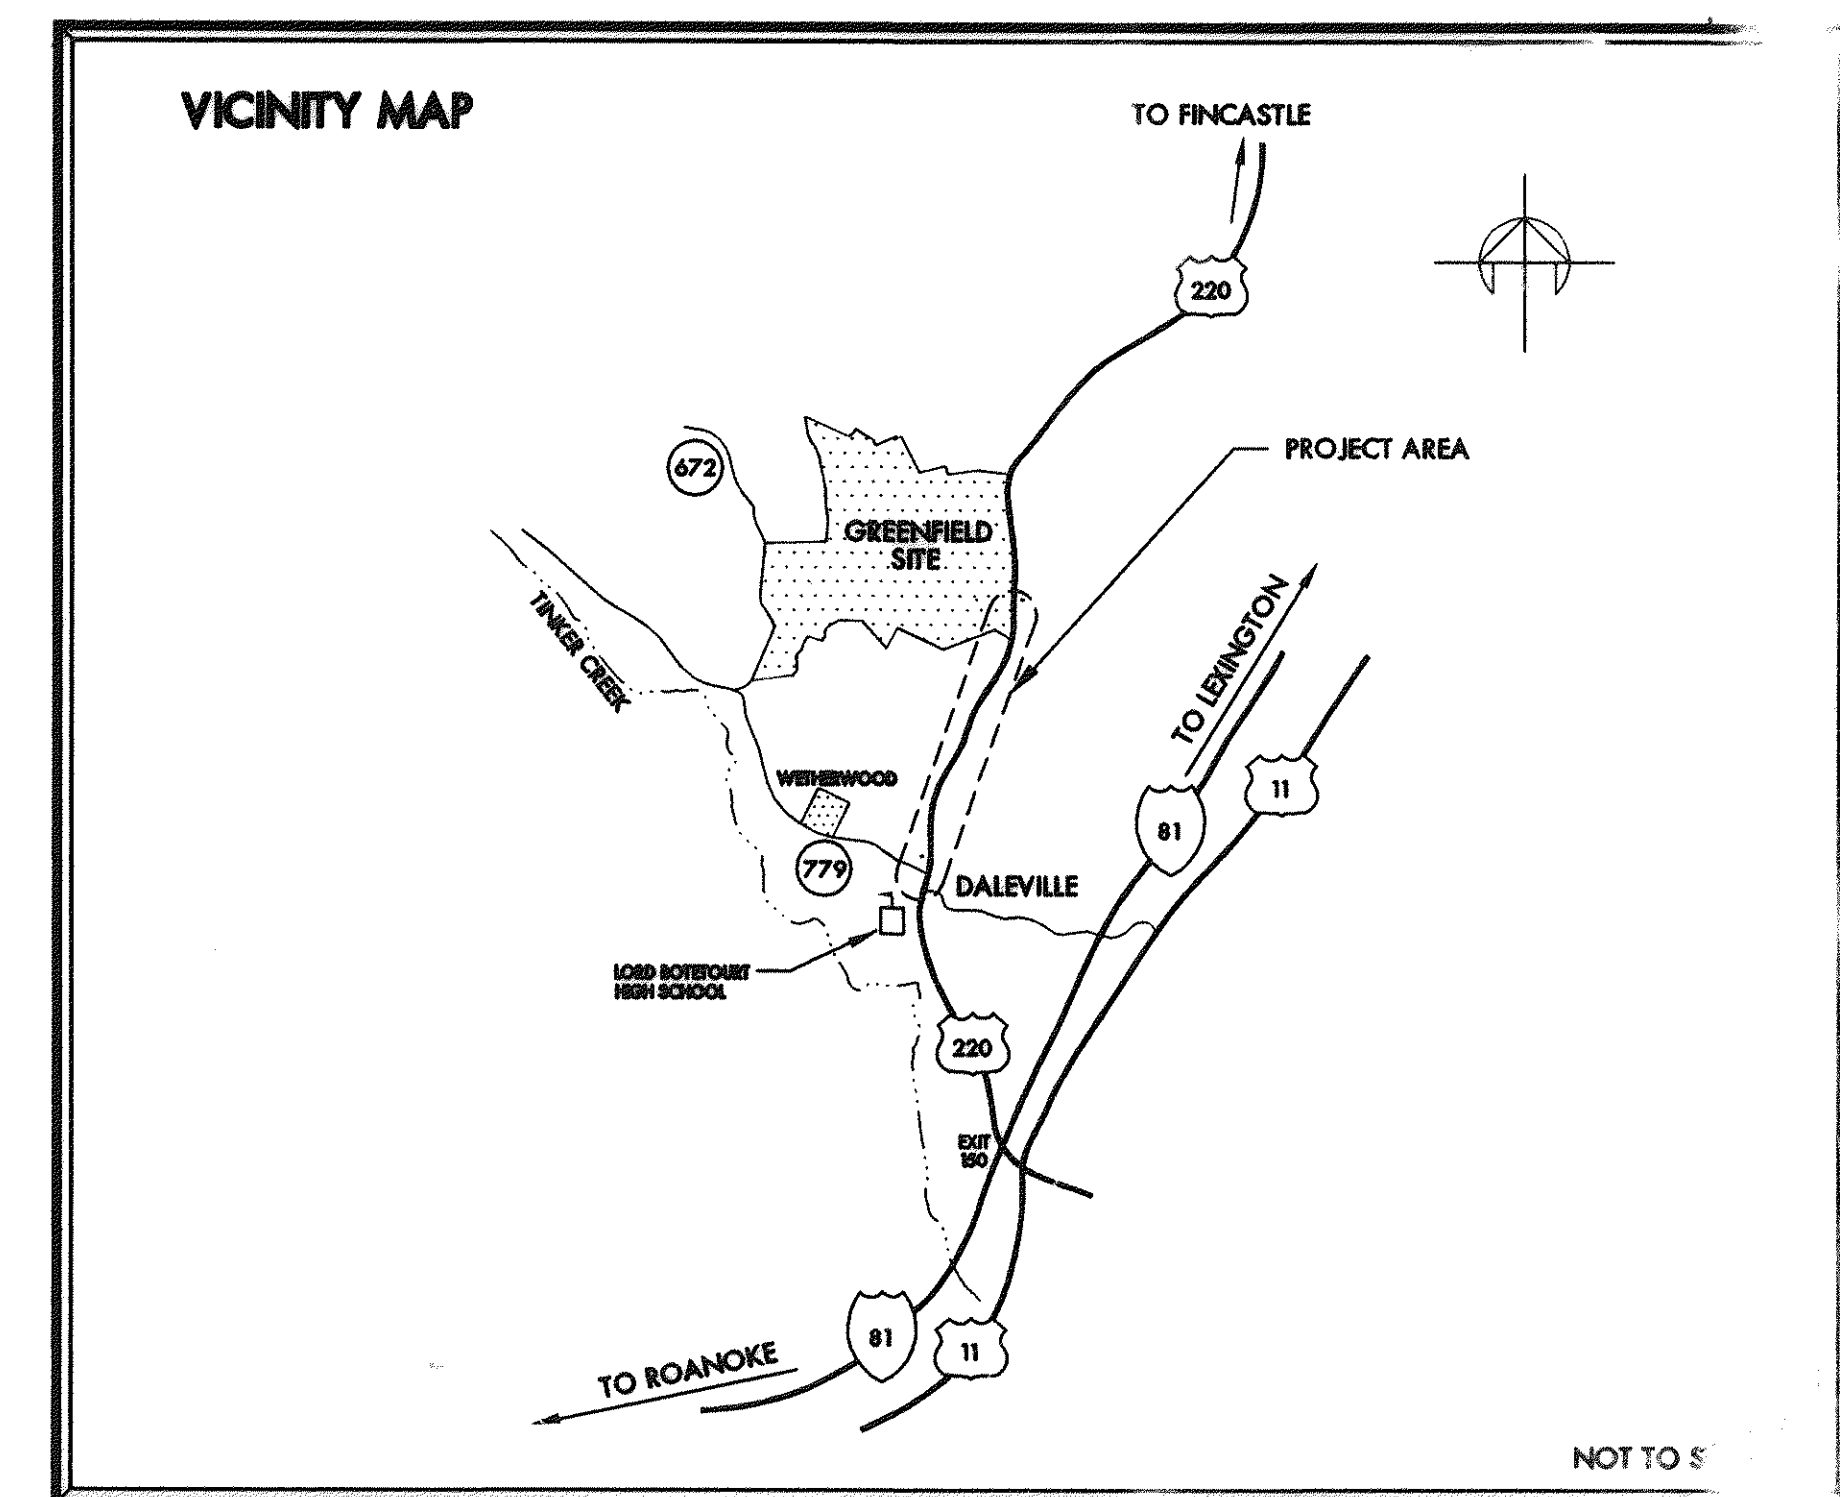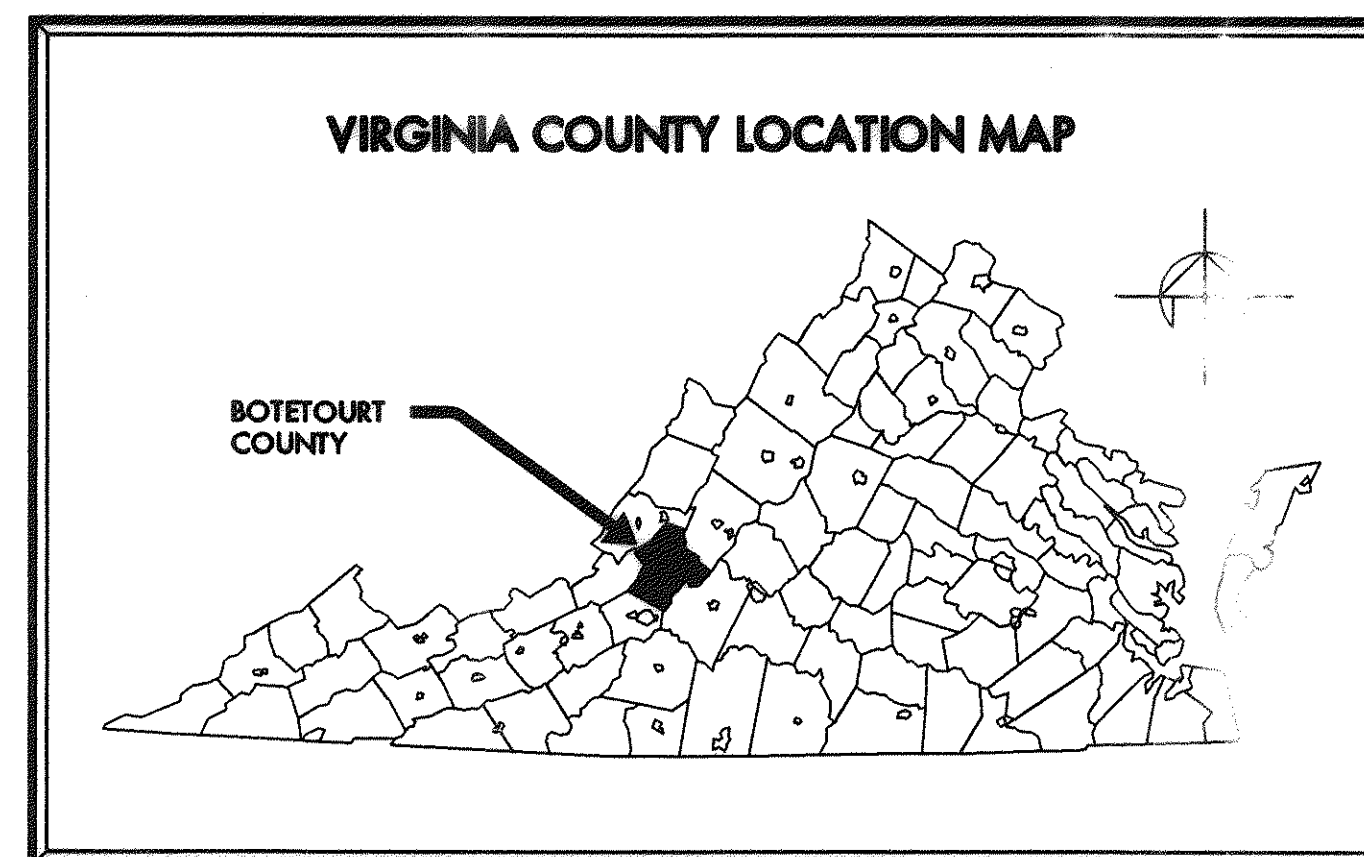

AB
PROJECT NAME: Greenfield to Wetherwood W.L.
DATE: March 2002
TYPE: WATERLINE
LOCATION: R75-220
TOTAL # SHEETS: 14
OF SETS: 1

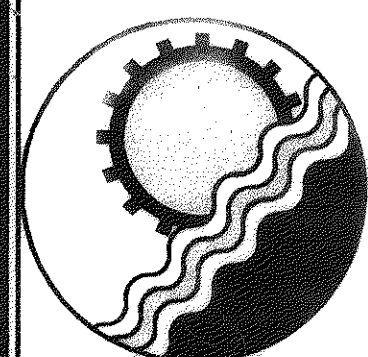

ENGINEERING CONCEPTS, INC.

201 S. ROANOKE ST., PO BOX 619
FINCASTLE, VIRGINIA 24090
540.473.1233 FAX: 540.473.1254

PROJECT 99035 AS-BUILT

OWNER: BOTETOURT

DEPARTMENT OF
PUBLIC FACILITIES
30 W. FINCASTLE

FINCASTLE, VA 24090
540.473.8316

