
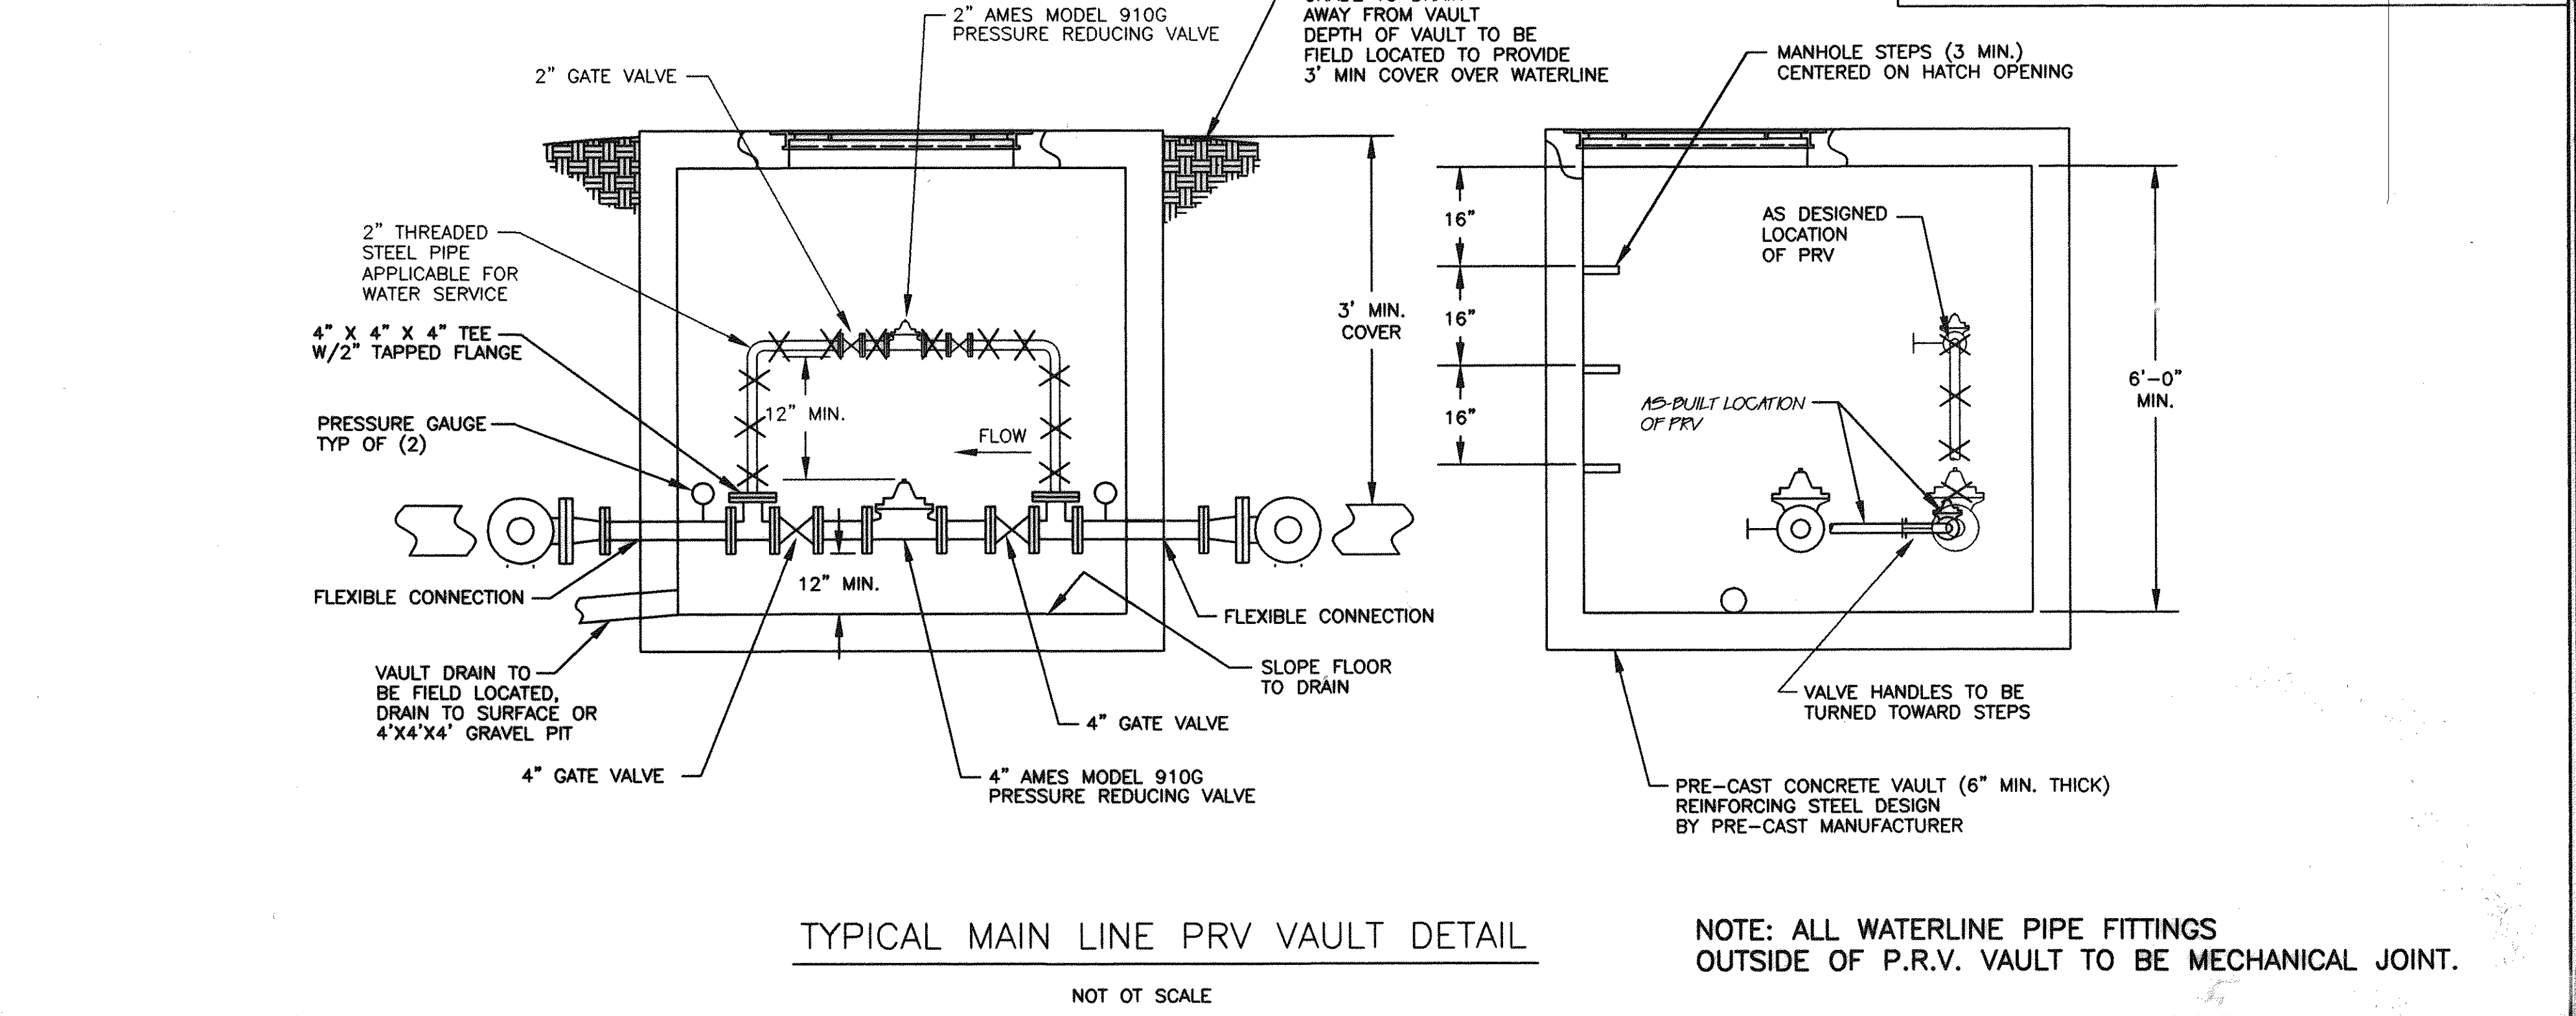
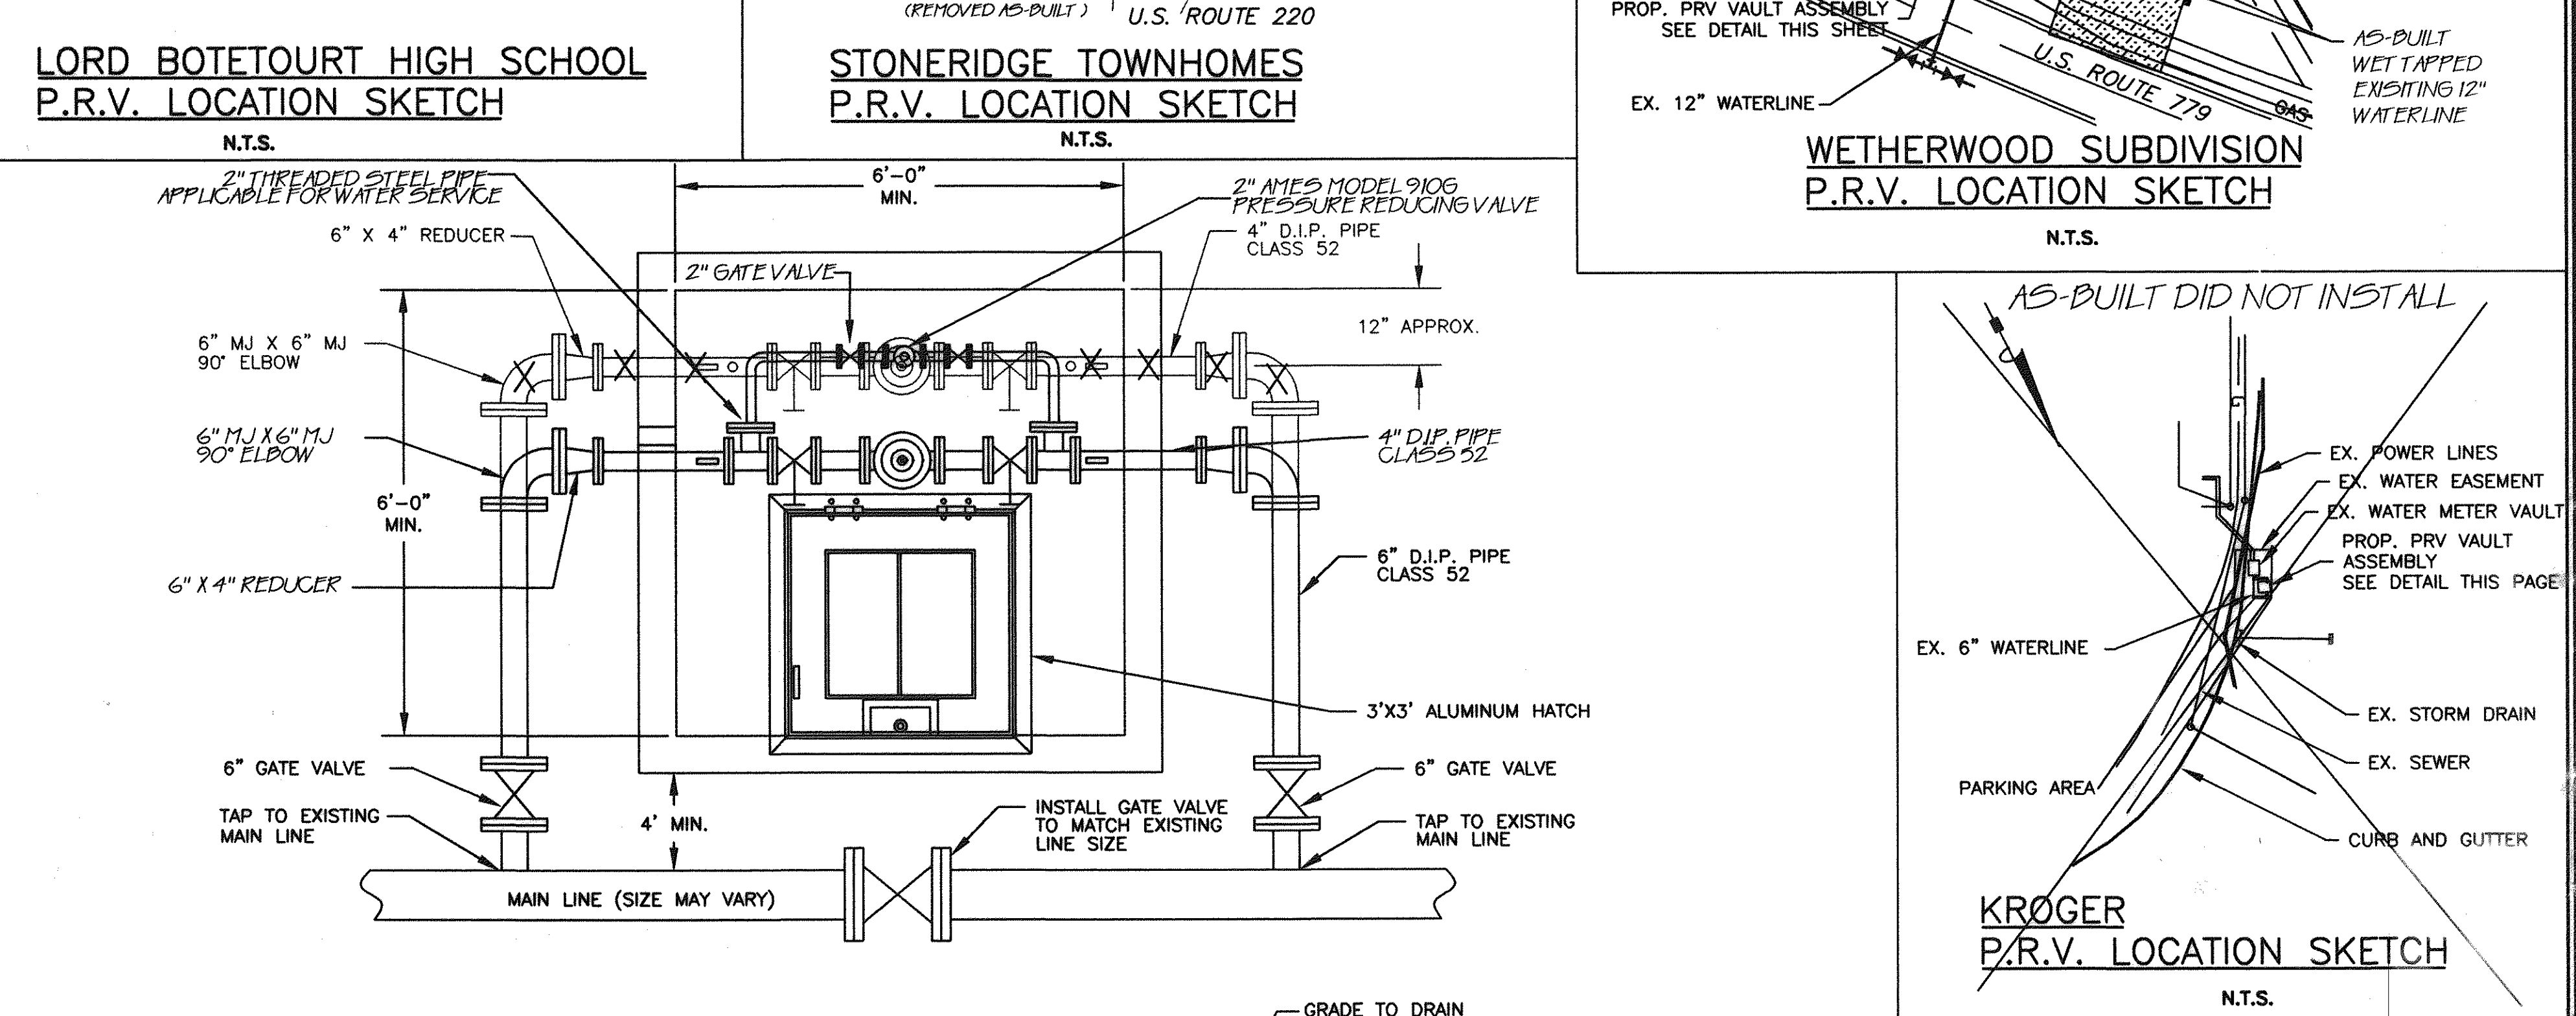
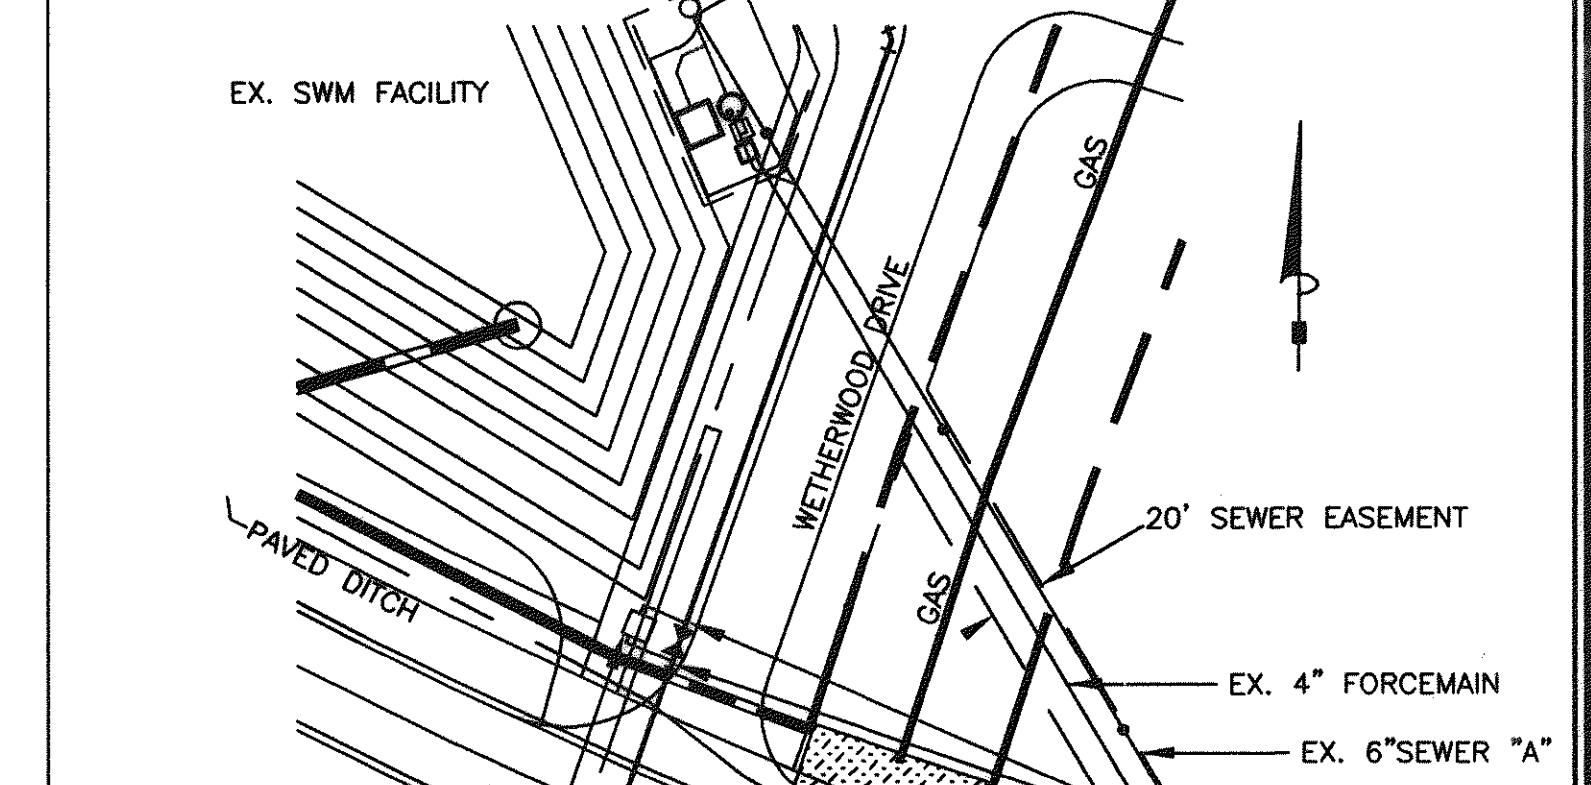
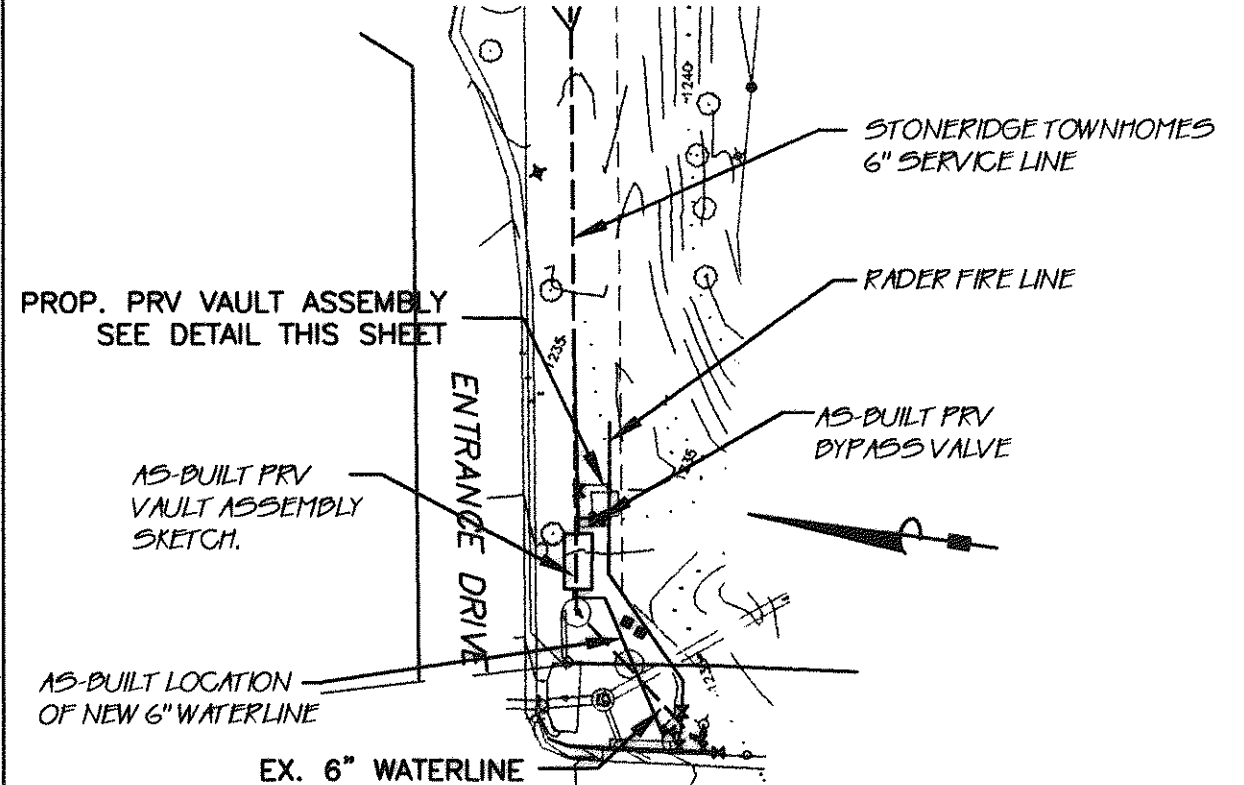
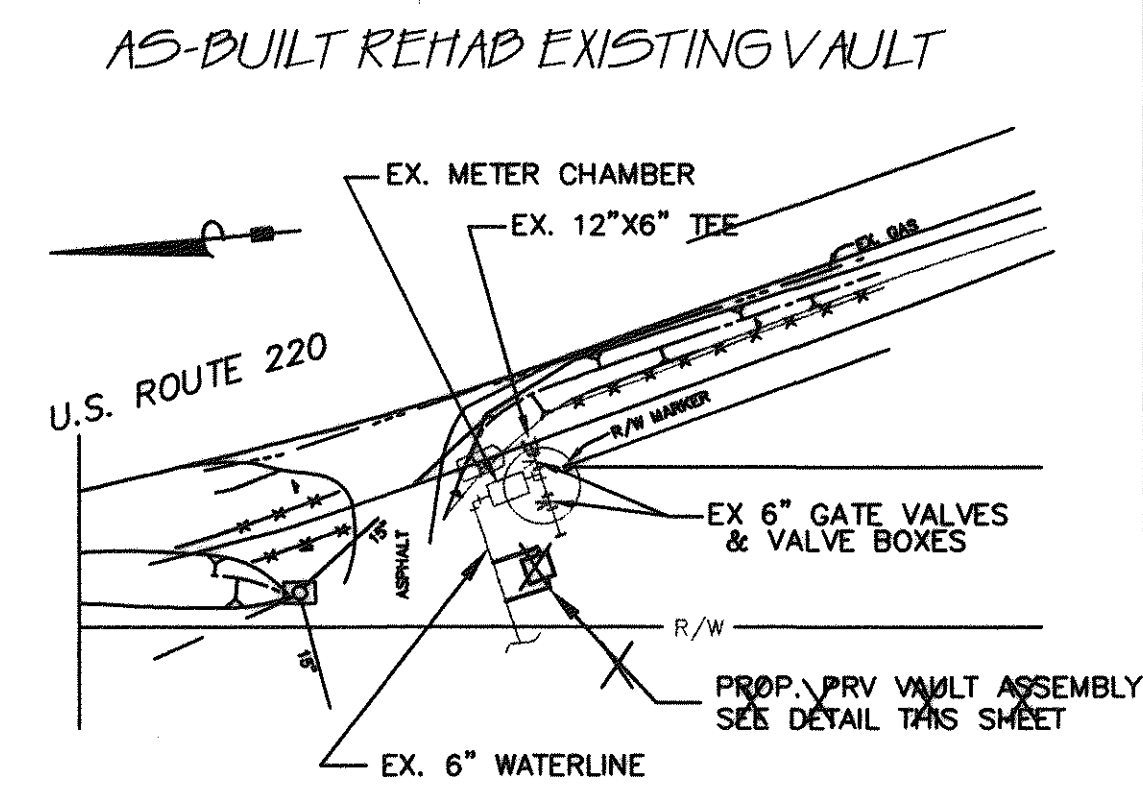


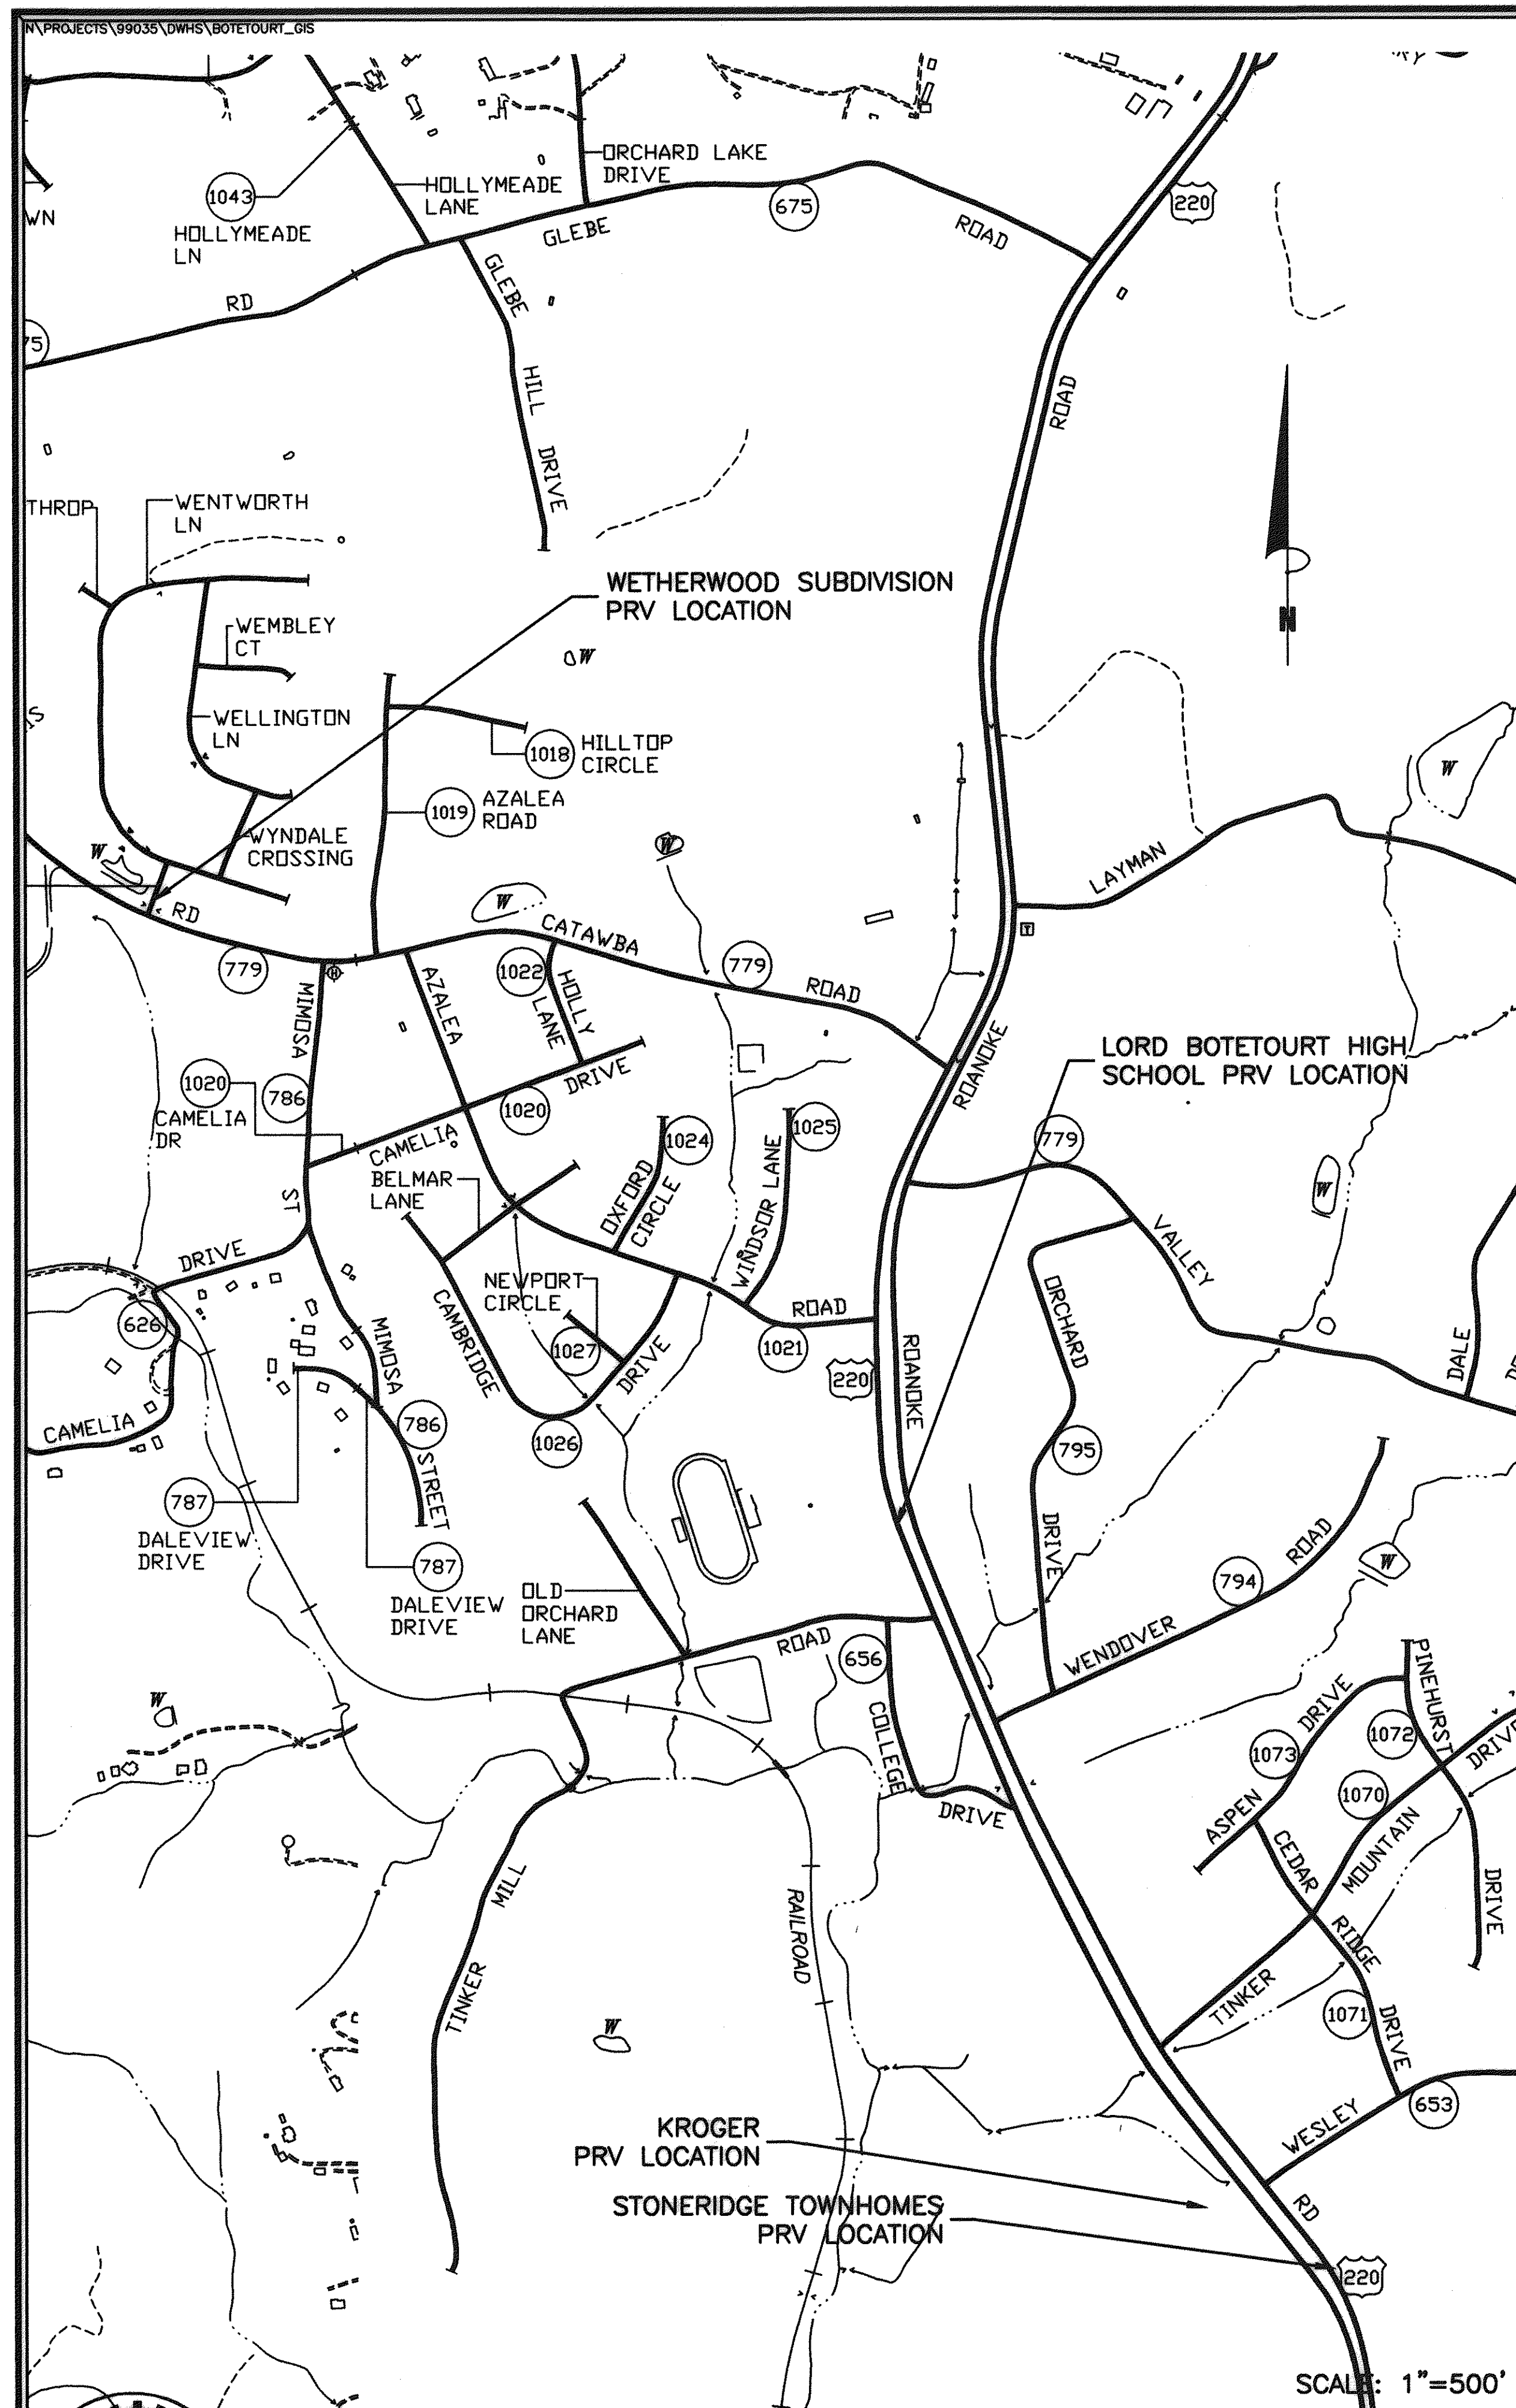

NOTE: ALL WATERLINE PIPE FITTINGS
OUTSIDE OF P.R.V. VAULT TO BE MECHANICAL JOINT.

Drawn	PSN	GREENFIELD TO WETHERWOOD WATERLINE	AS SHOWN	
Designed	PSN		DECEMBER 2000	
Checked	WPJ	MAIN LINE P.R.V. LOCATIONS AND DETAILS	PROJECT: 99035	
Approved	PSN		11 of 13	