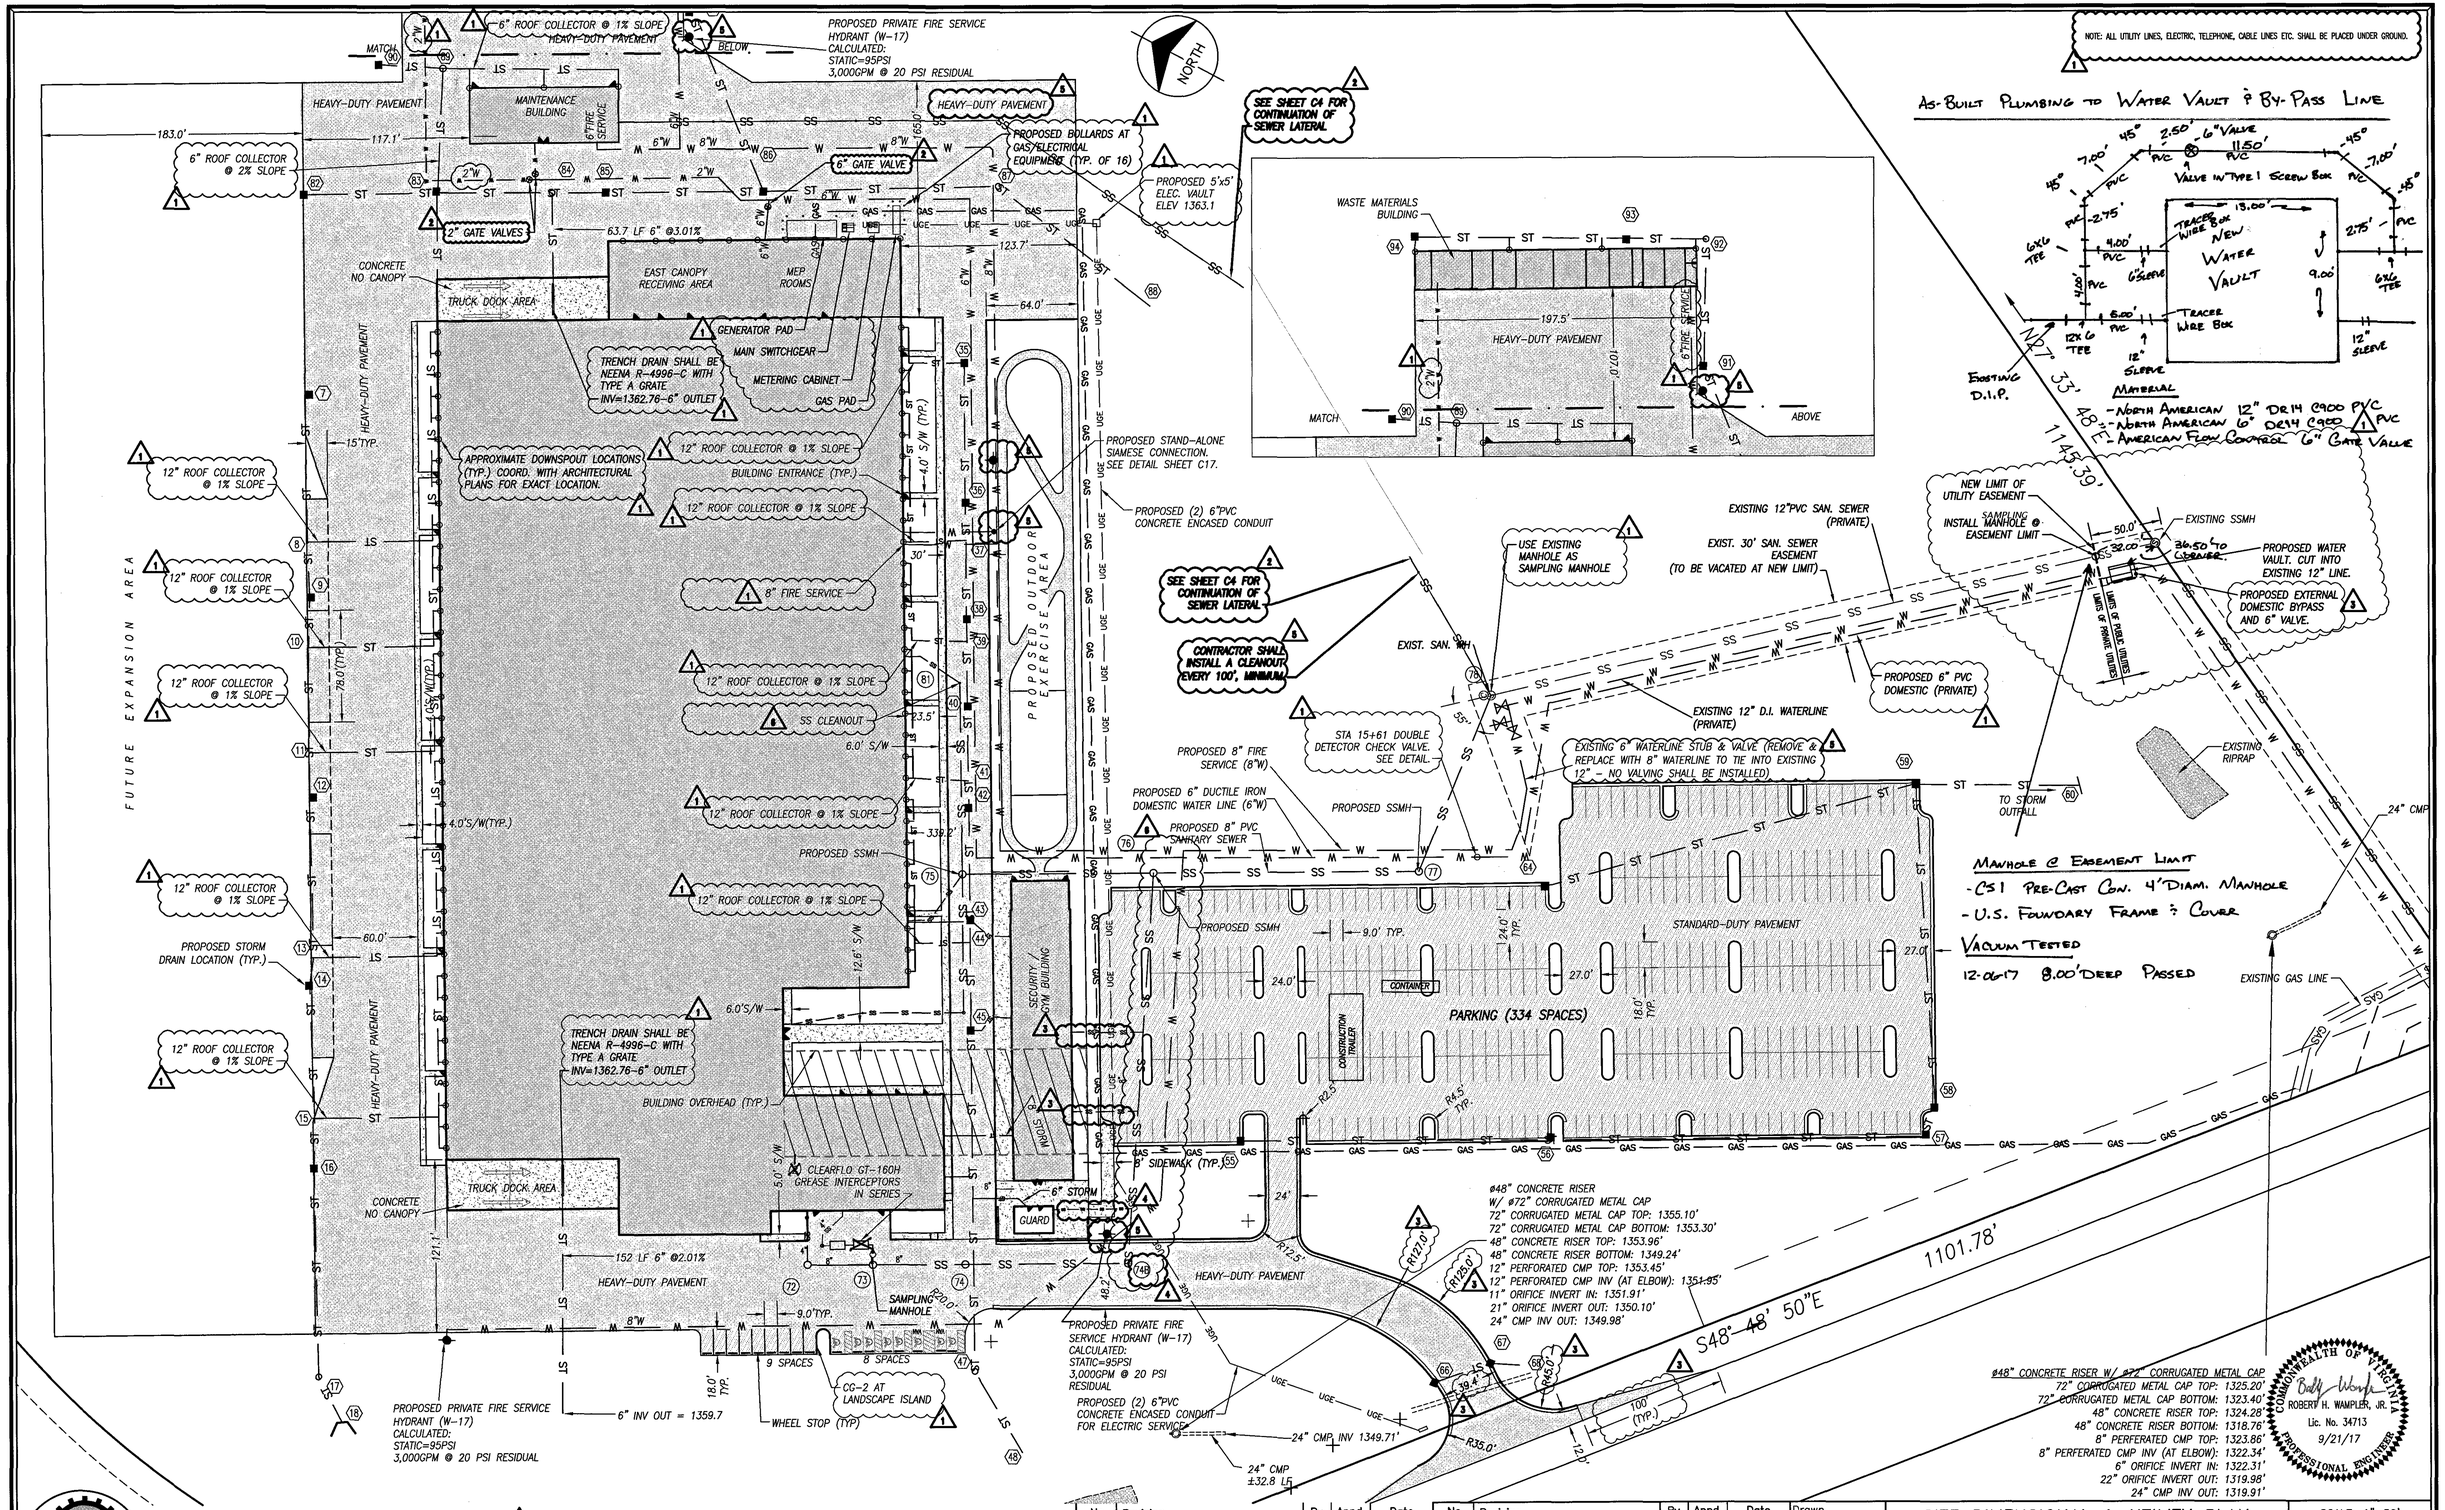

As-Built Plumbing to Water Vault & By-Pass Line

Material

- North American 12" DR14 C900 PVC
- North American 6" DR14 C900 PVC
- American Flow Control 6" Gate Valve

Manhole @ Easement Limit

- CSI Pre-Cast Con. 4' Diam. Manhole
- U.S. Foundary Frame & Cover

Vacuum Tested

12-06-17 8.00' Deep Passed

ENGINEERING CONCEPTS, INC.
94 GREENFIELD STREET
DALEVILLE, VIRGINIA 24083
540.473.1253 FAX: 540.473.1254

COORDINATION NOTES:
1. SEE ARCHITECTURAL PLANS TO CONFIRM EXACT LOCATION, SIZE, AND INVERT OF BUILDING UTILITY CONNECTIONS.
2. ALL SANITARY SEWER LATERALS FROM GUARD SHACK AND GYM ARE 4".
3. ALL STORM SEWERS FROM GYM ARE 6" UNLESS NOTED OTHERWISE.
4. CLEANOUTS SHALL BE INSTALLED 5' FROM BUILDING FACE FOR STORM AND SANITARY SEWER LATERALS.

No.	Revision	By	Appd.	Date
6	FIELD REVISION	ECI	RHW	9/21/17

No.	Revision	By	Appd.	Date
1	COORDINATION & COMMENTS	ECI	RHW	6/29/17
2	SANITARY SEWER LATERAL	ECI	RHW	7/27/17
3	REVIEW COMMENTS	ECI	RHW	8/11/17
4	LOWER SANITARY	ECI	RHW	9/7/17
5	FIRE & ZONING COMMENTS	ECI	RHW	9/13/17

Drawn ECI
Designed ECI
Checked RHW
Approved RHW

SITE DIMENSIONAL & UTILITY PLAN
ELDOR IGNITION MANUFACTURING
THE BOTETOURT CENTER AT GREENFIELD
BOTETOURT COUNTY – VIRIGNIA

SCALE: 1"=50'
September 21 2017
PROJECT: 16070
C6