
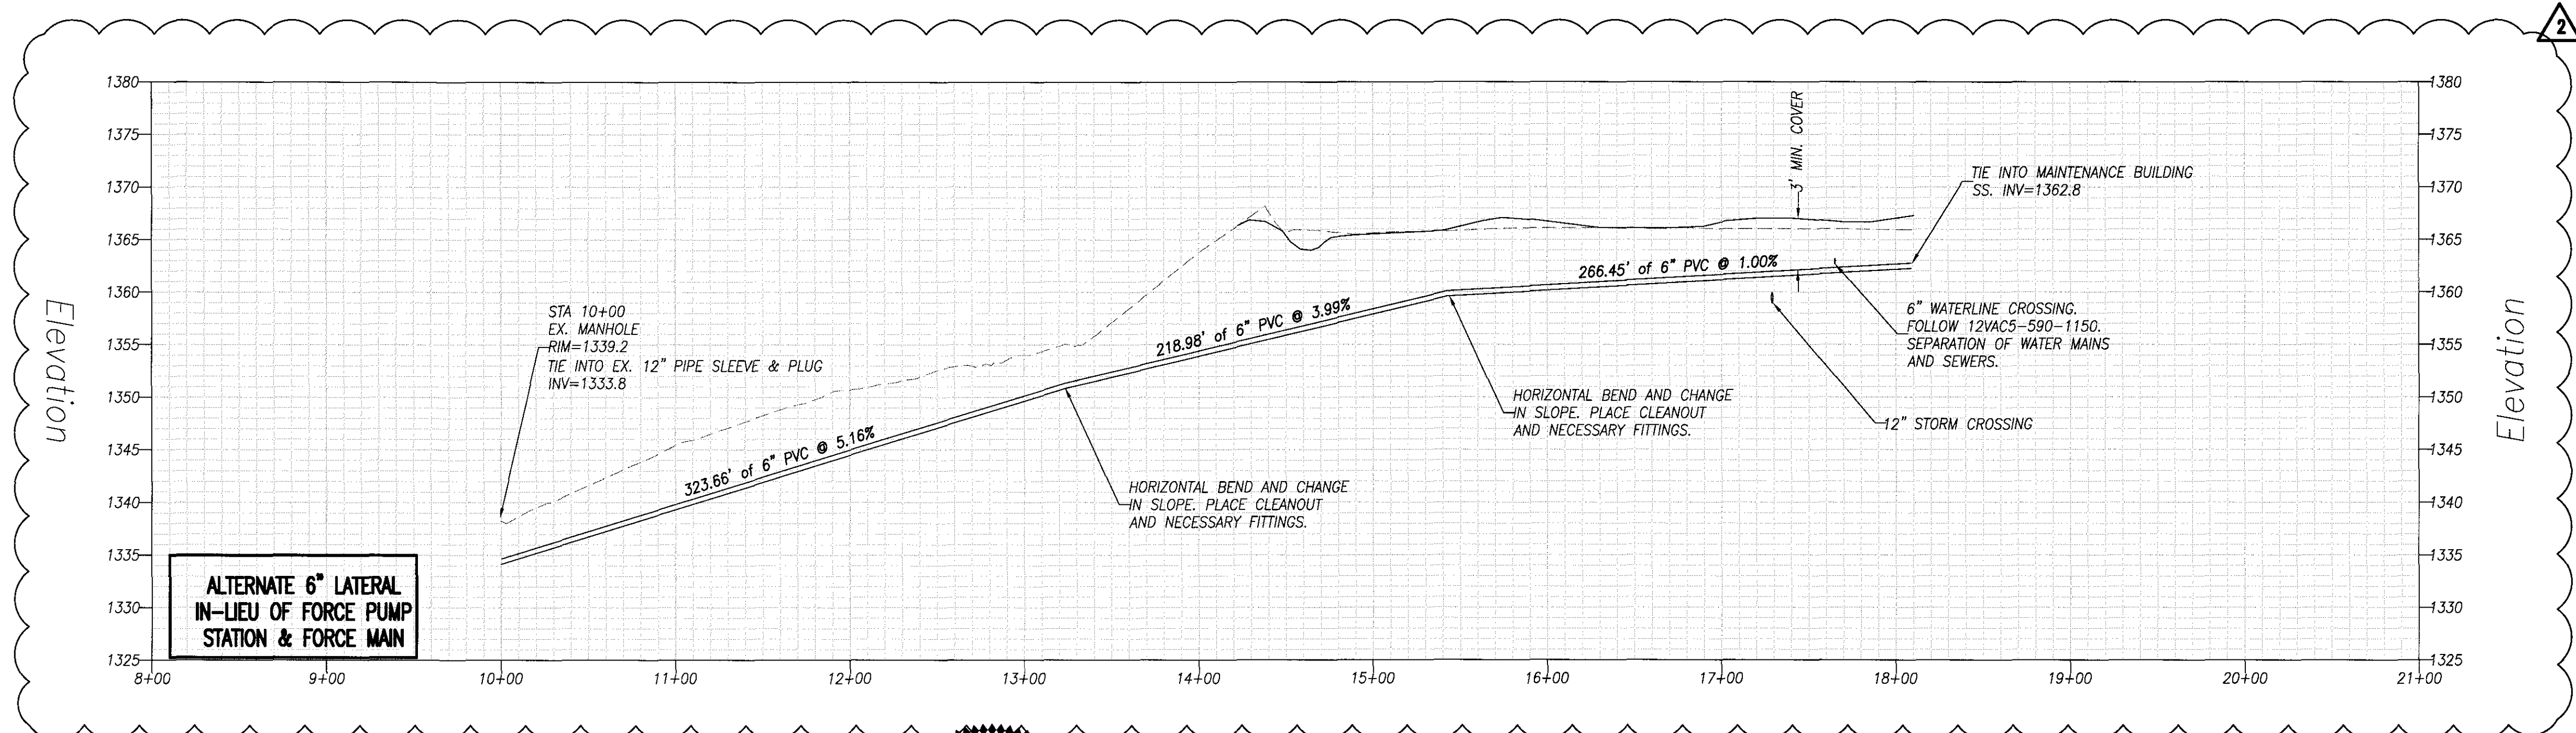
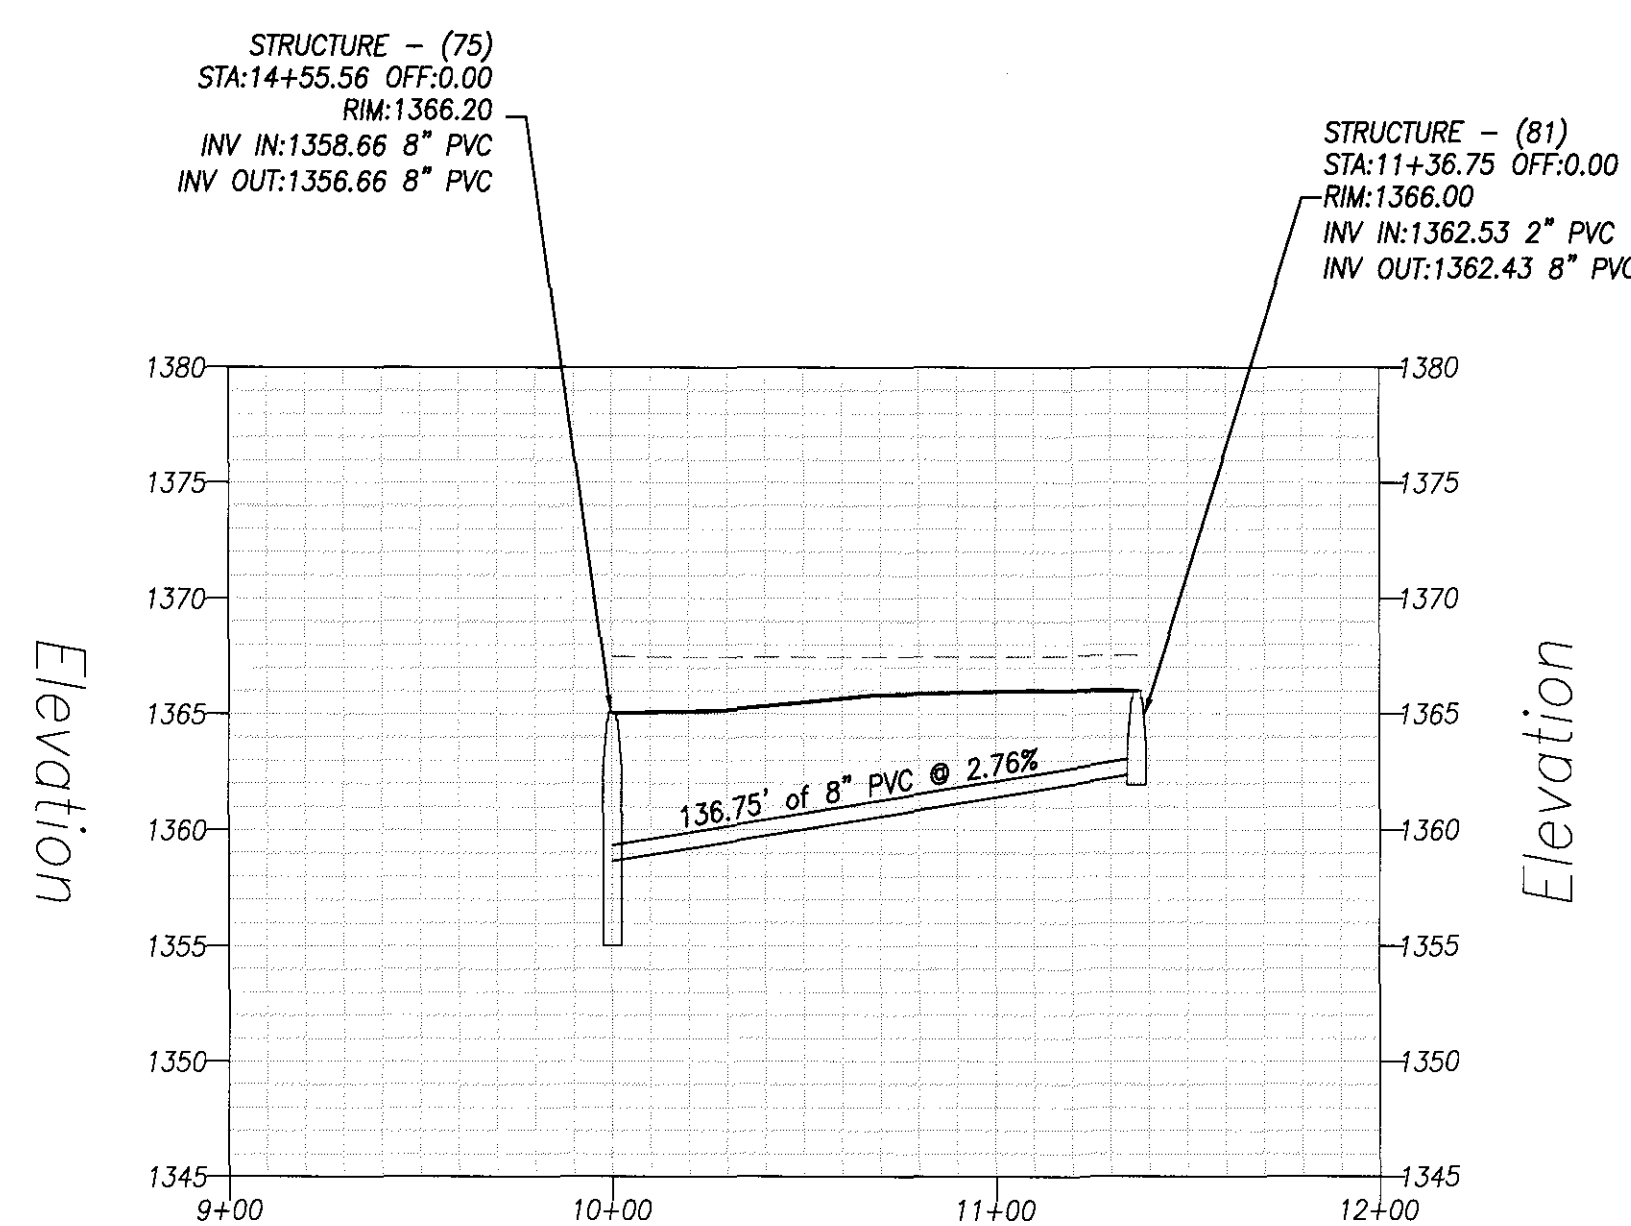
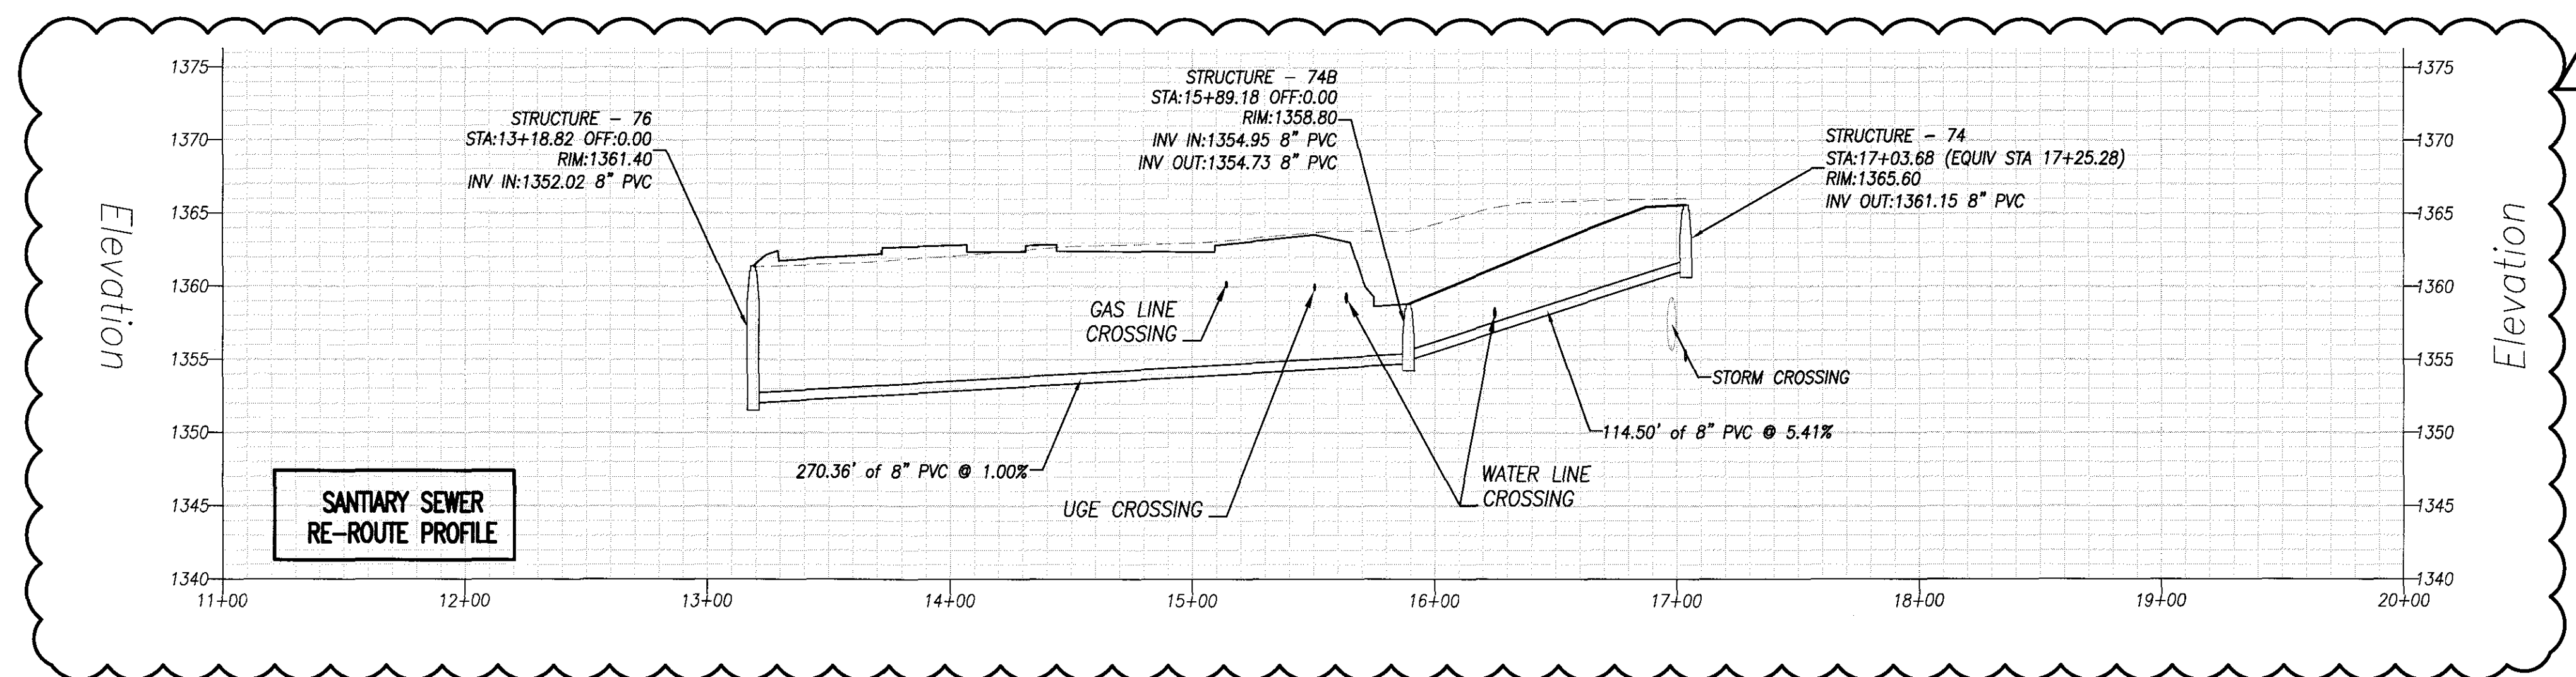


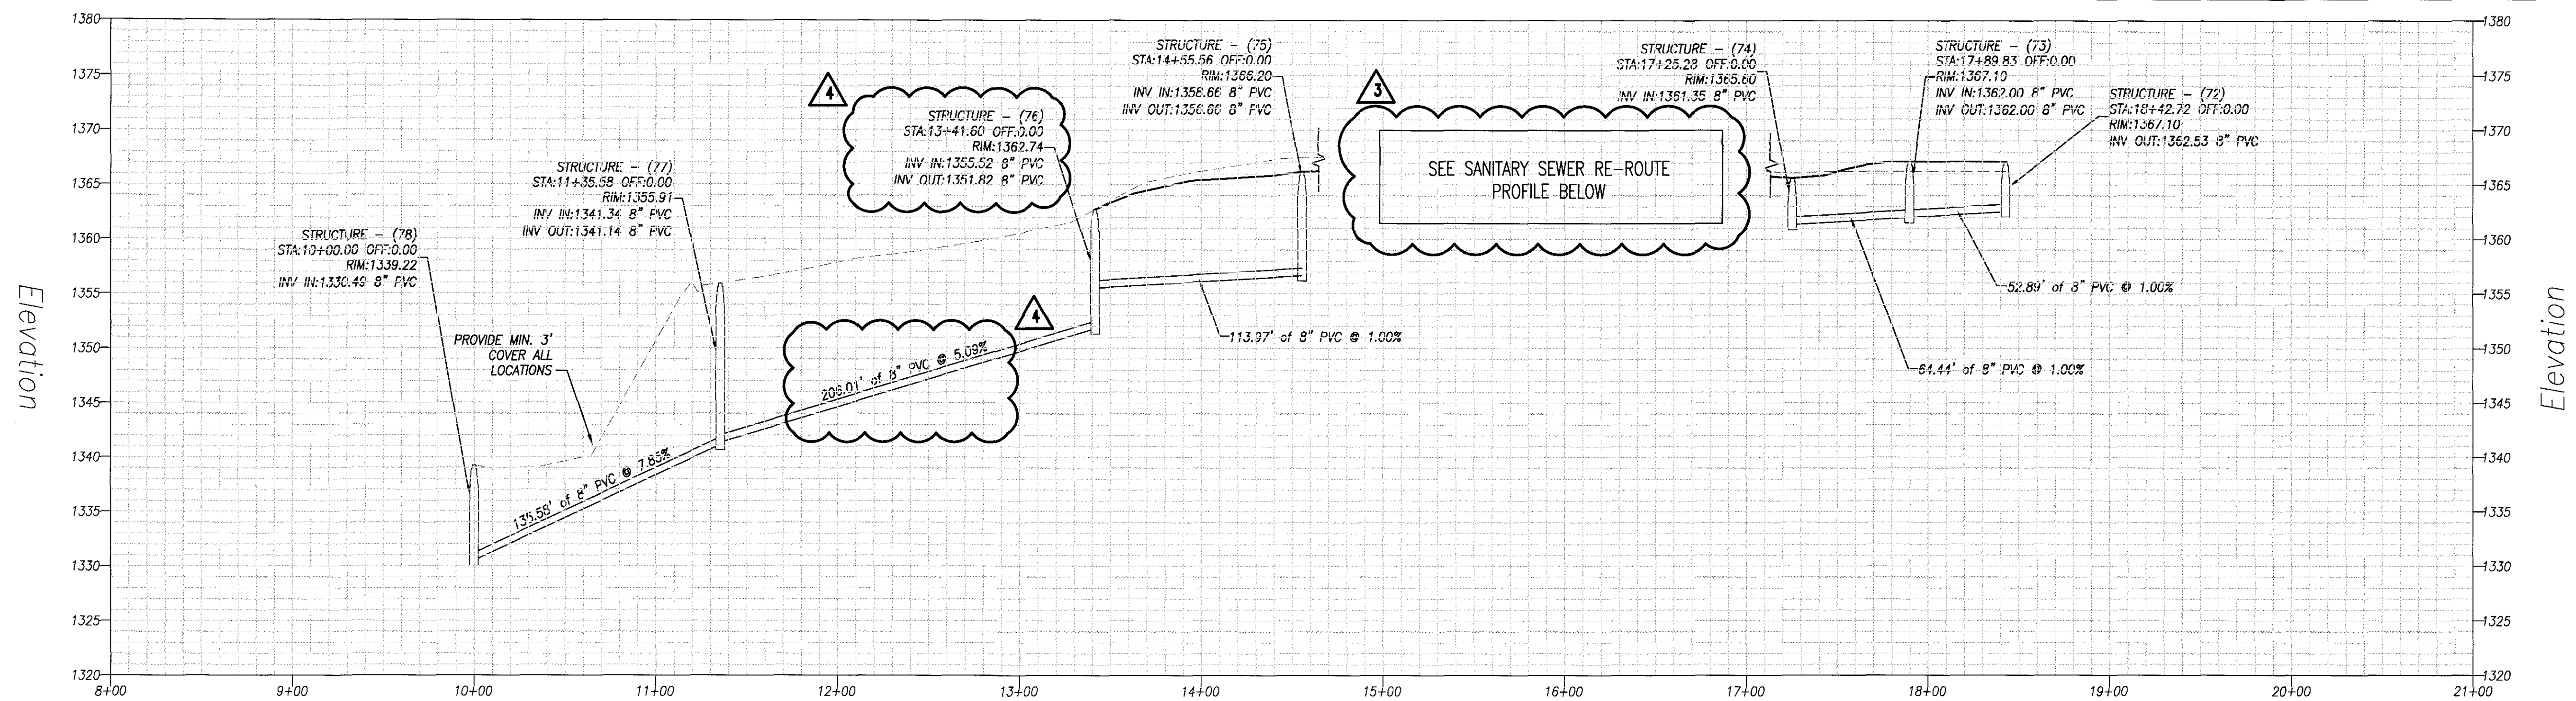

| No. | Revision                      | By  | Appd. | Date    | Drawn    | ECI |
|-----|-------------------------------|-----|-------|---------|----------|-----|
| 1   | COORDINATION & COMMENTS       | ECI | RHW   | 6/29/17 | Designed | ECI |
| 2   | 6" SANITARY SEWER LATERAL     | ECI | RHW   | 7/27/17 |          | ECI |
| 3   | REROUTE UTILITIES             | ECI | RHW   | 8/11/17 | Checked  | RHW |
| 4   | LOWER SANITARY                | ECI | RHW   | 9/7/17  | Approved | RHW |
| 5   | SANITARY SEWER FIELD REVISION | ECI | RHW   | 9/21/17 |          |     |

|                                                                   |  |                    |
|-------------------------------------------------------------------|--|--------------------|
| SANITARY SEWER PROFILES<br>ELDOR IGNITION MANUFACTURING           |  | H:1"=50' V:1"=10'  |
| THE BOTETOURT CENTER AT GREENFIELD<br>BOTETOURT COUNTY - VIRGINIA |  | September 21, 2017 |
|                                                                   |  | PROJECT: 16070     |
|                                                                   |  | C11                |