

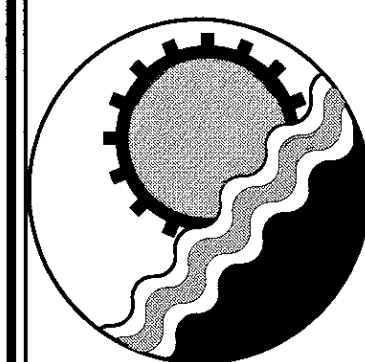
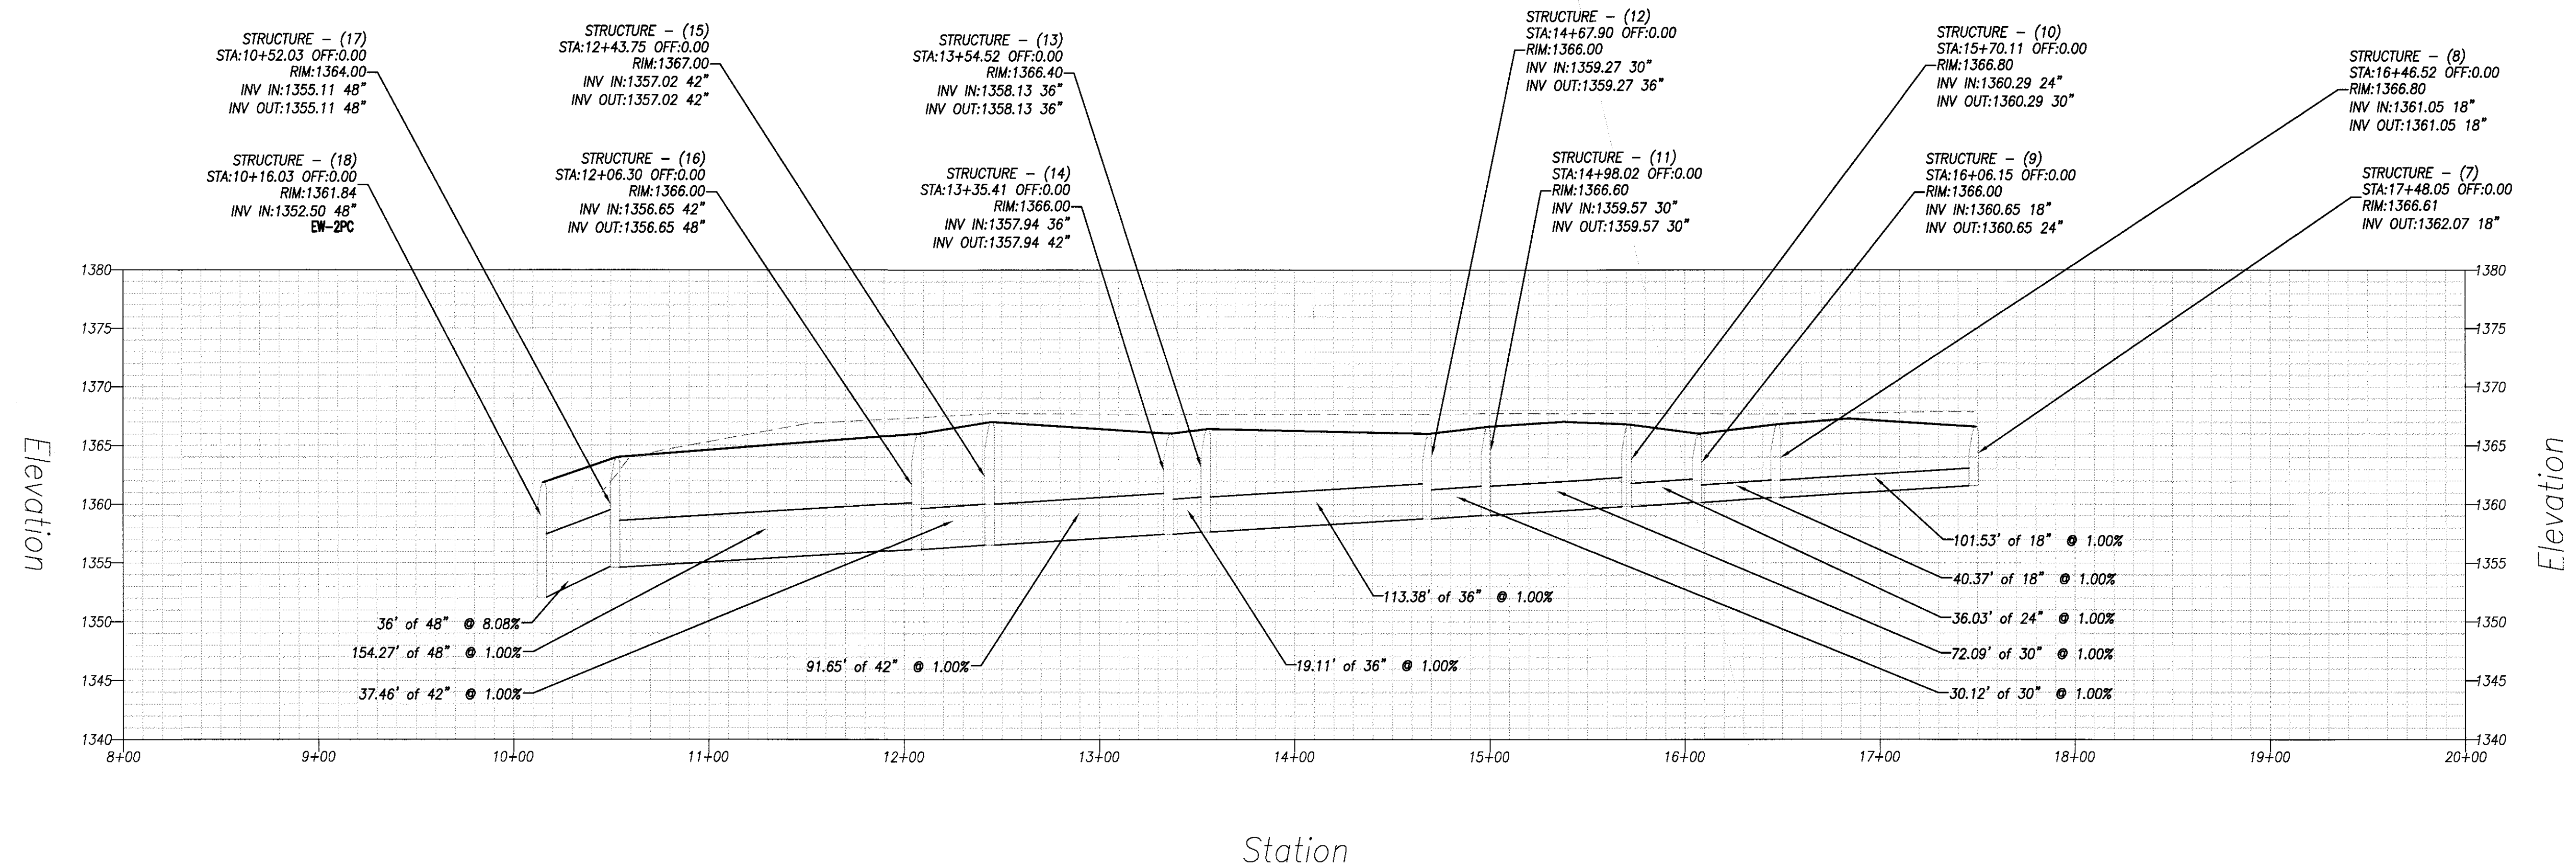


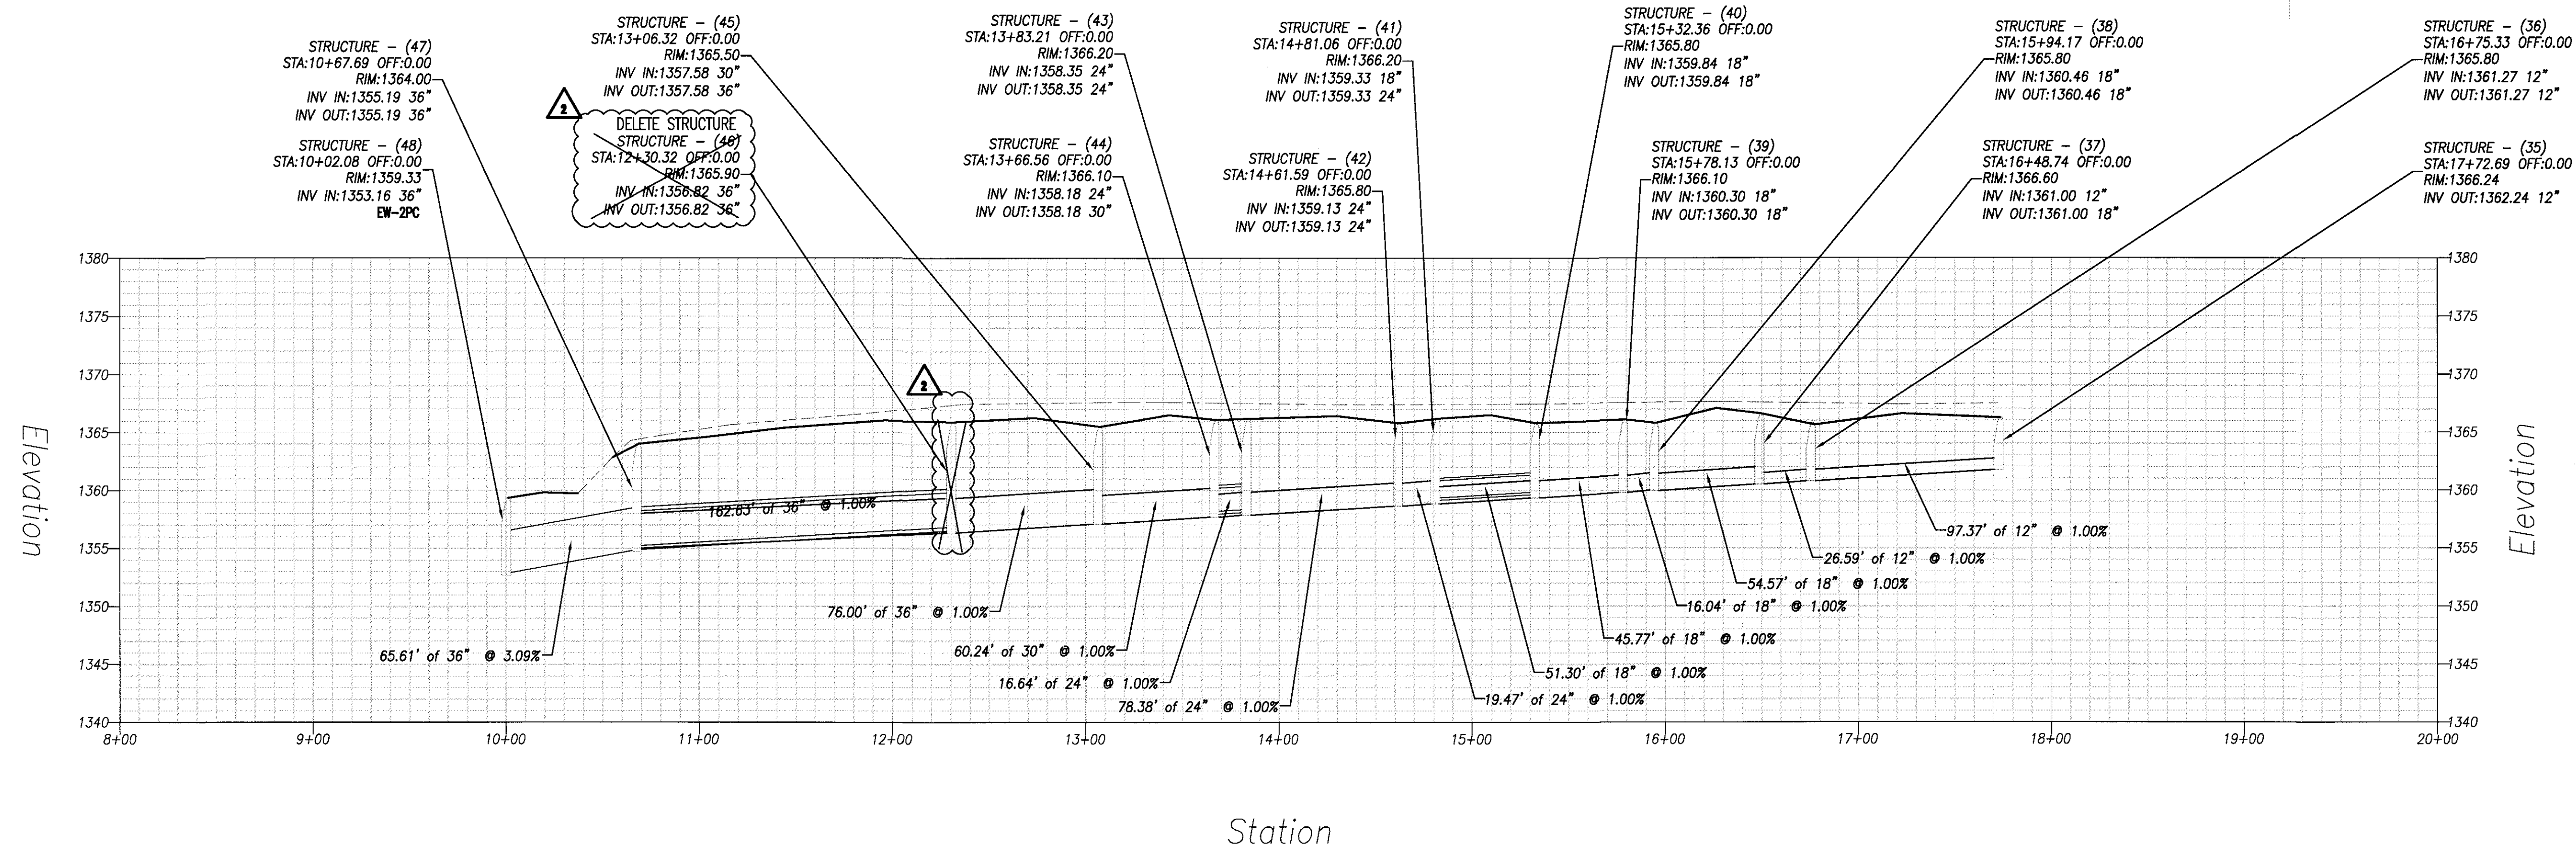

ENGINEERING CONCEPTS, INC.

94 GREENFIELD STREET
DALEVILLE, VIRGINIA 24083
540.473.1253 FAX: 540.473.1254

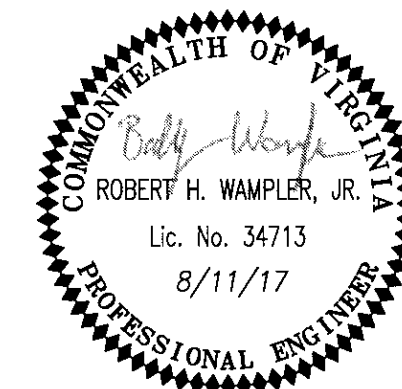

No.	Revision	By	Appd.	Date	Drawn	ECI
1	COORDINATION & COMMENTS	ECI	RHW	8/11/17	Designed	ECI
2	DELETE STRUCTURE	ECI	RHW	8/11/17	Checked	RHW
					Approved	RHW

STORM SEWER PROFILES - 2		H:1"=50' V:1"=10'
ELDOR IGNITION MANUFACTURING		DATE: June 29, 2017
THE BOTETOURT CENTER AT GREENFIELD		PROJECT: 16070
BOTETOURT COUNTY - VIRGINIA		C13