

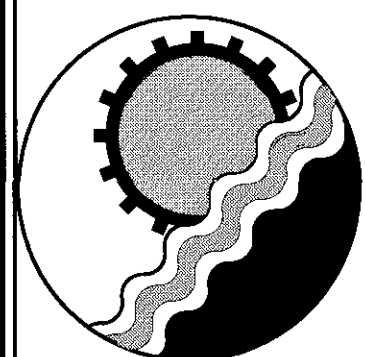
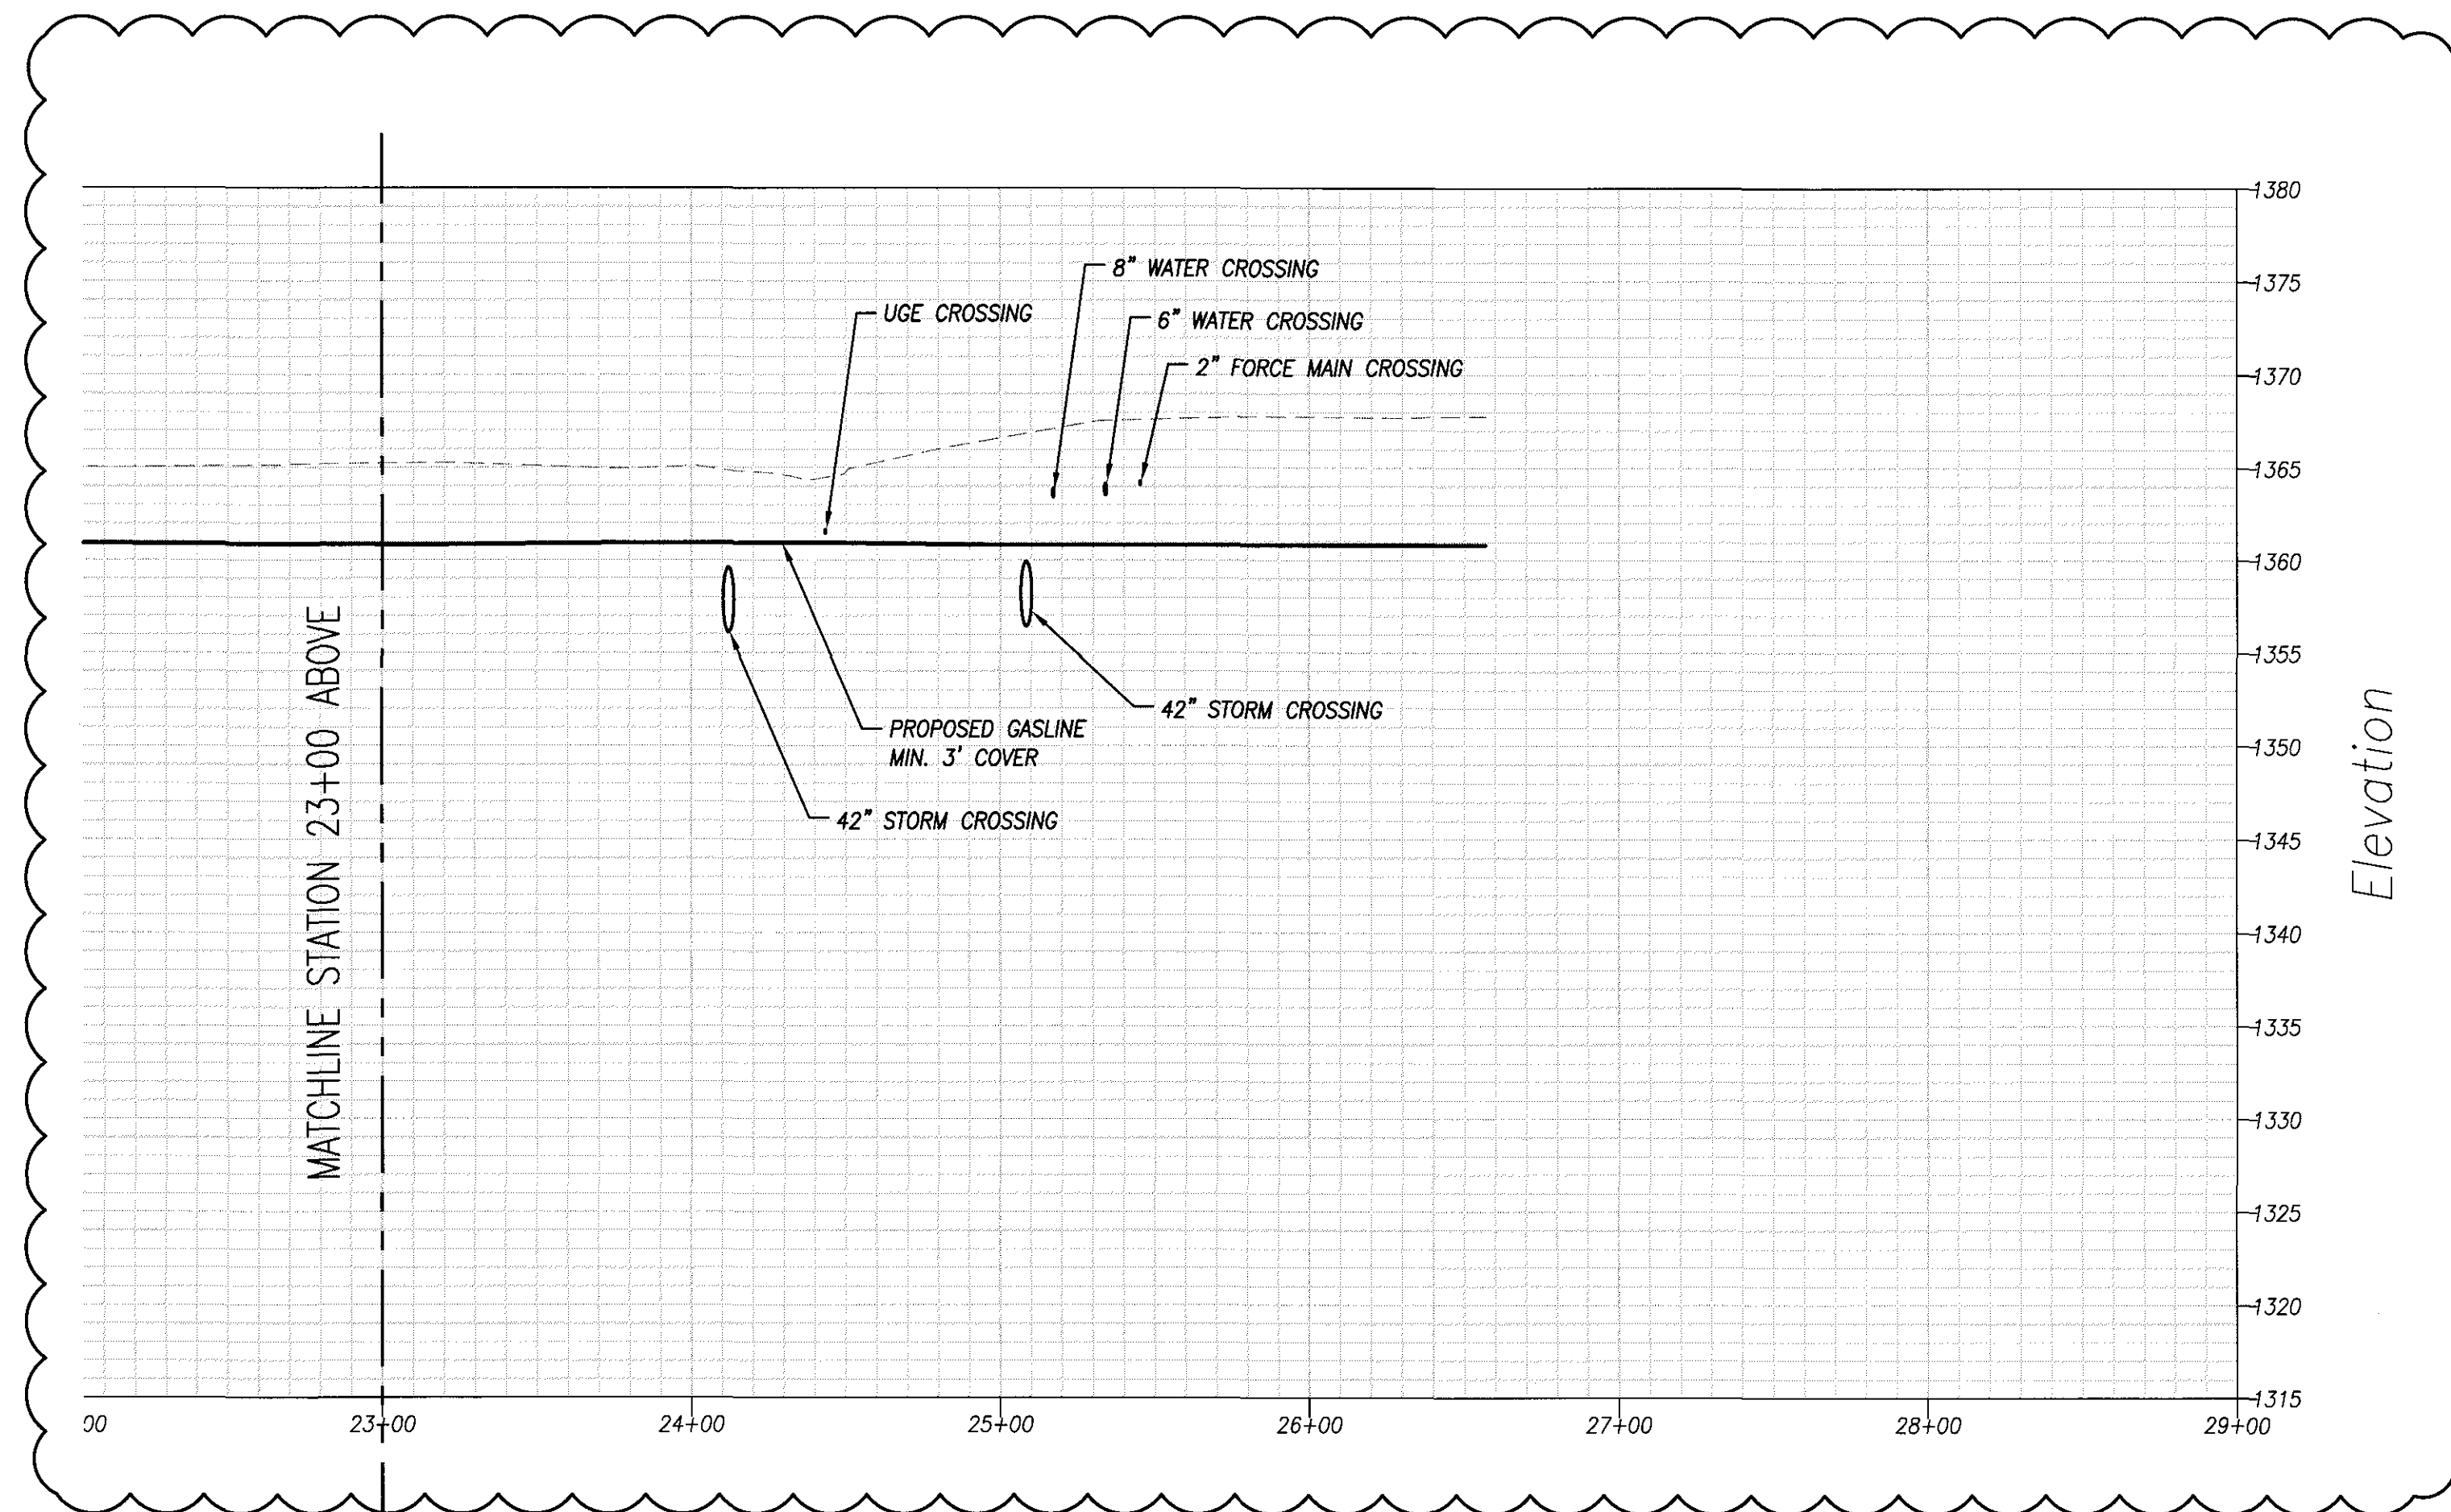


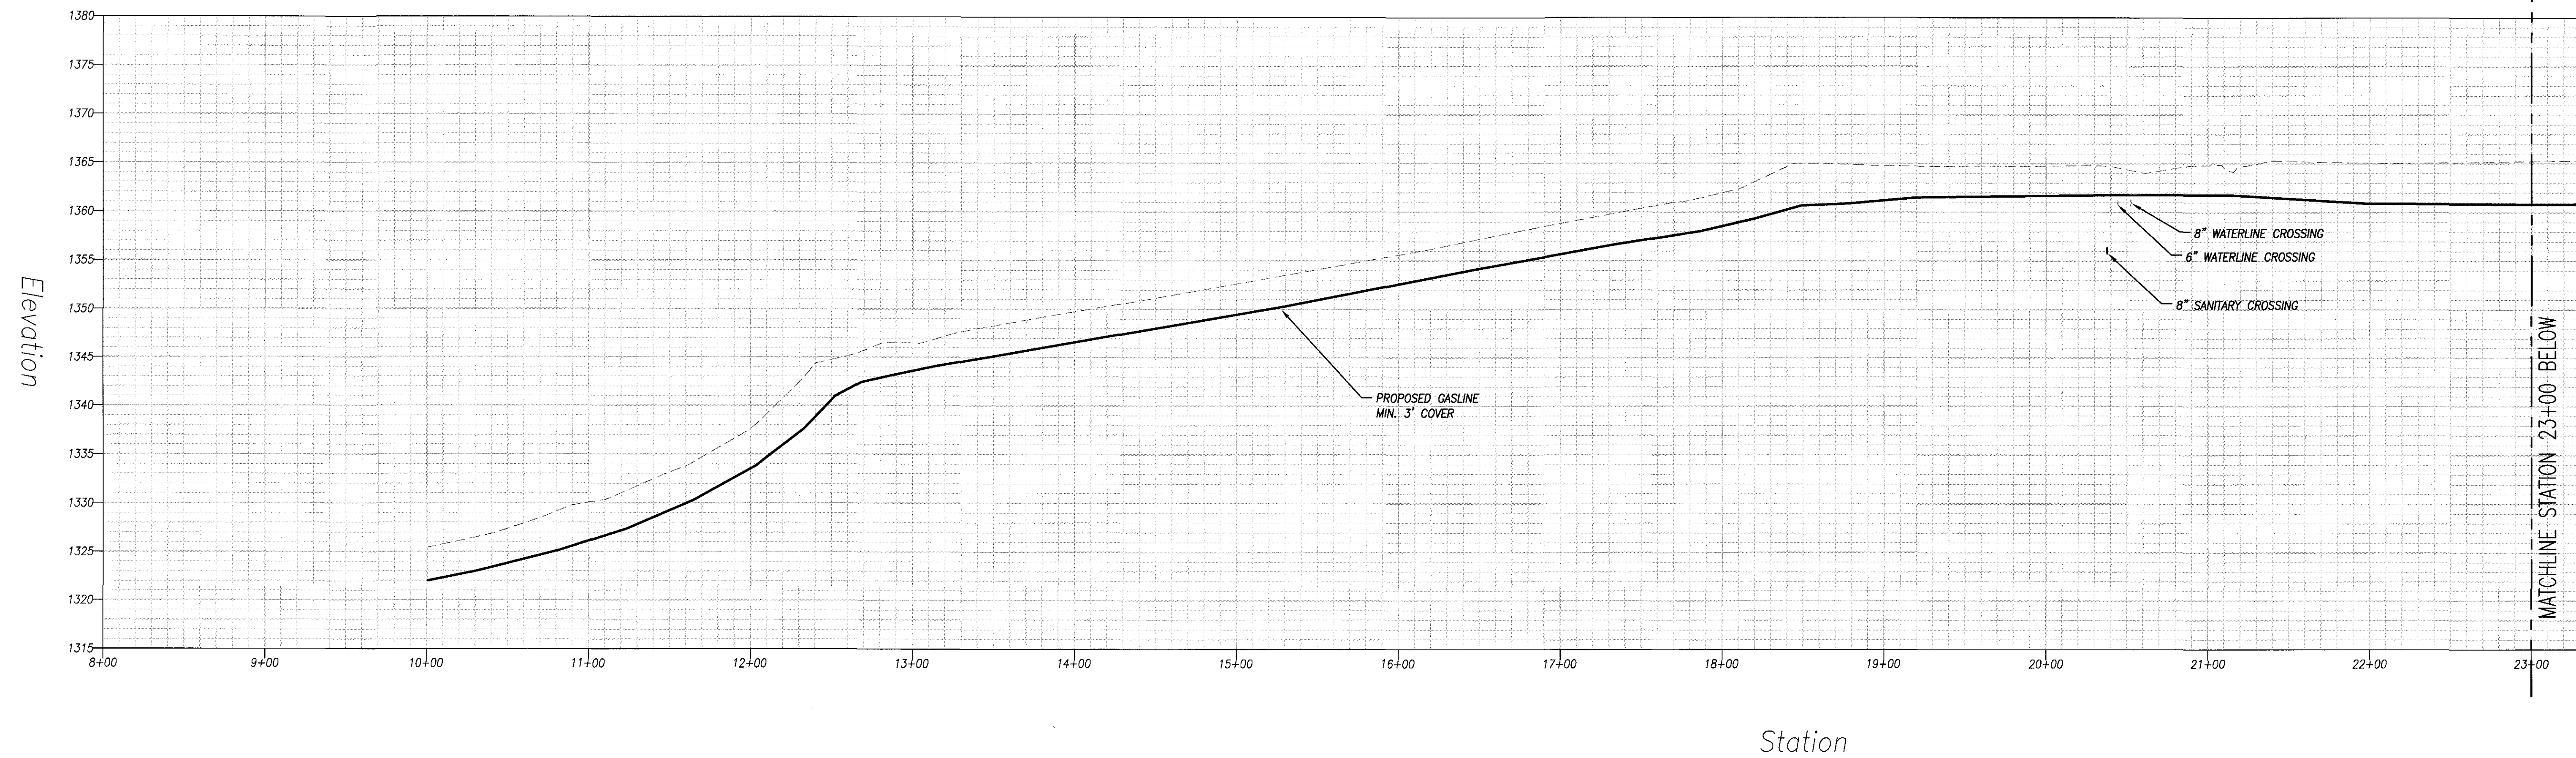

ENGINEERING CONCEPTS, INC.

94 GREENFIELD STREET
DALEVILLE, VIRGINIA 24083
540.473.1253 FAX: 540.473.1254

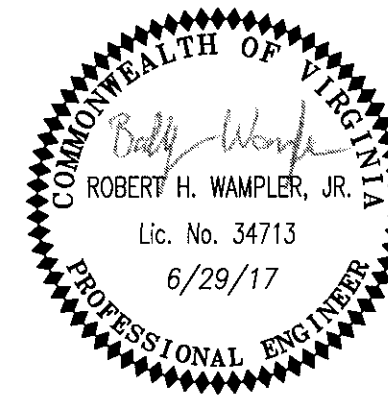

No.	Revision	By	Appd.	Date	Drawn	ECI
1	COORDINATION & COMMENTS	ECI	RHW	6/29/17	Designed	ECI
					Checked	RHW
					Approved	RHW

GAS LINE PROFILE ELDOR IGNITION MANUFACTURING		H:1"=50' V:1"=10'
THE BOTETOURT CENTER AT GREENFIELD BOTETOURT COUNTY - VIRGINIA		DATE: June 29, 2017
		PROJECT: 16070
		C15