

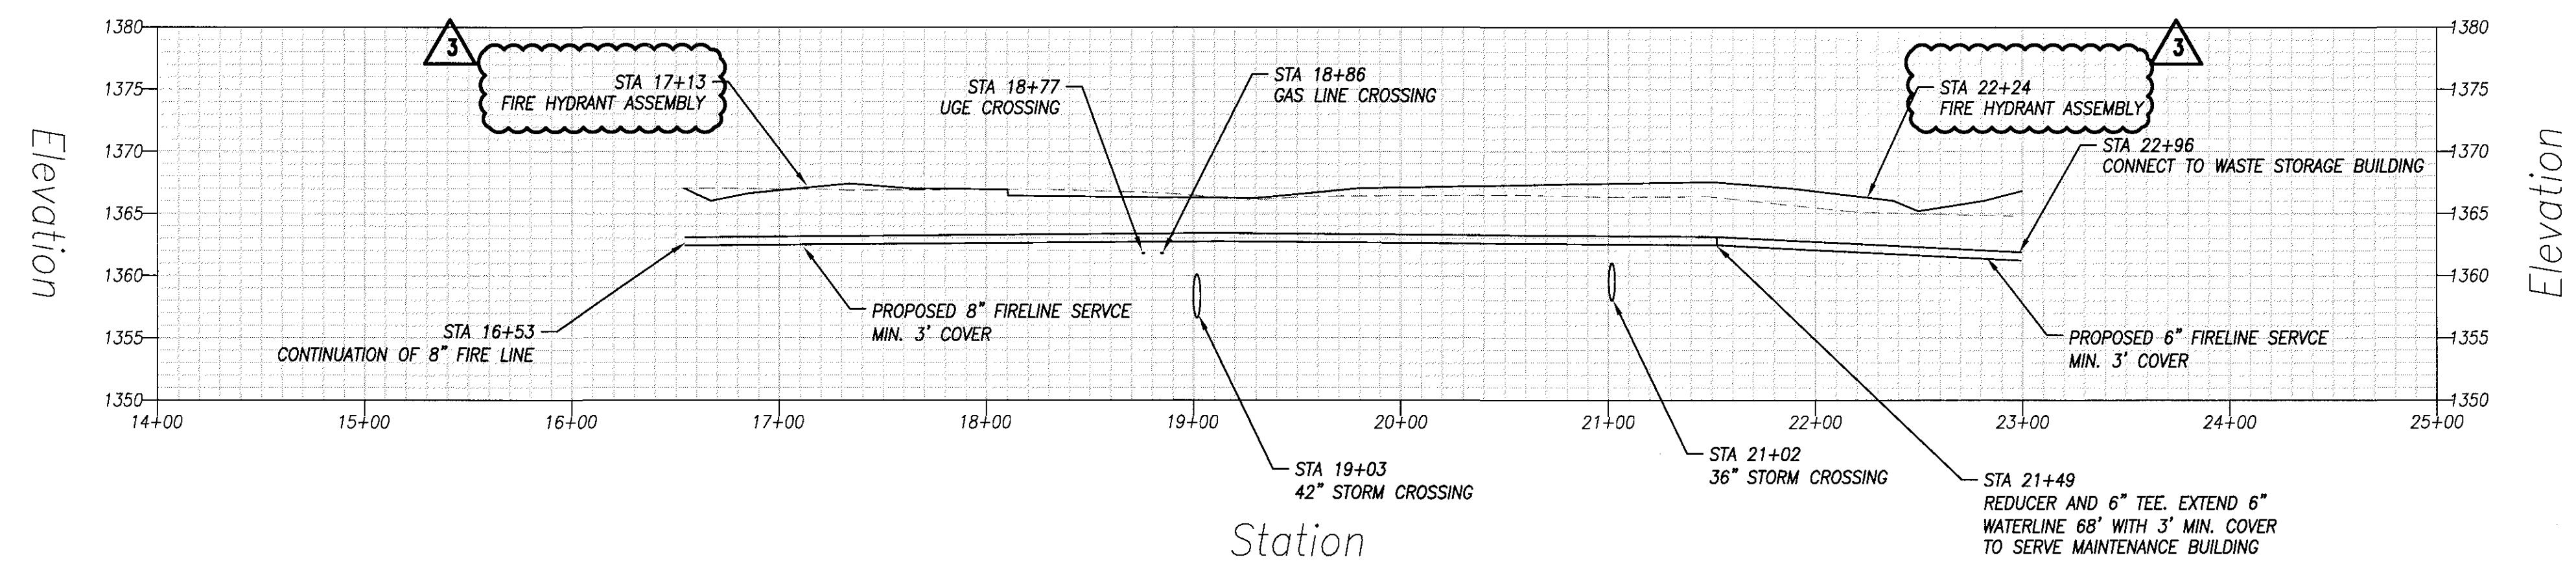


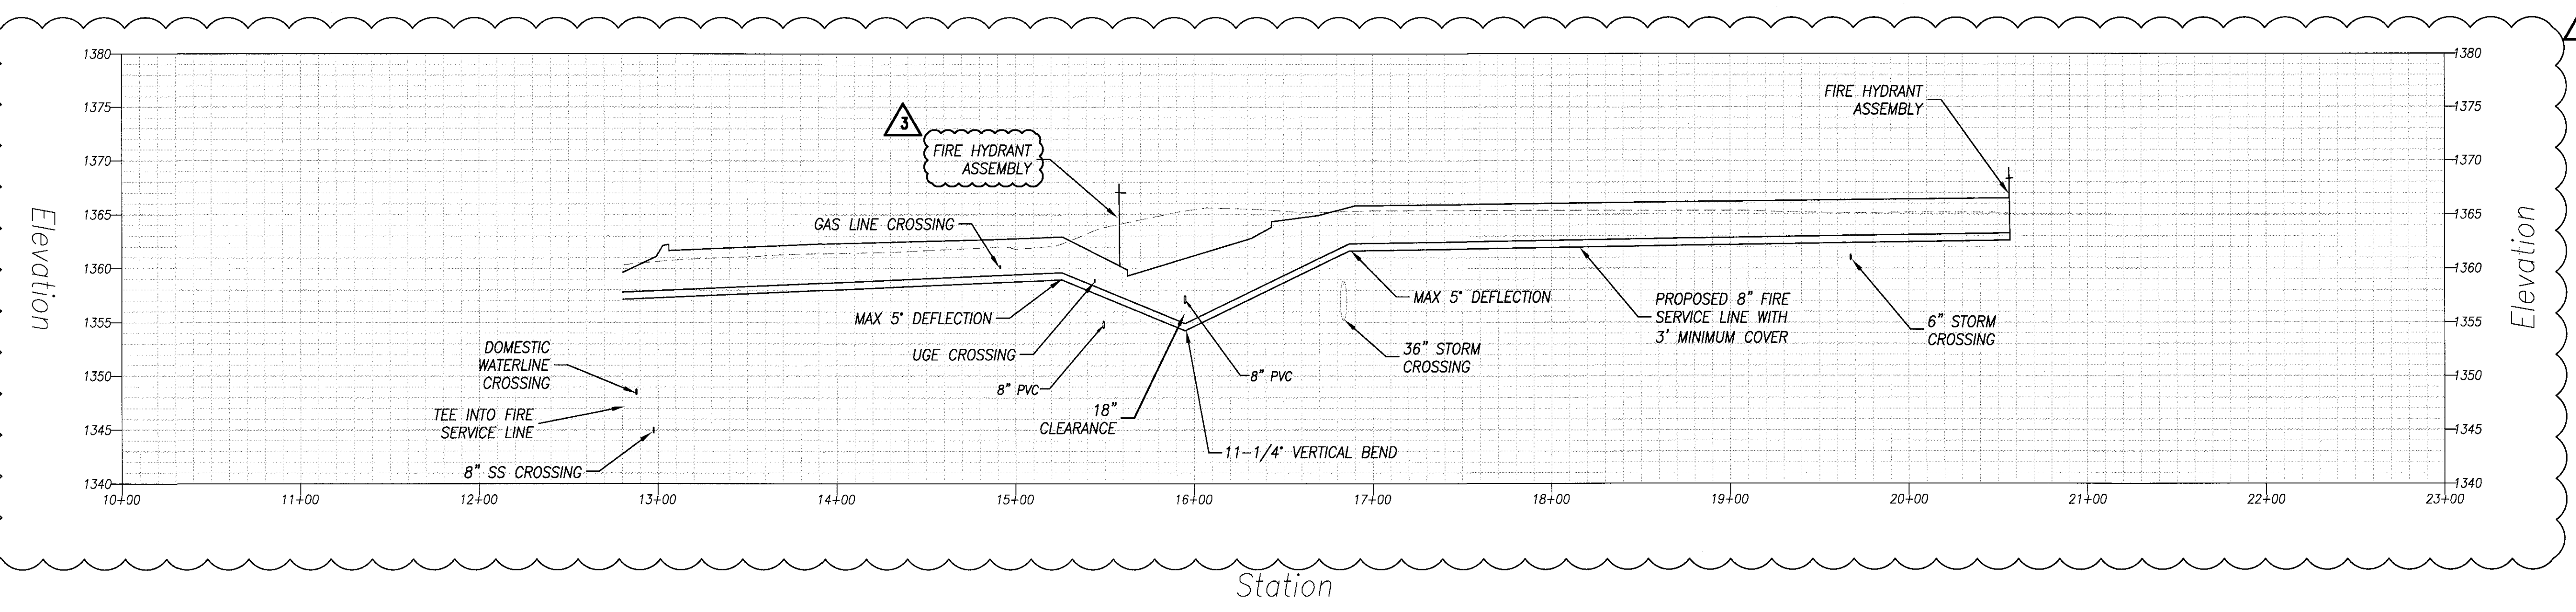

- TYPICAL NOTES:
- 1)-ALL EXPOSED PIPING AND FITTINGS TO BE GALVANIZED WITH EXCEPTION OF STORZ CONNECTION
 - 2)-40' MAX. FROM FDC TO FIRE APPARATUS ACCESS (DRIVEWAY)
 - 3)-FOR NFPA 13R SYSTEMS (2 1/2" RISER AND SMALLER) SINGLE FDC W/ RALEIGH THREADS (3.340 X 6 SHARPE V FORM)
 - 4)-WHEN BUILDING HT. IS GREATER THAN 200' USE RAL. SIAMESE
 - 5)-AN APPROVED CONNECTION (TAPPING NOT APPROVED)

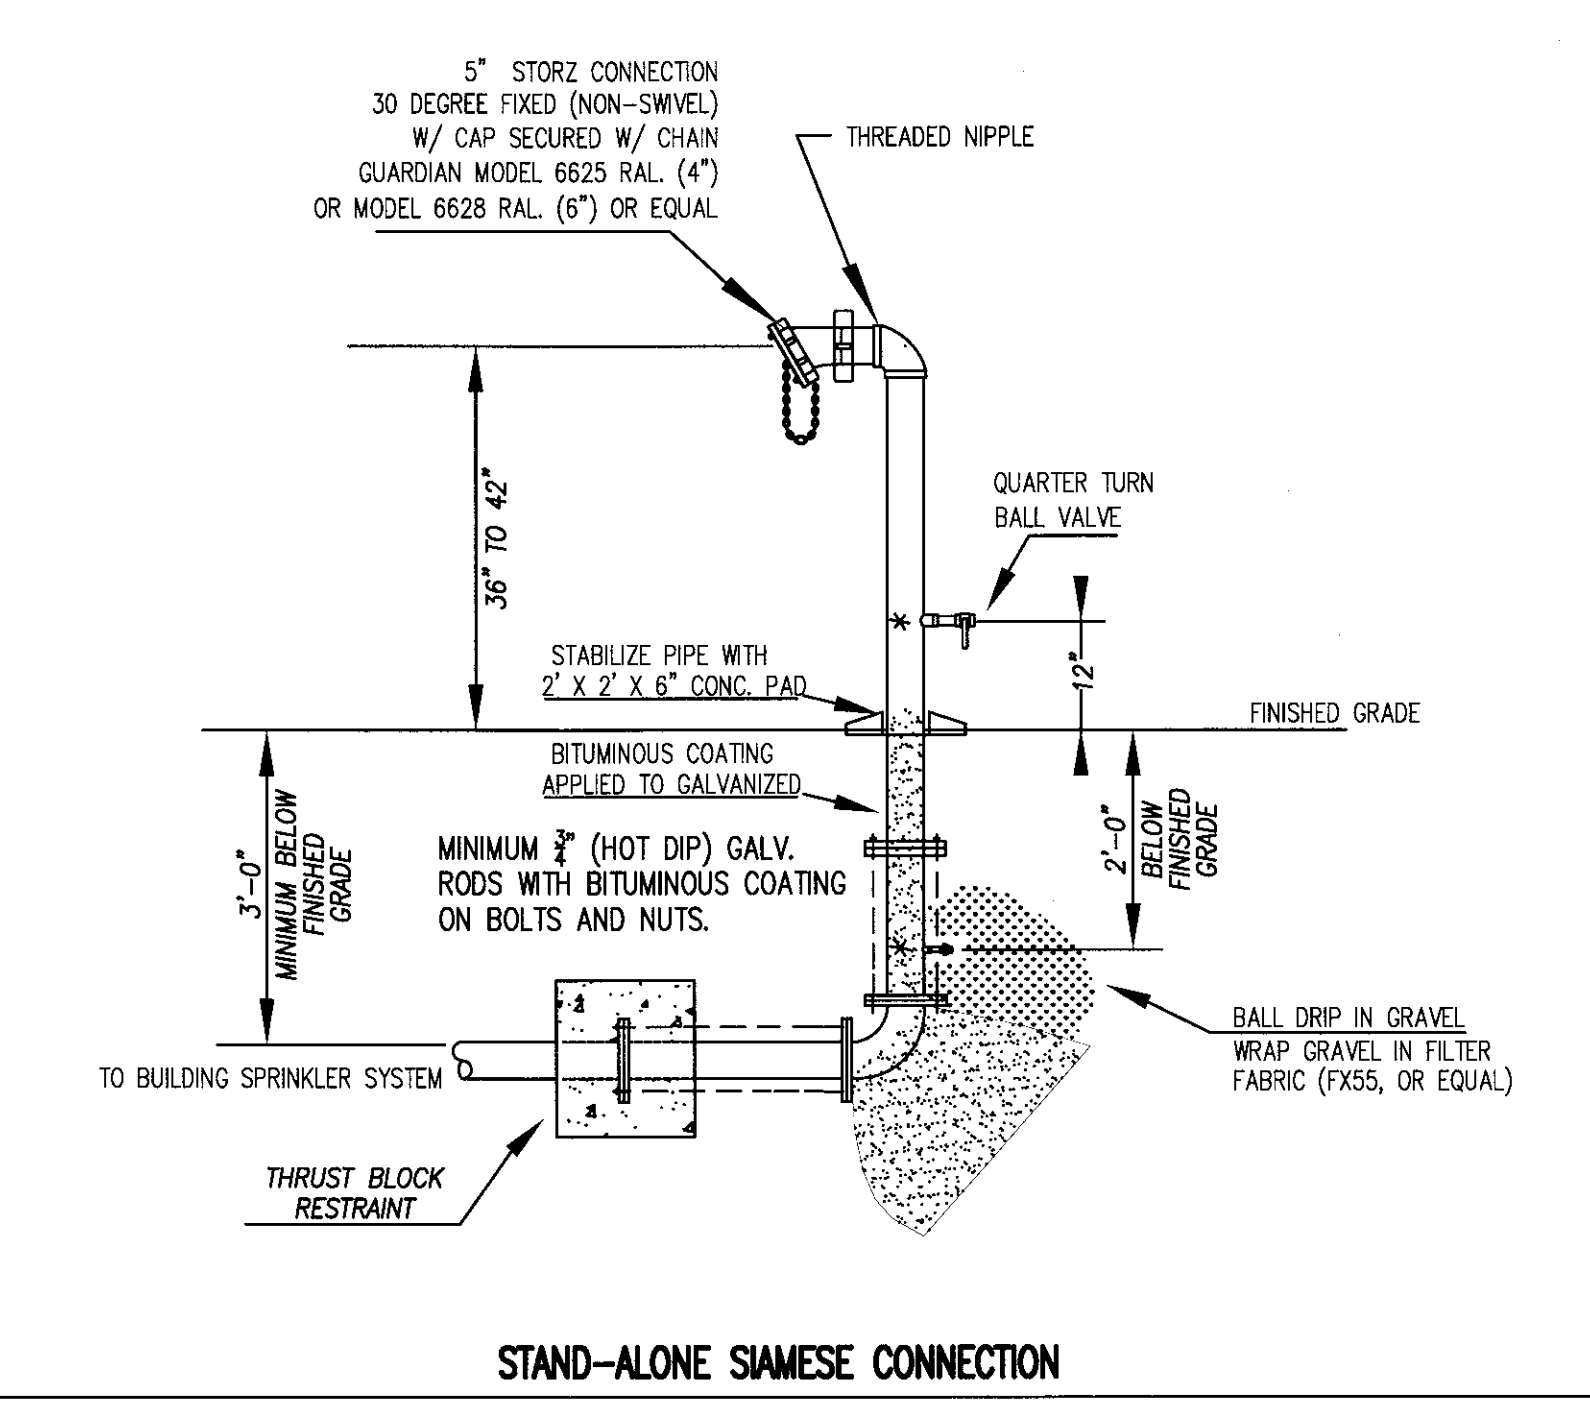

No.	Revision	By	Appd.	Date	Drawn	ECI
1	COORDINATION & COMMENTS	ECI	RHW	6/29/17	Designed	ECI
2	REROUTE UTILITIES	ECI	RHW	8/11/17		
3	FIRE & ZONING COMMENTS	ECI	RHW	9/12/17	Checked	RHW
4	WATERLINE FIELD REVISION	ECI	RHW	9/21/17	Approved	RHW