Drawn By: Author
Checked By: Checker
Approved By: Approver

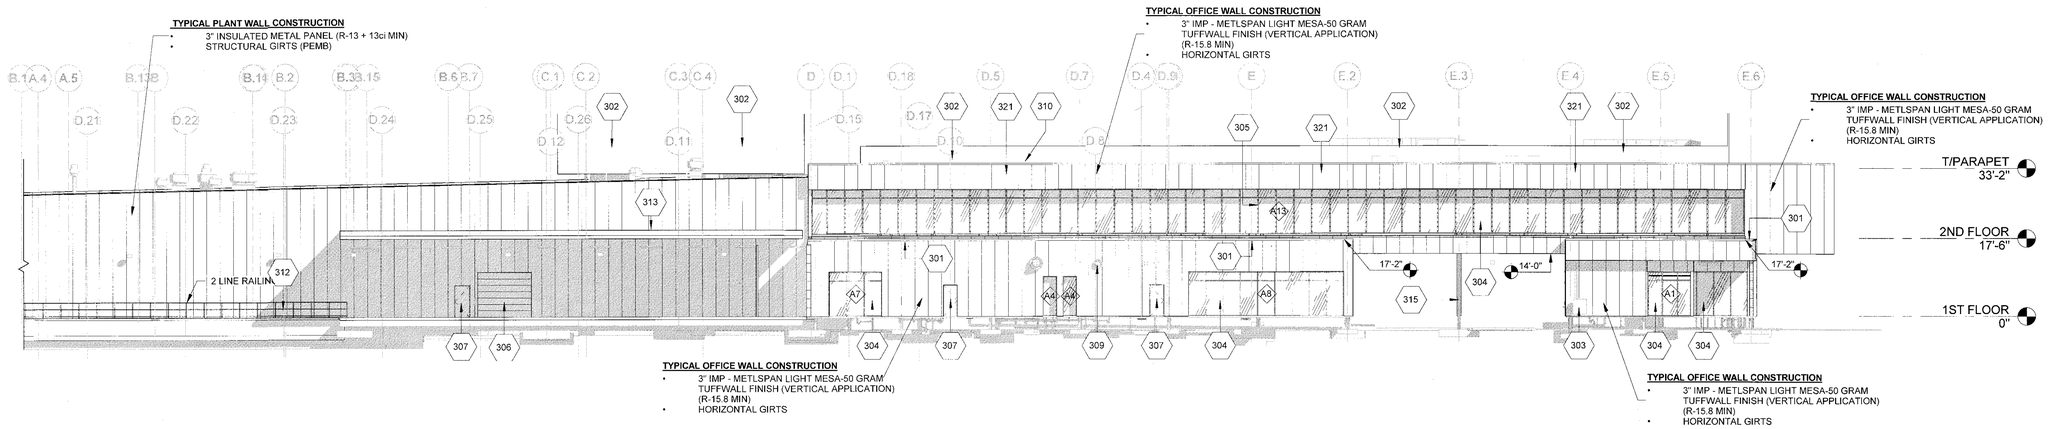

3 PLANT / OFFICE WEST ELEVATION
1/16" = 1'-0"

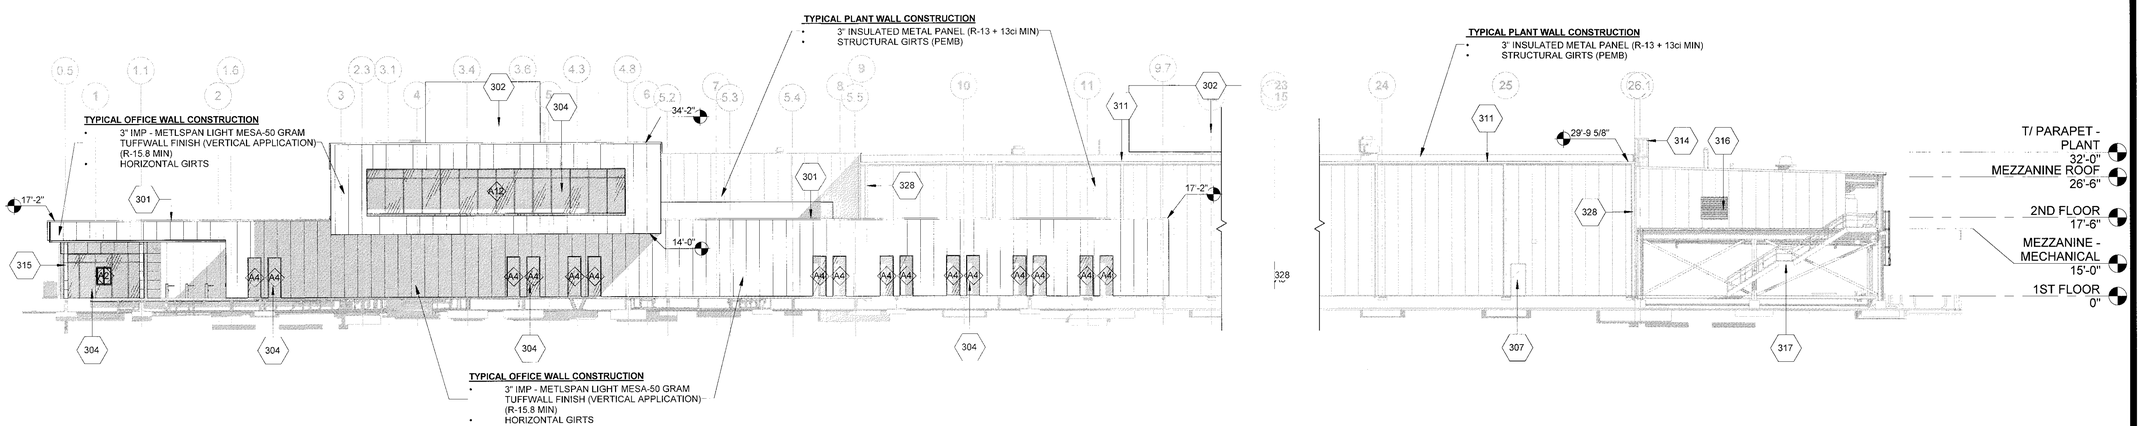

2 PLANT / OFFICE SOUTH ELEVATION
1/16" = 1'-0"

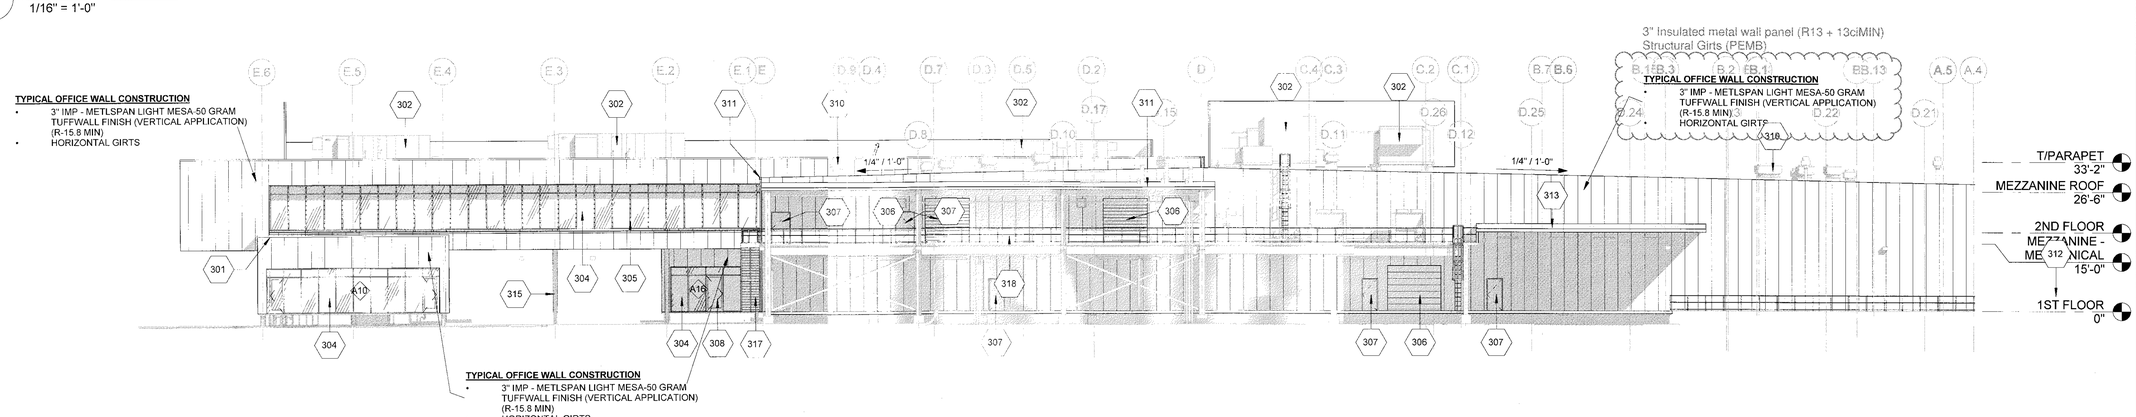

1 PLANT / OFFICE EAST ELEVATION
1/16" = 1'-0"

9/18/2017 4:40:29 PM BIM 360://42439.00 Eldor/4243900_Central_Arch_2016.rvt

G S & P
Design Services For The Built Environment
GRESHAM SMITH AND PARTNERS
www.greshamsmith.com

1400 Nashville City Center
511 Union Street
Nashville, TN 37219
615.770.8100

ELDOR MANUFACTURING PLANT
888 INTERNATIONAL PARKWAY
DALEVILLE, VA 24083

Revision		
No.	Date	Description

EXTERIOR ELEVATIONS

AS05

PROJECT: 4243900
DATE: 04/18/2017

LINE IS 3 INCHES WHEN PRINTED FULL SIZE
FULL SHEET SIZE = 24"X36"