


Power Poles Property of Appalachian Power Co., Roanoke, Va.
Telephone Poles Property of Roanoke-Baltimore Tel. Co., Danville, Va.
Telegraph Poles Property of Norfolk & Western R.R., Roanoke, Va.
Water Lines Property of Hub Water Co., Troutville, Va.



- (18-1) STD. DI-12A REQ'D. MED. L=4' H=11' INV. 1255.4 TYPE I GRATE REQ'D.
- (18-2) 66'-24" CONC. PIPE REQ'D. (6' Cover) INLET ELEV. 1256.8 OUTLET ELEV. 1255.5 I-STD. ES-1 REQ'D.
- (18-3) 90'-24" CONC. PIPE REQ'D. (10' Cover) INLET ELEV. 1255.4 OUTLET ELEV. 1248.9 I-STD. EW-1 REQ'D. LT SBL
- (18-4) STD. EC-1 REQ'D. TYPE 'B' LT SBL
- (18-5) STD. PG-2A TYPE 'D' REQ'D.
- (18-6) 68'-15" CORR. PIPE REQ'D. (Min. Cover) I-STD. EW-1 REQ'D. STD. EG-1 TYPE 'A' REQ'D.
- (18-7) I-SPECIAL DESIGN BRIDGE SHOULDER SLOT INLET REQ'D. TYPE I (See Sht. No. for Details)
- (18-8) STD. DA-1 REQ'D. TYPE II CHUTE REQ'D.

- (18-9) STD. PG-4 REQ'D. I-STD. ES-1 REQ'D.
- (18-10) 42' STD. D. CD-2 REQ'D.
- (18-11) 44' STD. D. CD-2 REQ'D.
- (18-12) 42' STD. D. CD-2 REQ'D.
- (18-13) 44' STD. D. CD-2 REQ'D.
- (18-14) 28'-15" PIPE (Min. Cover)

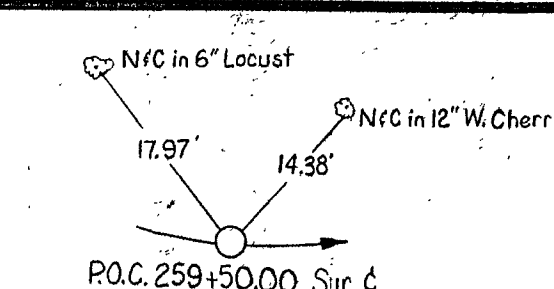

DESIGN FEATURES RELATING TO CONSTRUCTION OR TO REGULATION AND CONTROL OF TRAFFIC MAY BE SUBJECT TO CHANGE AS DEEMED NECESSARY BY THE DEPARTMENT.

REVISED	PHWA REGION	STATE	FEDERAL AID PROJECT	ROUTE	STATE PROJECT	SHEET NO.
	3	VA		220	6220-011-104, PE-101 6220-011-104, RW-201 6220-011-104, C-501	18

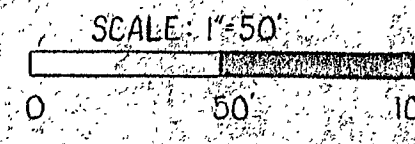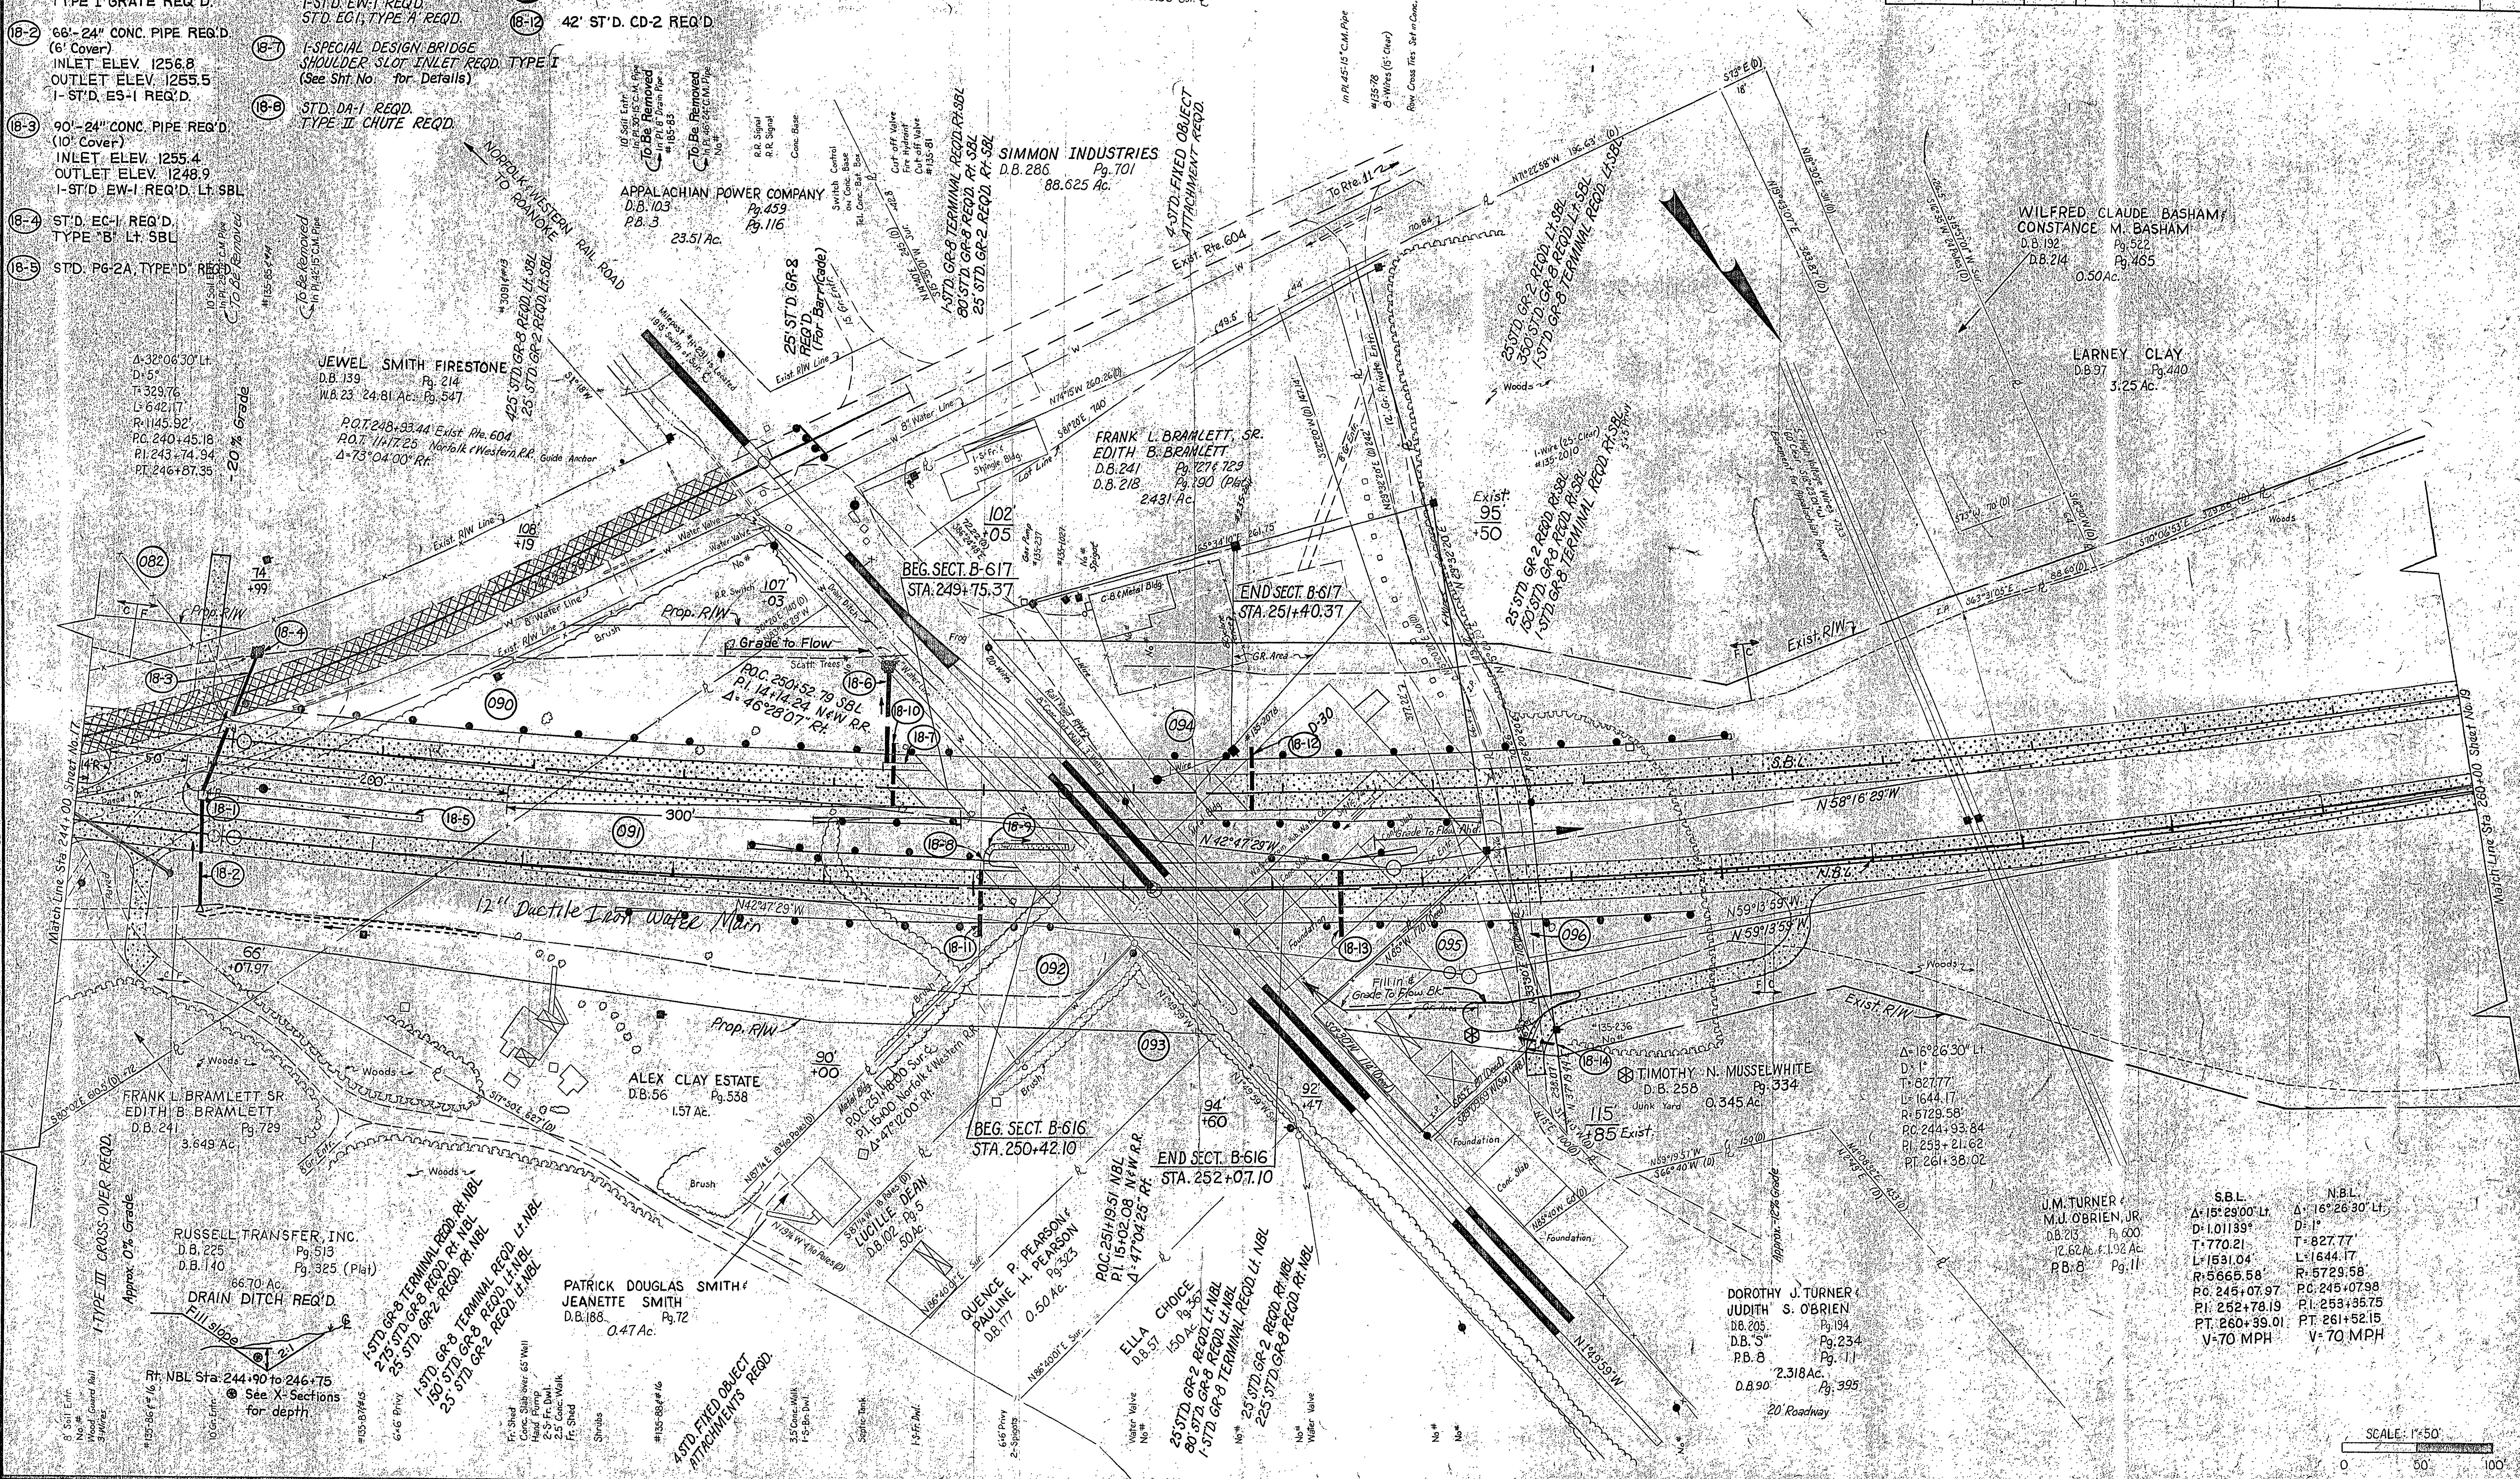

PLAN NO.	PROJECT	FILE NO.	SHEET NO.
A	6220-011-104, C-501		18