


Power Poles Property of Appalachian Power Co., Roanoke, Va.
Telephone Poles Property of Chesapeake & Potomac Telephone Co., Roanoke, Va.
Water Lines Property of Hub Water Co., Troutville, Va.
Telephone Poles Property of Roanoke & Balfour Tele. Co., Daleville, Va.

- (19-14) 42"-18" CONC. PIPE REQ'D LT. SBL
- (19-15) 76"-30" CONC. PIPE REQ'D
- (19-16) ST'D. DI-2B REQ'D. MED. L=6'
- (19-17) 6"-18" CONC. PIPE REQ'D
- (19-18) ST'D. DI-2B REQ'D. MED. L=10'
- (19-19) 70"-18" CONC. PIPE REQ'D
- (19-20) ST'D. DI-7A REQ'D. RT. NBL GRATE A, TYPE II

DESIGN FEATURES RELATING TO CONSTRUCTION OR TO REGULATION AND CONTROL OF TRAFFIC MAY BE SUBJECT TO CHANGE AS DEEMED NECESSARY BY THE DEPARTMENT.

- (19-21) 60"-36" CONC. PIPE REQ'D
- (19-22) ST'D. PG-4 REQ'D. RT. NBL
- (19-23) ST'D. EG-1 REQ'D. RT. NBL
- (19-24) 1145' ST'D. UD-1 REQ'D. To be tied to Prop. DI
- (19-25) 1100' ST'D. UD-1 REQ'D. To be tied to Prop. DI

REVISED	FHWA REGION	STATE	FEDERAL AID PROJECT	ROUTE	PROJECT	SHEET NO.
	3	VA		220	6220-011-104, PE-101 6220-011-104, RW-201 6220-011-104, C-501	19

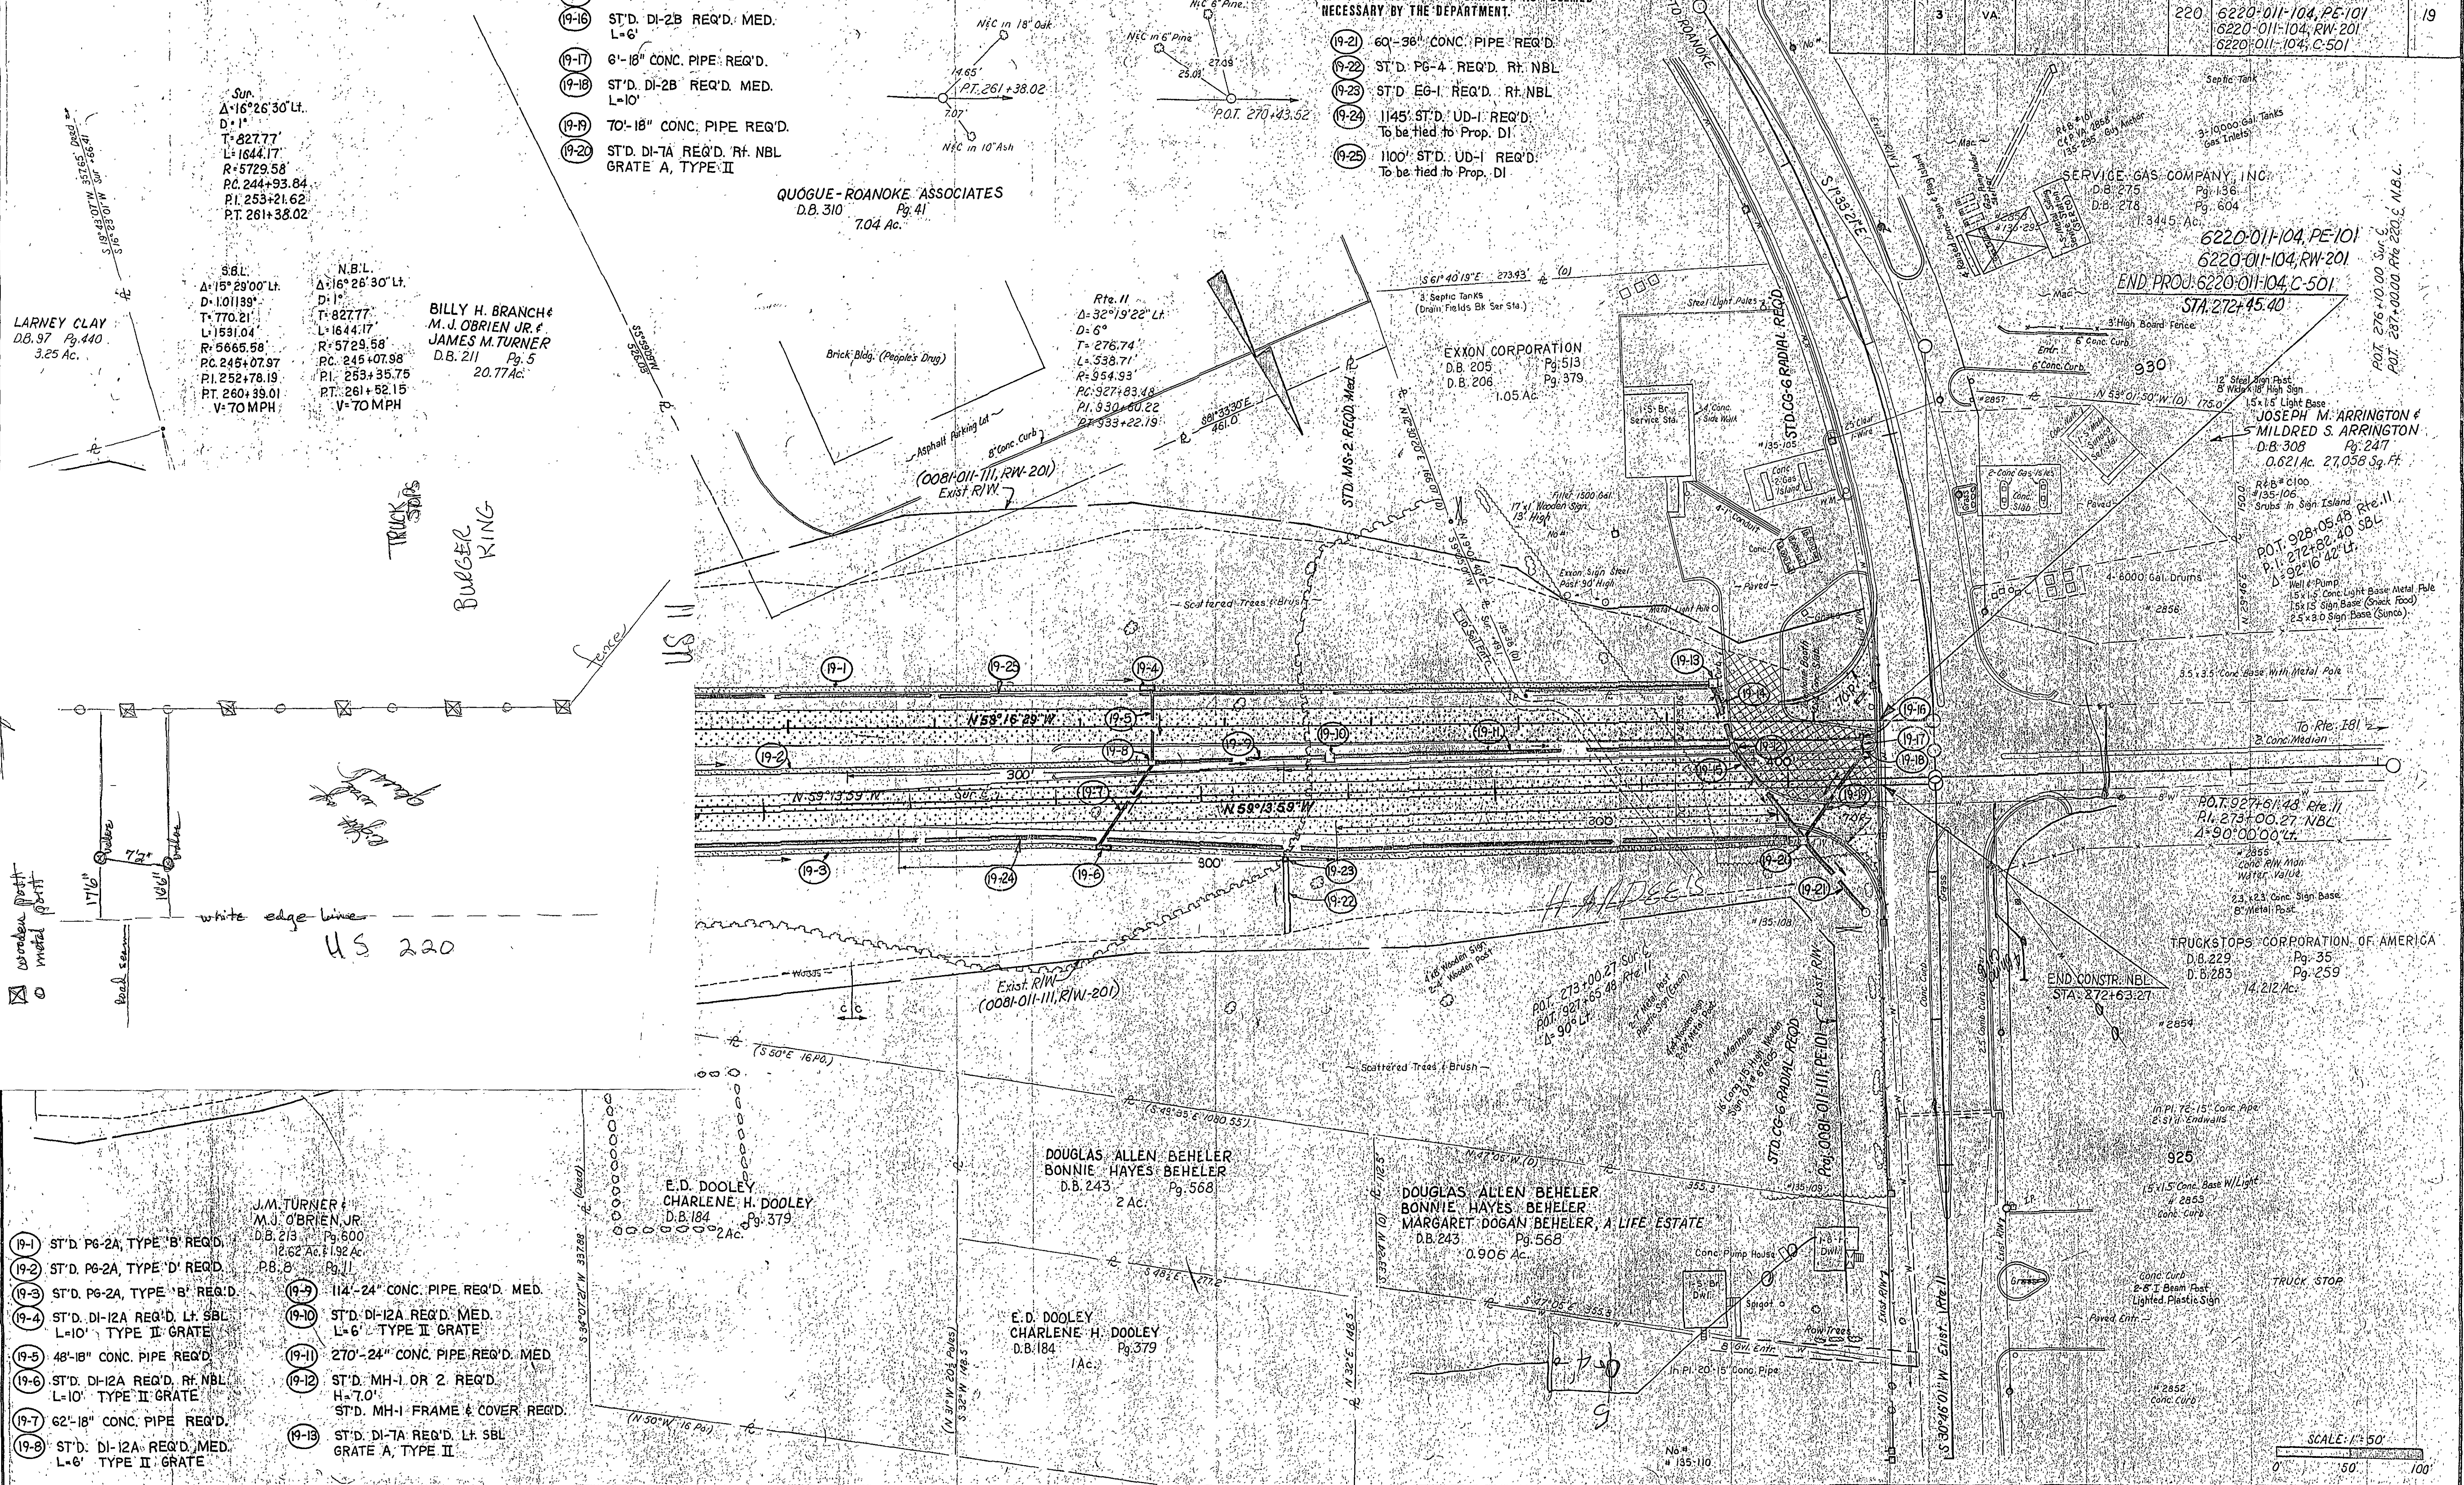

- (19-1) ST'D. PG-2A, TYPE 'B' REQ'D
- (19-2) ST'D. PG-2A, TYPE 'D' REQ'D
- (19-3) ST'D. PG-2A, TYPE 'B' REQ'D
- (19-4) ST'D. DI-12A REQ'D. LT. SBL L=10' TYPE II GRATE
- (19-5) 48"-18" CONC. PIPE REQ'D
- (19-6) ST'D. DI-12A REQ'D. RT. NBL L=10' TYPE II GRATE
- (19-7) 62"-18" CONC. PIPE REQ'D
- (19-8) ST'D. DI-12A REQ'D. MED. L=6' TYPE II GRATE
- J.M. TURNER & M.J. O'BRIEN JR. D.B. 219 Pg. 600 12.62 Ac. & 1.92 Ac. P.B. 8 Pg. 11
- (19-9) 114'-24" CONC. PIPE REQ'D. MED.
- (19-10) ST'D. DI-12A REQ'D. MED. L=6' TYPE II GRATE
- (19-11) 270'-24" CONC. PIPE REQ'D. MED.
- (19-12) ST'D. MH-1 OR 2 REQ'D. H=7.0' ST'D. MH-1 FRAME & COVER REQ'D.
- (19-13) ST'D. DI-7A REQ'D. LT. SBL GRATE A, TYPE II

