


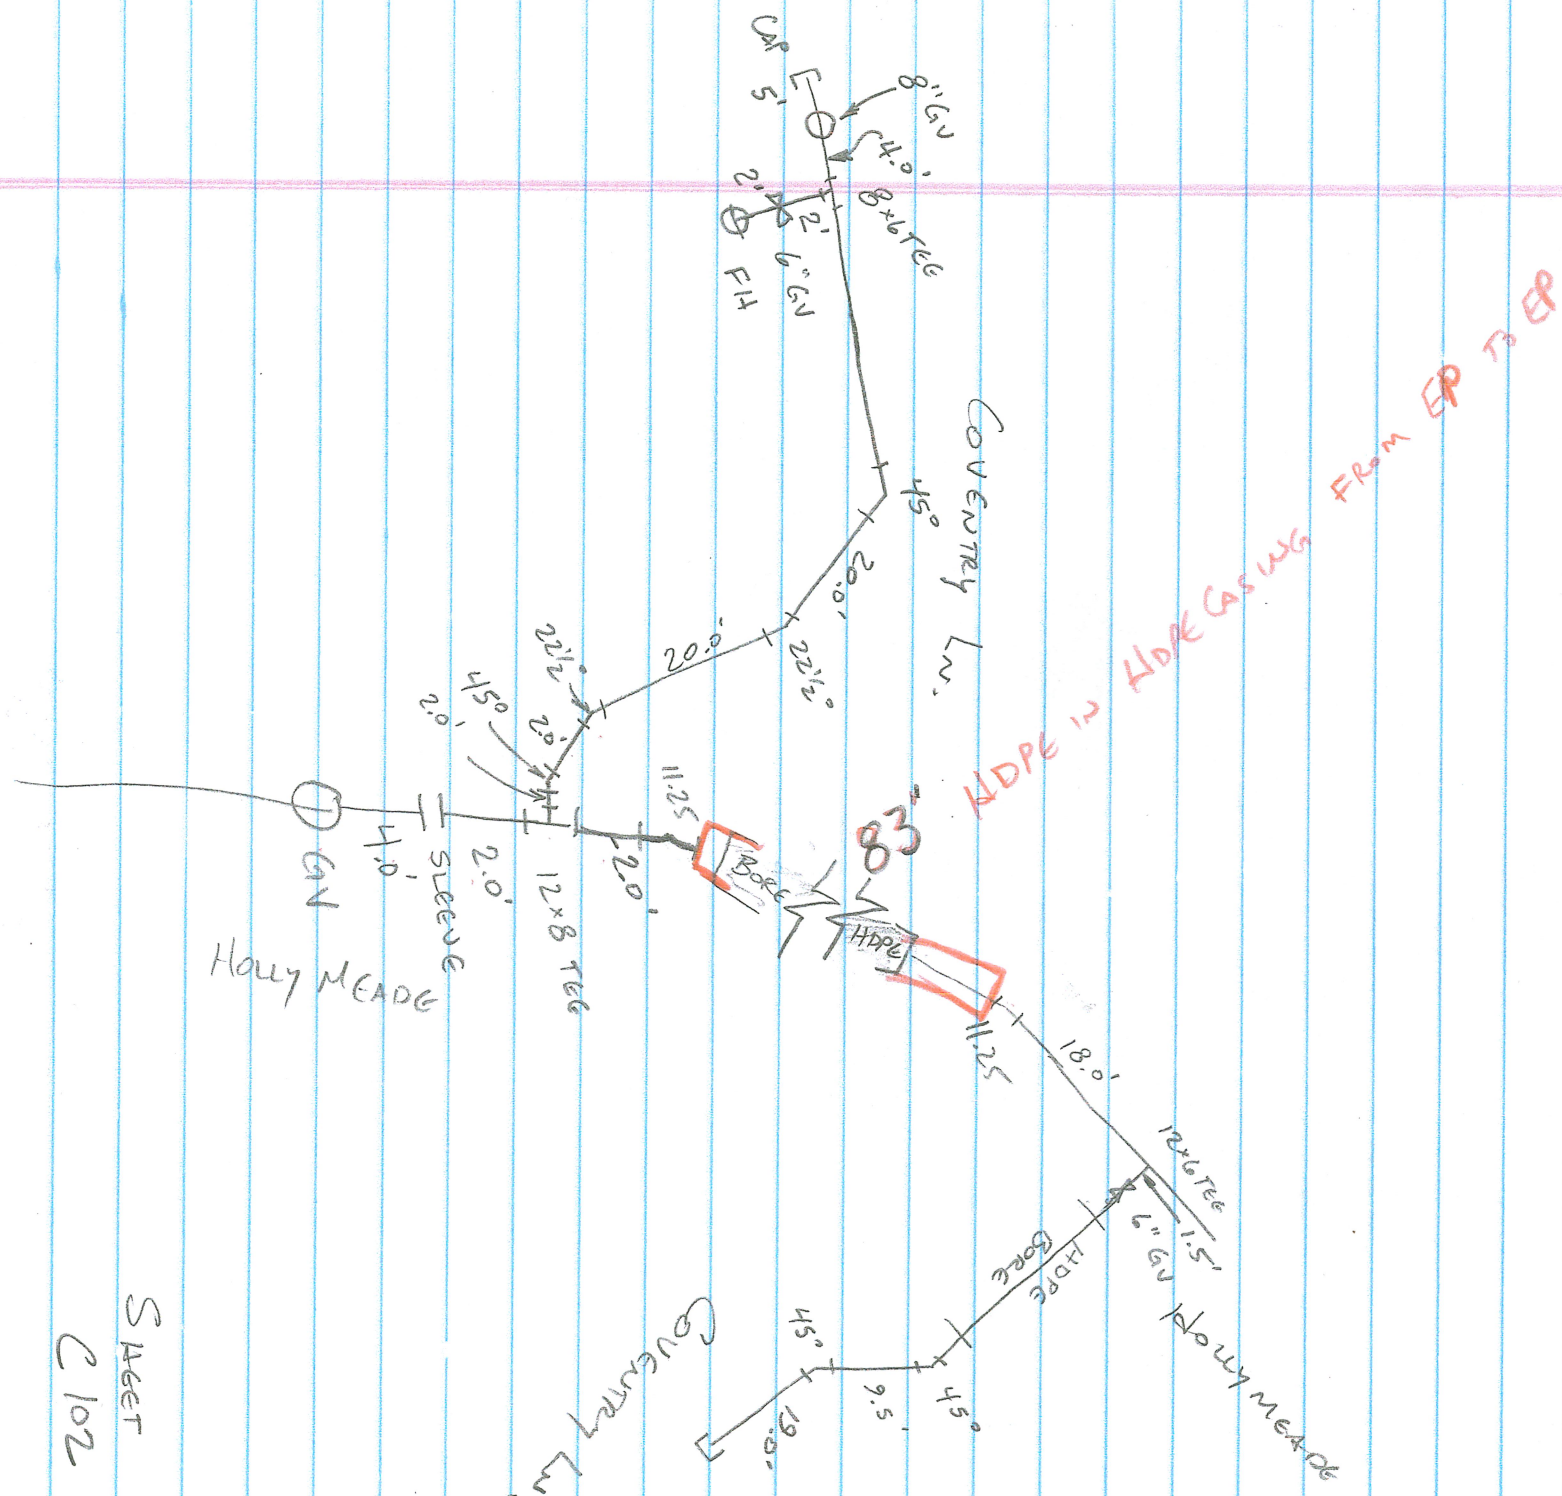

S
A
G
E
T

C
1
0
2