



LARE. INC. BOTETOURT

PREPARED FOR
LARE, INC.

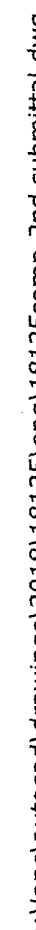

SHEET No.	DESCRIPTION
1	LUMSDEN ASSOCIATES COVER SHEET
2	NOTES & DETAILS
3	DIMENSIONAL LAYOUT
4	GRADING PLAN
5	PROFILES
6	LANDSCAPE PLAN
7	EROSION AND SEDIMENT CONTROL PLAN
8	EROSION & SEDIMENT CONTROL NARRATIVE, NOTES & DETAILS
9	DETAILS
10	MAINTENANCE OF TRAFFIC PLAN

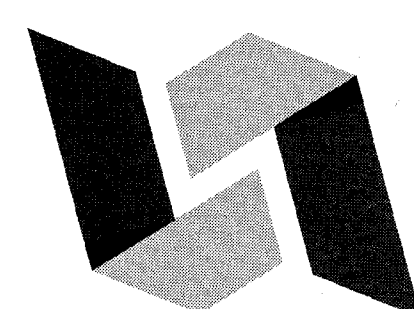

CHARLES CRUSH
AG-BUILTS
11-15-19