


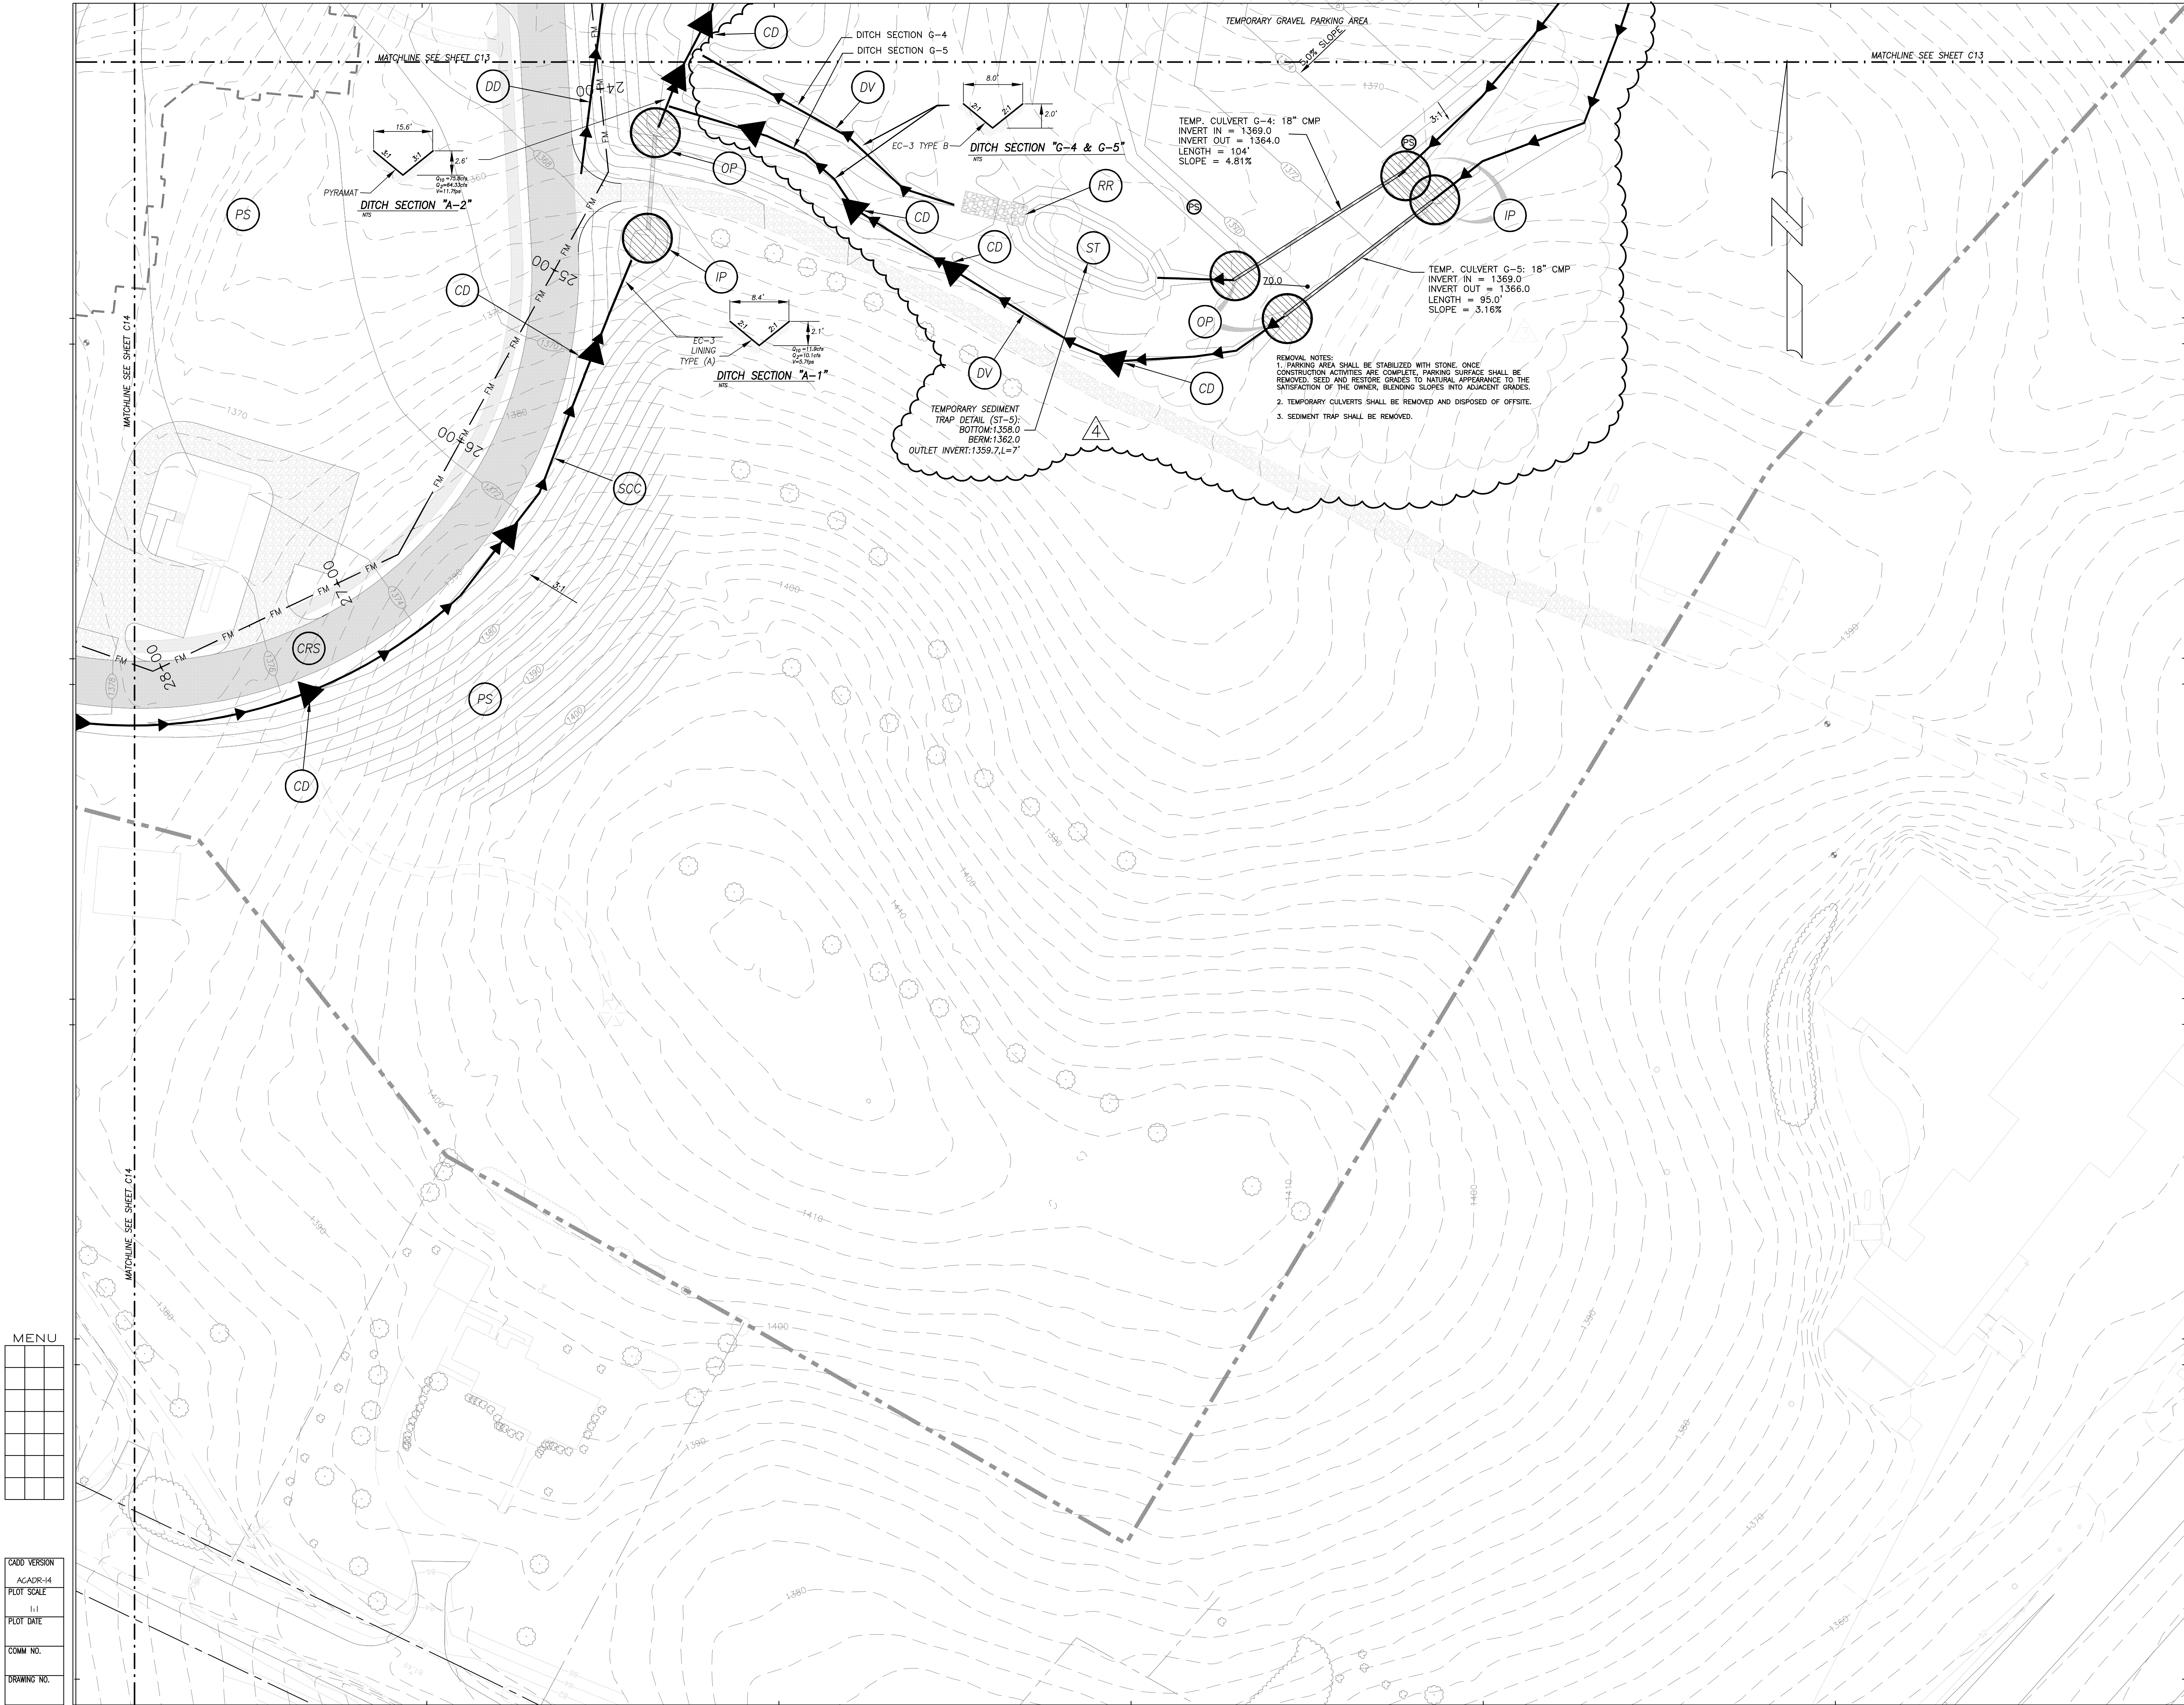

MENU			

CADD VERSION
ACAD-R14
PLOT SCALE
1:1
PLOT DATE
COMM. NO.
DRAWING NO.

KEYPLAN

ENGINEERING
CONCEPTS, INC.

20 South Roanoke St.
Fincastle, Virginia 24090
540.473.1253 540.473.1254(Fax)
email@engineeringconcepts.com
ECI PROJECT #02019

GENERAL NOTES

30' 0' 30' 60'
SCALE: 1"=30'

PROJECT TITLE

SFC S

Architecture
Engineering
Planning
Interiors

SFCS Inc. • 305 South Jefferson Street
Roanoke, Virginia 24011.2003
540.344.6664 • Fax 540.343.6925
www.sfcs.com

PROJECT DESIGNER	: SFCS
PROJECT ARCHITECT	: SFCS
PROJECT ENGINEER	: ECI
DRAWN BY	: ECI
CHECKED BY	: ECI
APPROVED BY	: ECI

NO.	REVISION DESCRIPTION	DATE
3	E&S REVISIONS	9/15/03
4	E&S REVISIONS	10/24/03

DRAWING TITLE

EROSION CONTROL
PLAN

COMM. NO.	DATE
47115.00	11/12/03
DRAWING	SHEET
C15	15 OF 43