

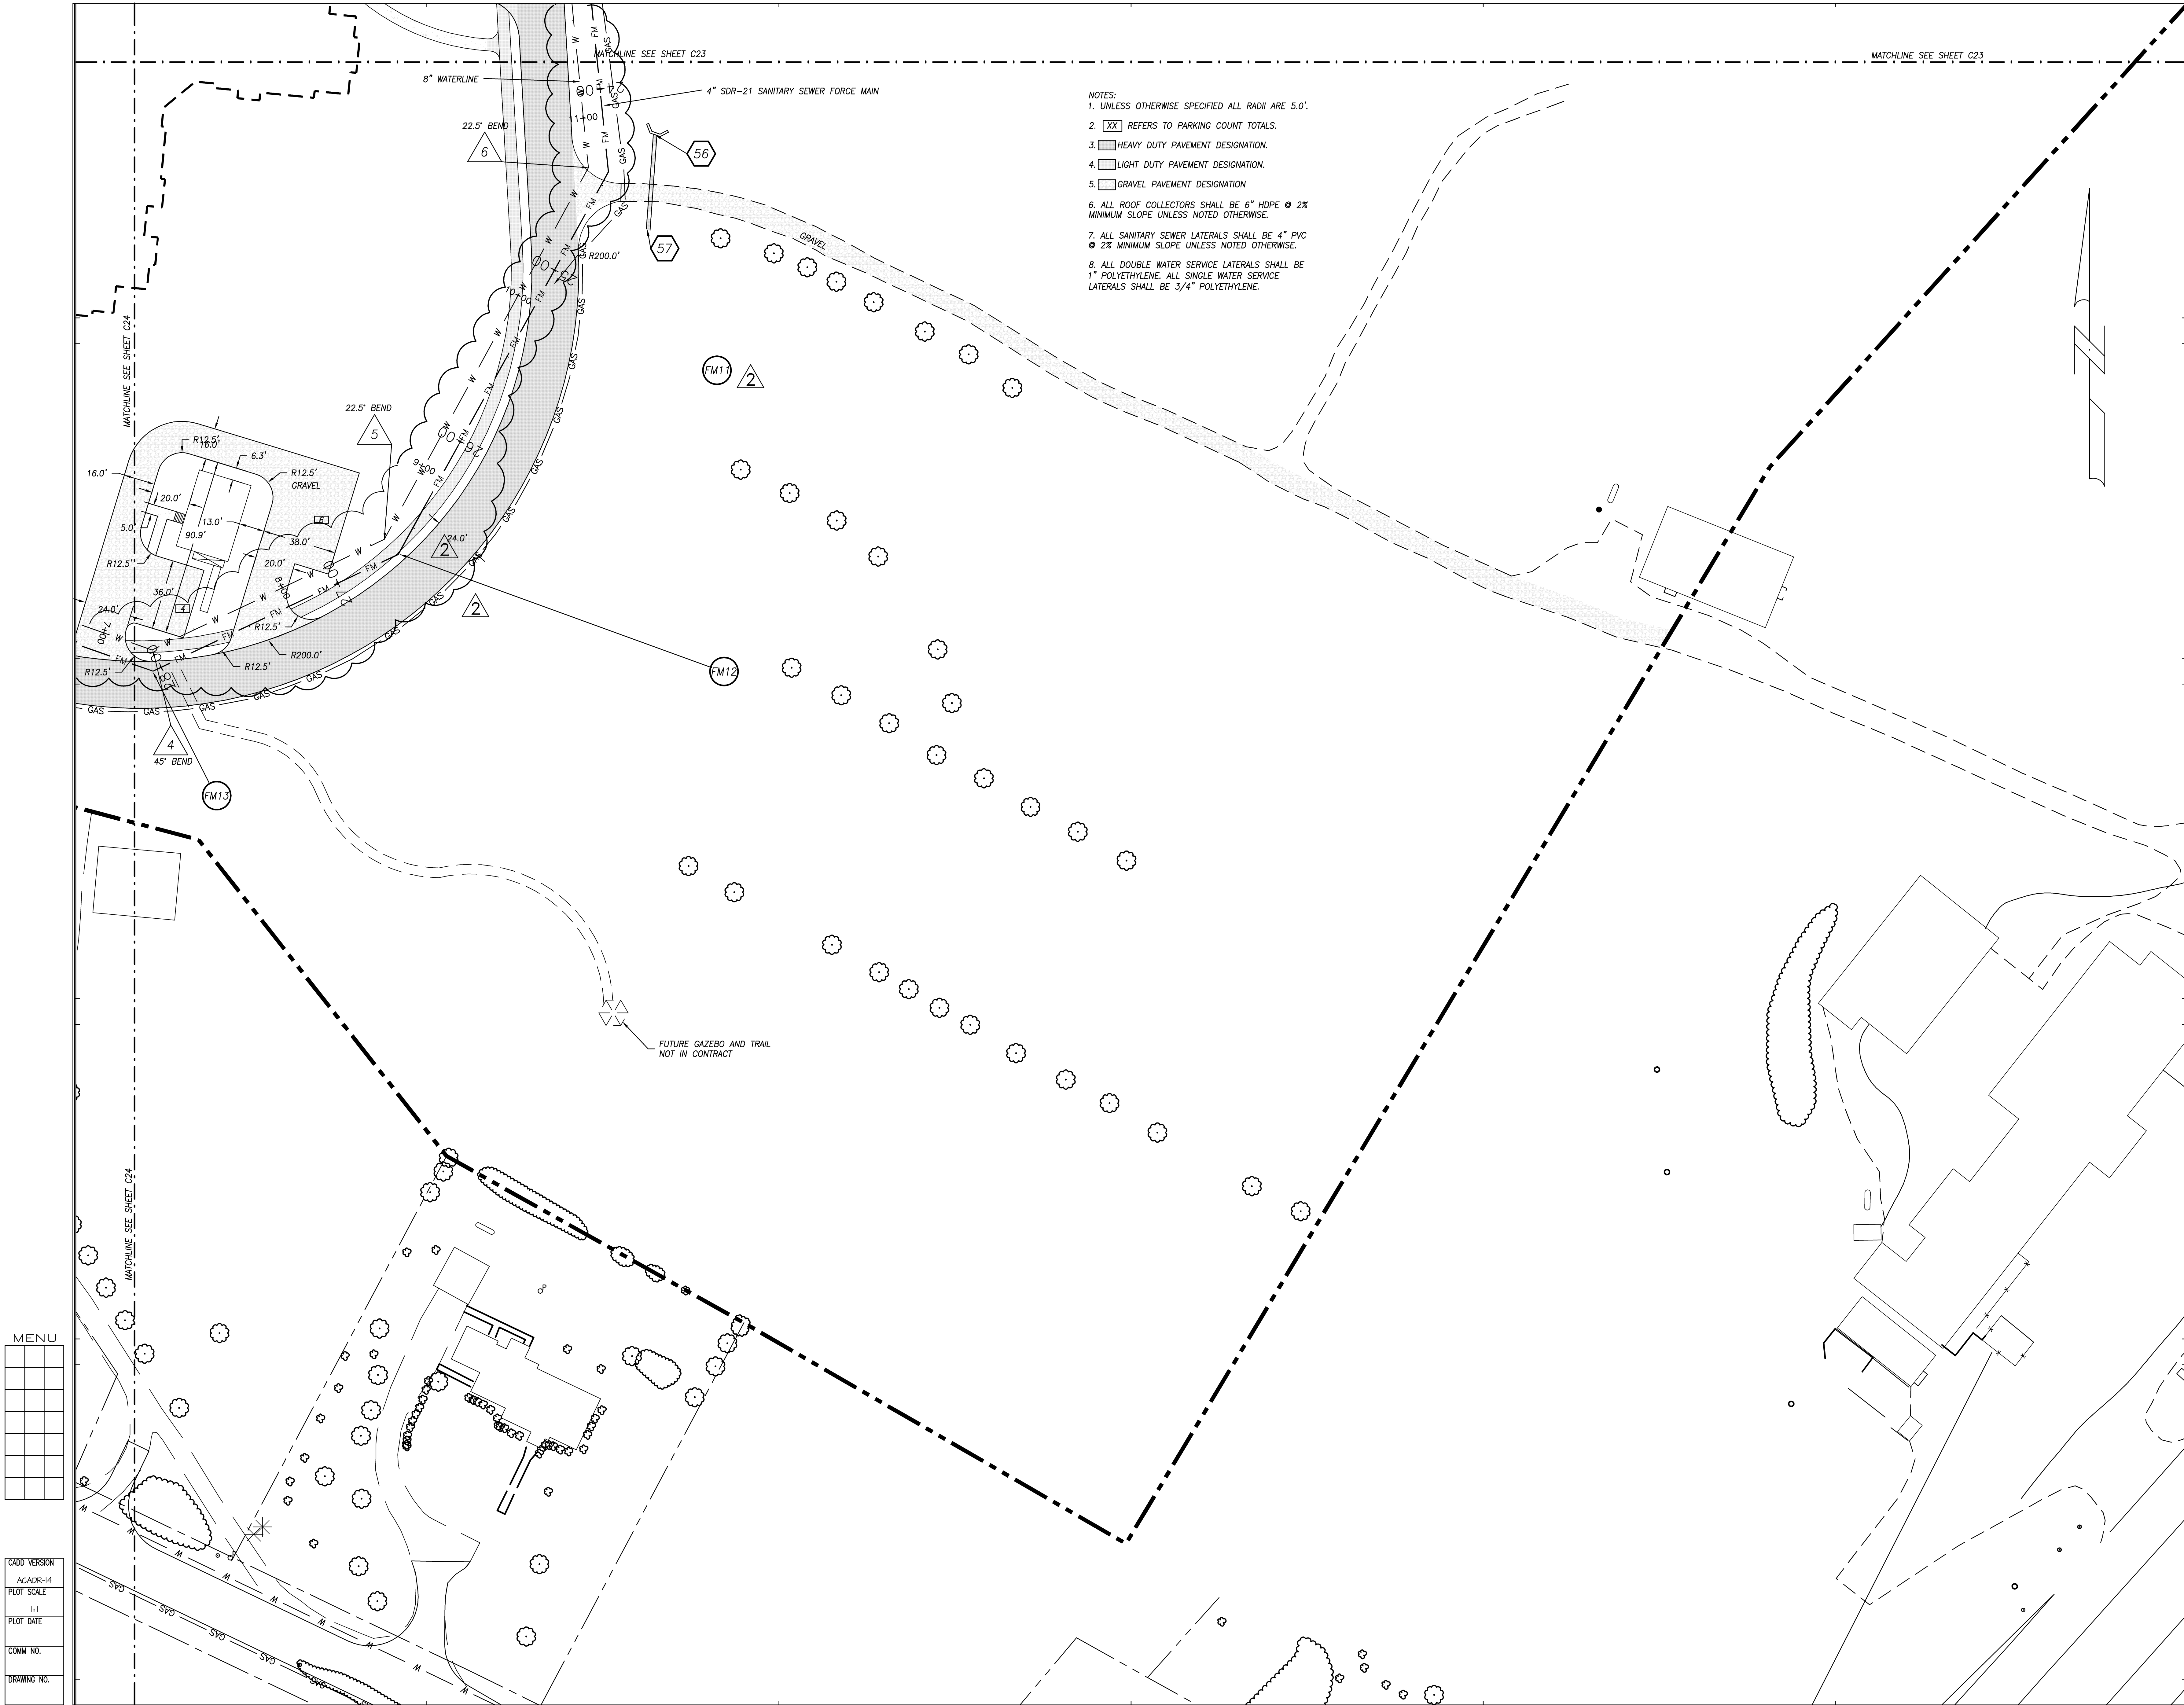



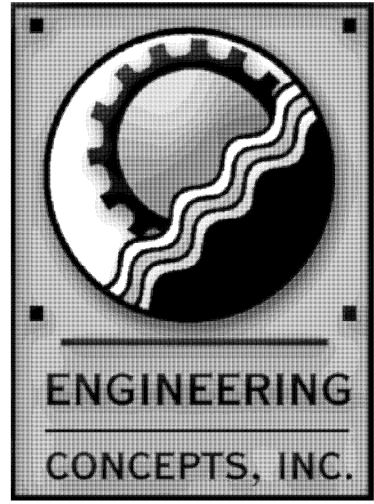


- NOTES:
1. UNLESS OTHERWISE SPECIFIED ALL RADII ARE 5.0'.
 2. [XX] REFERS TO PARKING COUNT TOTALS.
 3. [HEAVY DUTY PAVEMENT DESIGNATION]
 4. [LIGHT DUTY PAVEMENT DESIGNATION]
 5. [GRAVEL PAVEMENT DESIGNATION]
 6. ALL ROOF COLLECTORS SHALL BE 6" HDPE @ 2% MINIMUM SLOPE UNLESS NOTED OTHERWISE.
 7. ALL SANITARY SEWER LATERALS SHALL BE 4" PVC @ 2% MINIMUM SLOPE UNLESS NOTED OTHERWISE.
 8. ALL DOUBLE WATER SERVICE LATERALS SHALL BE 1" POLYETHYLENE. ALL SINGLE WATER SERVICE LATERALS SHALL BE 3/4" POLYETHYLENE.

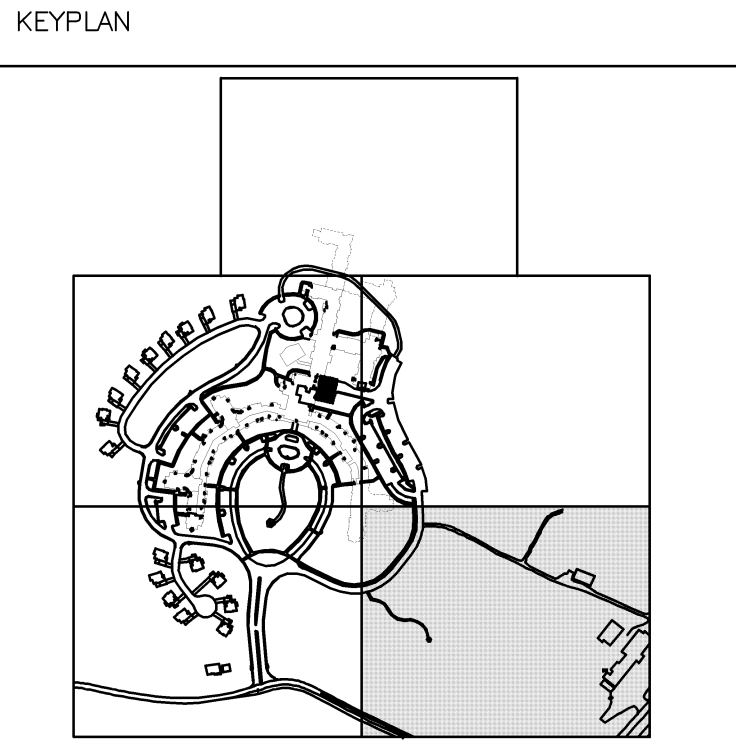

20 South Roanoke St.
Fincastle, Virginia 24090
540.473.1253 540.473.1254(Fax)
email@engineeringconcepts.com
ECI PROJECT #02019

GENERAL NOTES

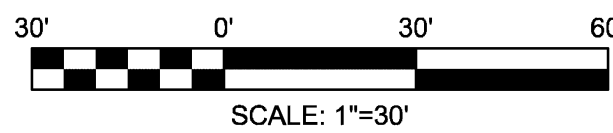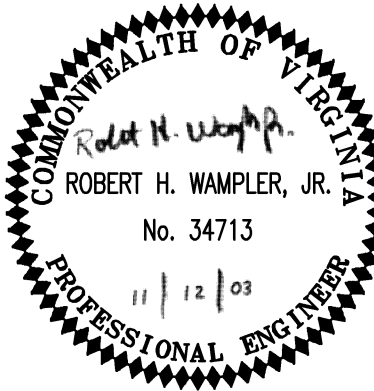

PROJECT TITLE

The Glebe

SFCS

Architecture
Engineering
Planning
Interiors

SFCS Inc. • 305 South Jefferson Street
Roanoke, Virginia 24011.2003
540.344.6664 • Fax 540.343.6925
www.sfcs.com

PROJECT DESIGNER	: SFCS
PROJECT ARCHITECT	: SFCS
PROJECT ENGINEER	: ECI
DRAWN BY	: ECI
CHECKED BY	: ECI
APPROVED BY	: ECI
NO.	REVISION DESCRIPTION DATE

2 SANITARY SEWER REVISIONS 8/06/03

DRAWING TITLE
SITE DIMENSIONAL
AND UTILITY PLAN

COMM. NO. 47115.00	DATE 11/12/03
DRAWING	SHEET

C25

25 OF 43