




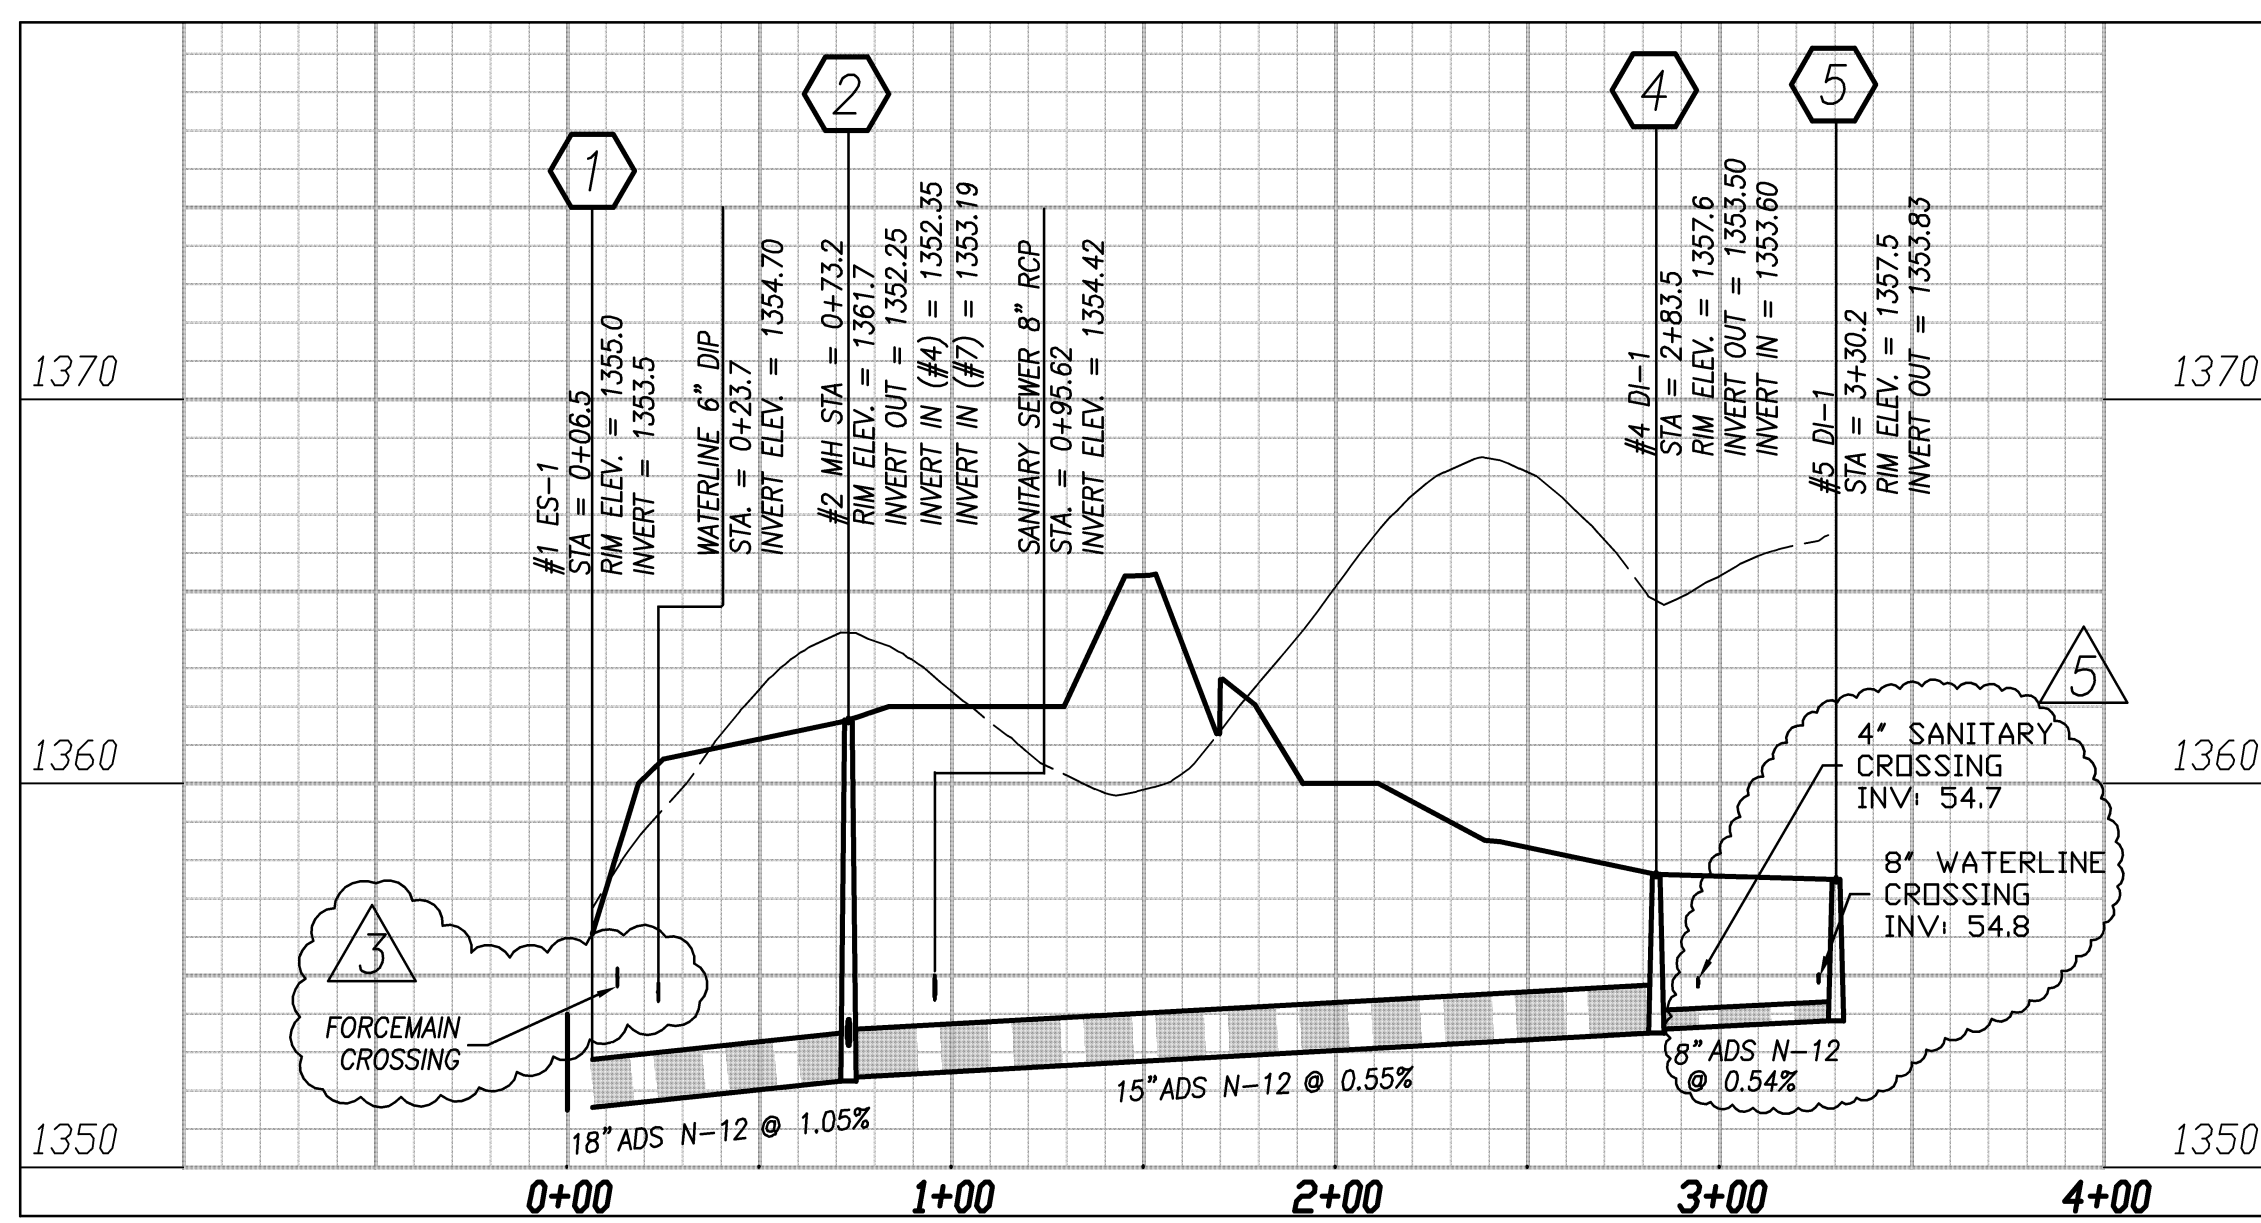


SEE SHEETS C18,C17 AND C23,C22 FOR PLAN VIEW

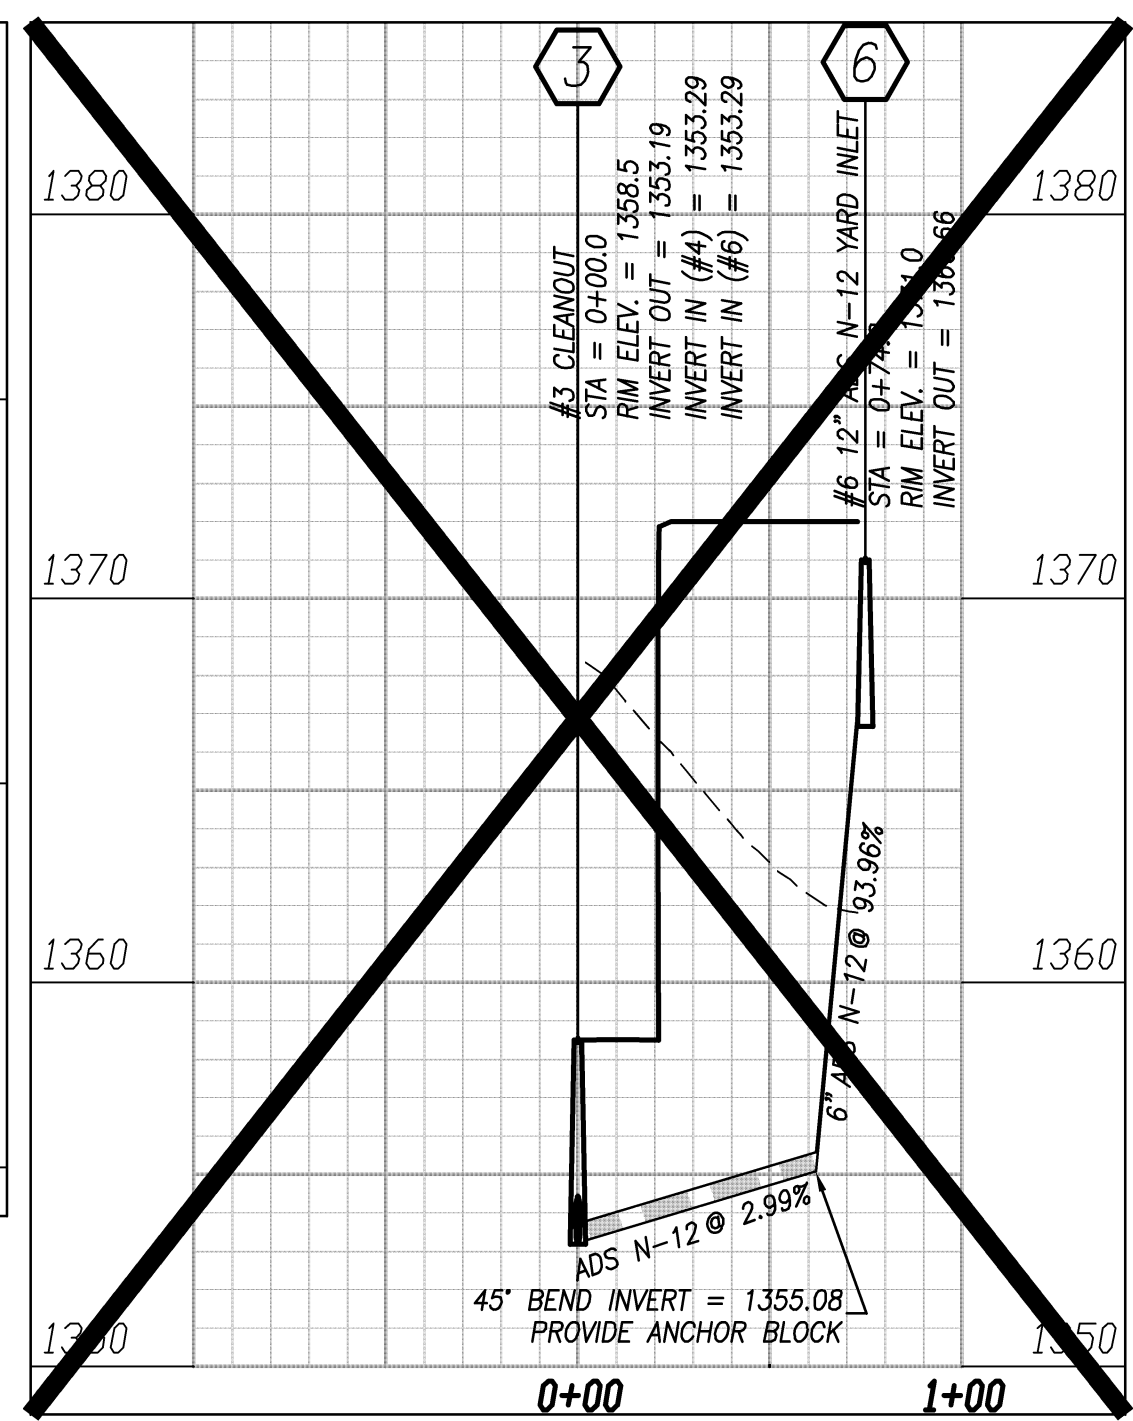


SEE SHEETS C17,C22 FOR PLAN VIEW

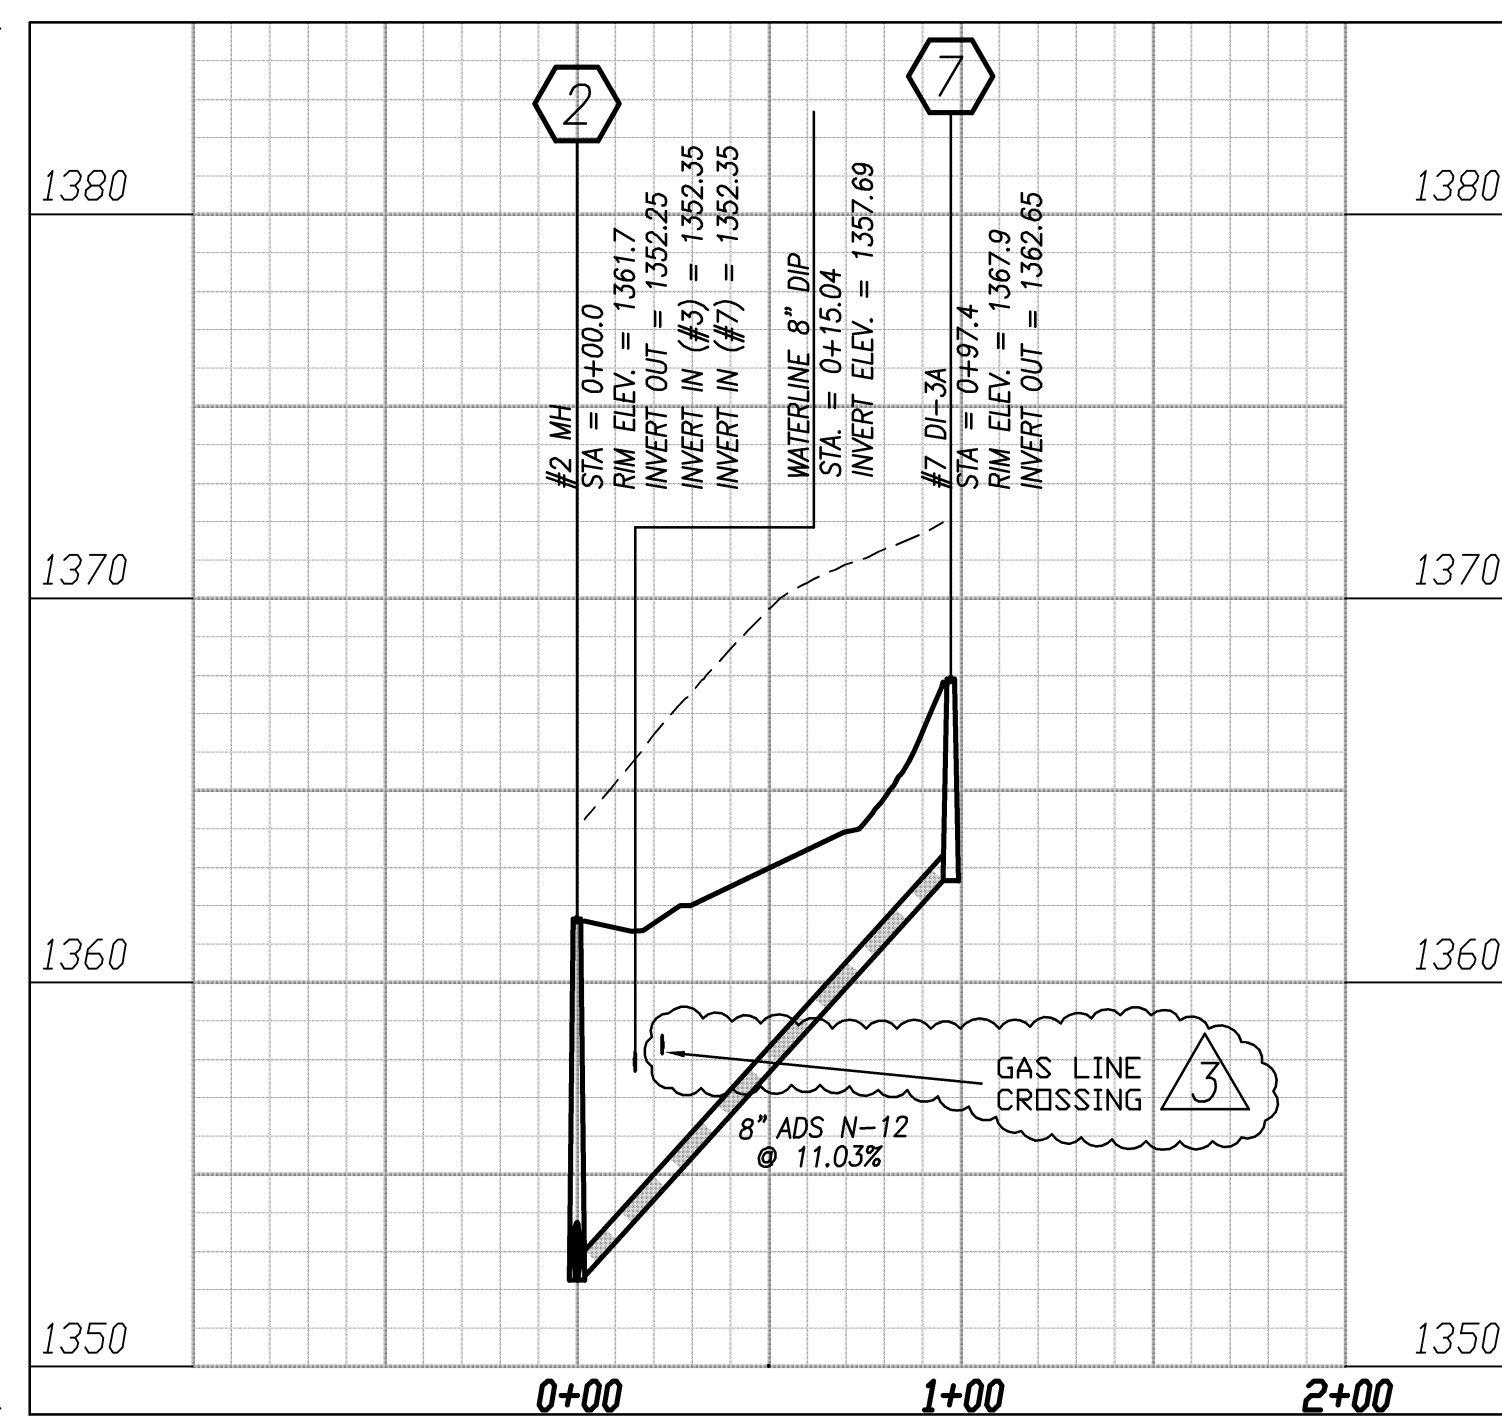


SEE SHEETS C18,C23 FOR PLAN VIEW

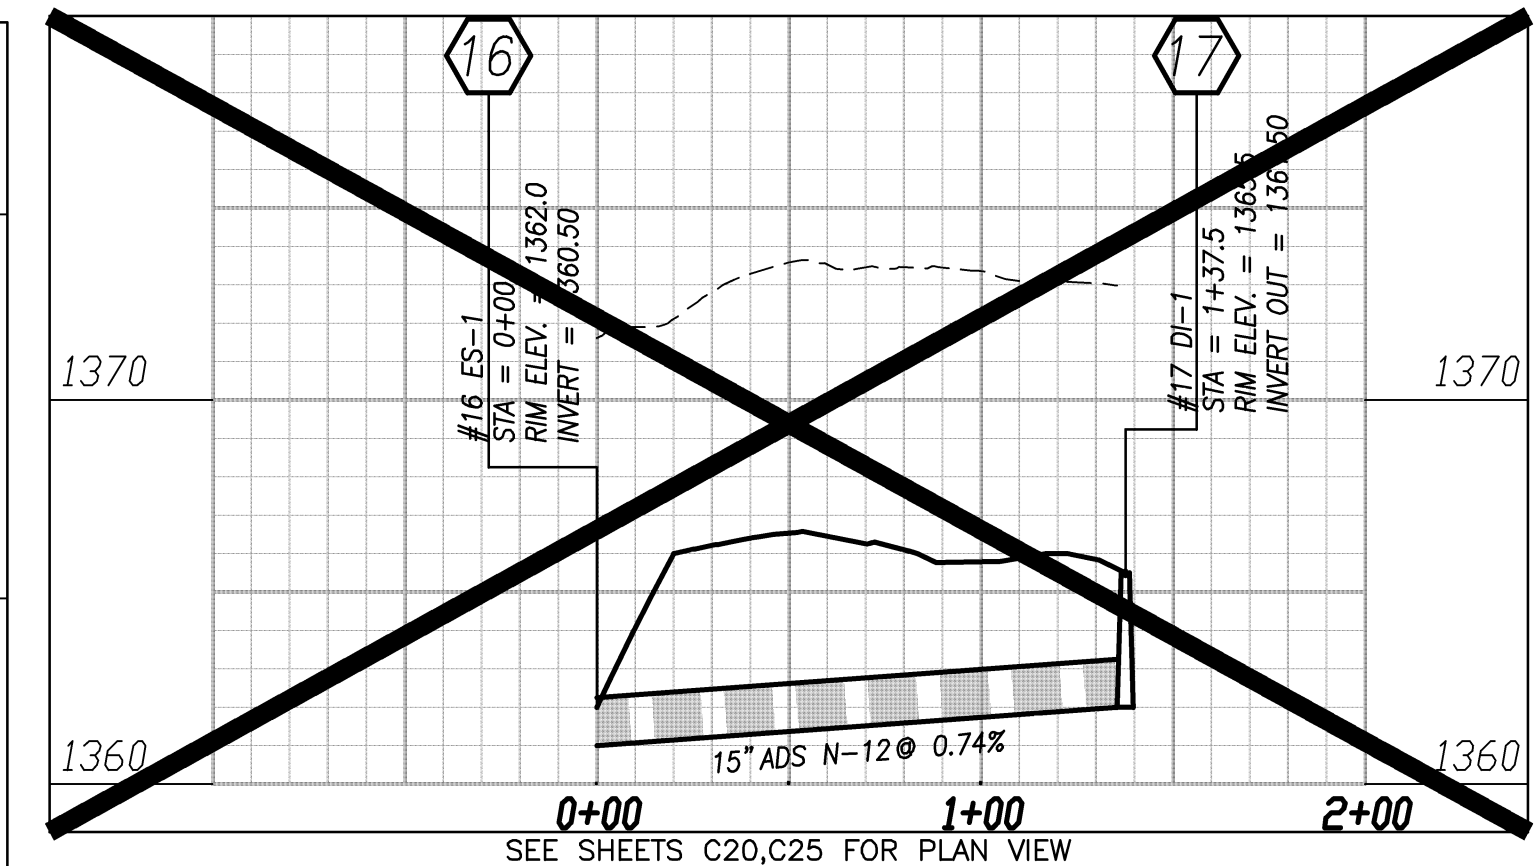


SEE SHEETS C20,C25 FOR PLAN VIEW

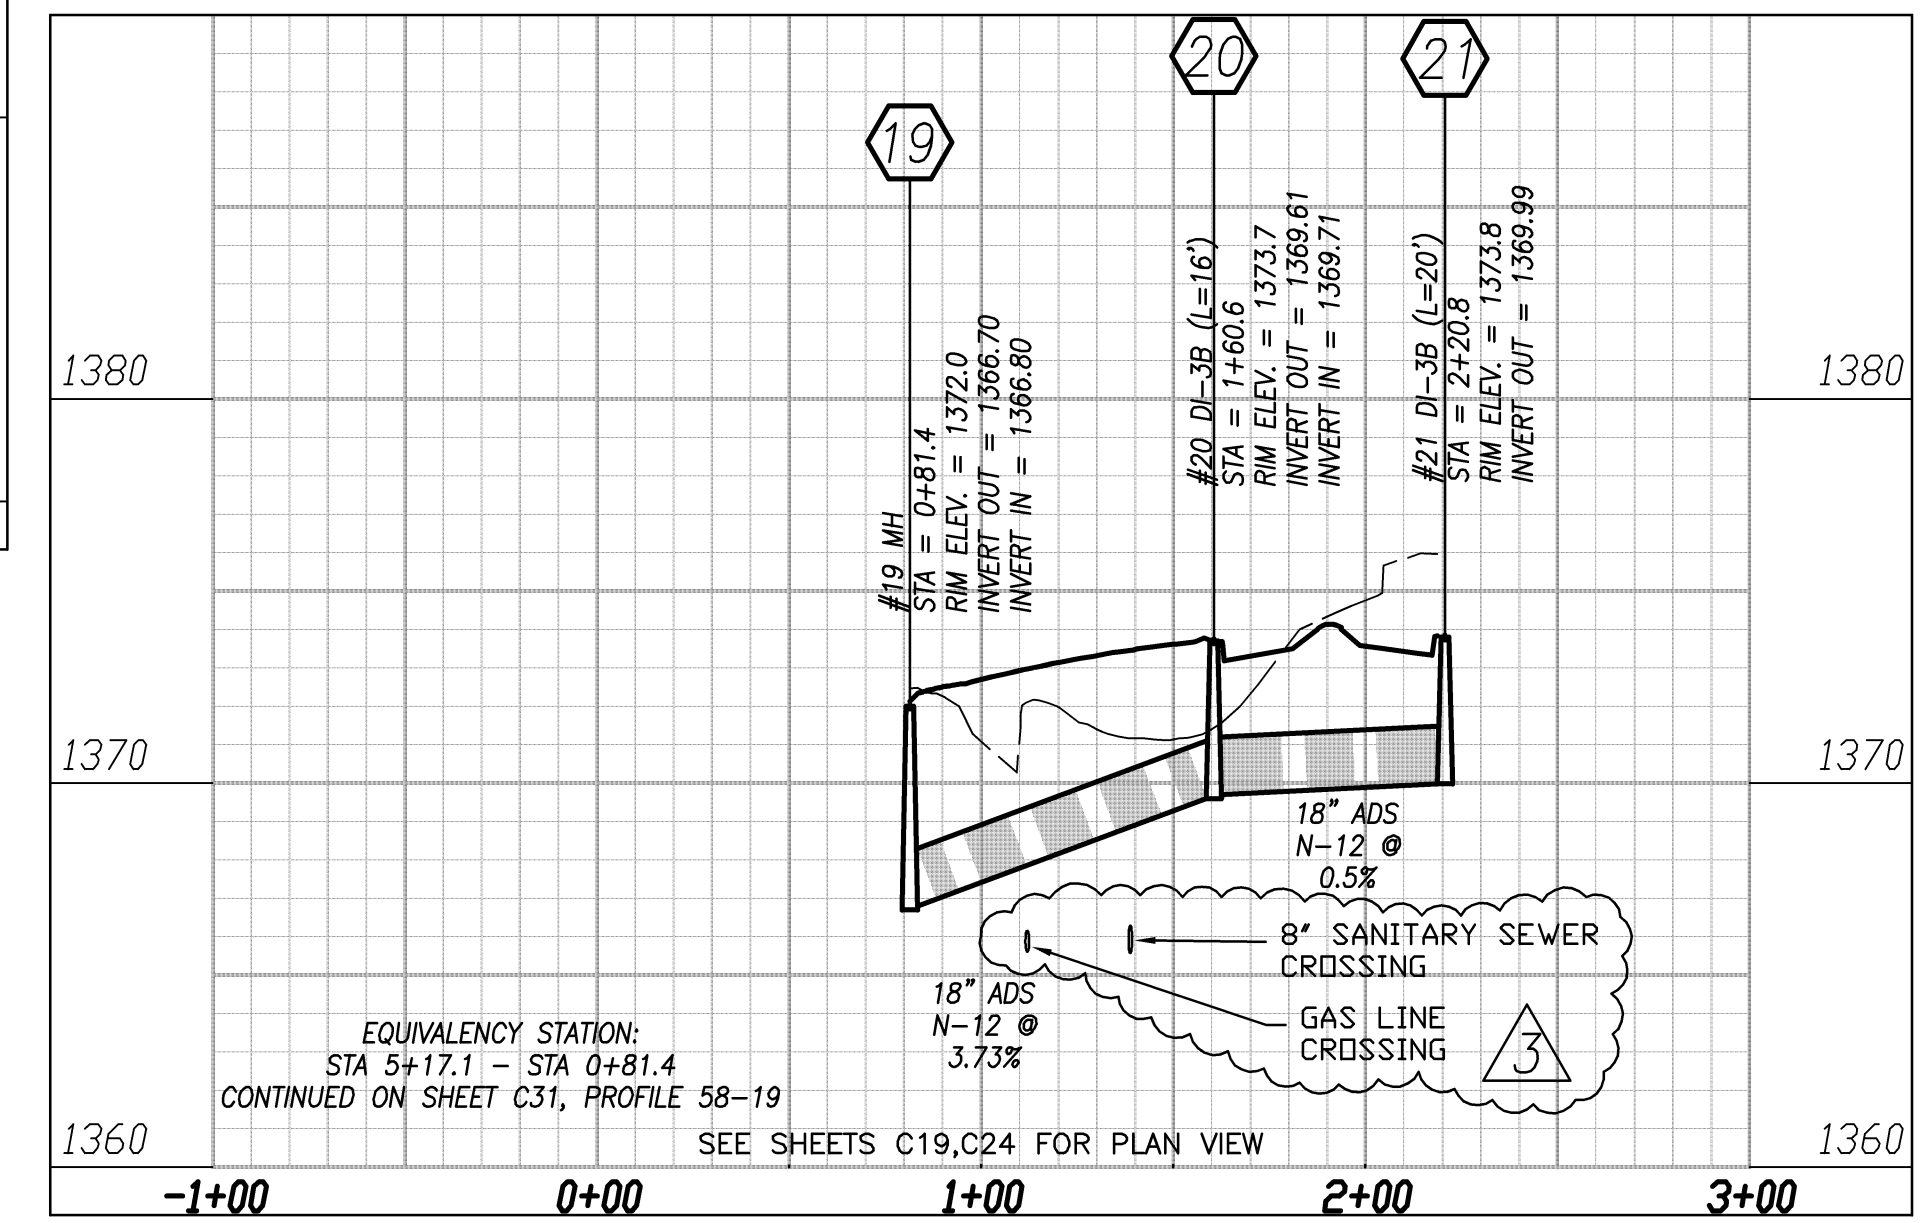


SEE SHEETS C19,C24 FOR PLAN VIEW

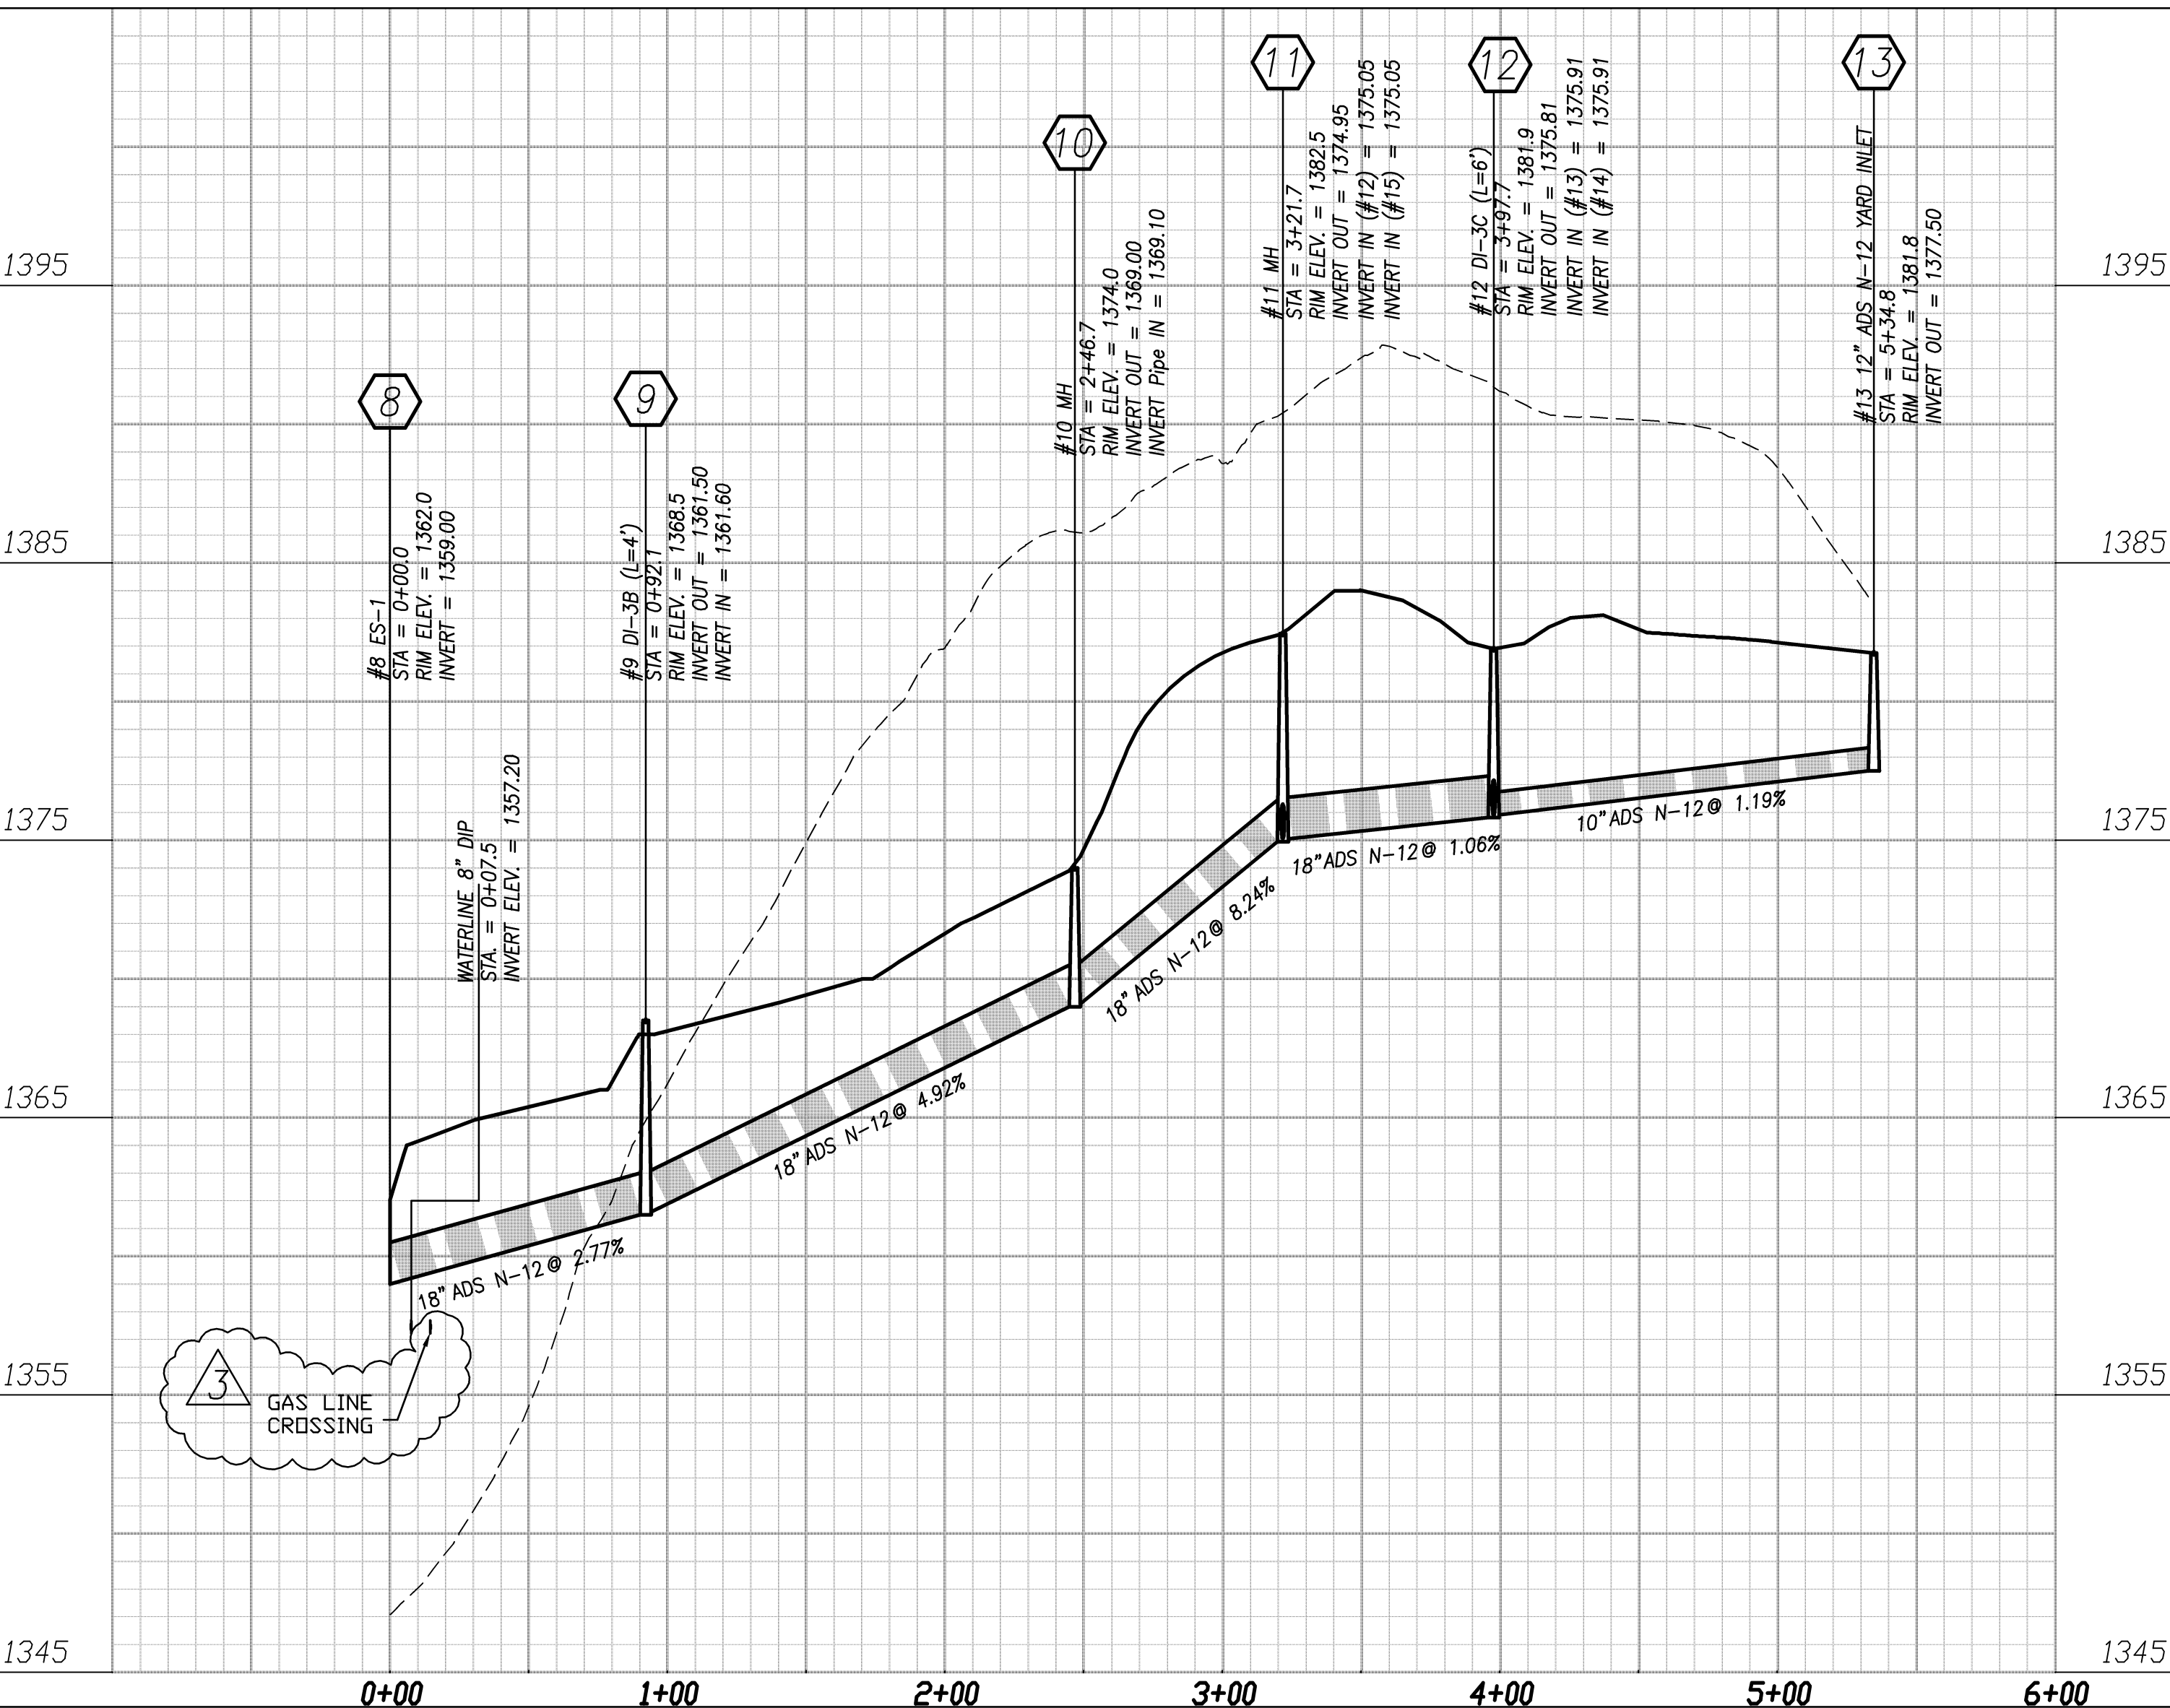


SEE SHEETS C18,C17 AND C23,C22 FOR PLAN VIEW

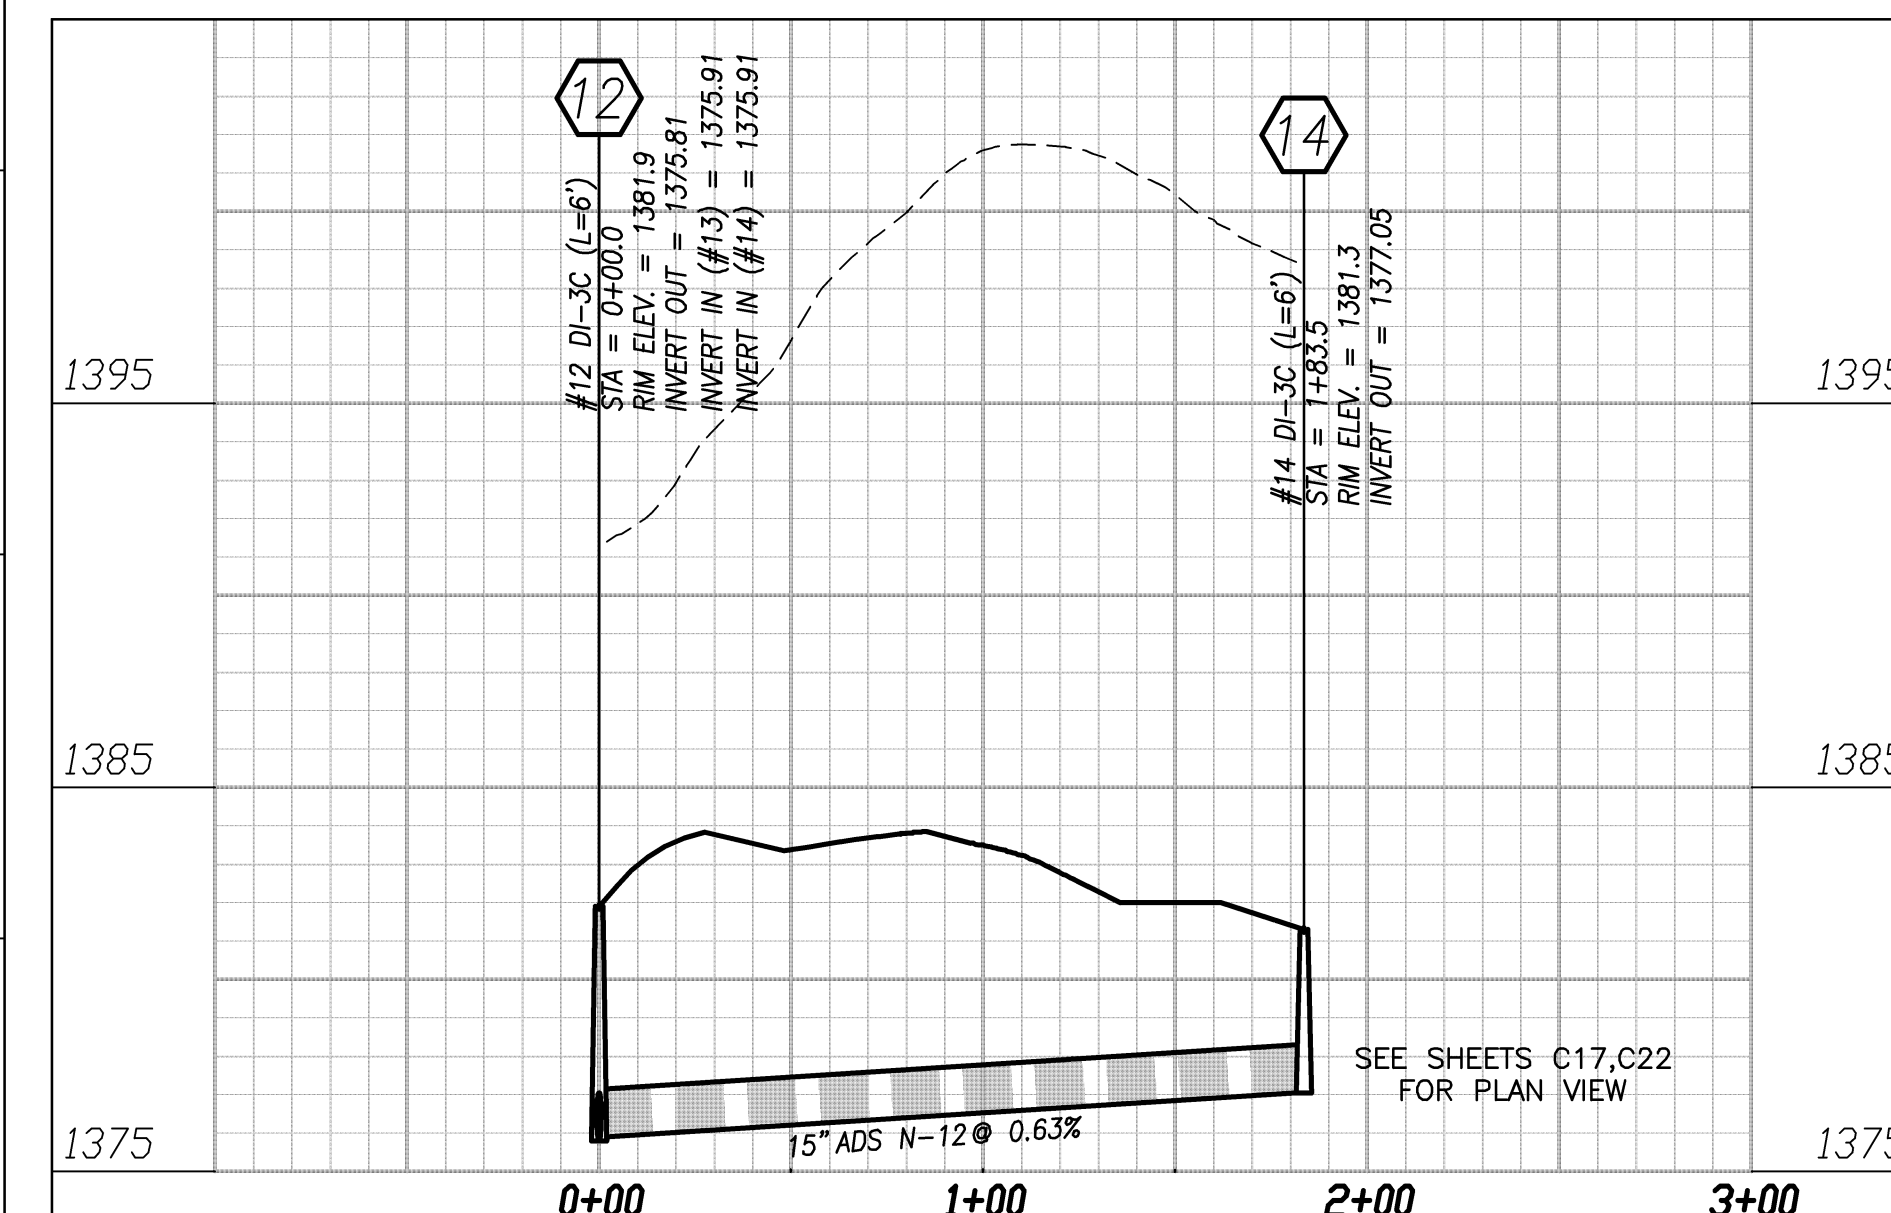

SEE SHEETS C17,C22 FOR PLAN VIEW


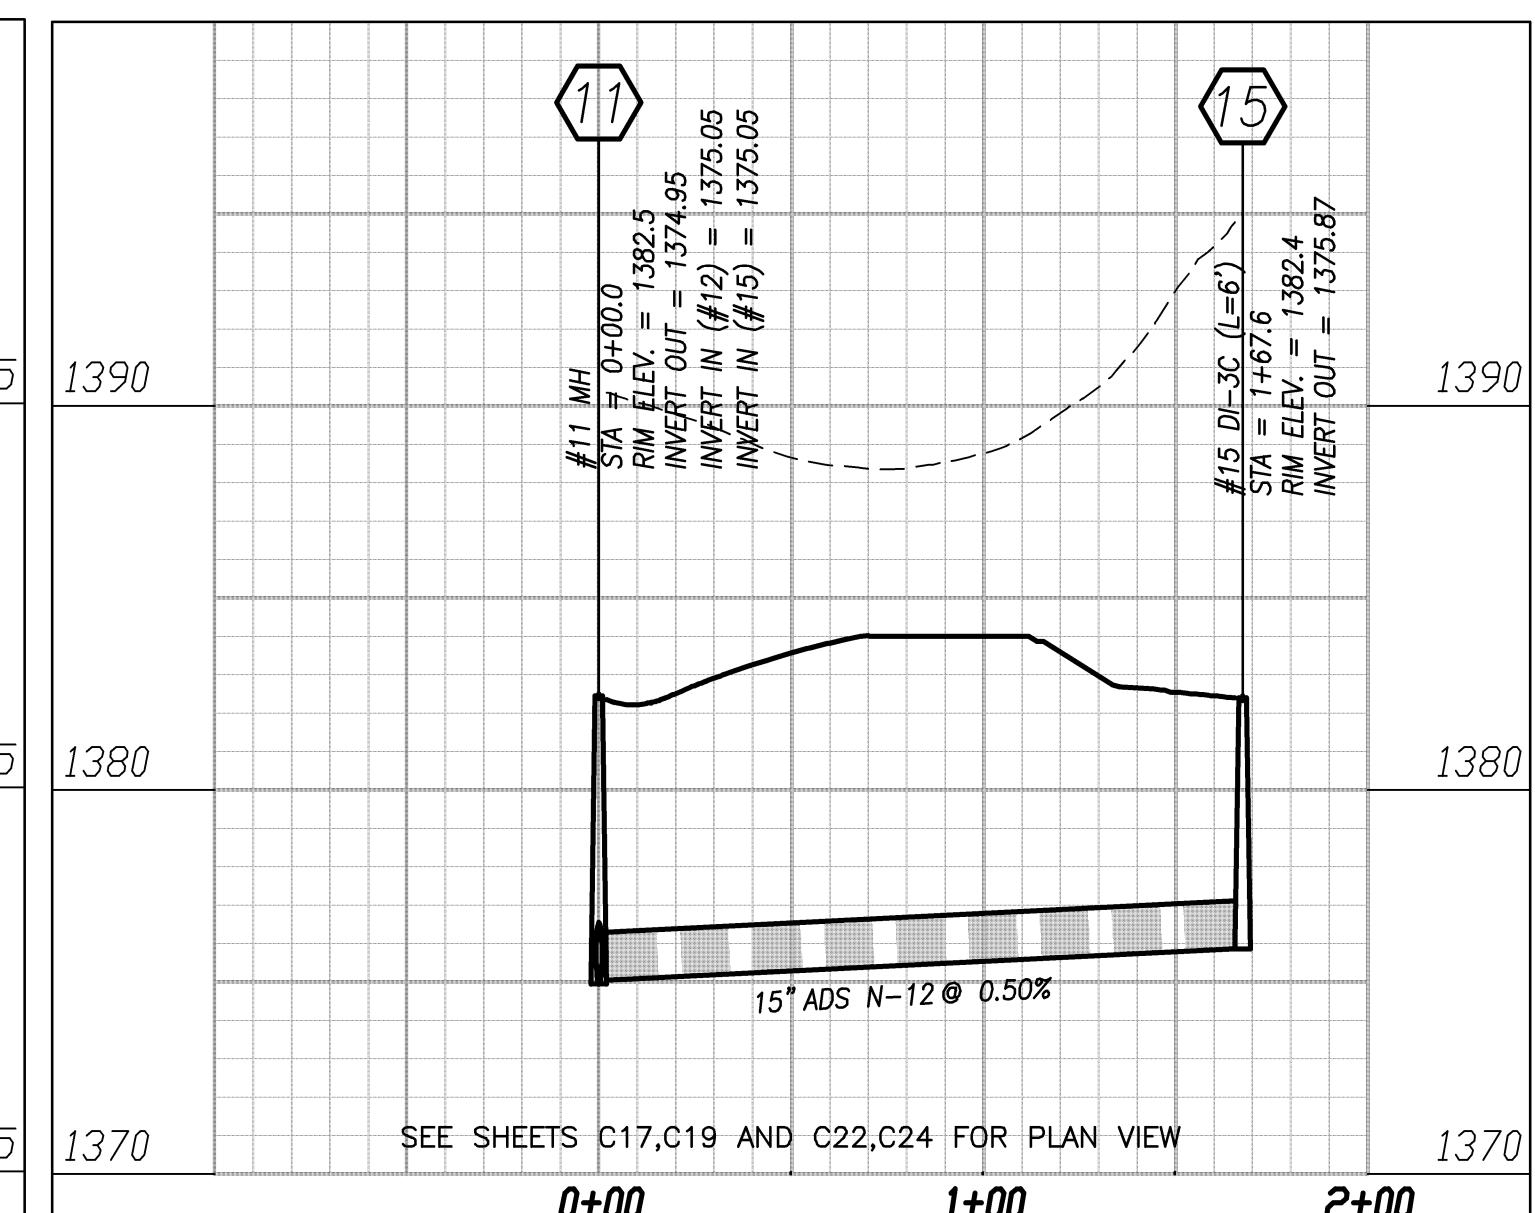


SEE SHEETS C17,C19 AND C22,C24 FOR PLAN VIEW

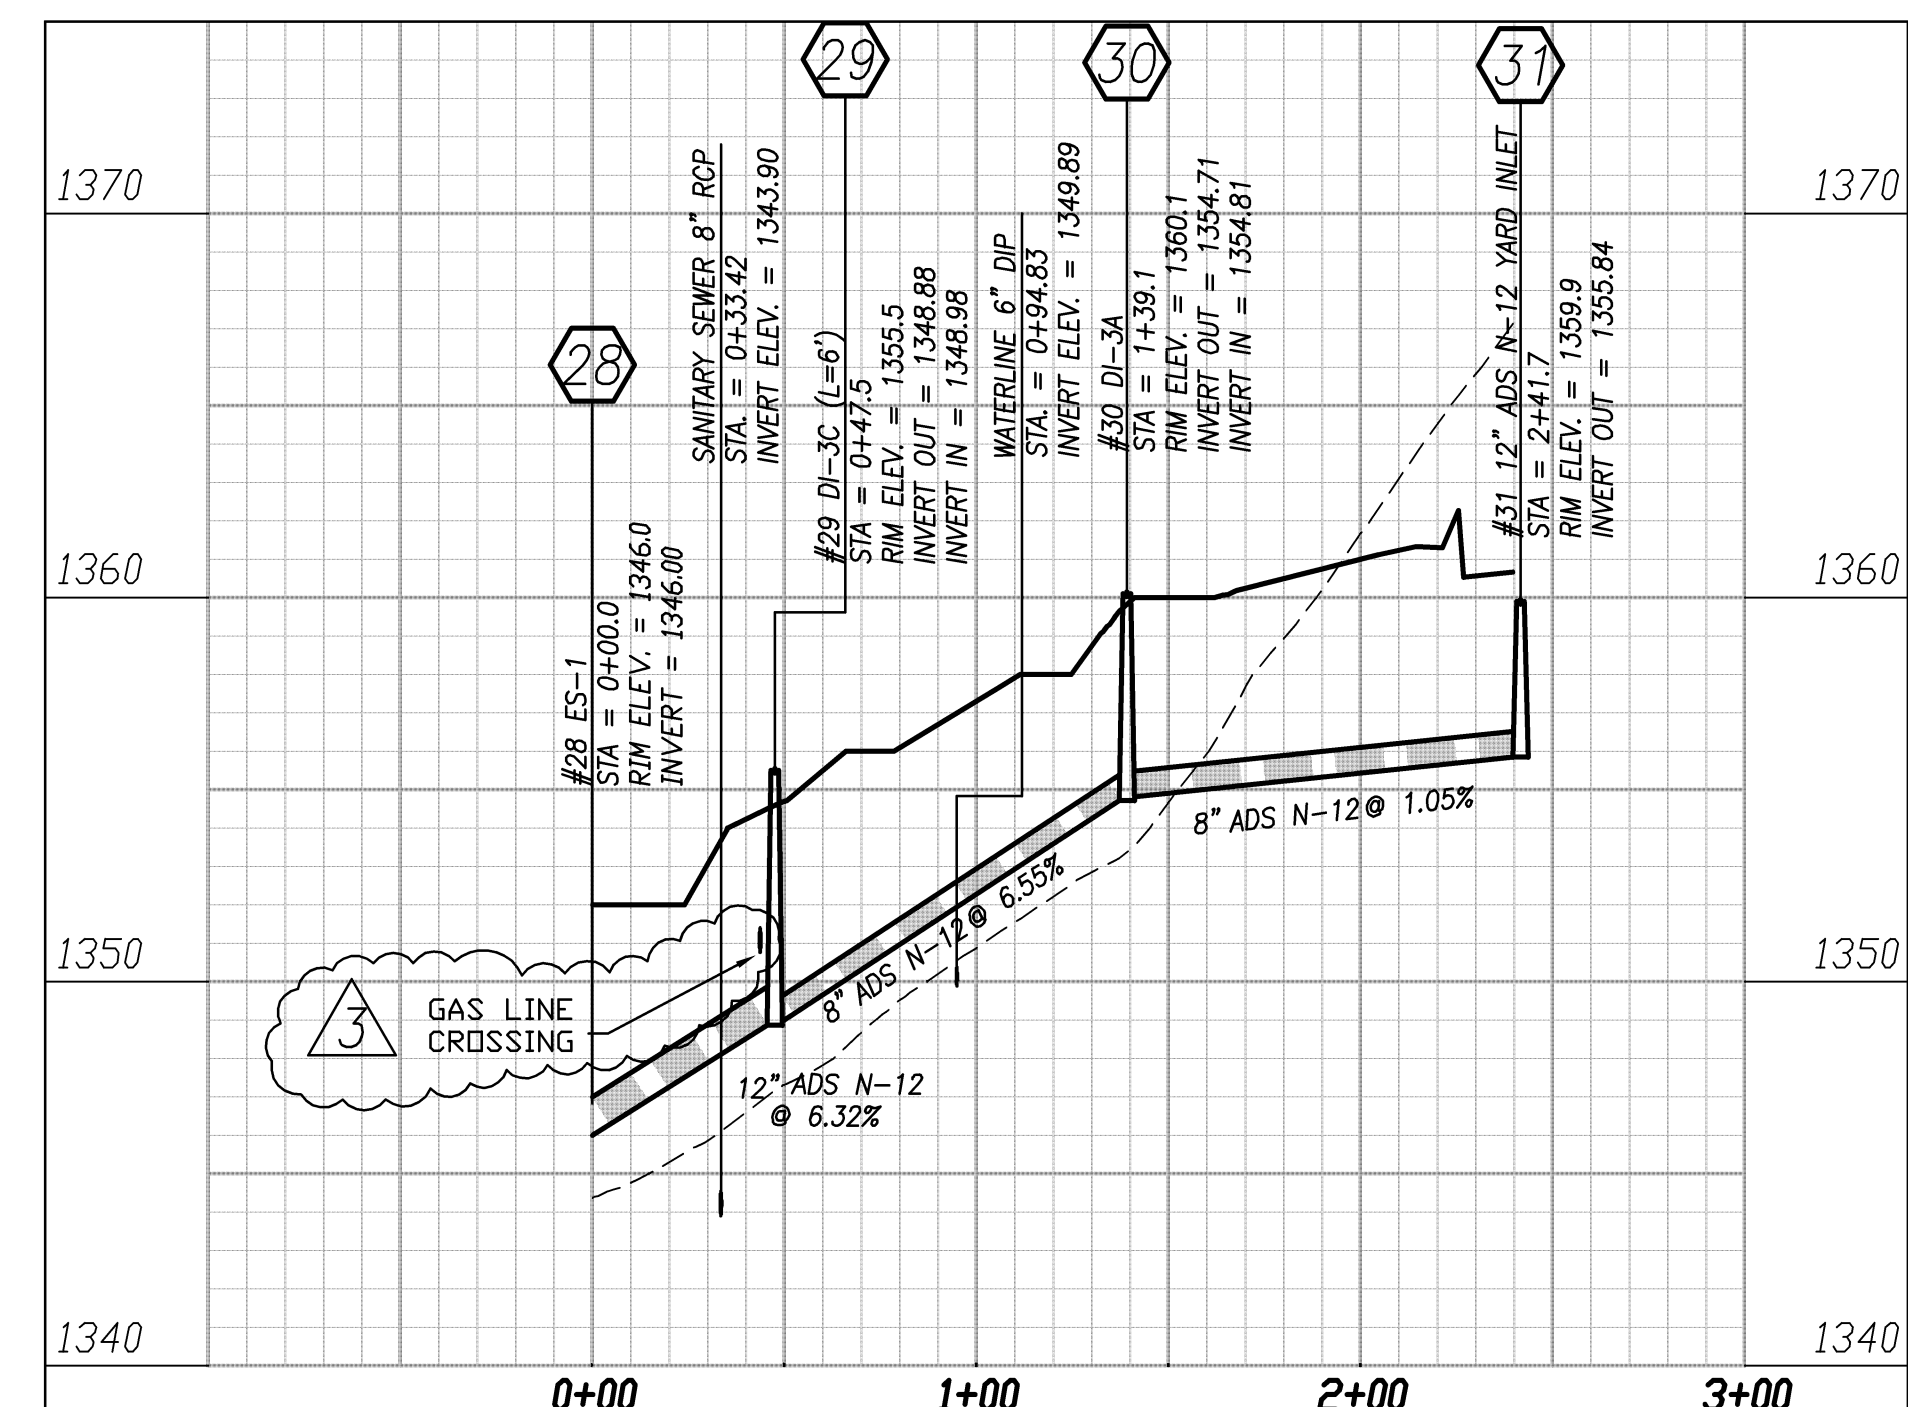


SEE SHEETS C17,C22 FOR PLAN VIEW

SLOPE CALCULATION NOTE:
ALL PIPE SLOPES ARE CALCULATED FROM INSIDE FACE OF MANHOLE TO INSIDE FACE OF MANHOLE.

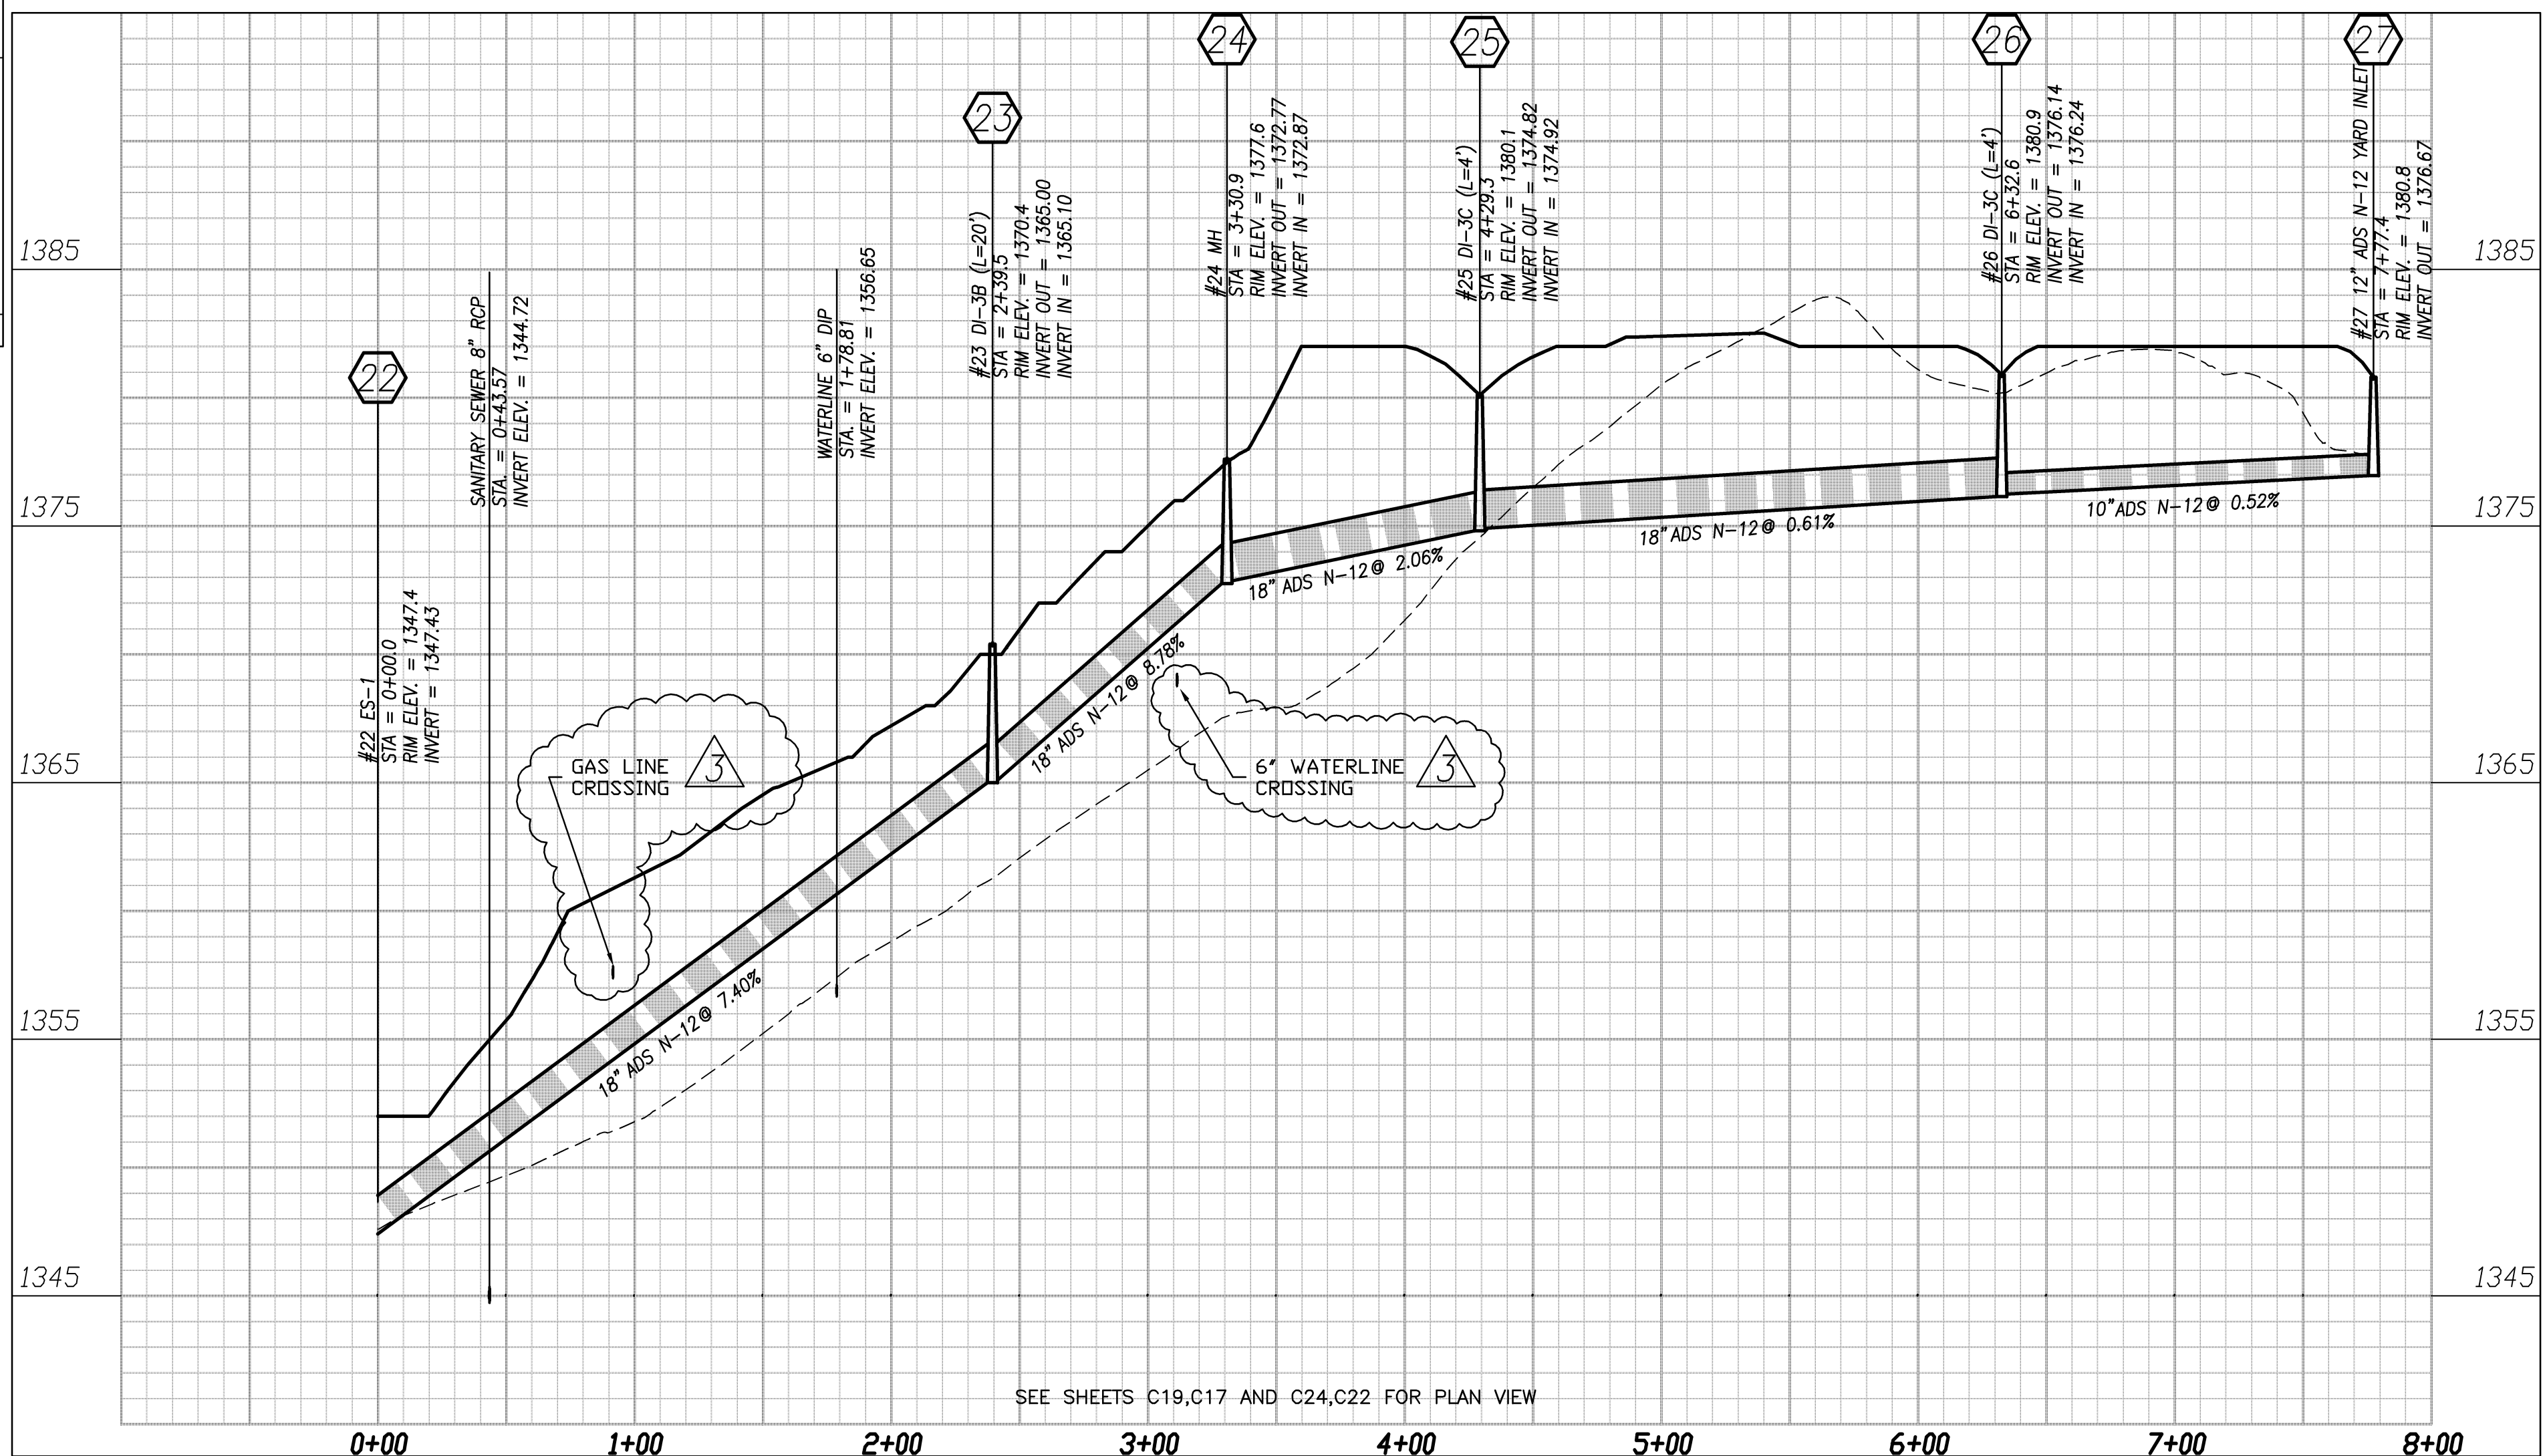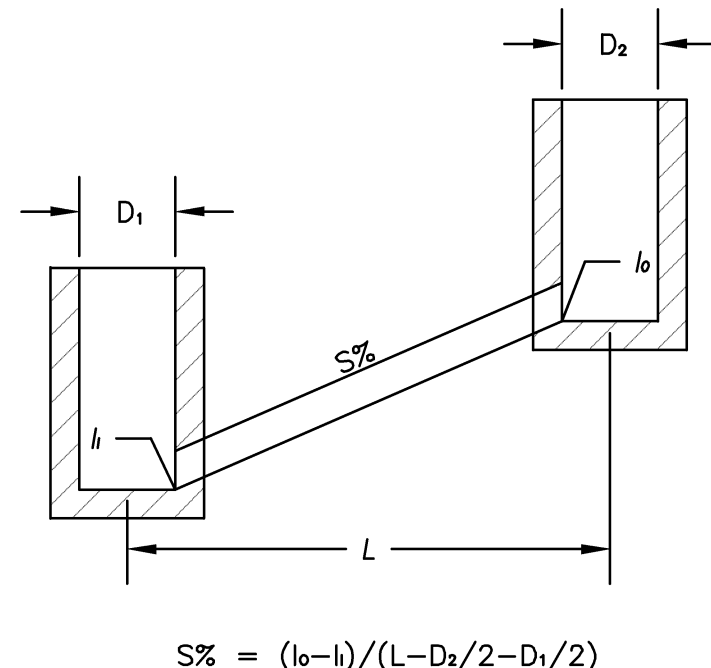


SEE SHEETS C19,C17 AND C24,C22 FOR PLAN VIEW

KEYPLAN

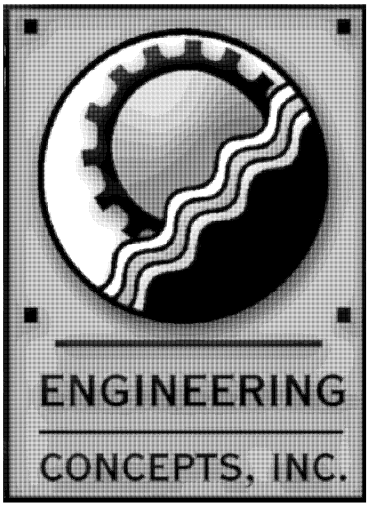

20 South Roanoke St.
Fincastle, Virginia 24090 540.473.1253
540.473.1254 (fax)
email@engineeringconcepts.com
ECI PROJECT #02019

GENERAL NOTES

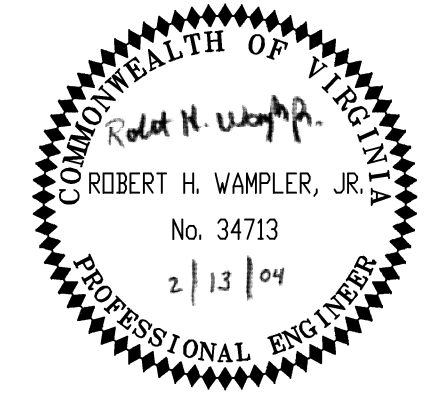

SCALE:
1" = 50' HOR.
1" = 5' VERT.

PROJECT TITLE

The Glebe

SFCS

SFCS Inc. • 305 South Jefferson Street
Roanoke, Virginia 24011.2003
540.344.6664 • Fax 540.343.6925
www.sfcs.com

PROJECT DESIGNER	: SFCS	
PROJECT ARCHITECT	: SFCS	
PROJECT ENGINEER	: ECI	
DRAWN BY	: ECI	
CHECKED BY	: ECI	
APPROVED BY	: ECI	
NO.	REVISION DESCRIPTION	DATE


2	SANITARY SEWER REVISIONS	8/06/03
3	REVISION PER BOT CO	11/12/03
5	MEP COURTYARD REVISION	2/11/04

DRAWING TITLE
STORM DRAIN PROFILES

COMM. NO.	DATE
47115.00	11/12/03
DRAWING	SHEET

C30

30 OF 43

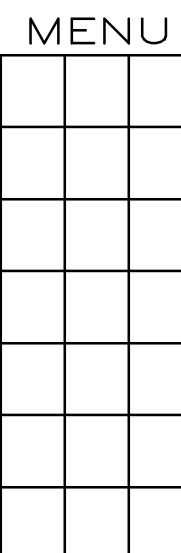

CADD VERSION
ACAD LT
PLOT SCALE
1:1
PLOT DATE
COMM. NO.
DRAWING NO.