

MENU










CADD VERSION
ACAD R14

PLOT SCALE
1/1

PLOT DATE

COMM. NO.

DRAWING NO.

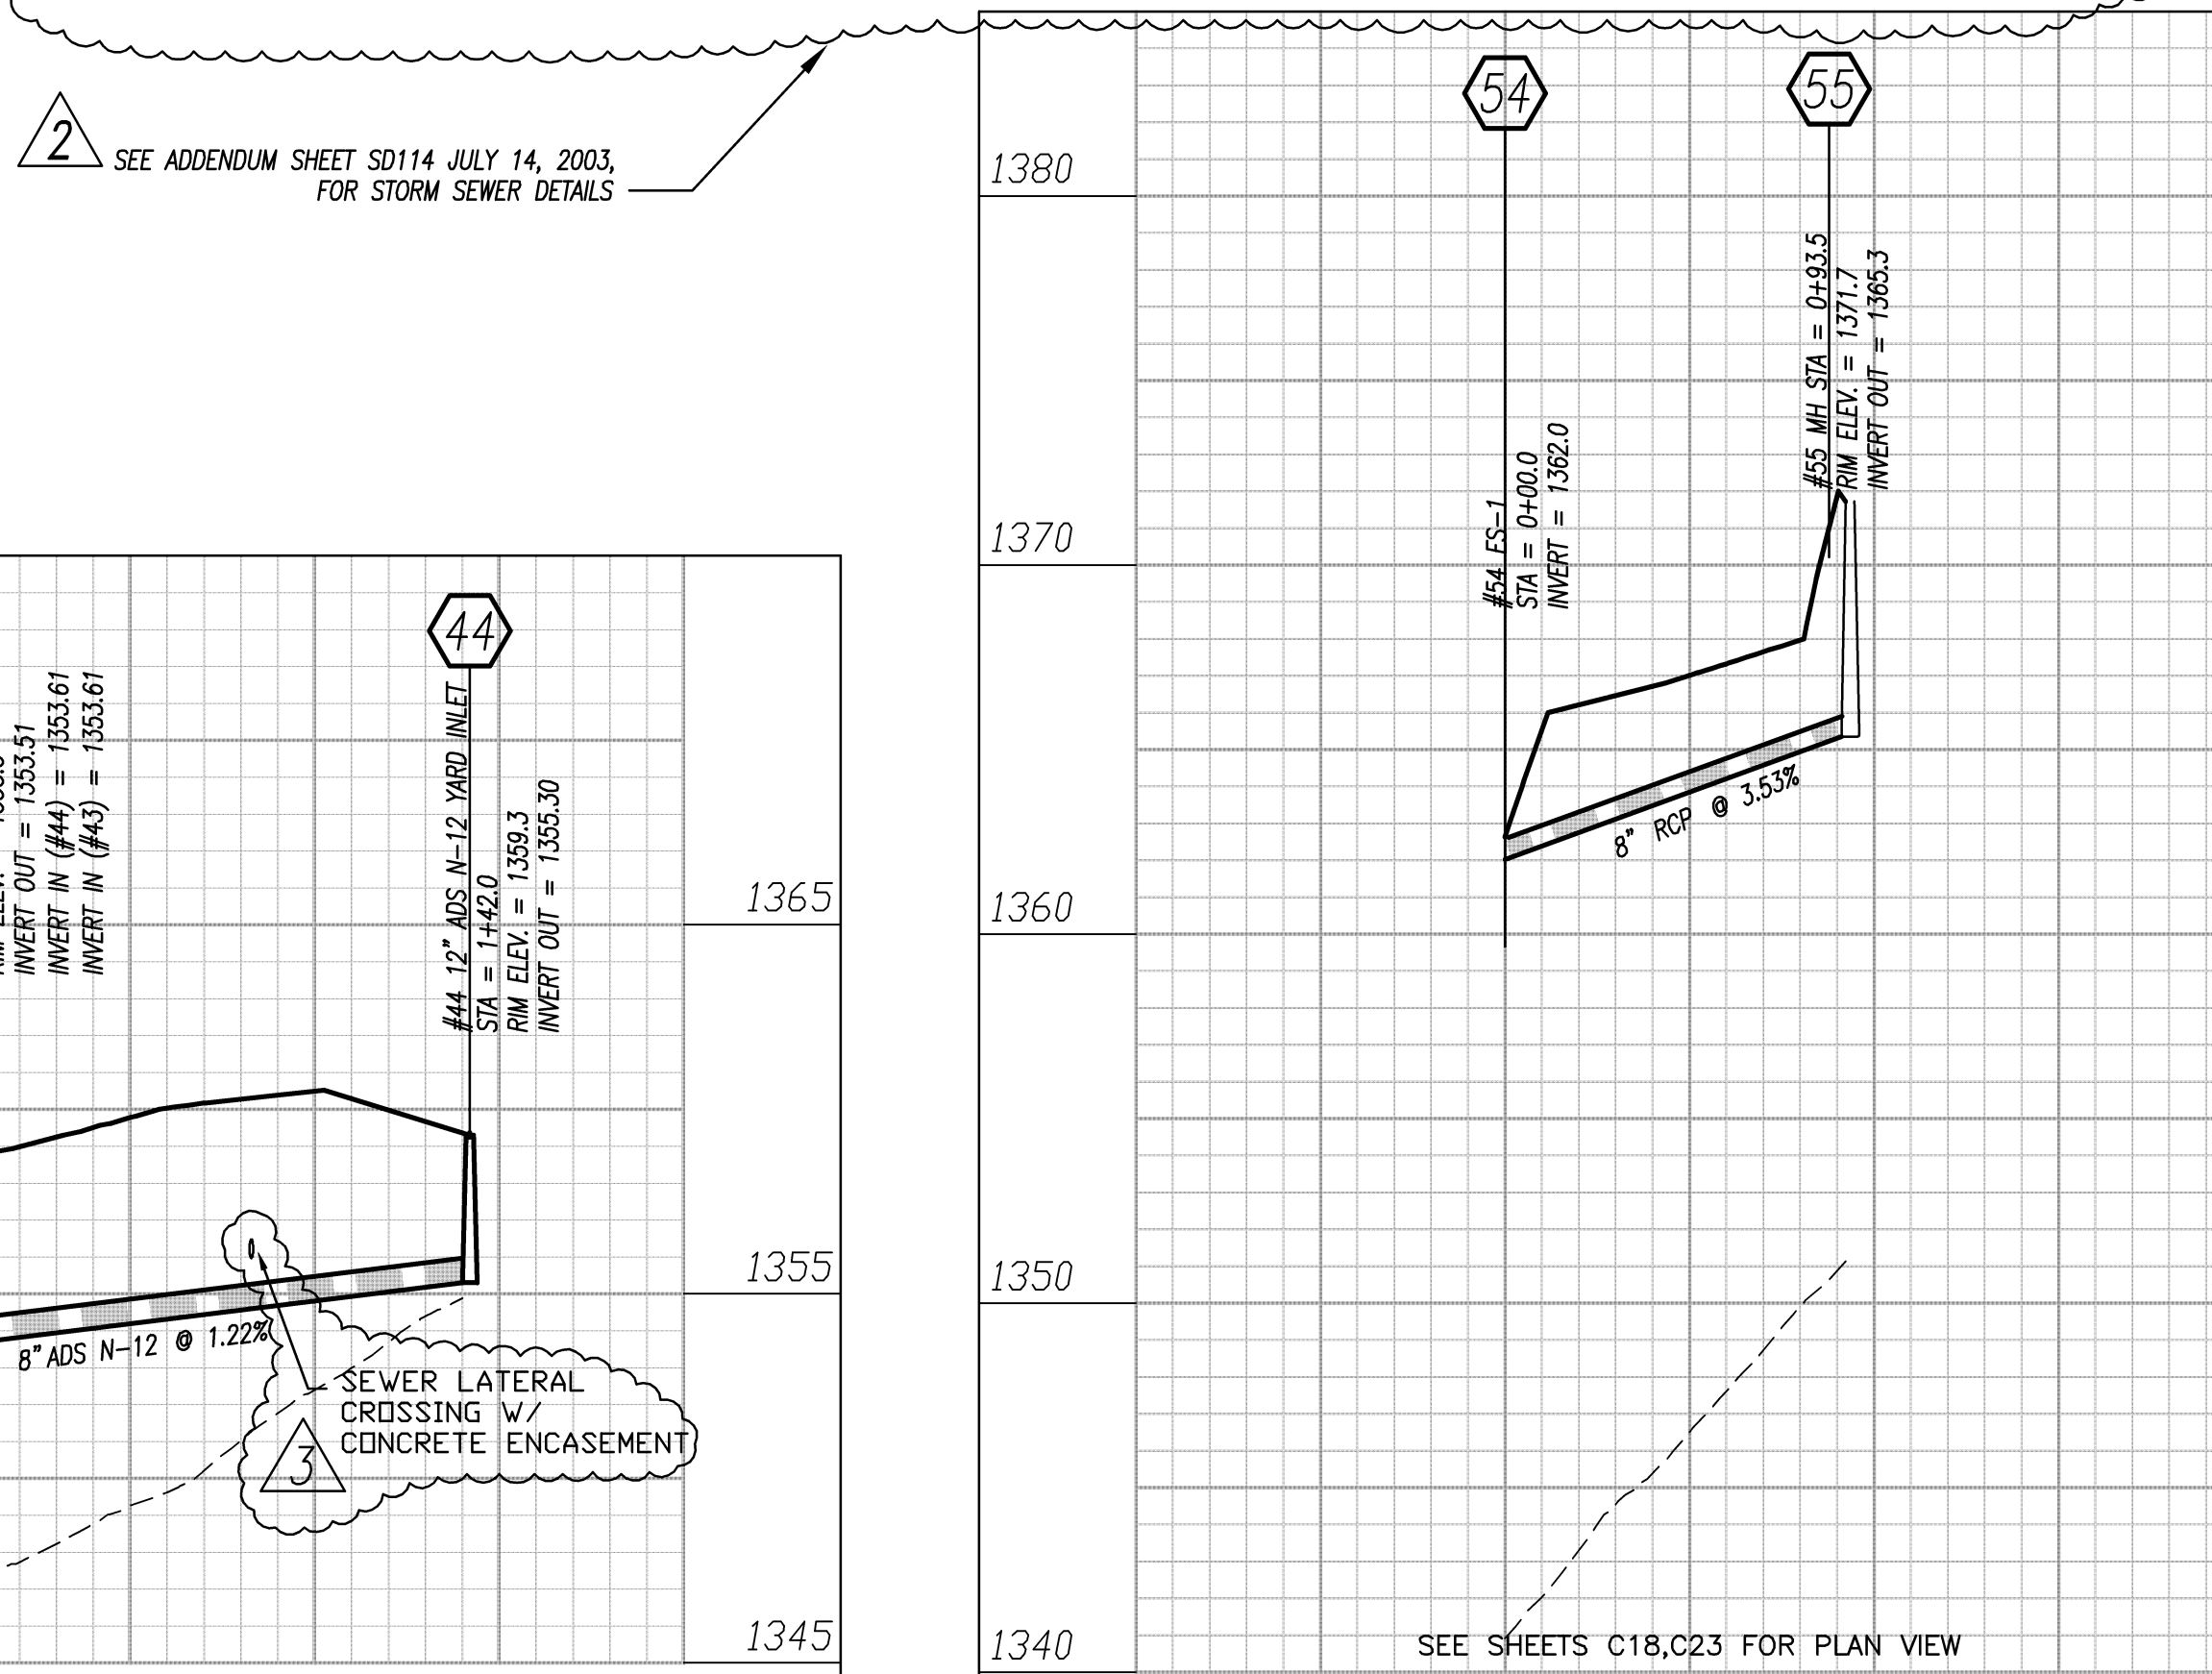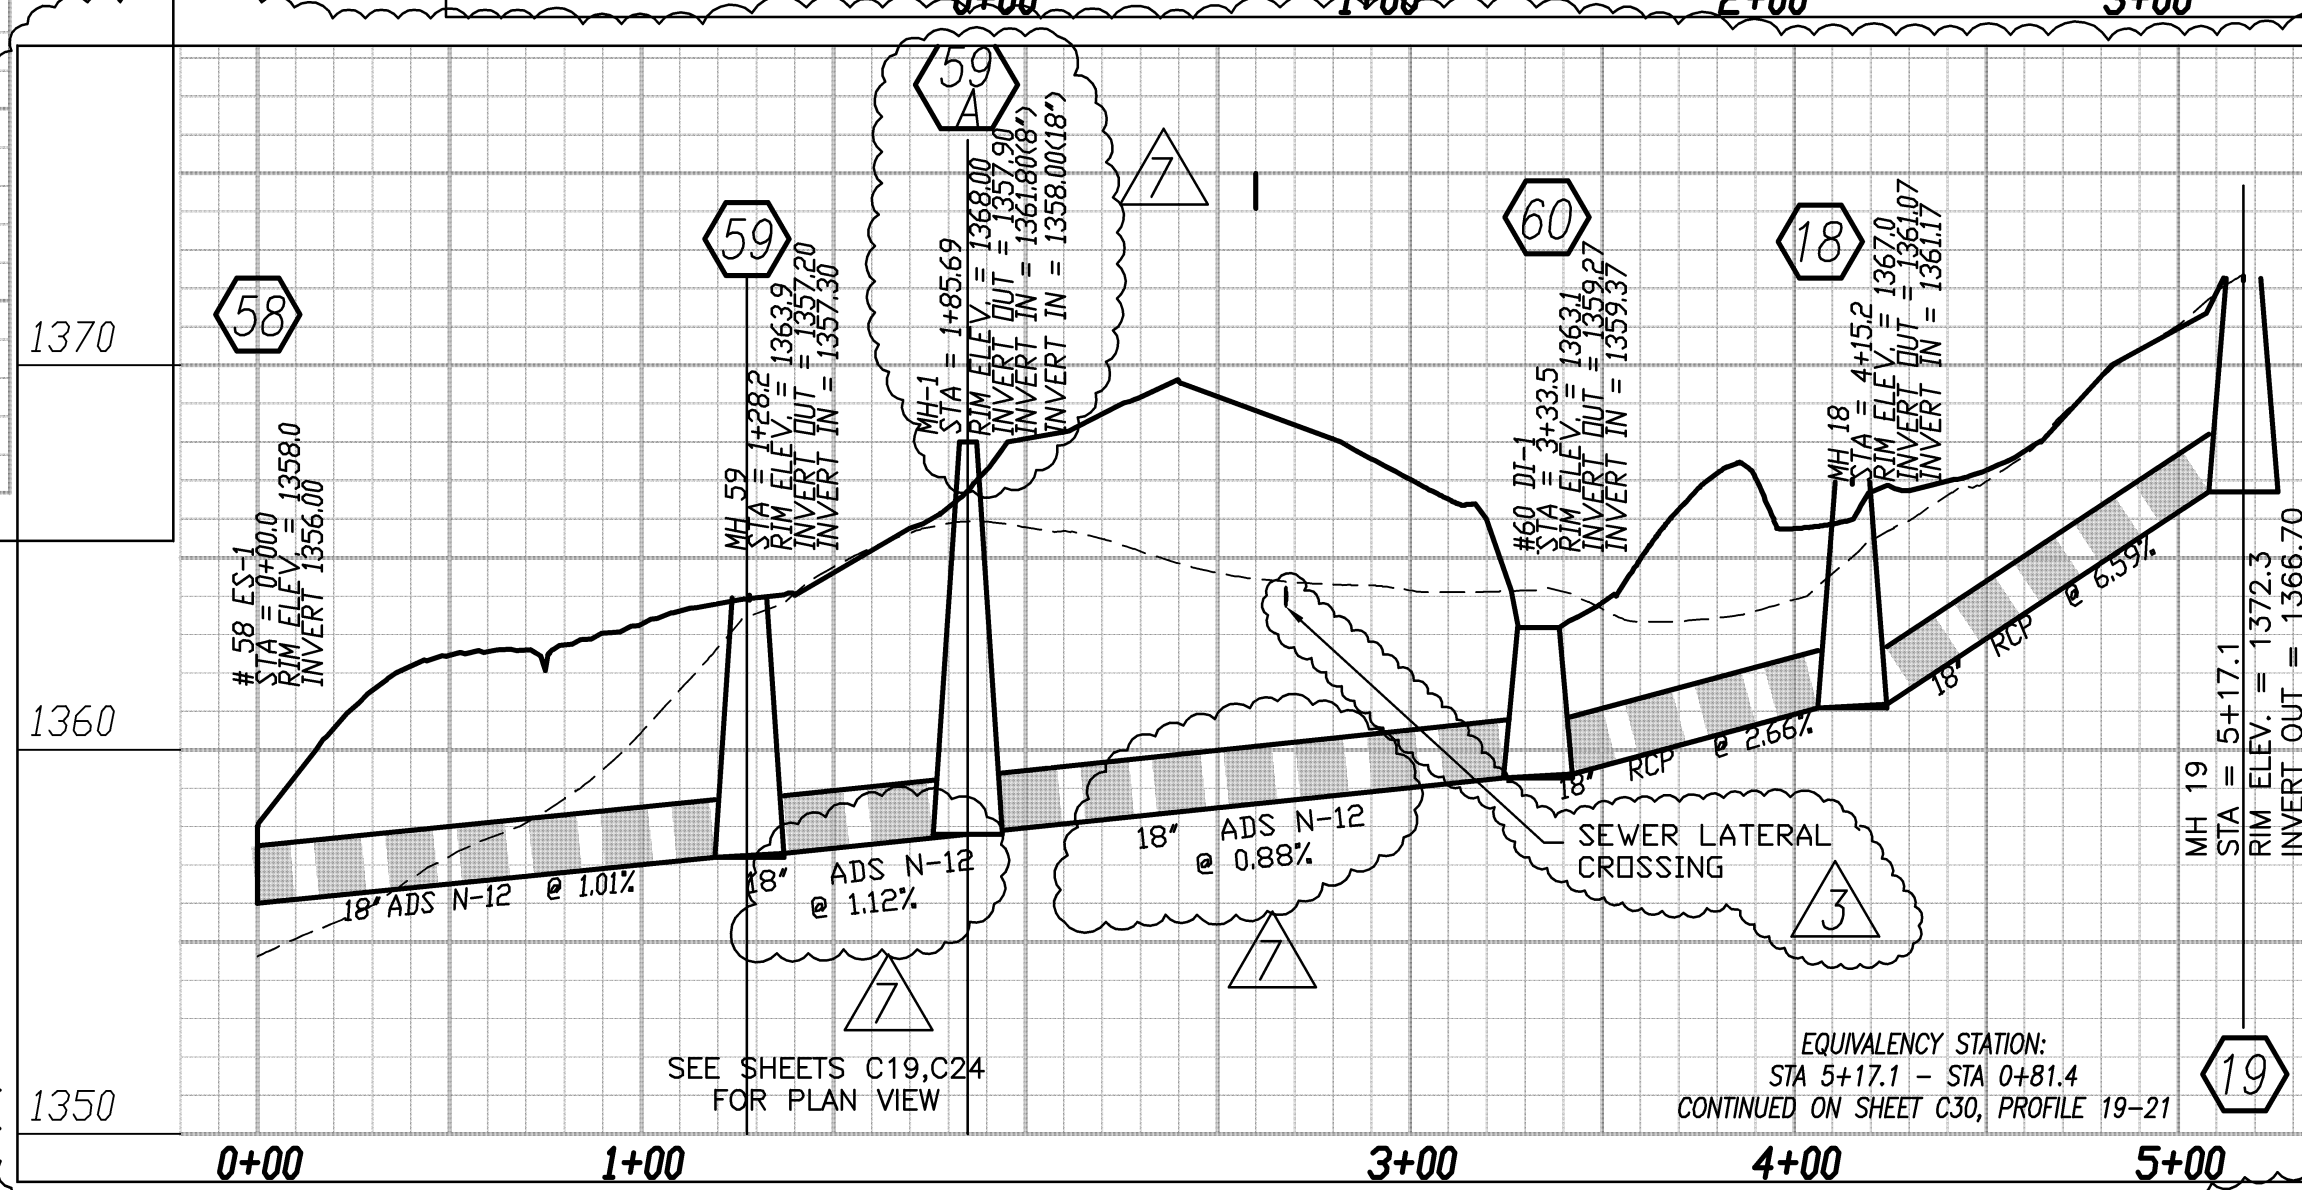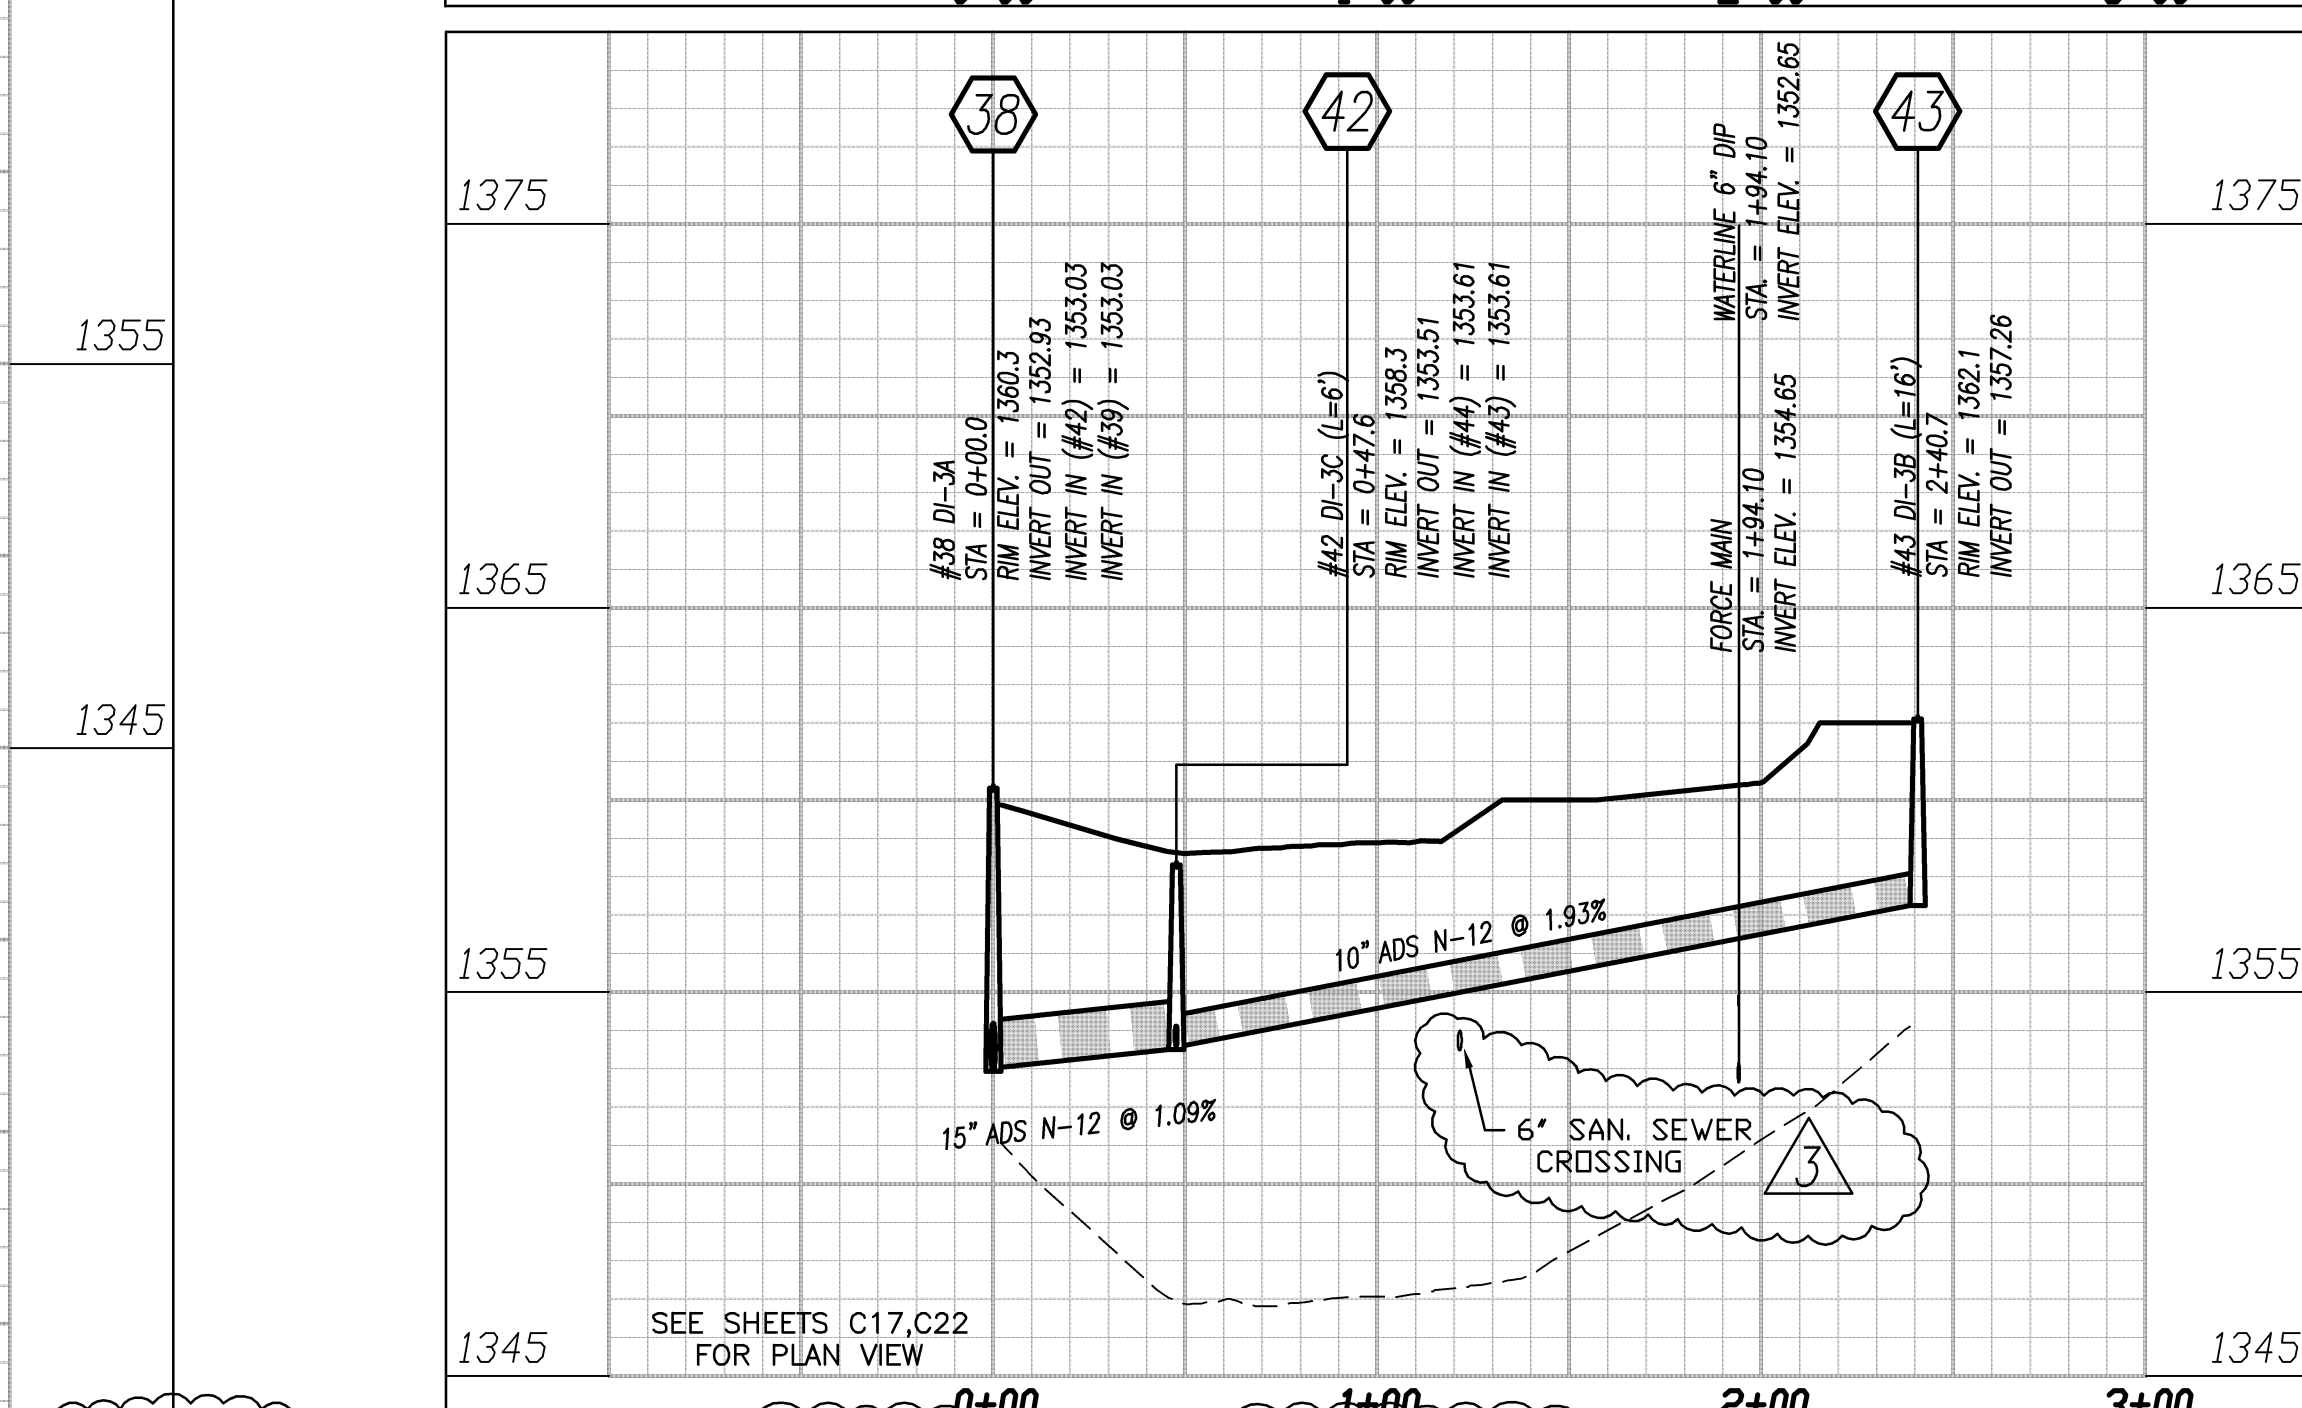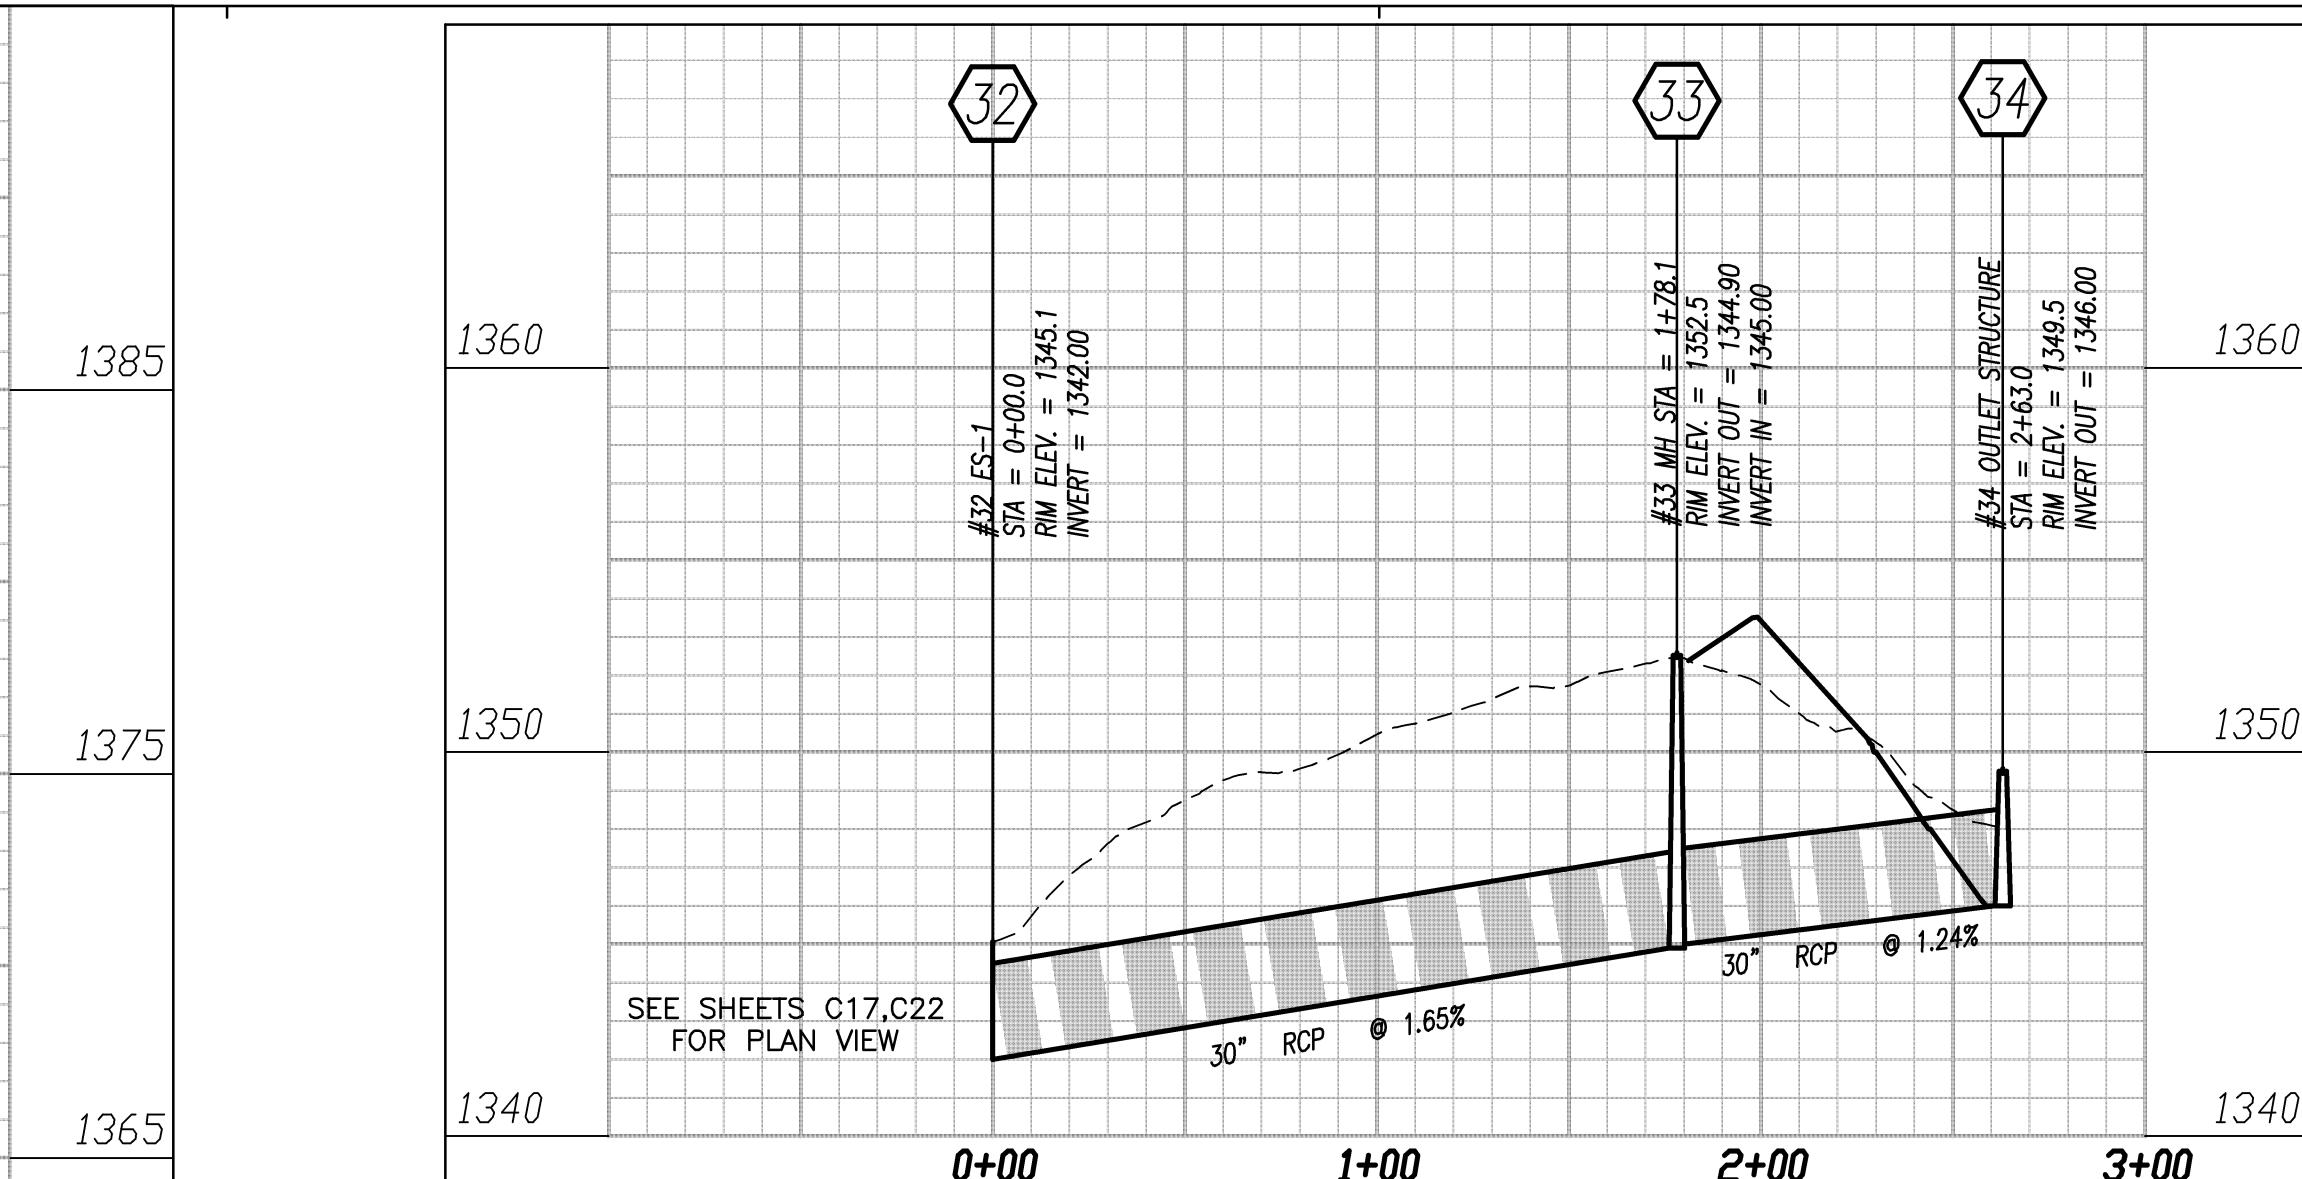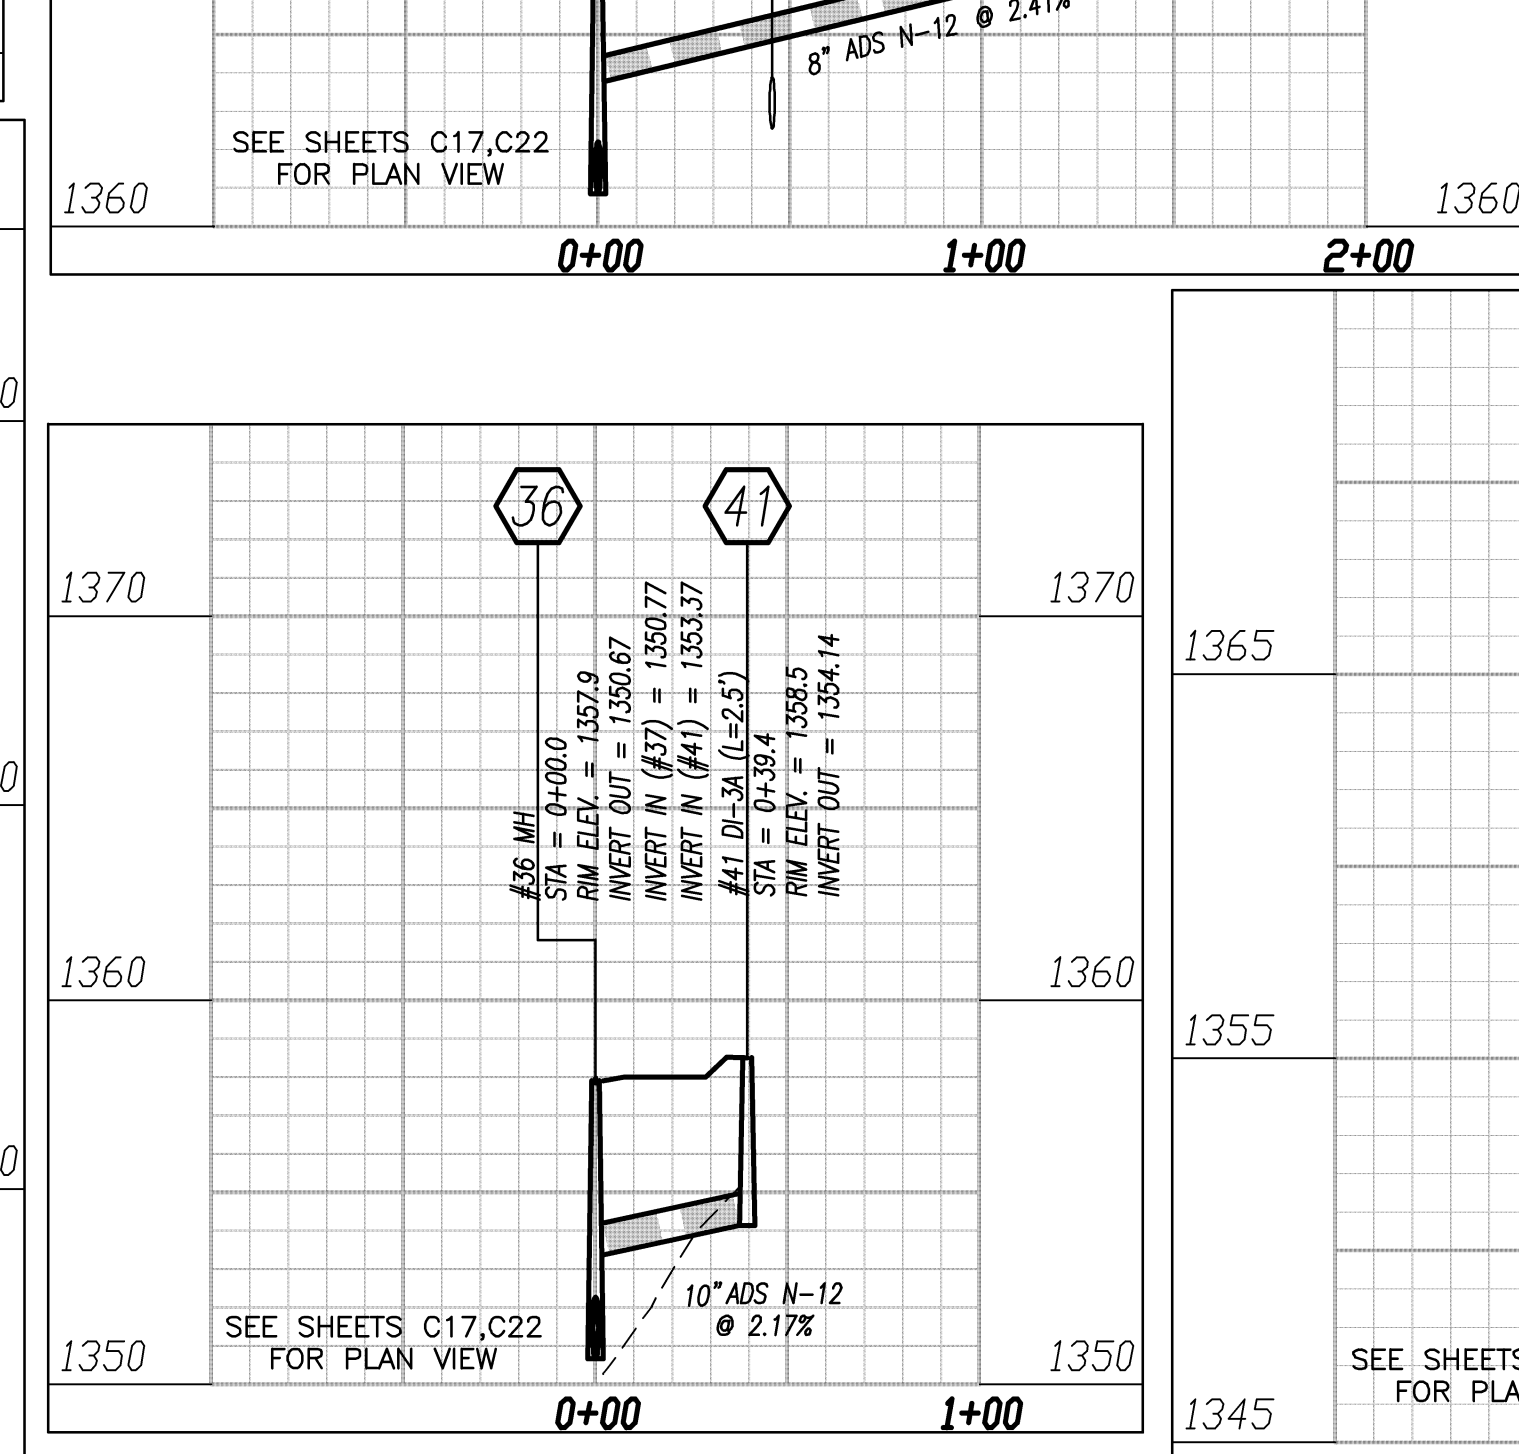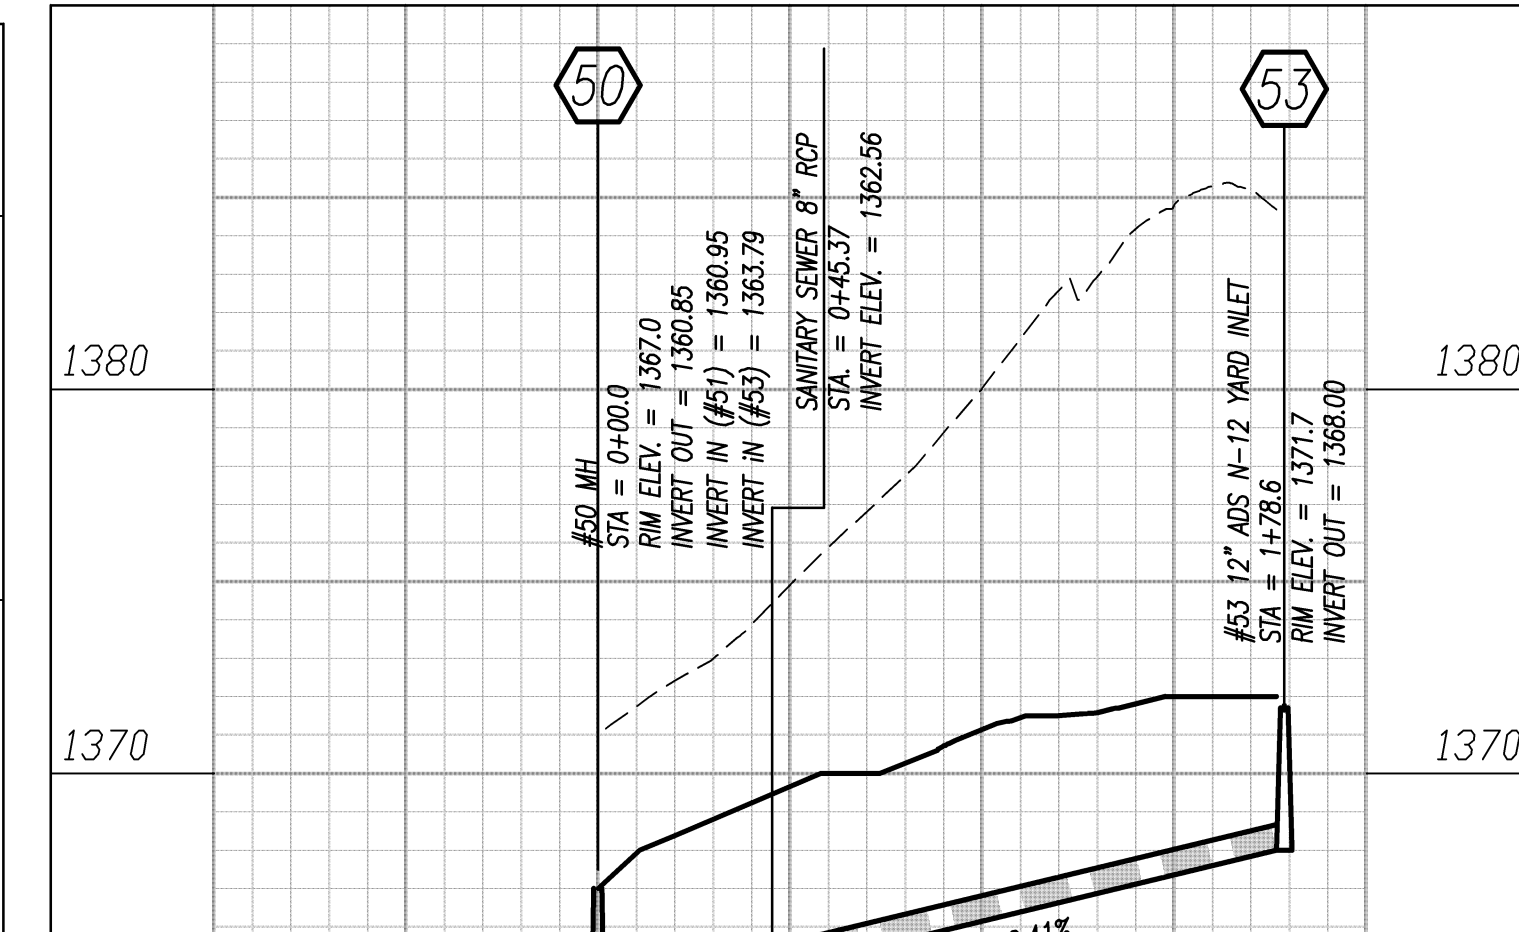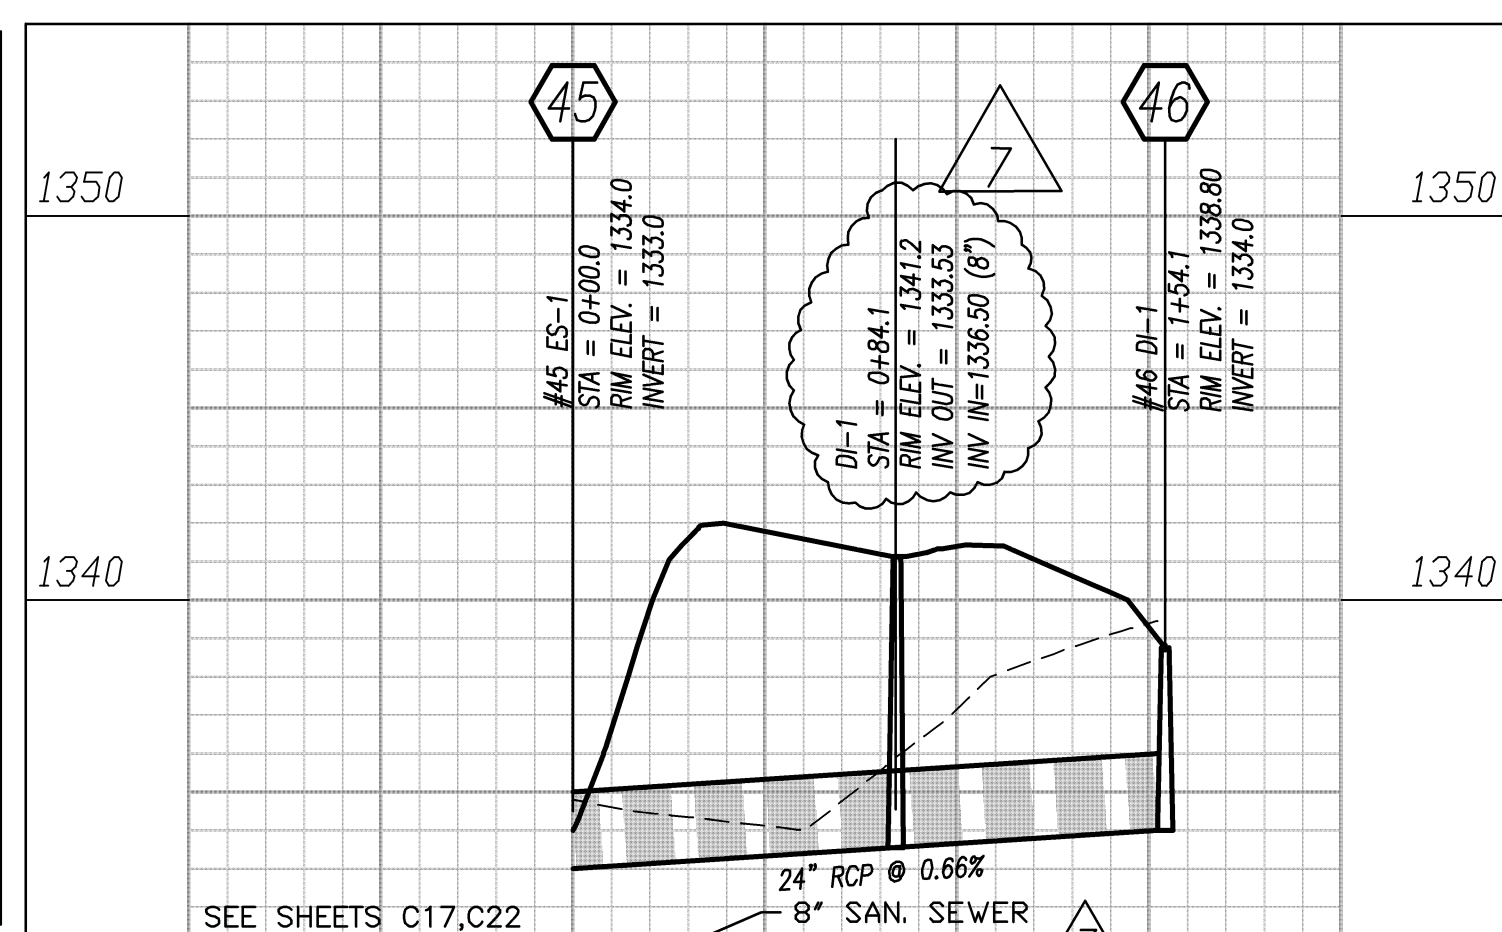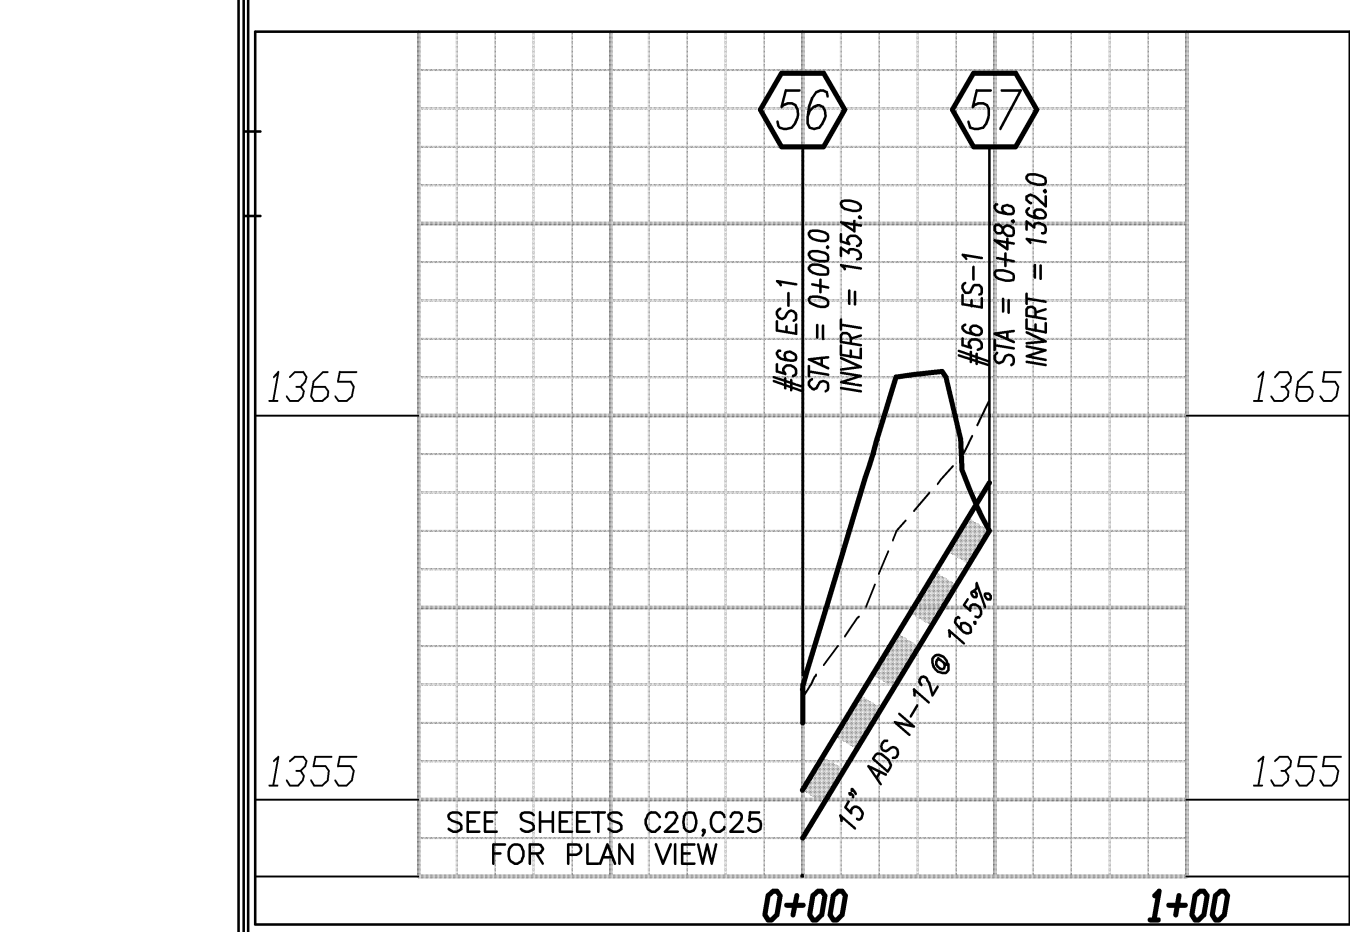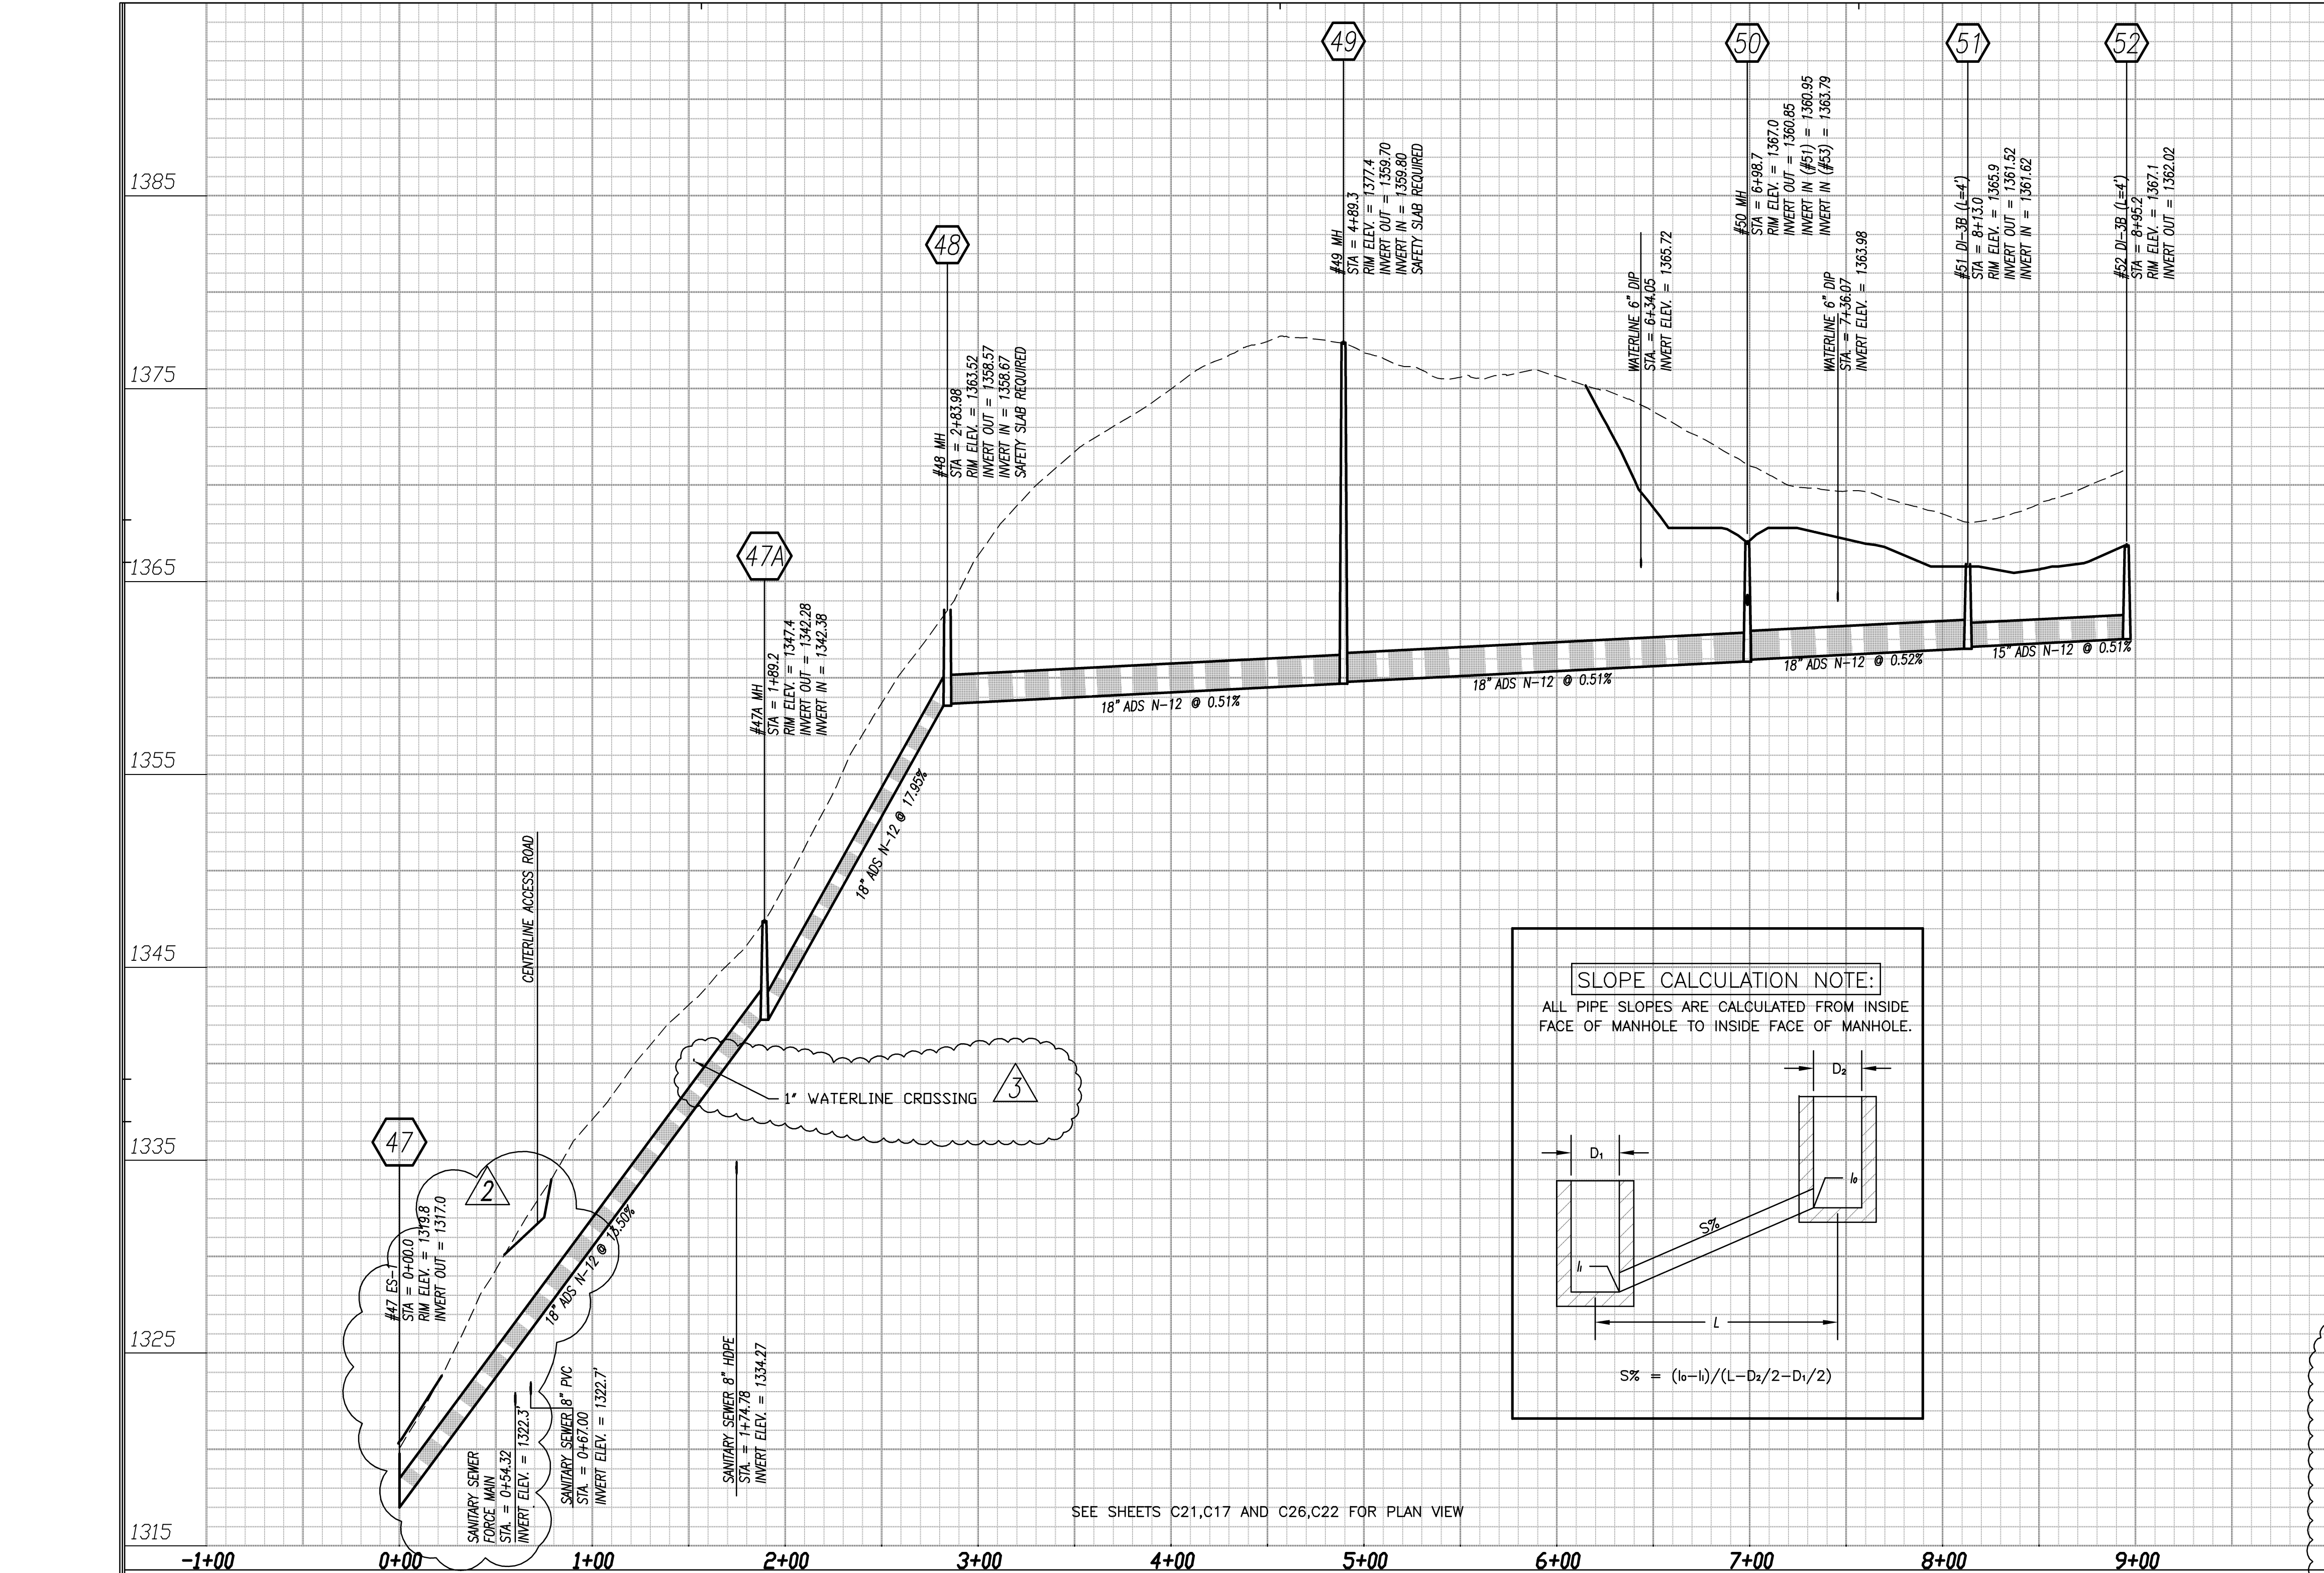

KEYPLAN

ENGINEERING CONCEPTS, INC.

30 South Roanoke St.
Fincastle, Virginia 24090 540.473.1253
540.473.1254 (fax)
email@engineeringconcepts.com
ECI PROJECT #02019

GENERAL NOTES

COMM. OF VA
ROBERT H. WAMPLER, JR.
No. 34713
8/11/04
PROFESSIONAL ENGINEER

SCALE:
1" = 50' HOR.
1" = 5' VERT.

PROJECT TITLE

The Glebe

SFCS

SFCS Inc. • 305 South Jefferson Street
Roanoke, Virginia 24011.2003
540.344.6664 • Fax 540.343.6925
www.sfcs.com

Architecture
Engineering
Planning
Interiors

SFCS		Architecture Engineering Planning Interiors
SFCS Inc. • 305 South Jefferson Street Roanoke, Virginia 24011.2003 540.344.6664 • Fax 540.343.6925 www.sfcs.com		
PROJECT DESIGNER	: SFCS	
PROJECT ARCHITECT	: SFCS	
PROJECT ENGINEER	: ECI	
DRAWN BY	: ECI	
CHECKED BY	: ECI	
APPROVED BY	: ECI	
NO.	REVISION DESCRIPTION	DATE
1	VDOT,VOH,BOTETOURT COUNTY COMMENTS	
2	SANITARY SEWER REVISIONS	8/06/03
3	REVISIONS PER BOT CO	11/12/03
7	ADS REVISIONS	9/30/04
DRAWING TITLE		
STORM DRAIN PROFILES		
COMM. NO.	DATE	
47115.00	11/12/03	
DRAWING	SHEET	
C3		