

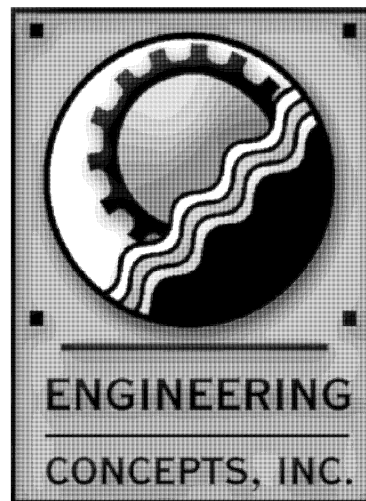
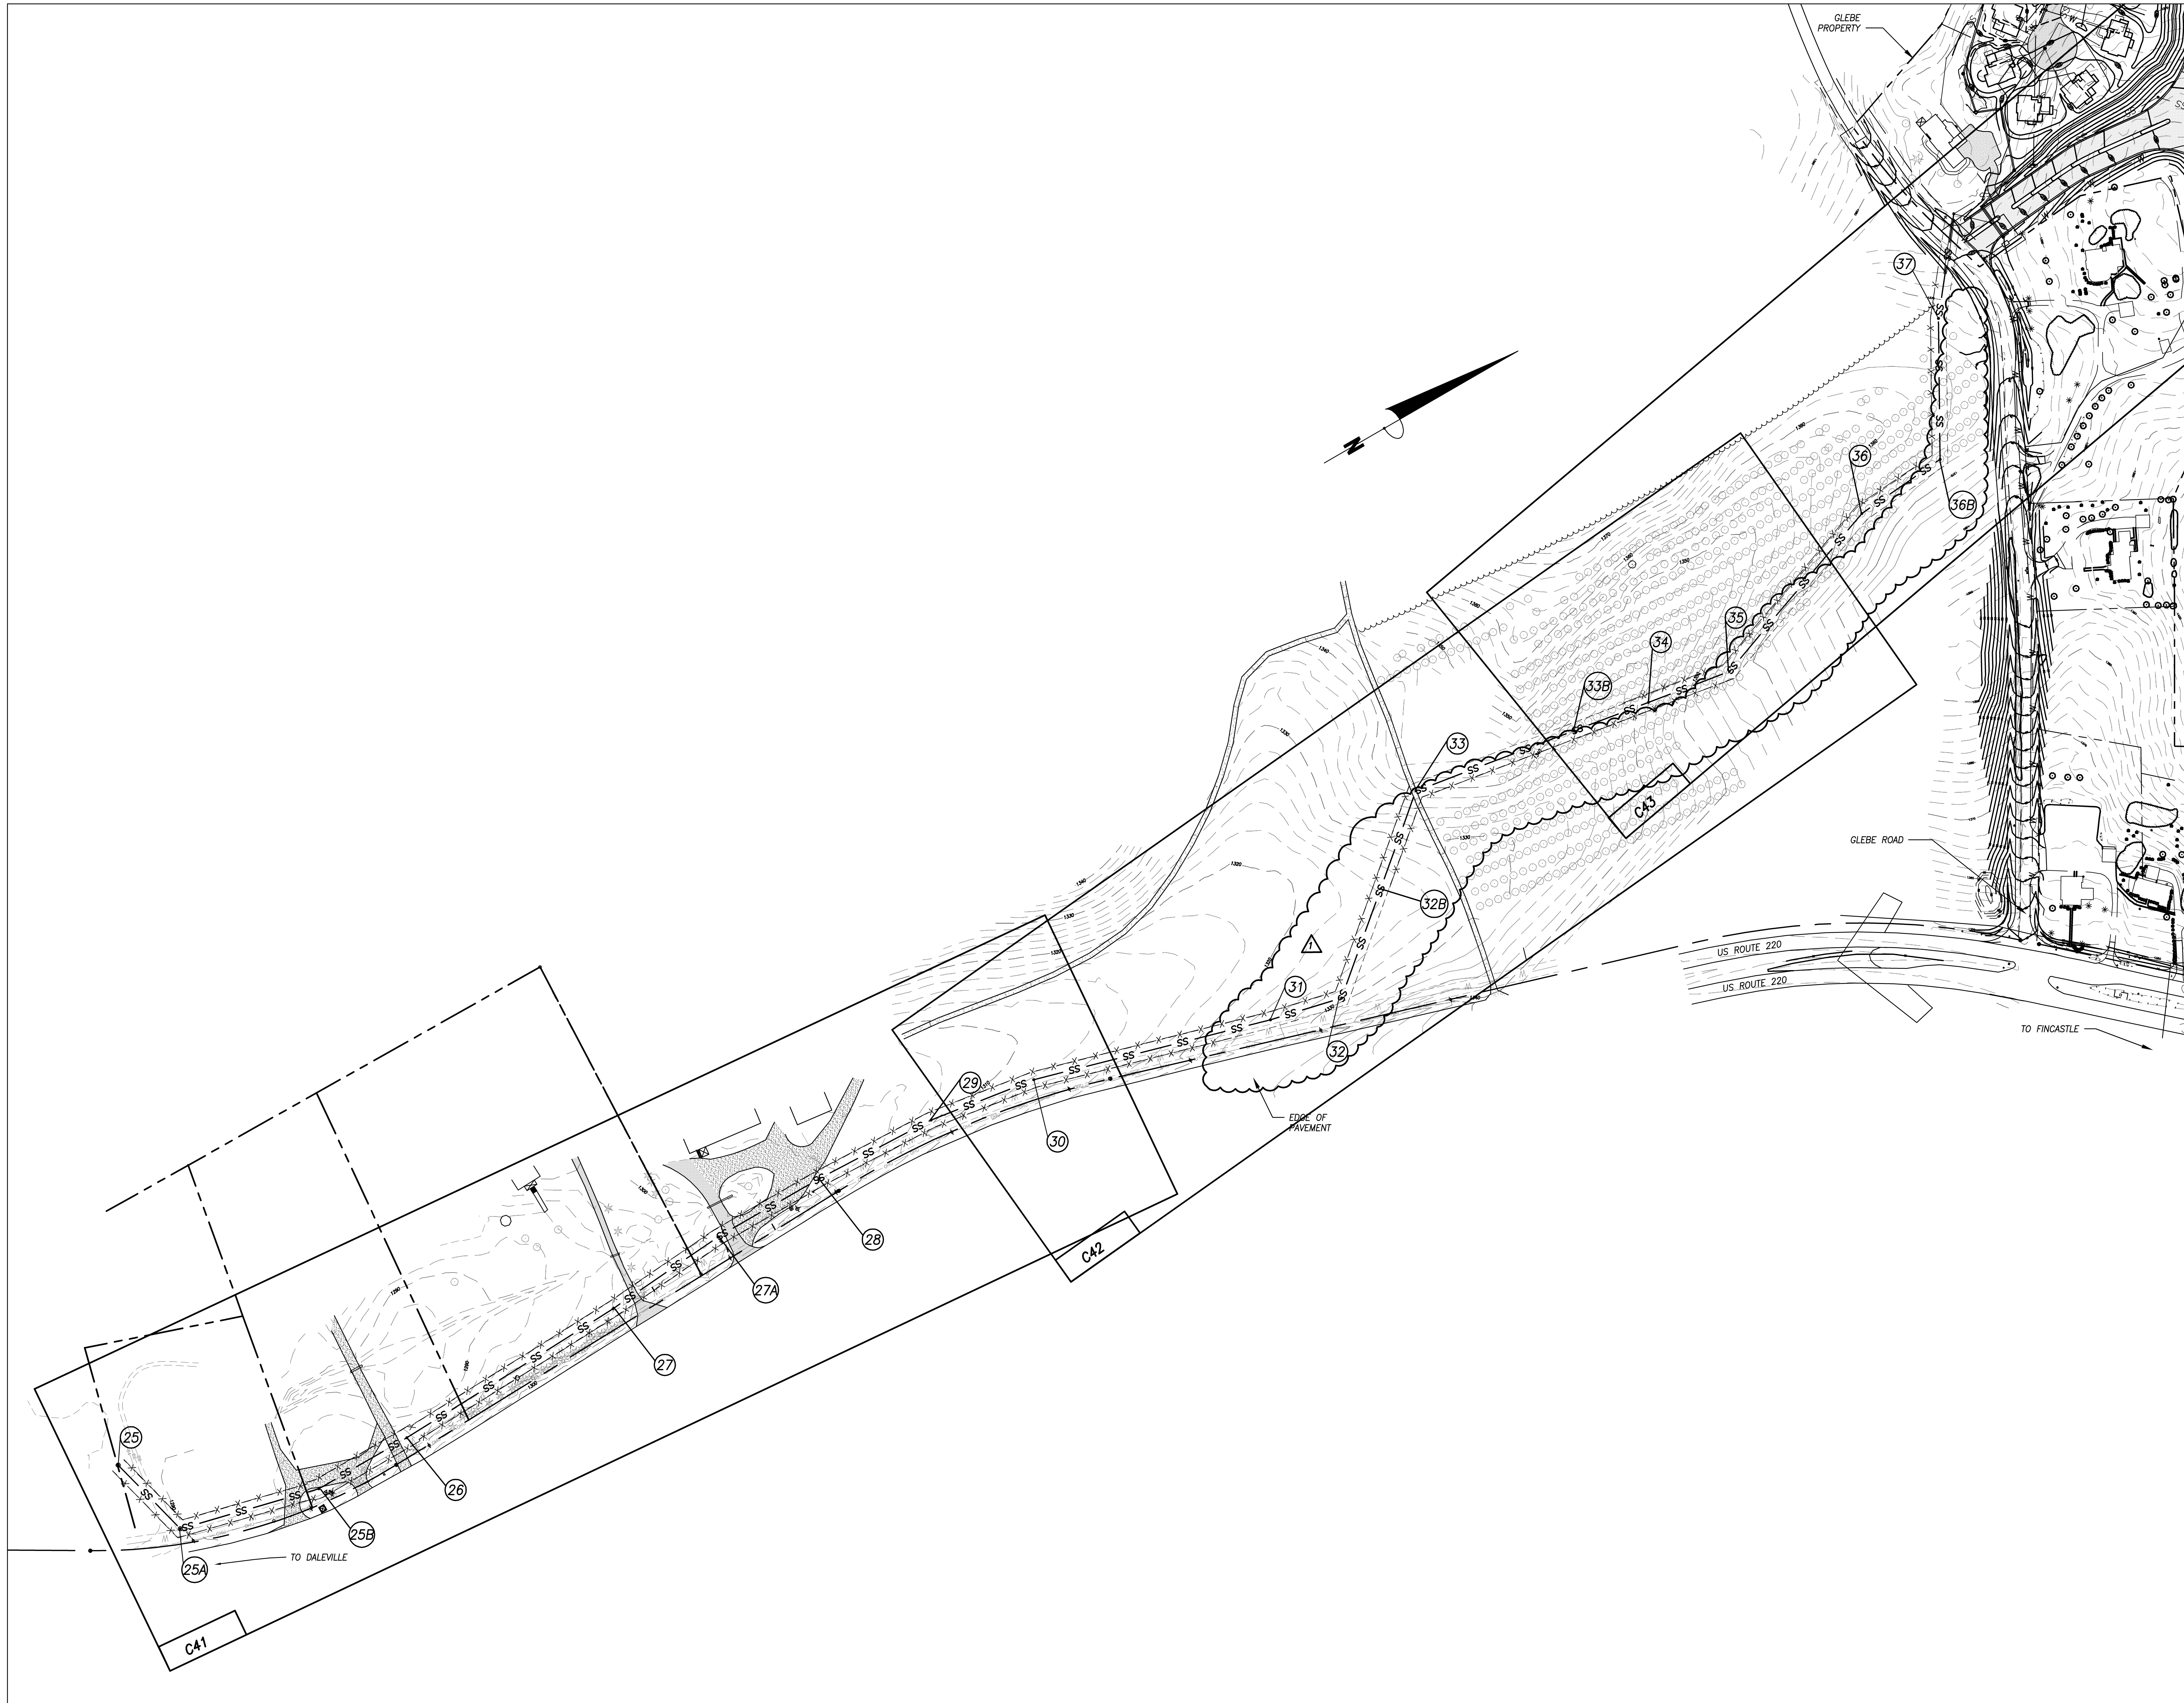


CADD VERSION
ACAD R14
PLOT SCALE
1:1
PLOT DATE
COMM. NO.
DRAWING NO.

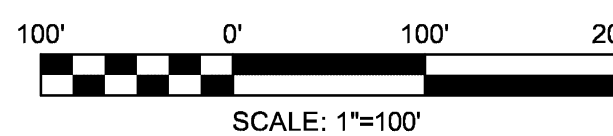

20 South Roanoke St.
Fincastle, Virginia 24090
540.473.1253 540.473.1254(Fax)
email@engineeringconcepts.com
ECI PROJECT #02019

GENERAL NOTES

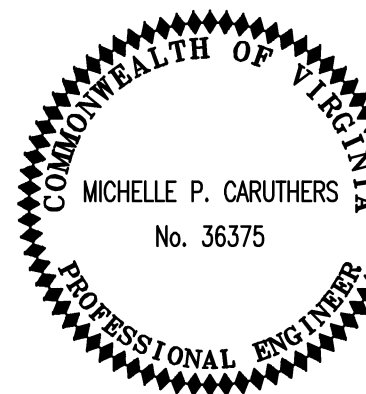

PROJECT TITLE

The Glebe

SFCS

SFCS Inc. • 305 South Jefferson Street
Roanoke, Virginia 24011.2003
540.344.6664 • Fax 540.343.6925
www.sfcs.com

PROJECT DESIGNER : SFCS
PROJECT ARCHITECT : SFCS
PROJECT ENGINEER : ECI
DRAWN BY : ECI
CHECKED BY : ECI
APPROVED BY : ECI

NO.	REVISION	DESCRIPTION	DATE
1	REVISIONS	SEWER ALIGNMENT	09/14/04

DRAWING TITLE
OFFSITE GRAVITY
SANITARY SEWER
OVERALL PLAN

COMM. NO.	DATE
471115.00	11/12/03

DRAWING	SHEET
C40	40 OF 43