


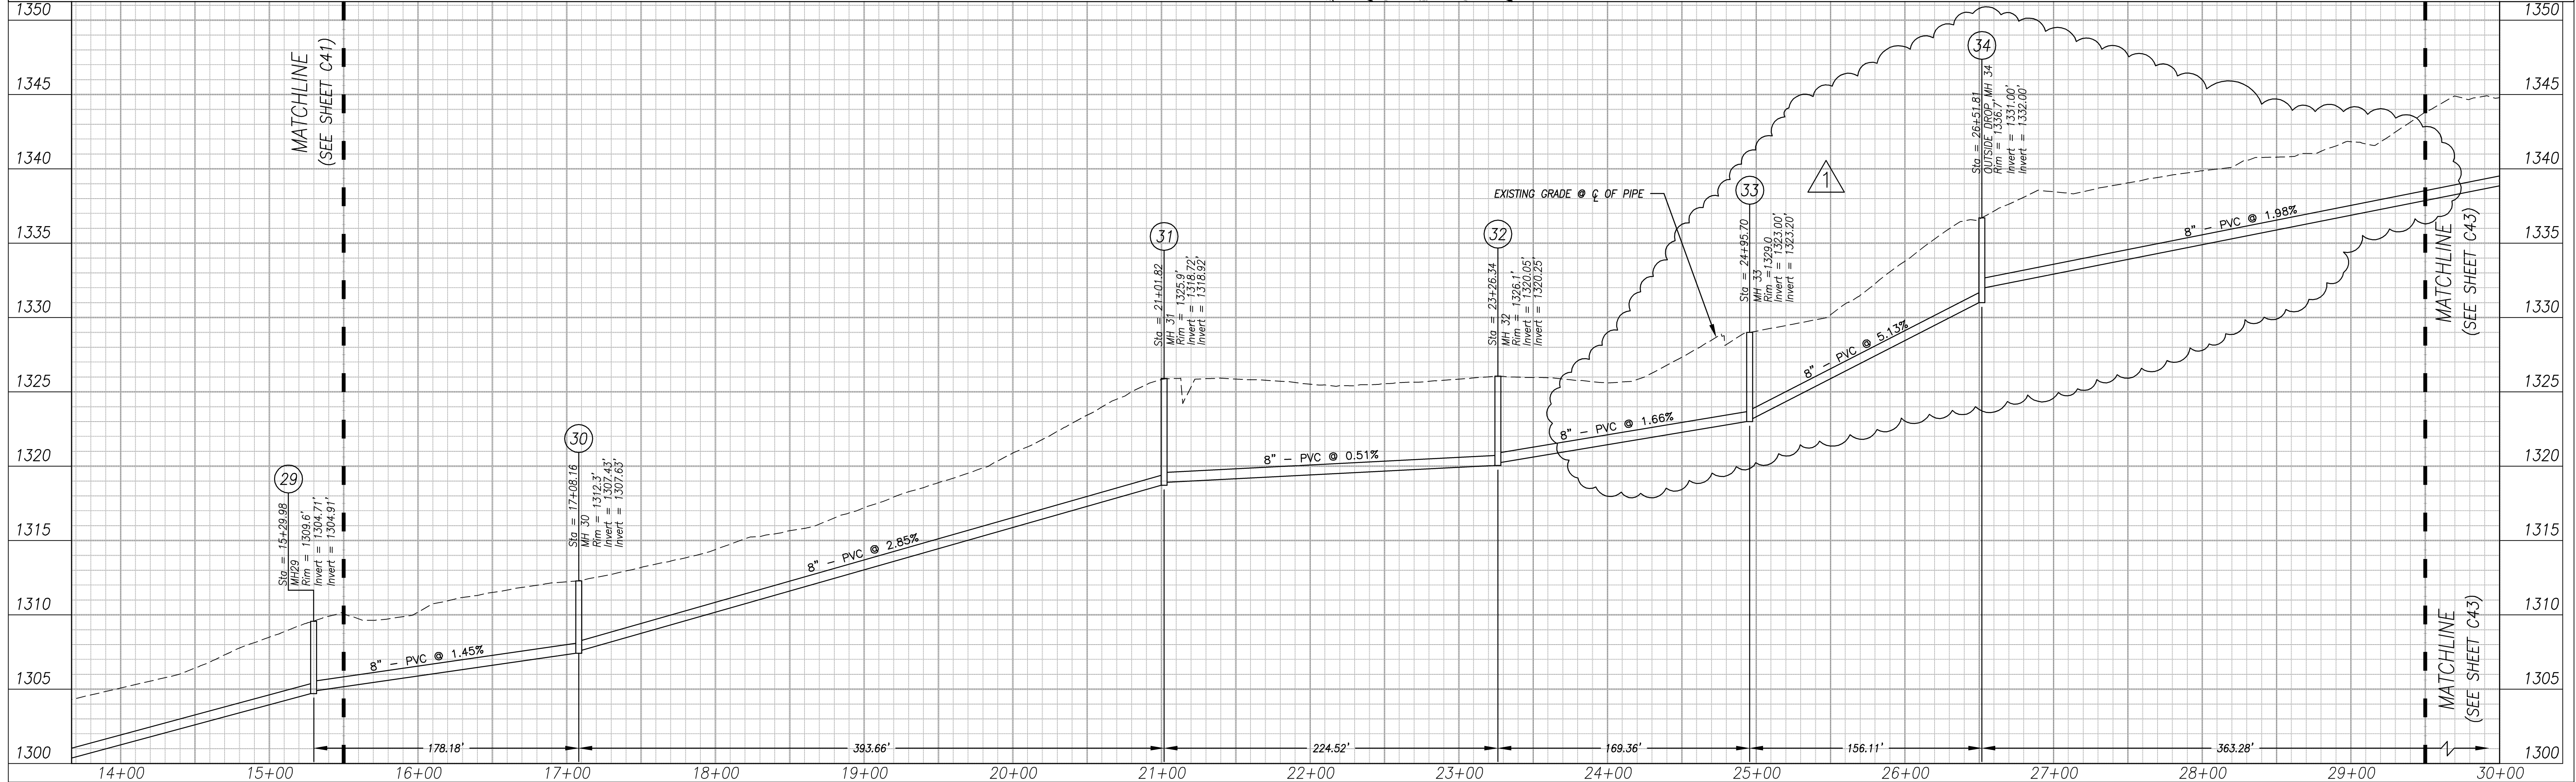


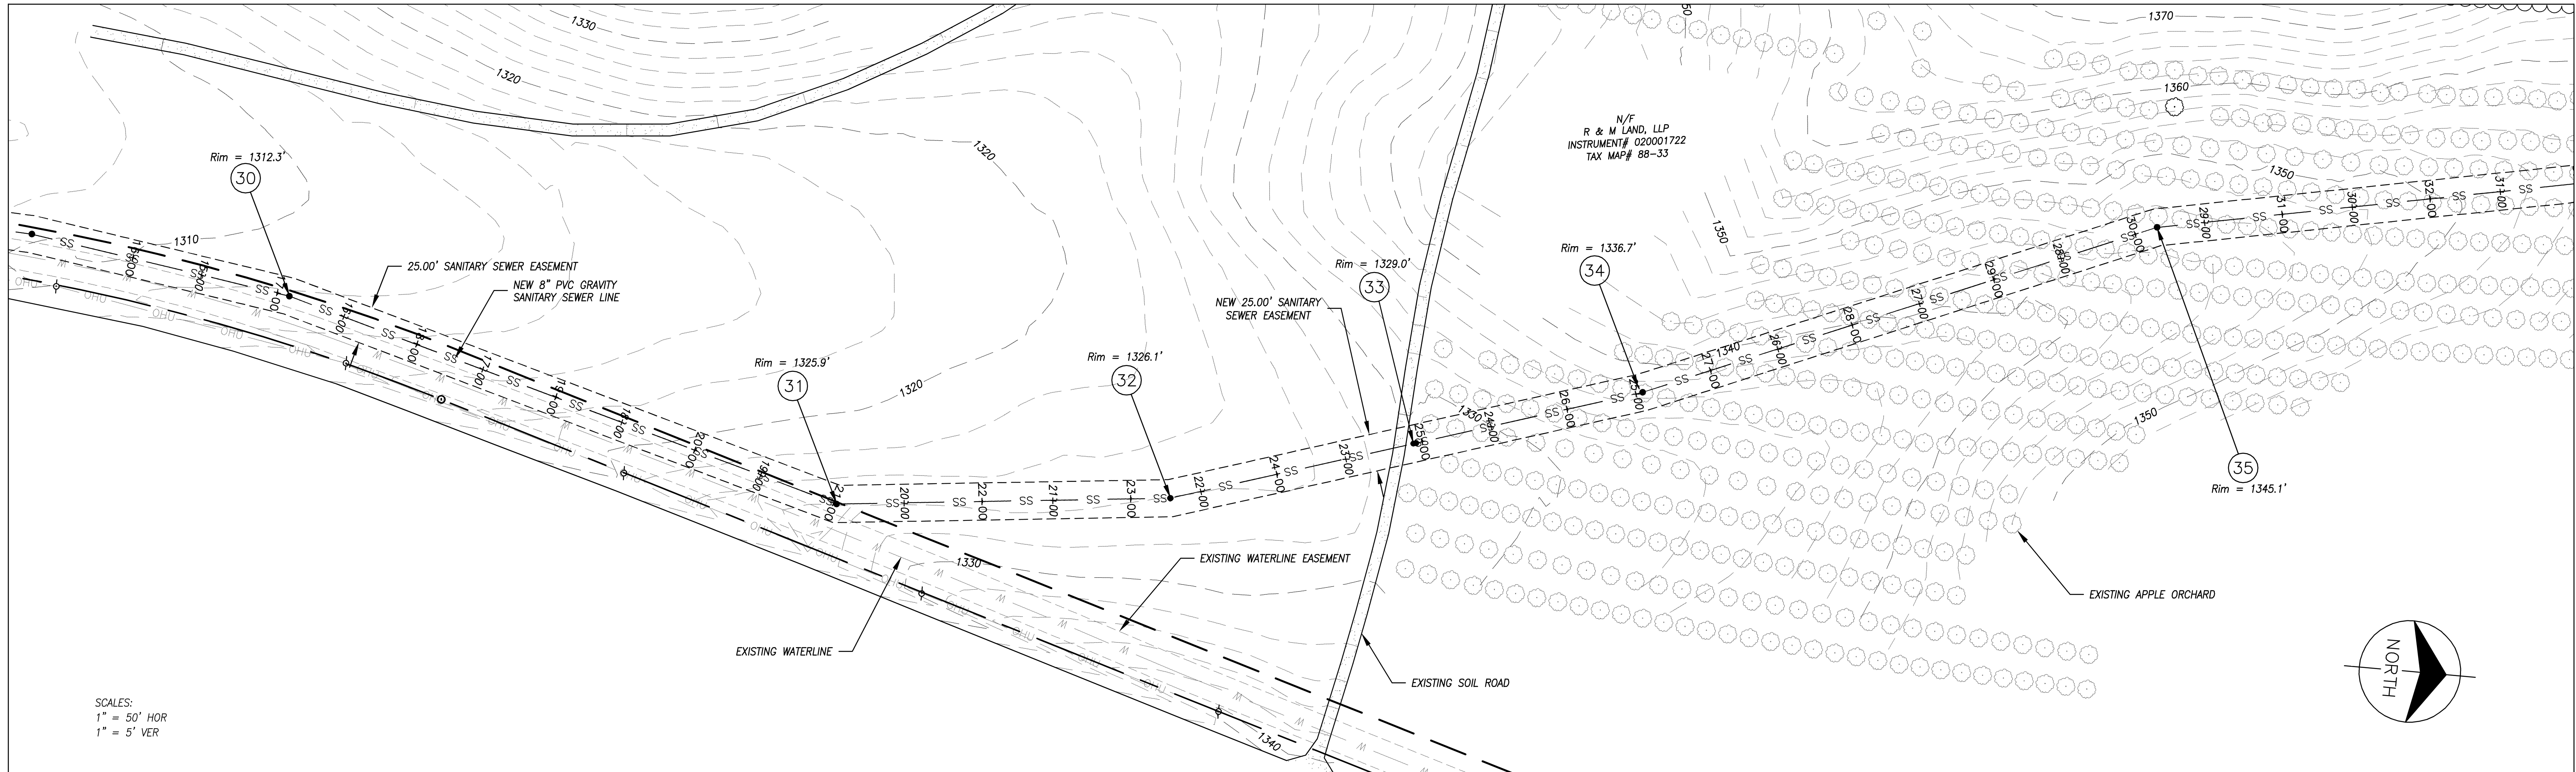

SLOPE CALCULATION NOTE:
ALL PIPE SLOPES ARE CALCULATED FROM INSIDE FACE OF
MANHOLE TO INSIDE FACE OF MANHOLE.


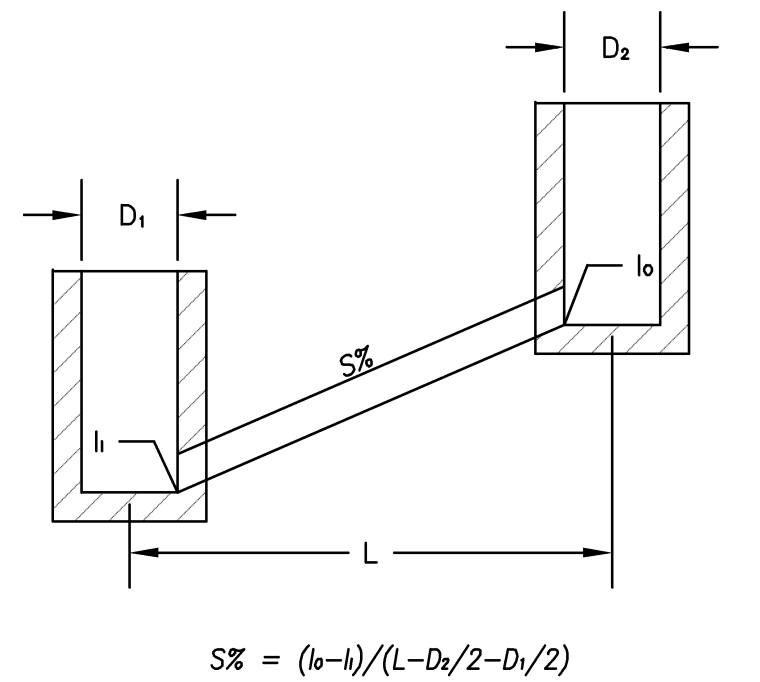


KEYPLAN

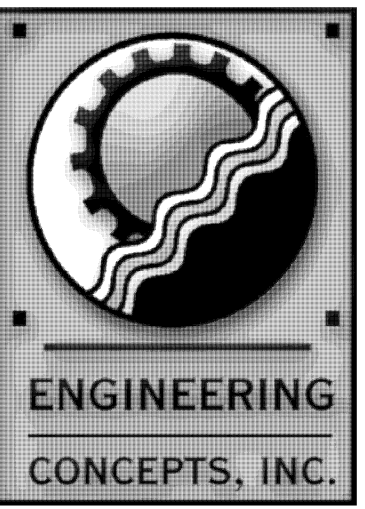

20 South Roanoke St.
Fincastle, Virginia 24090
540.473.1253 540.473.1254(Fax)
email@engineeringconcepts.com
ECI PROJECT #02019

GENERAL NOTES

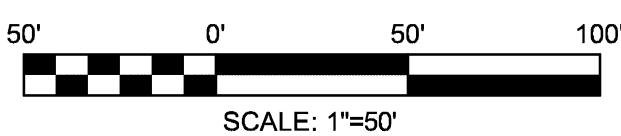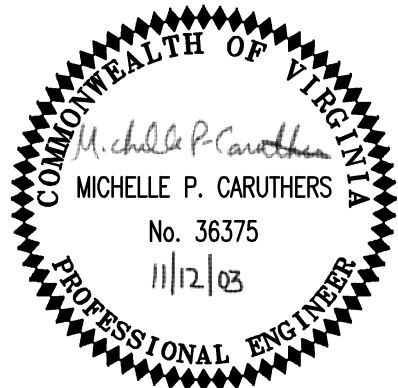

PROJECT TITLE

The Glebe

SFCS

SFCS Inc. • 305 South Jefferson Street
Roanoke, Virginia 24011.2003
540.344.6664 • Fax 540.343.6925
www.sfcs.com

PROJECT DESIGNER : SFCS
PROJECT ARCHITECT : SFCS
PROJECT ENGINEER : ECI
DRAWN BY : ECI
CHECKED BY : ECI
APPROVED BY : ECI

NO. REVISION DESCRIPTION DATE
1 REVISIONS PER BOT. CO. 11/12/03

DRAWING TITLE
OFFSITE GRAVITY
SANITARY SEWER
PLAN & PROFILE

COMM. NO. 47115.00 DATE 11/12/03

DRAWING SHEET

C42 42 OF 43