

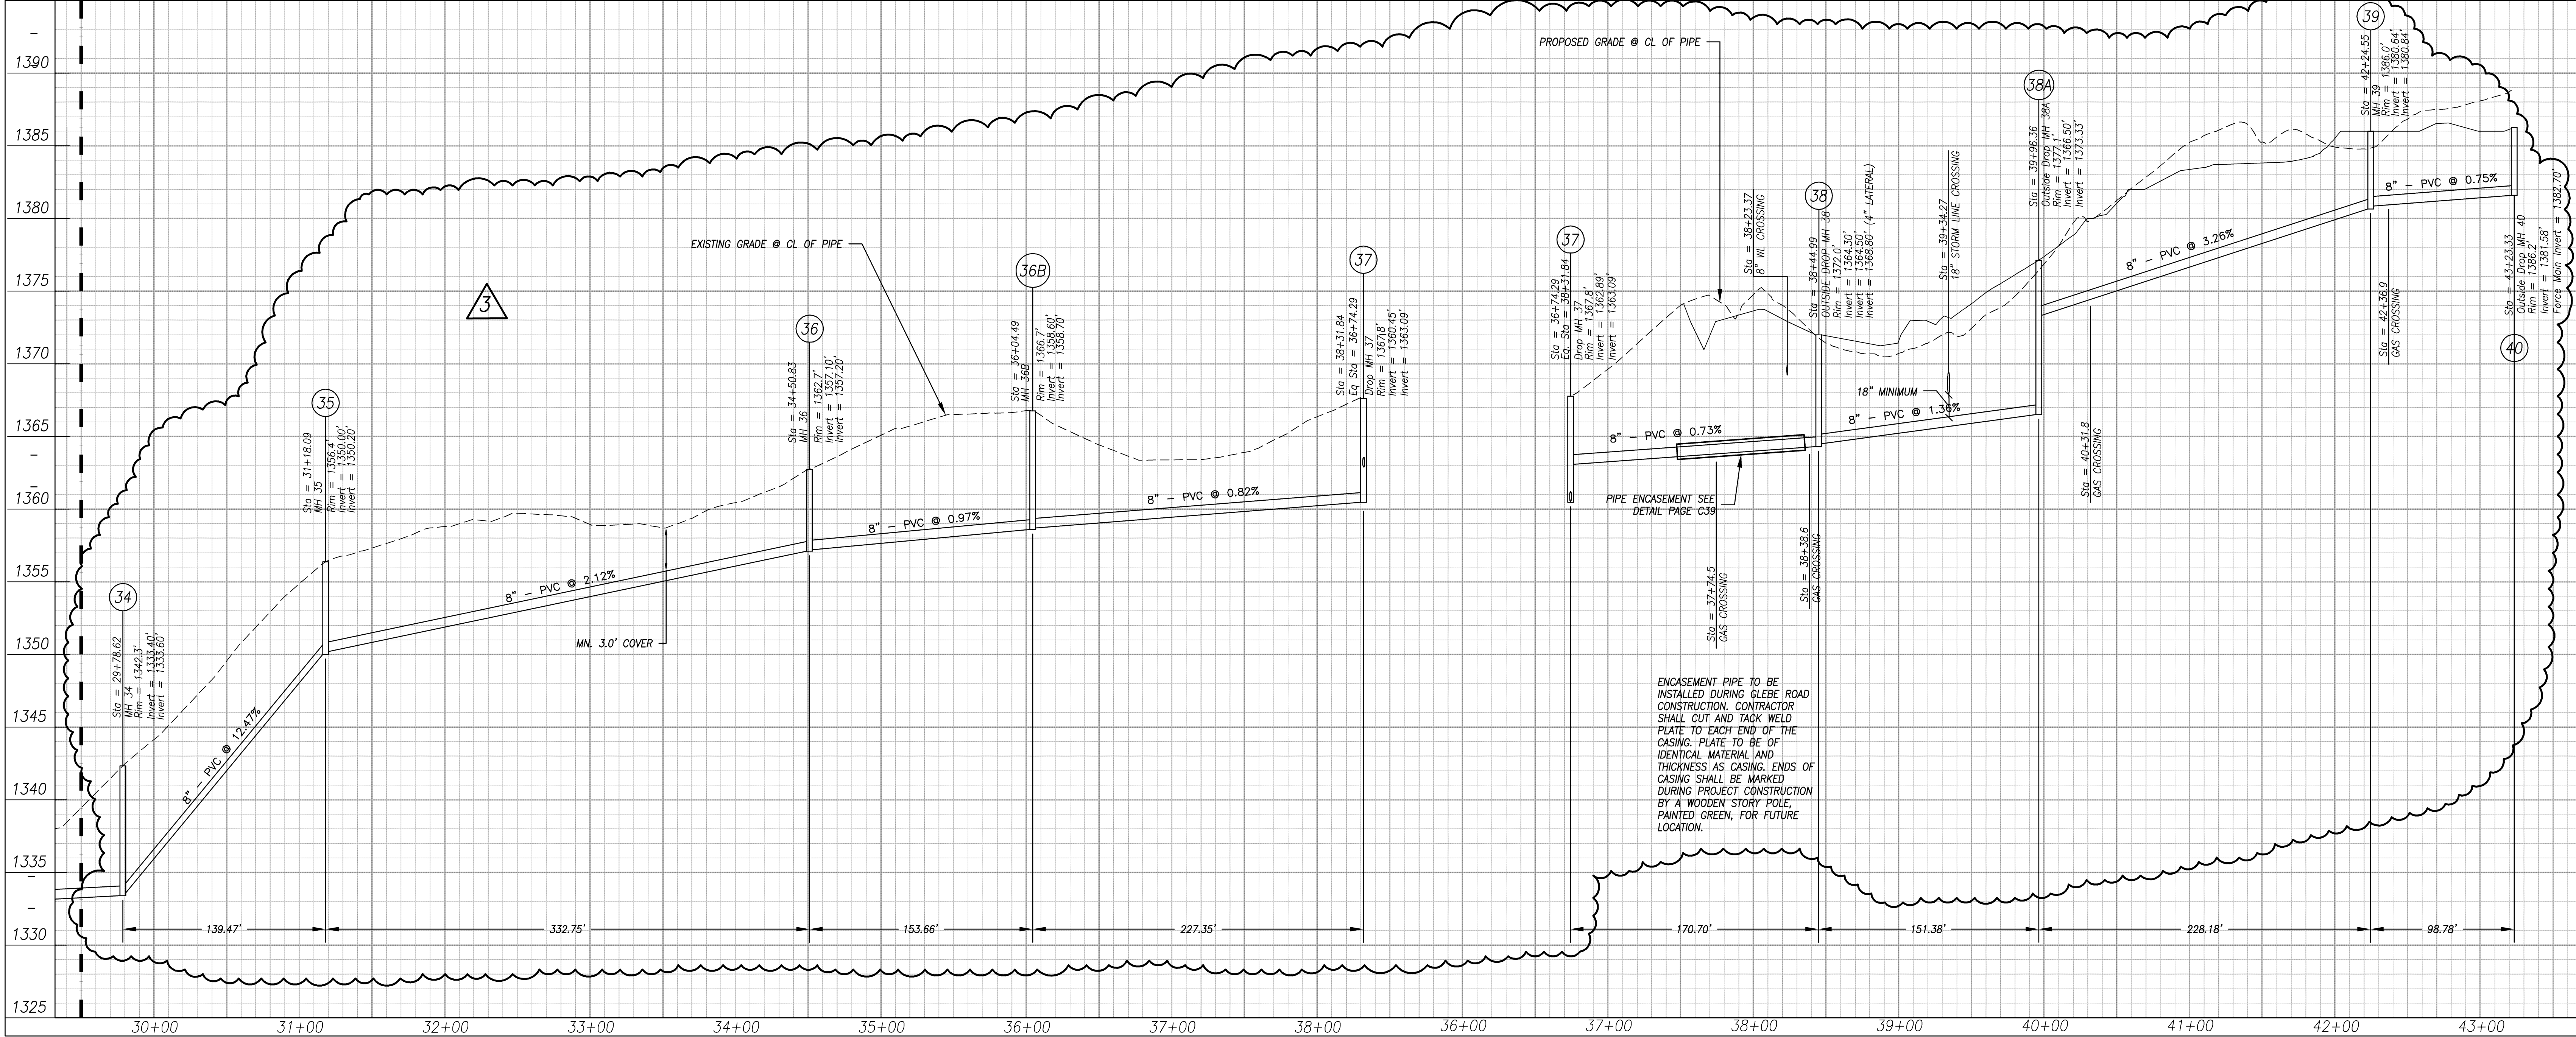


CADD VERSION
ACADR-14
PLOT SCALE
1:1
PLOT DATE
COMM. NO.
DRAWING NO.

NOTE:
EXCAVATED MATERIAL SHALL BE
ADDED ON THE UPHILL SIDE OF THE
INSTALLED TRENCH. SILT FENCE
SHALL BE ON THE DOWNHILL SIDE
OF THE TRENCH.


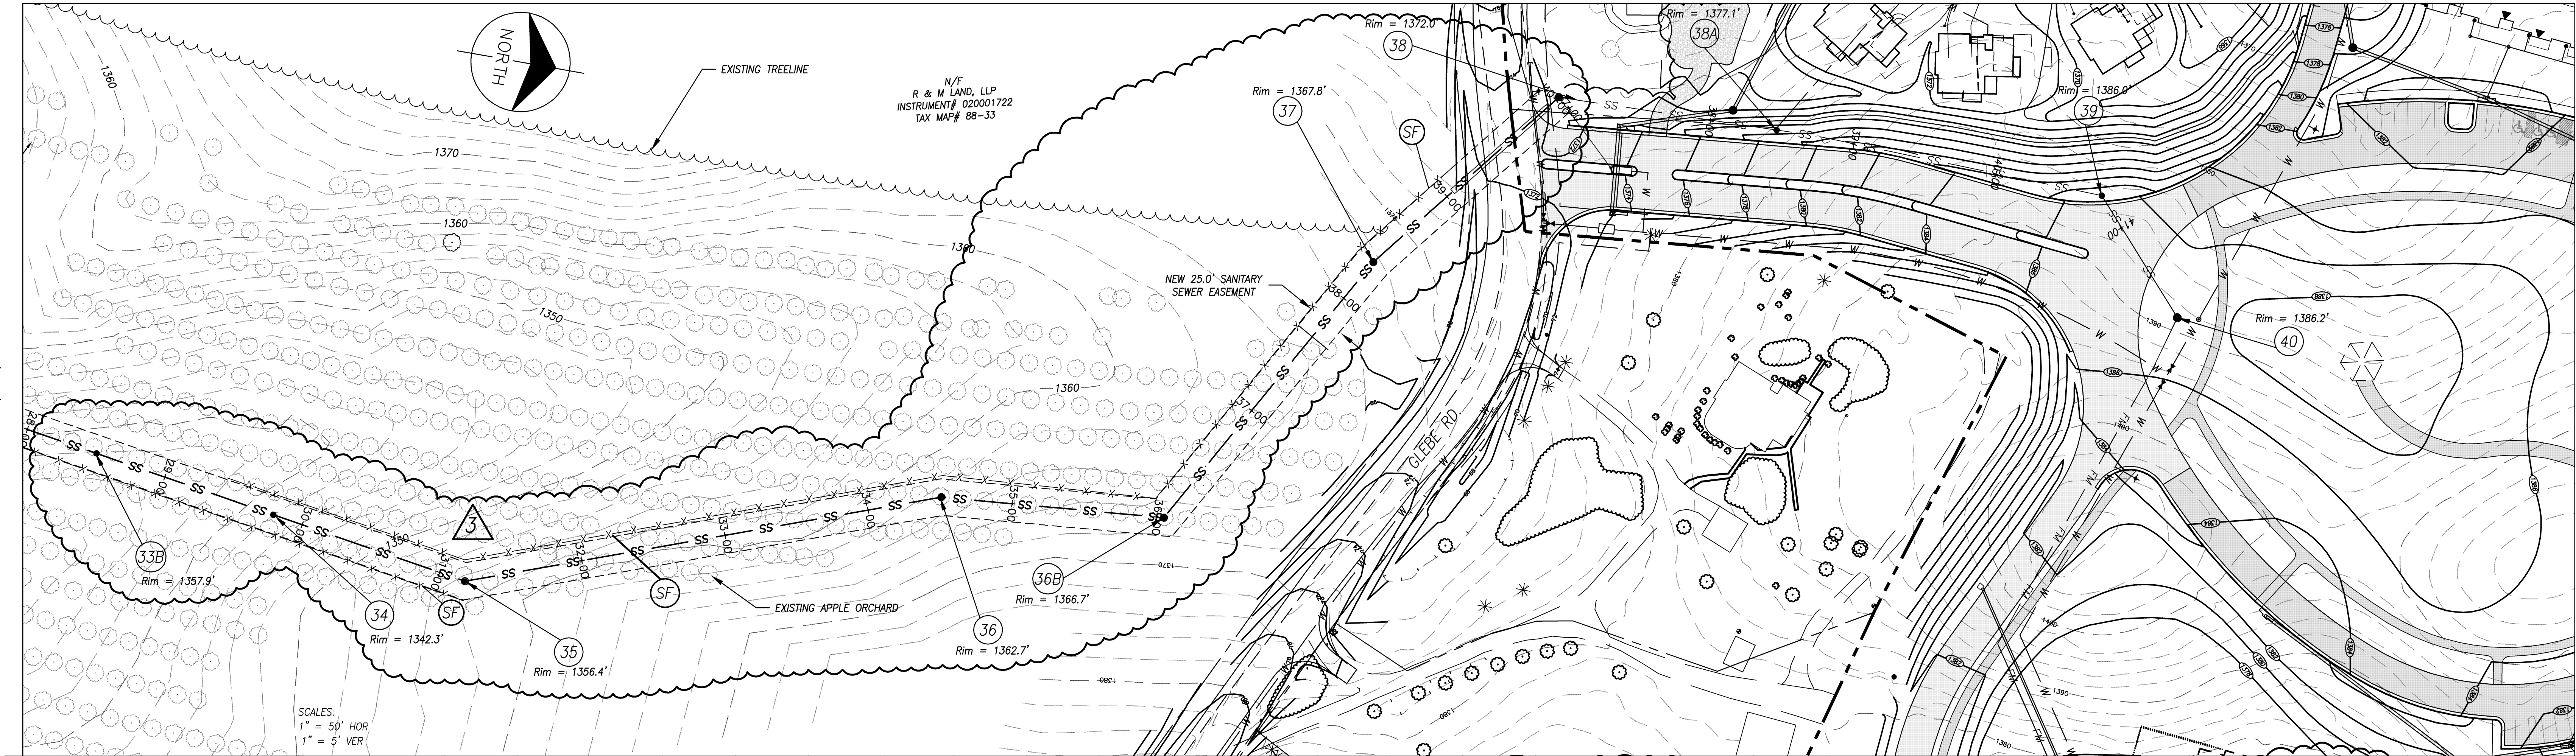


KEYPLAN

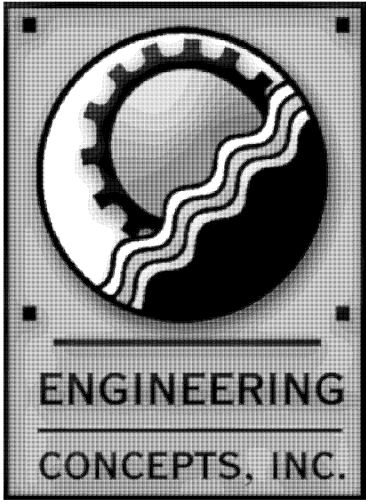

20 South Roanoke St.
Fincastle, Virginia 24090
540.473.1253 540.473.1254(Fax)
email@engineeringconcepts.com
ECI PROJECT #02019

GENERAL NOTES

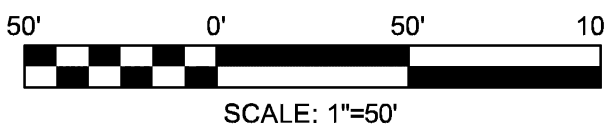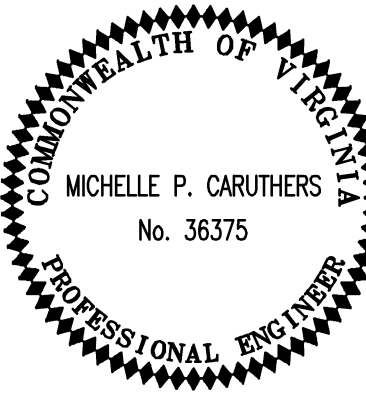

PROJECT TITLE

The Glebe

SFCS

SFCS Inc. • 305 South Jefferson Street
Roanoke, Virginia 24011.2003
540.344.6664 • Fax 540.343.6925
www.sfcs.com

PROJECT DESIGNER	:	SFCS	
PROJECT ARCHITECT	:	SFCS	
PROJECT ENGINEER	:	ECI	
DRAWN BY	:	ECI	
CHECKED BY	:	ECI	
APPROVED BY	:	ECI	
NO.	REVISION	DESCRIPTION	DATE
1	BOT CO	REQUESTED CHANGES	9/4/03
2	REVISIONS	PER BOT. CO.	11/12/03
3	REVISIONS	SEWER ALIGNMENT	09/14/04

DRAWING TITLE
OFFSITE GRAVITY
SANITARY SEWER
PLAN & PROFILE

COMM. NO.	DATE
47115.00	11/12/03
DRAWING	SHEET

C43

43 OF 43