

DATE: 11/12/09
 REVISIONS
 05/07/2012
 05/31/2012
 12/03/2012


PIERSON
 ENGINEERING
 &
 SURVEYING

P.O. BOX 311
 44 CATAWBA ROAD
 DALEVILLE, VA 24083


(540) 966-3027 TEL
 (540) 966-5906 FAX
 e-mail: rpierson@rbnet.com

DEVELOPMENT PLANS FOR
SANTILLANE PHASE 4
 BOTETOURT COUNTY, VIRGINIA

PLAN SHEET

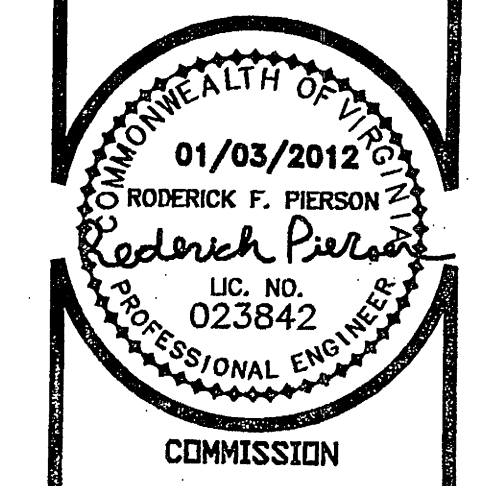


SHEET
 2

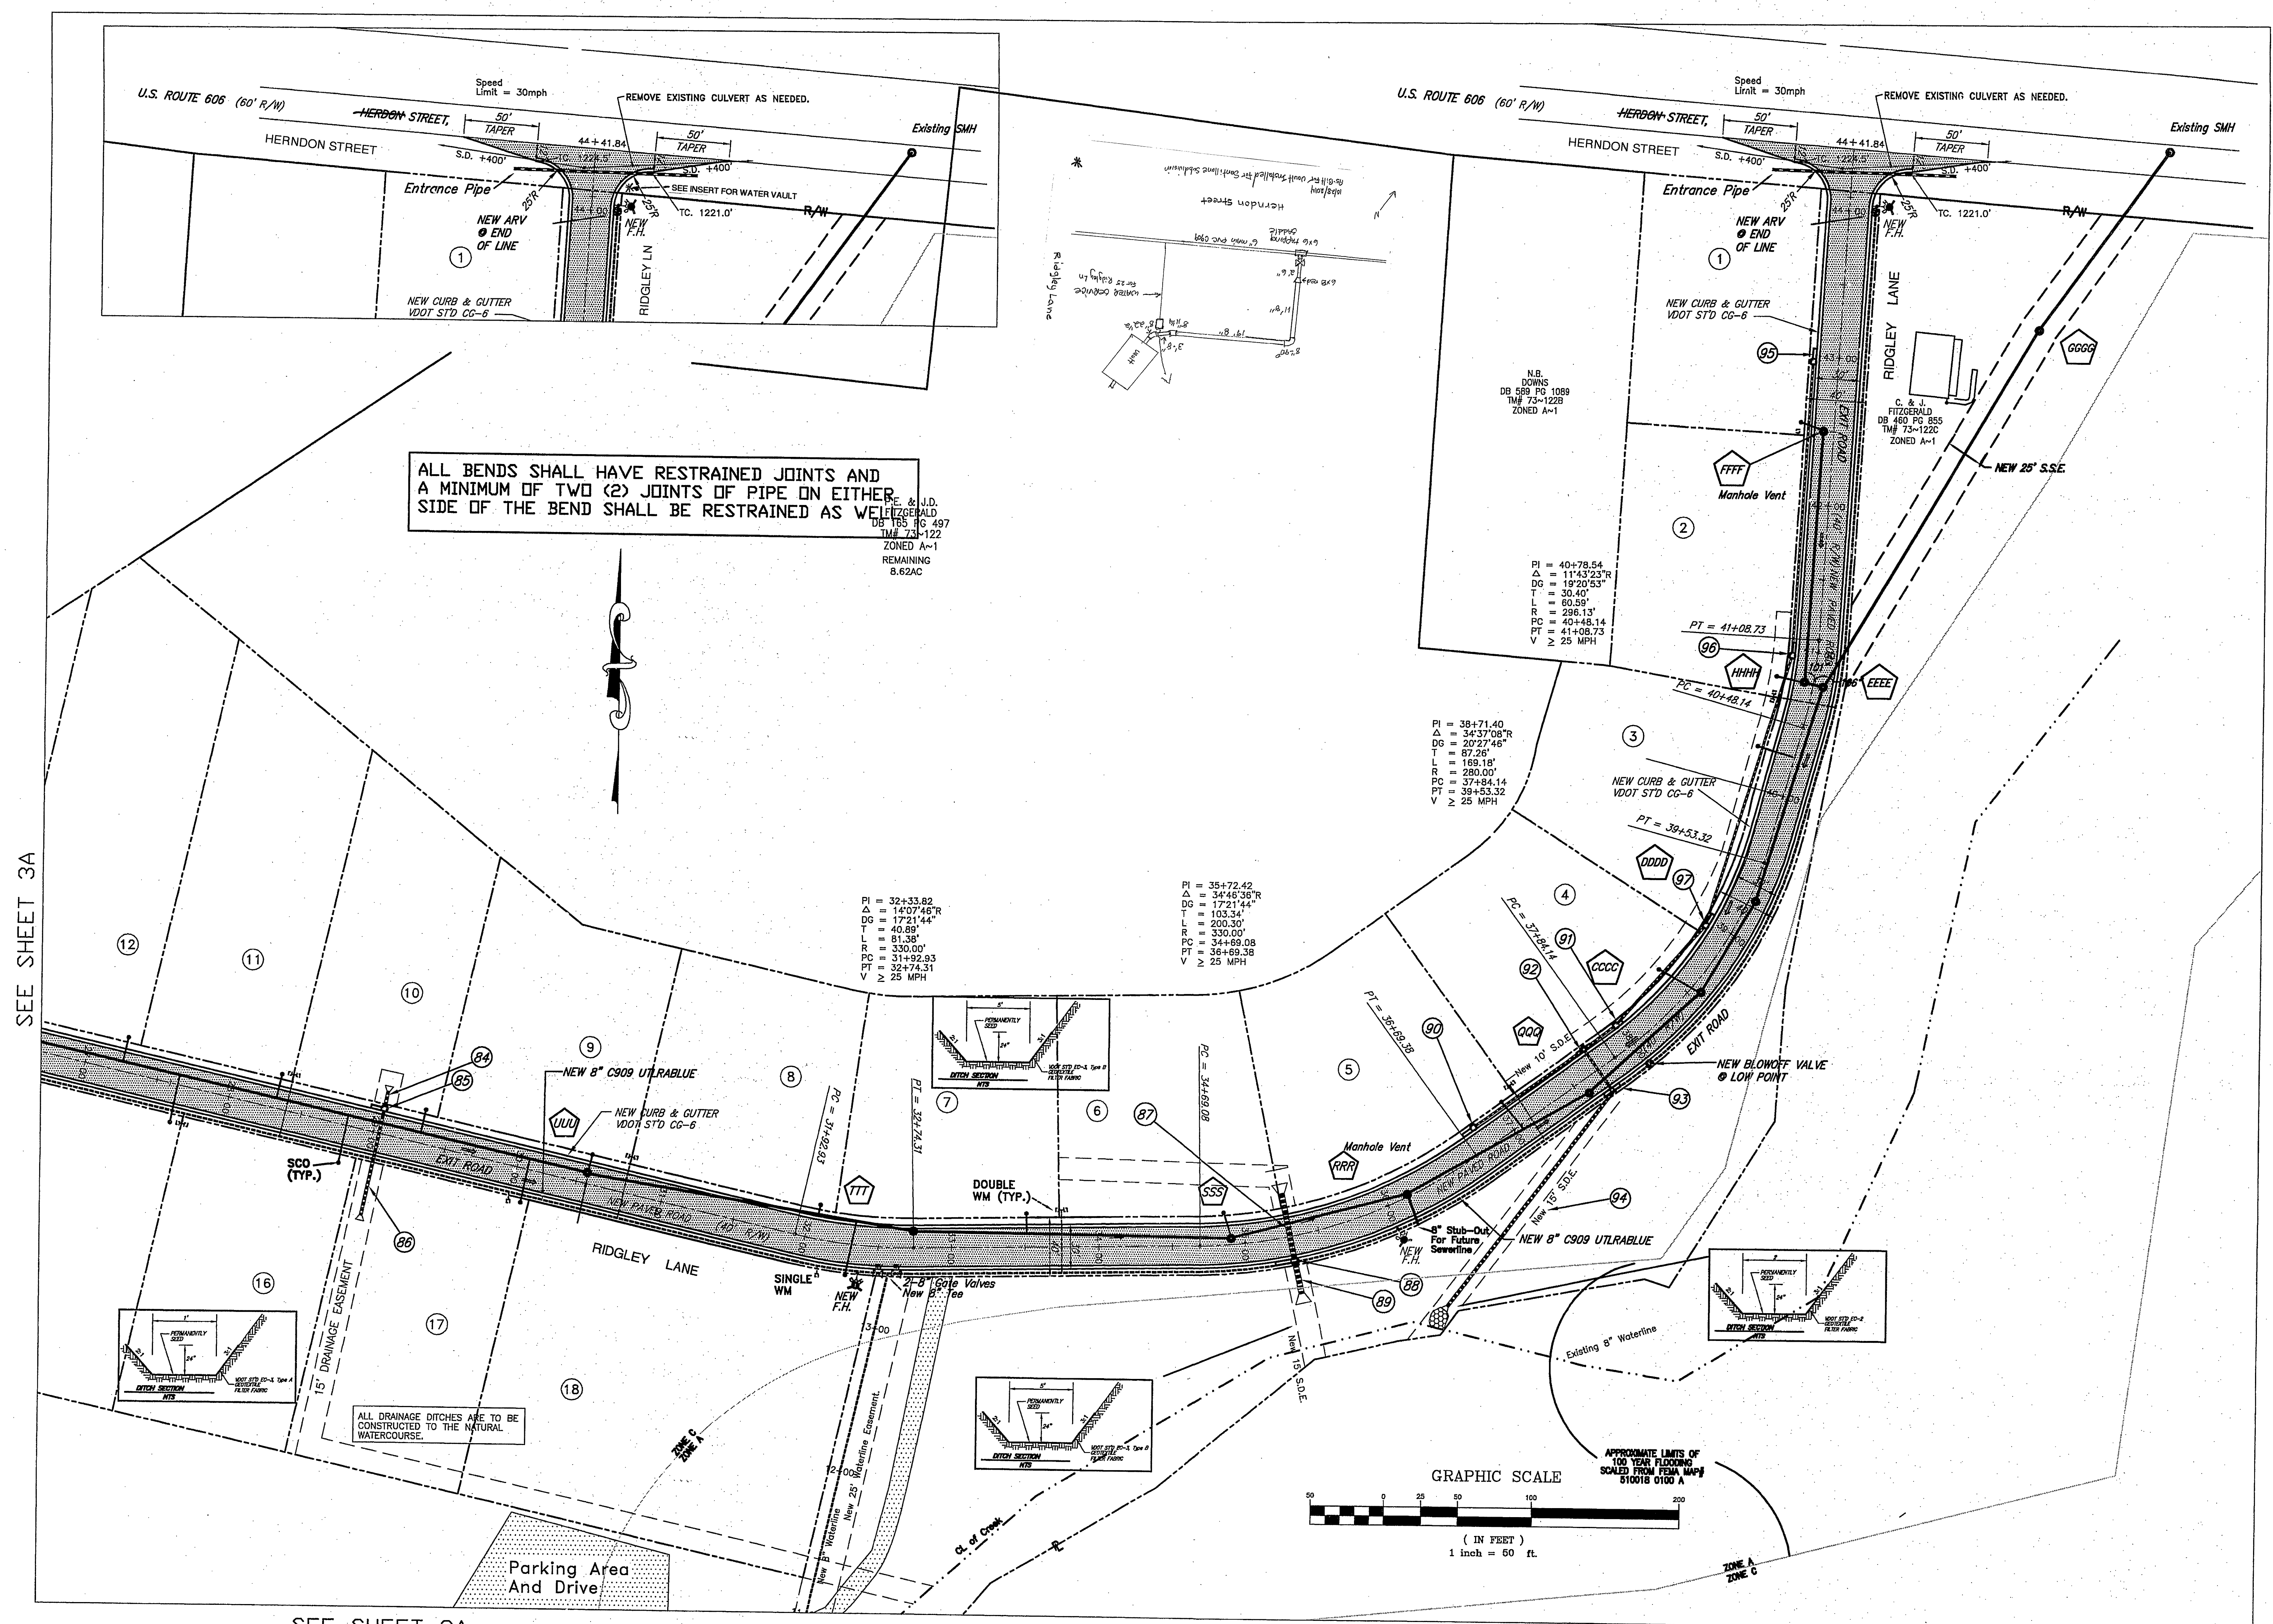

ALL BENDS SHALL HAVE RESTRAINED JOINTS AND
 A MINIMUM OF TWO (2) JOINTS OF PIPE ON EITHER
 SIDE OF THE BEND SHALL BE RESTRAINED AS WELL.
 R.F. & J.D. FITZGERALD
 DB 185 PG 497
 TM# 73-122
 ZONED A-1
 REMAINING
 6.62AC

ALL DRAINAGE DITCHES ARE TO BE
 CONSTRUCTED TO THE NATURAL
 WATERCOURSE.

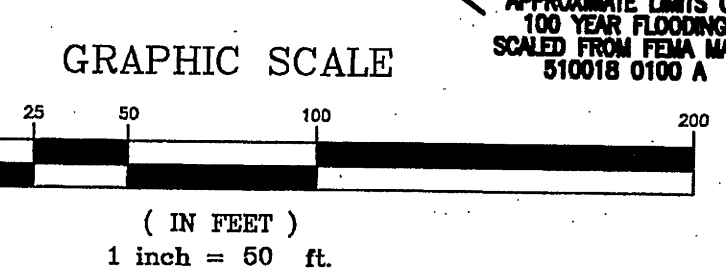

SEE SHEET 3A

SEE SHEET 2A