

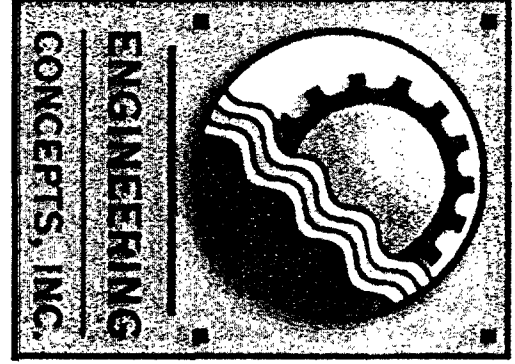


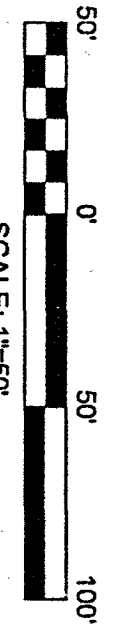

20 South Renne St.
Fallsdale, Virginia 24090
540.712.1233 540.473.1234 (fax)
www.eci-engineers.com
ECI PROJECT #2019

GENERAL NOTES

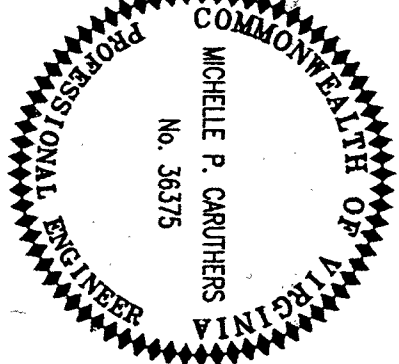

PROJECT TITLE


The Gleebe

SPCS Architecture
Engineering
Interiors
SPCS, Inc. • 305 South Jefferson Street
Blacksburg, Virginia 24011-2003
540.476.6664 • Fax 540.343.6925
www.spcs.com

PROJECT DESIGNER	: SPCS
PROJECT ARCHITECT	: SPCS
PROJECT ENGINEER	: ECI
DRAWN BY	: ECI
CHECKED BY	: ECI
APPROVED BY	: ECI
NO.	REVISION DESCRIPTION
1	REVISIONS PER BOT. CO. 11/12/03
2	REVISIONS SEWER ALIGNMENT 09/14/04

OFFSITE GRAVITY
SANITARY SEWER
PLAN & PROFILE


COMD. NO.	DATE
4711240	10/12/03
DRAWING	SHEET
C42	SD374
	42 OF 49

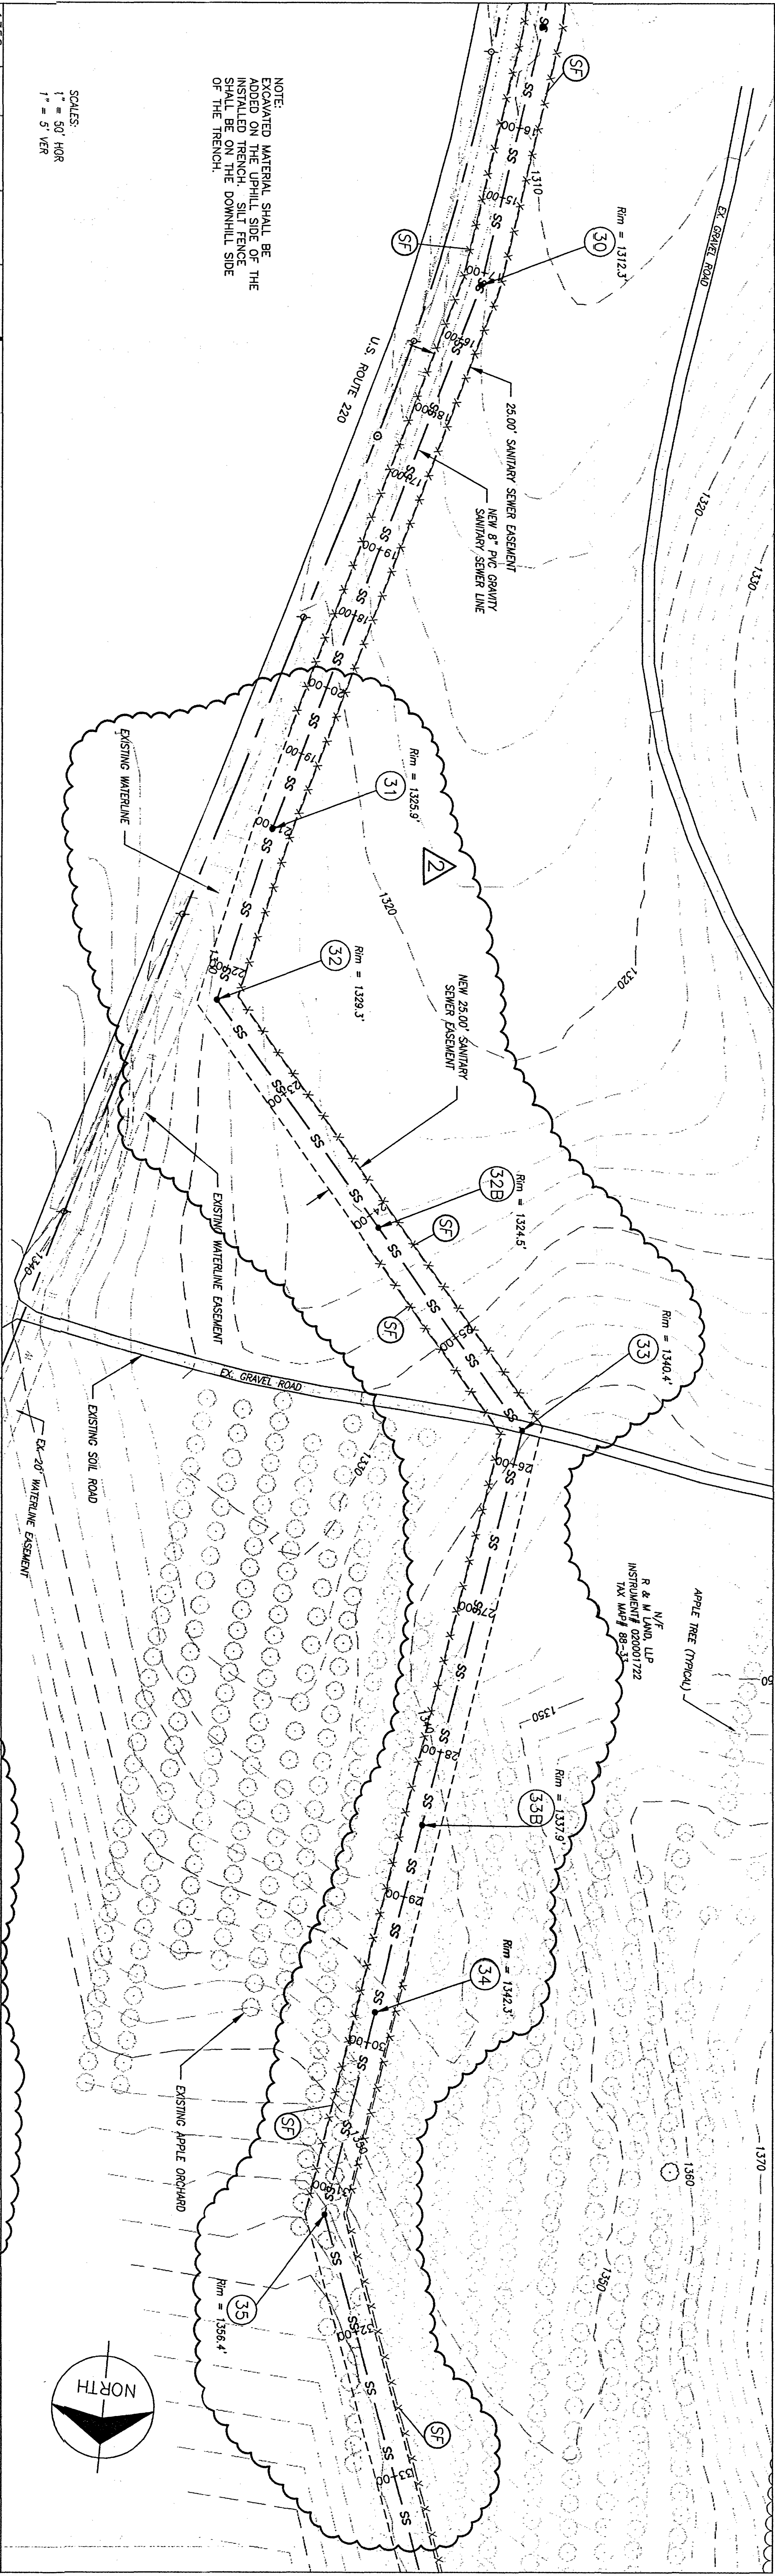


NOTE:
SHALL BE ON THE DOWNHILL SIDE
OF THE TRENCH.

SCALES:

MATCHLINE
(SEE SHEET C41)

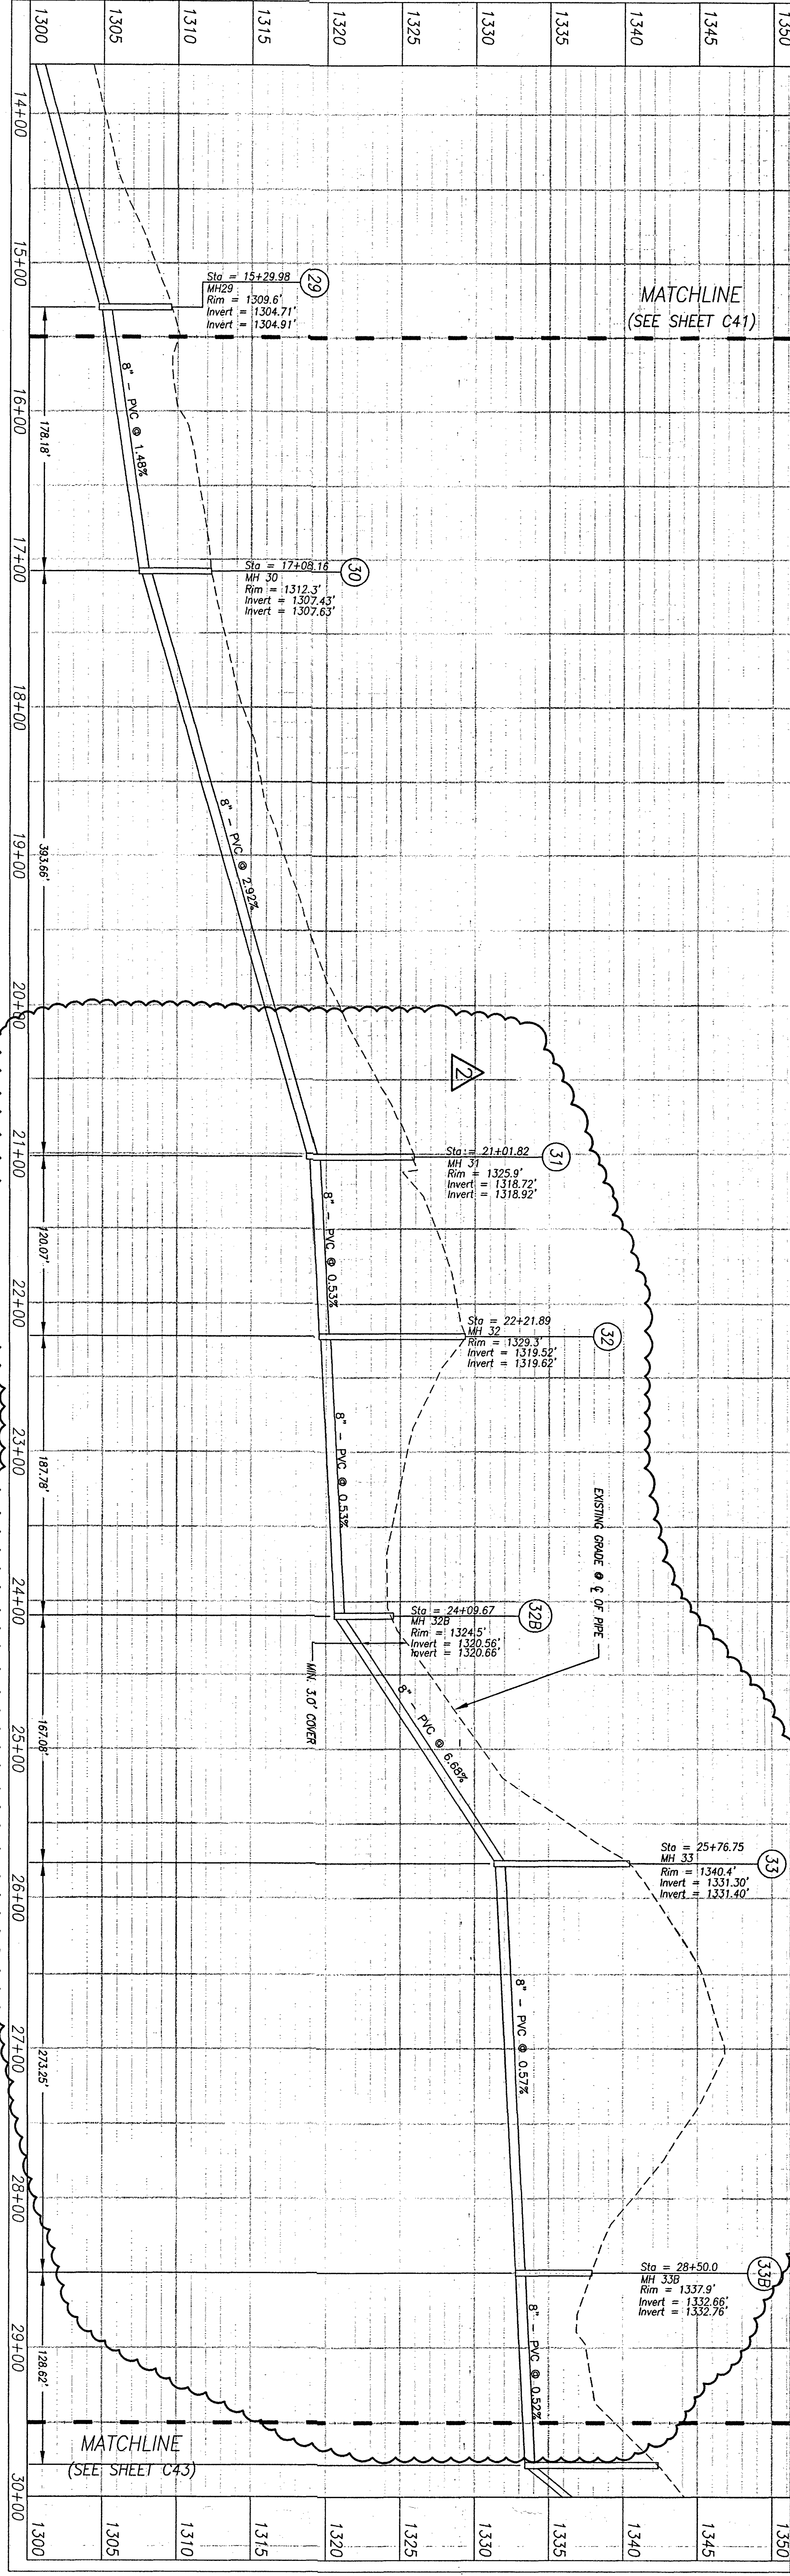

SLOPE CALCULATION NOTE:
ALL PIPE SLOPES ARE CALCULATED FROM INSIDE FACE OF
MANHOLE TO INSIDE FACE OF MANHOLE.

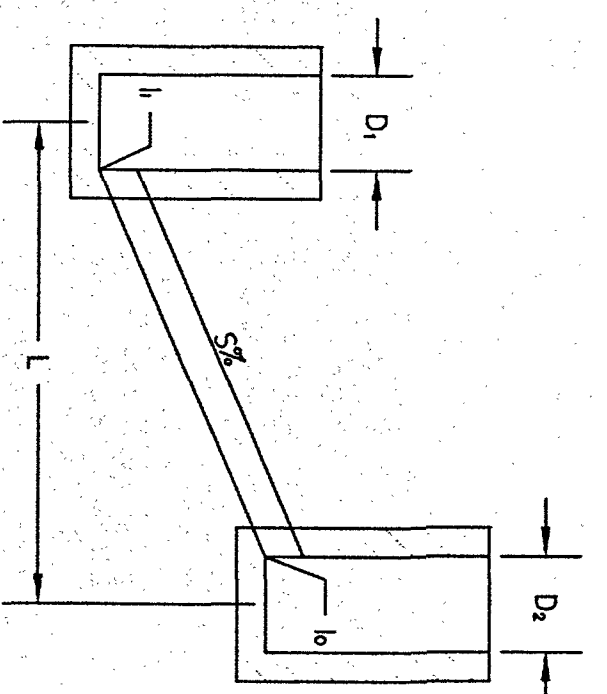

$$S = (D_1 - D_2) / (L - D_1 - D_2)$$

MENU

000 VERSION	AC-03-14
FOOT SCALE	1/1
FOOT DATE	
COMD. NO.	
DRAWING NO.	