
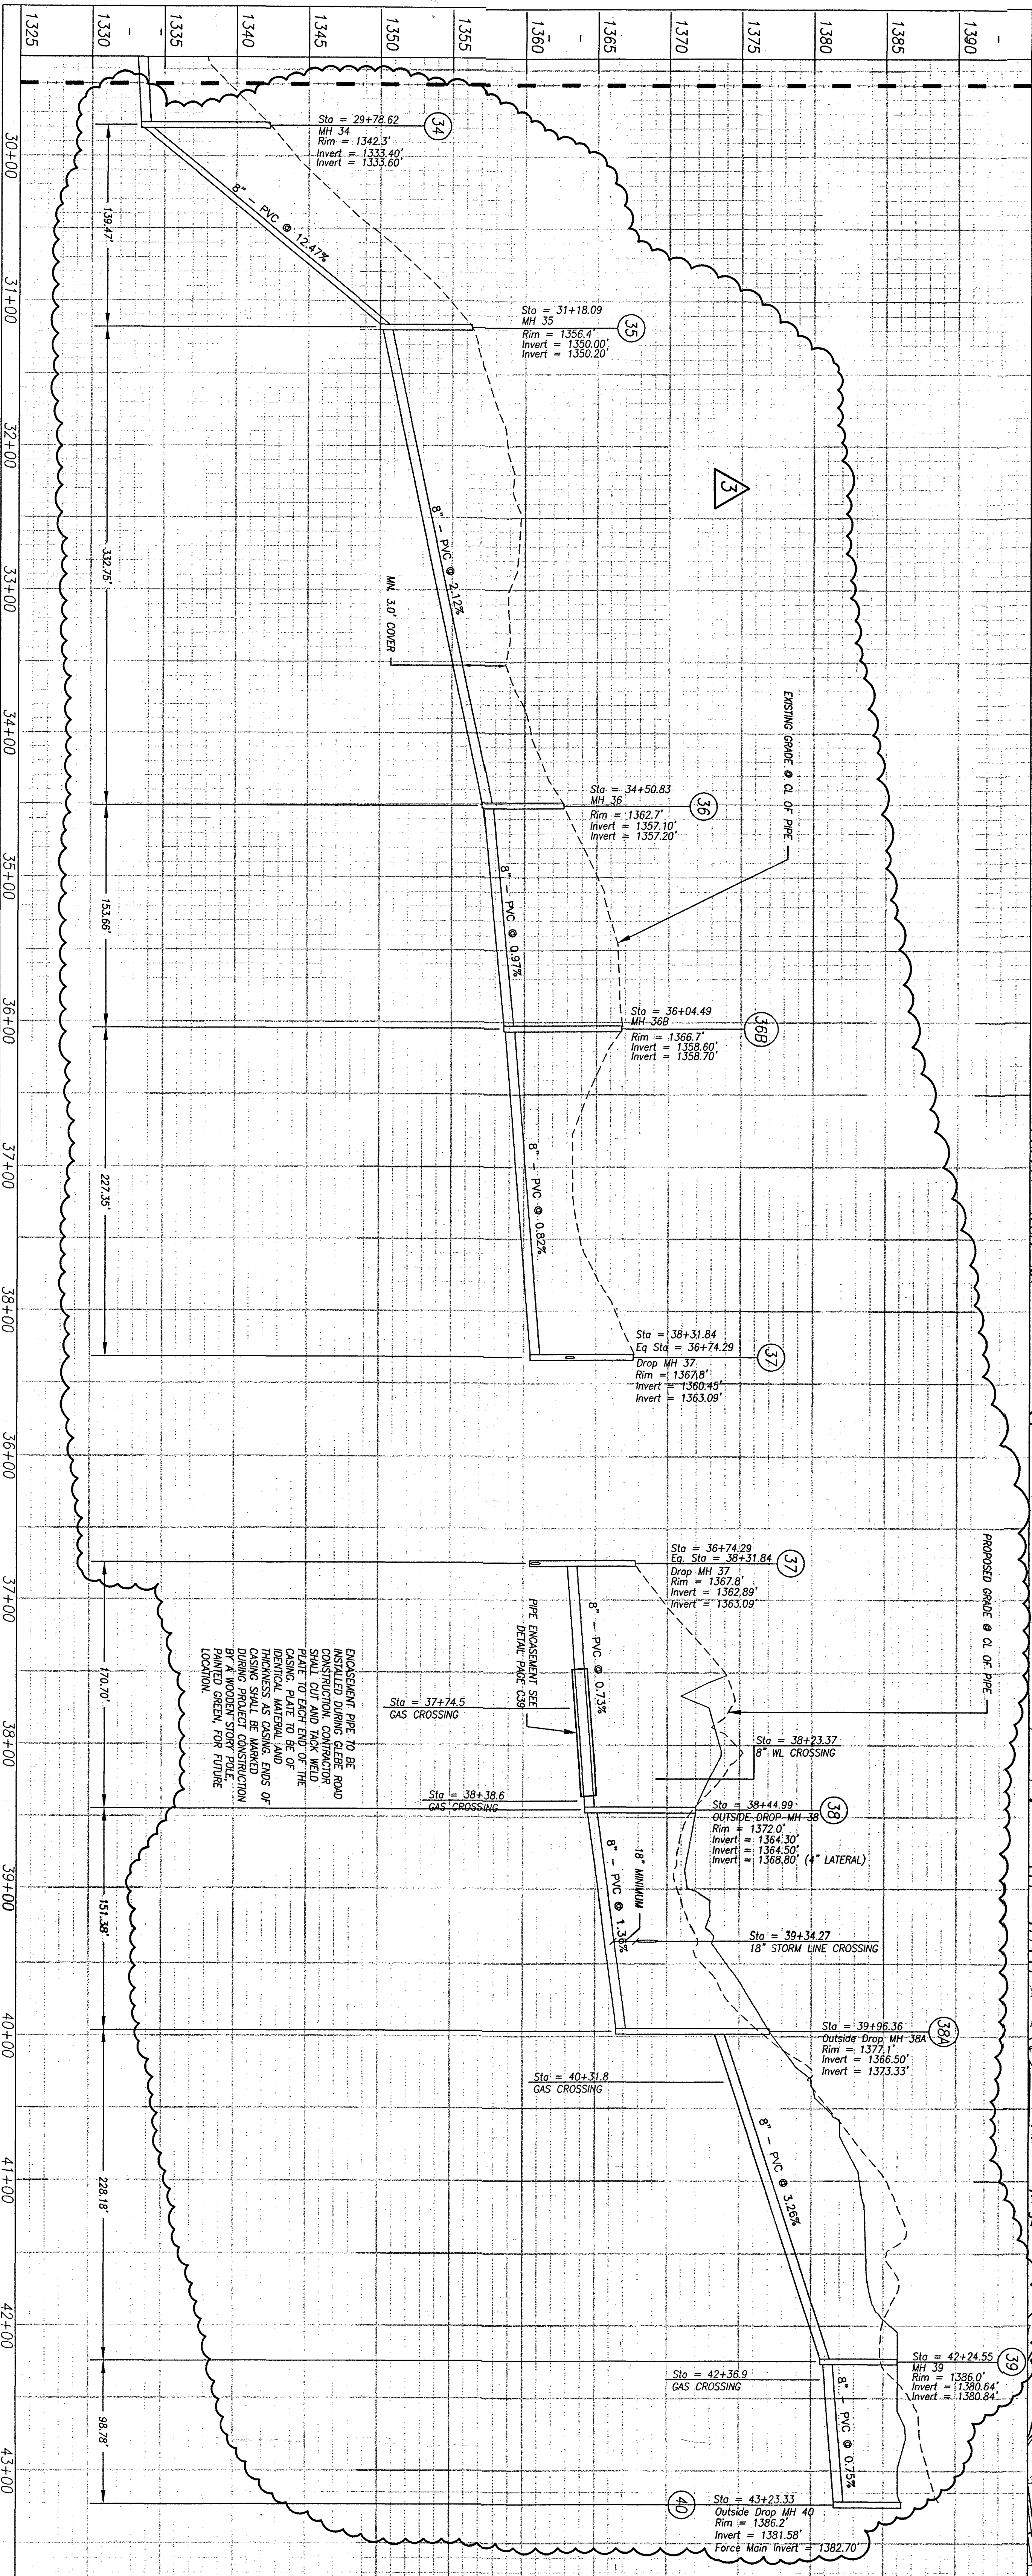


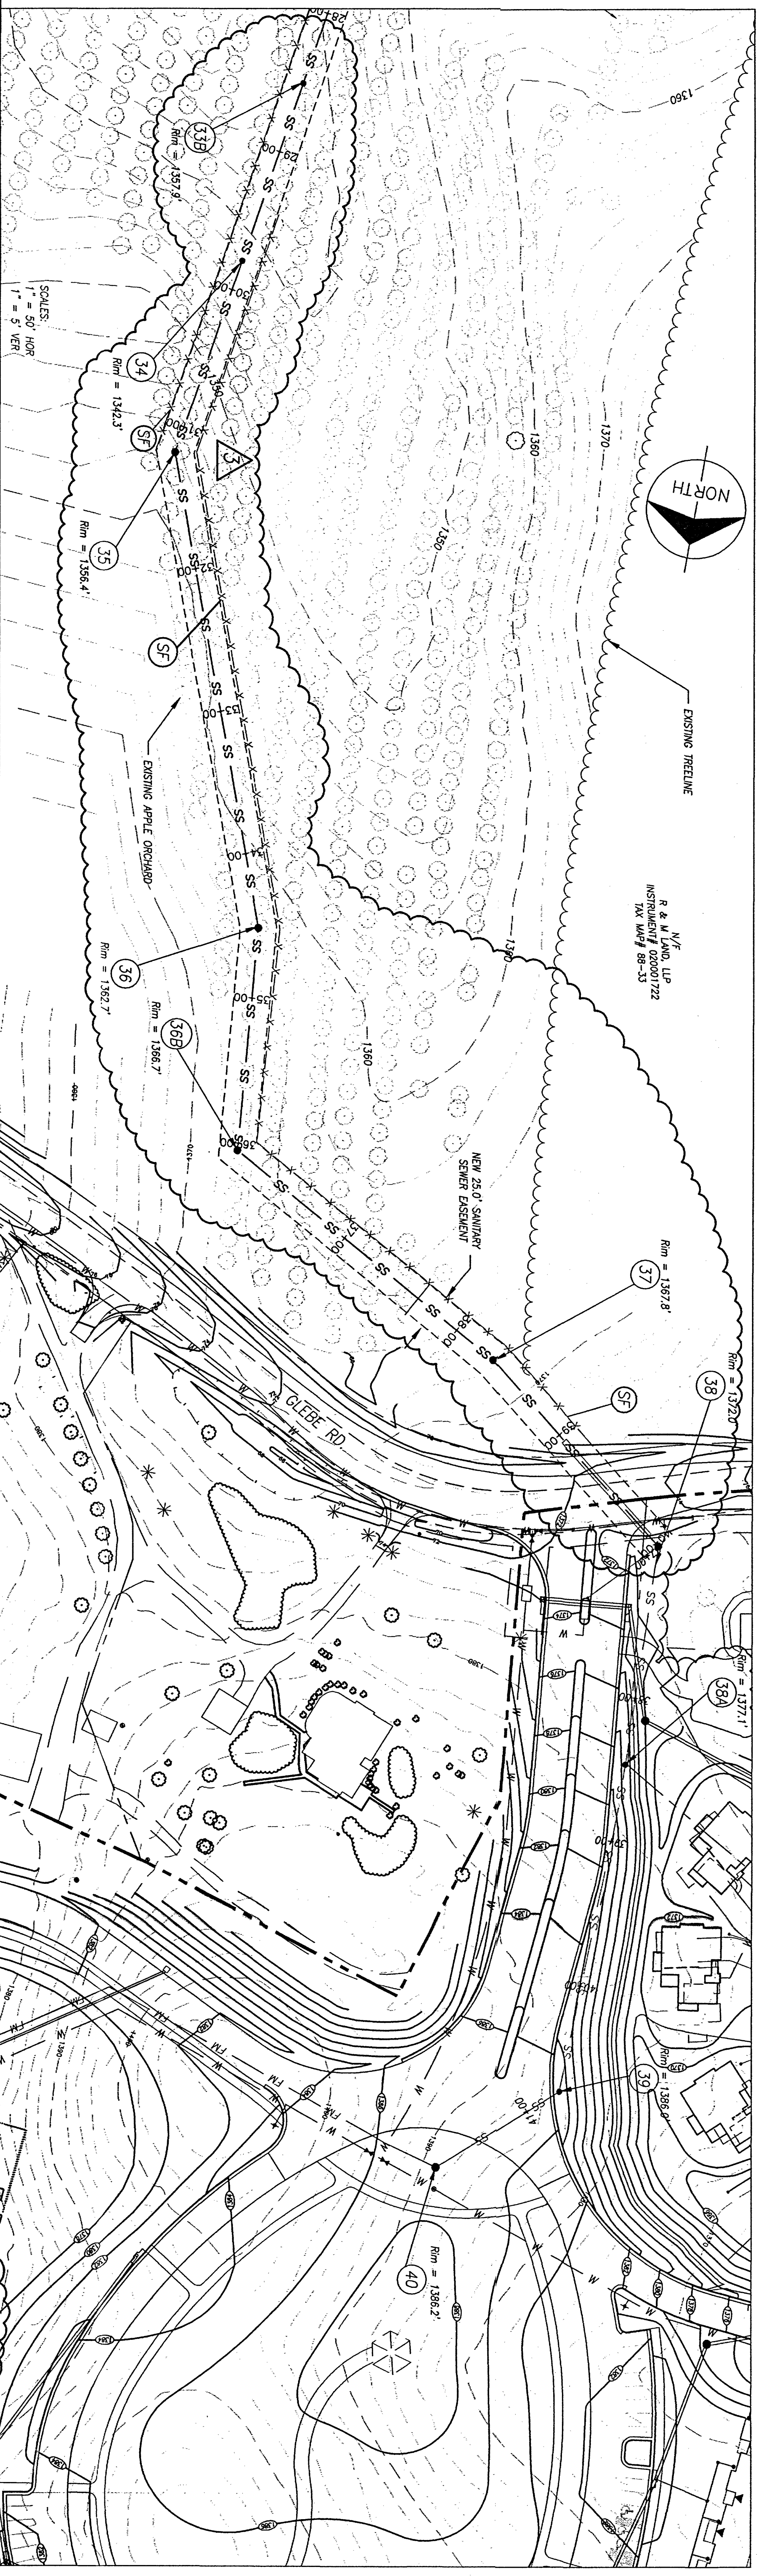

NOTE:  
EXCAVATED MATERIAL SHALL BE  
INSTALLED IN TRENCH SHALL BE  
SHALL BE ON THE DOWNHILL SIDE  
OF THE TRENCH.

|              |
|--------------|


|           |         |
|-----------|---------|
| COMAL NO. | DATE    |
| 9715.00   | 11/2/03 |
| DRAWING   | SHEET   |
| C43       | SD375   |
| 43        | OF 43   |

|                      |                                    |
|----------------------|------------------------------------|
| PROJECT DESIGNER     | : SFCs                             |
| PROJECT ARCHITECT    | : SFCs                             |
| PROJECT ENGINEER     | : ECI                              |
| DRAWN BY             | : ECI                              |
| CHECKED BY           | : ECI                              |
| APPROVED BY          | : ECI                              |
| REVISION DESCRIPTION | : DATE                             |
| 1                    | BOT CO REQUESTED CHANGES 9/4/03    |
| 2                    | REVISIONS PER BOT. CO. 11/12/03    |
| 3                    | REVISIONS SEWER ALIGNMENT 09/14/04 |

**SFCs**  
SFCs Inc. • 305 South Jefferson Street  
Roanoke, Virginia 24011-2003  
540.344.6664 • Fax 540.343.6925  
www.sfc.com

**The Glebe**

PROJECT TITLE

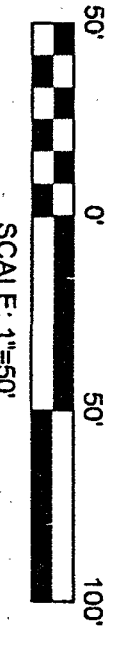

GENERAL NOTES

ECI PROJECT #00019

