

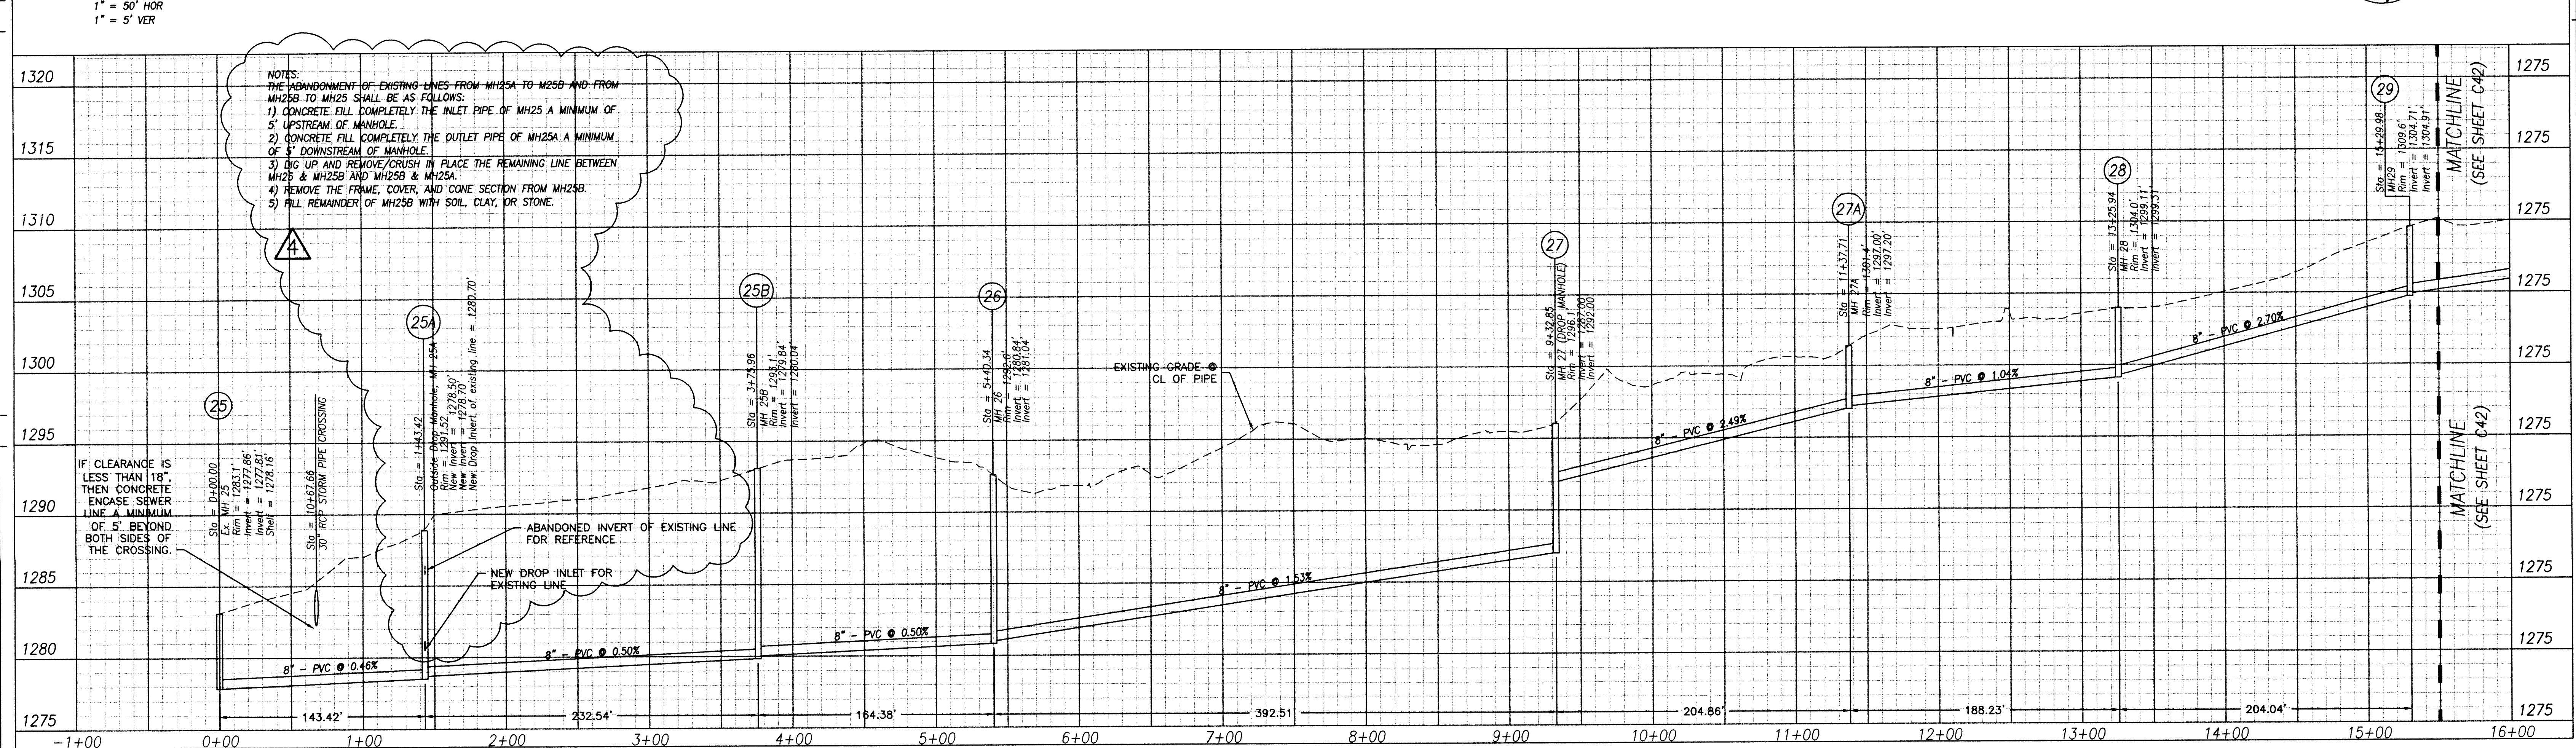


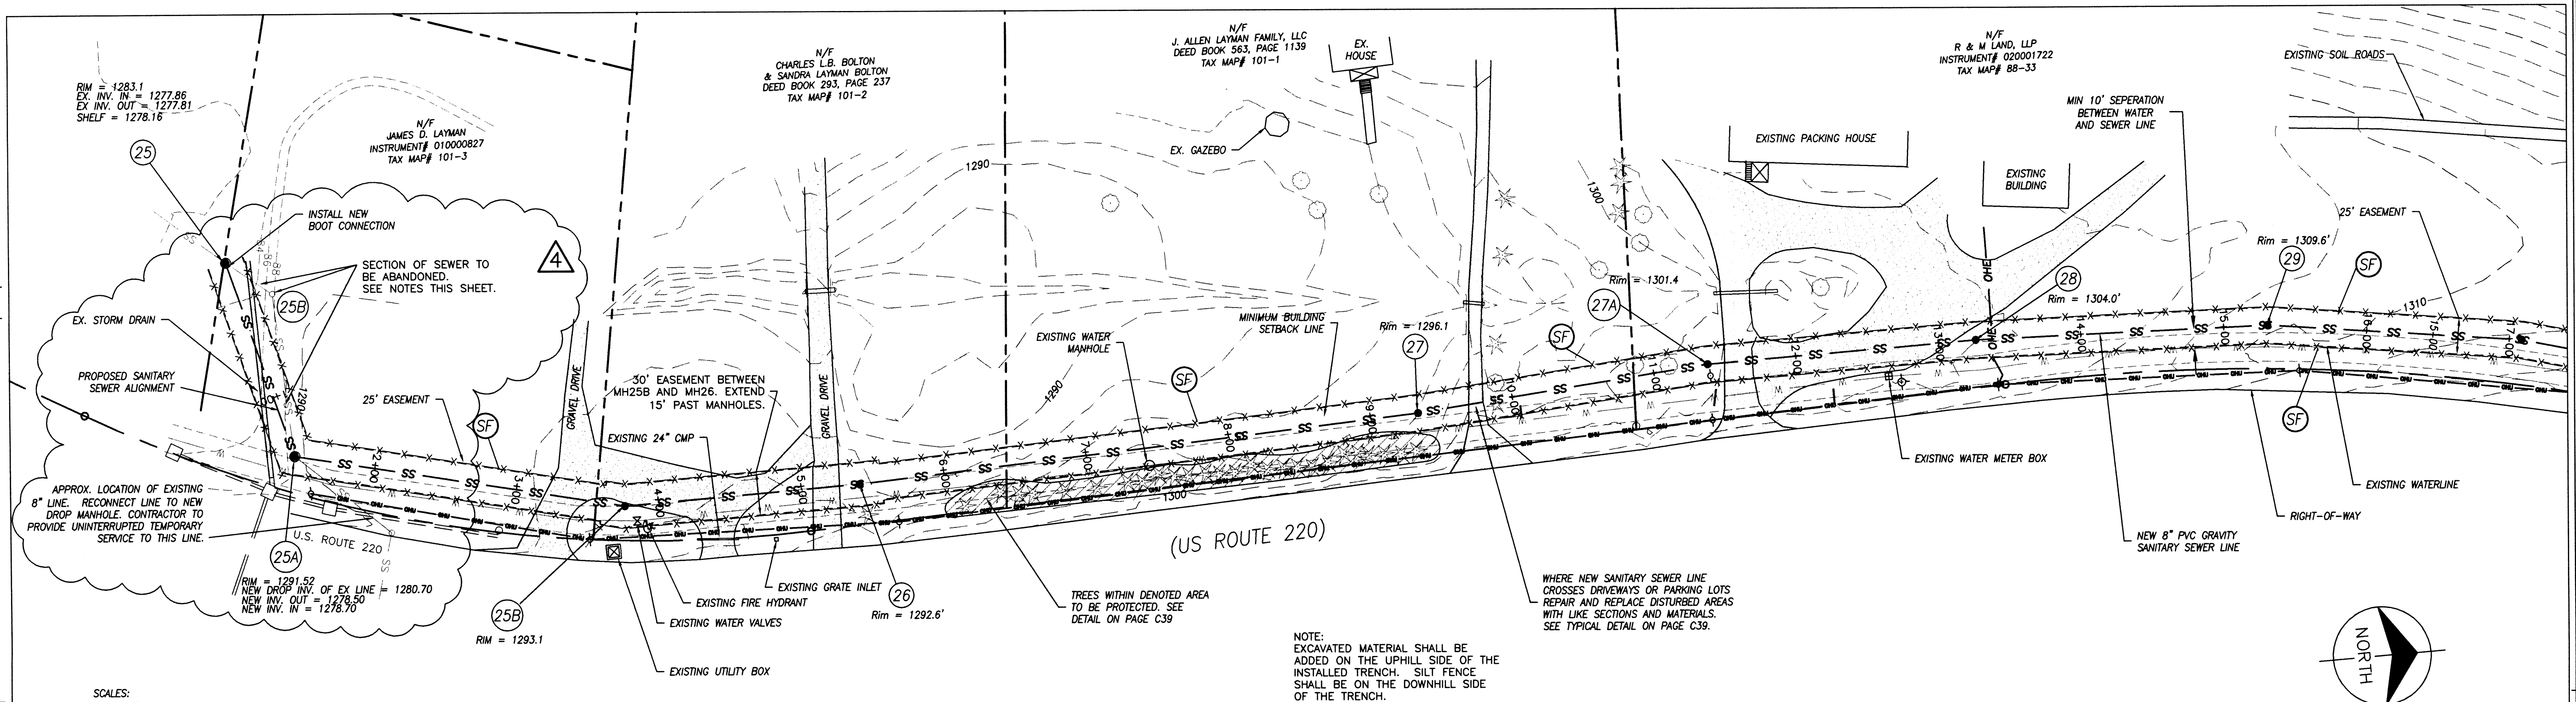


NOTES:
THE ABANDONMENT OF EXISTING LINES FROM MH25A TO MH25B AND FROM MH25B TO MH25C SHALL BE AS FOLLOWS:
1) CONCRETE FILL COMPLETELY THE INLET PIPE OF MH25A A MINIMUM OF 5' UPSTREAM OF MANHOLE.
2) CONCRETE FILL COMPLETELY THE OUTLET PIPE OF MH25A A MINIMUM OF 5' DOWNSTREAM OF MANHOLE.
3) DIG UP AND REMOVE/CRUSH IN PLACE THE REMAINING LINE BETWEEN MH25B & MH25C AND MH25C & MH25A.
4) REMOVE THE FRAME, COVER, AND CONE SECTION FROM MH25B.
5) FILL REMAINDER OF MH25B WITH SOIL, CLAY, OR STONE.

IF CLEARANCE IS LESS THAN 18" THEN CONCRETE ENCASE SEWER LINE A MINIMUM OF 5' BEYOND BOTH SIDES OF THE CROSSING.

SLOPE CALCULATION NOTE:
ALL PIPE SLOPES ARE CALCULATED FROM INSIDE FACE OF MANHOLE TO INSIDE FACE OF MANHOLE.

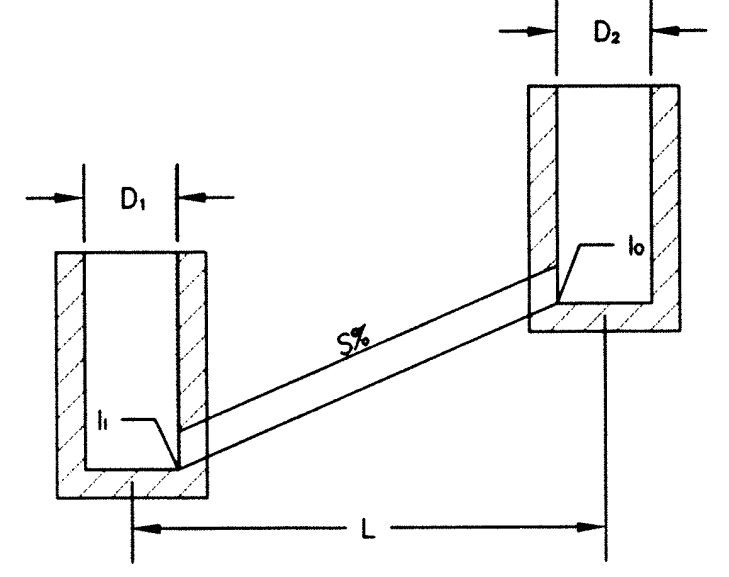

NOTES:
2. STEPS TO BE VERTICALLY ALIGNED.
4. TOP INVERT LINE SHALL NOT ENTER THROUGH RISER (CONE) SECTION OR BARREL SEGMENT JOINTS.

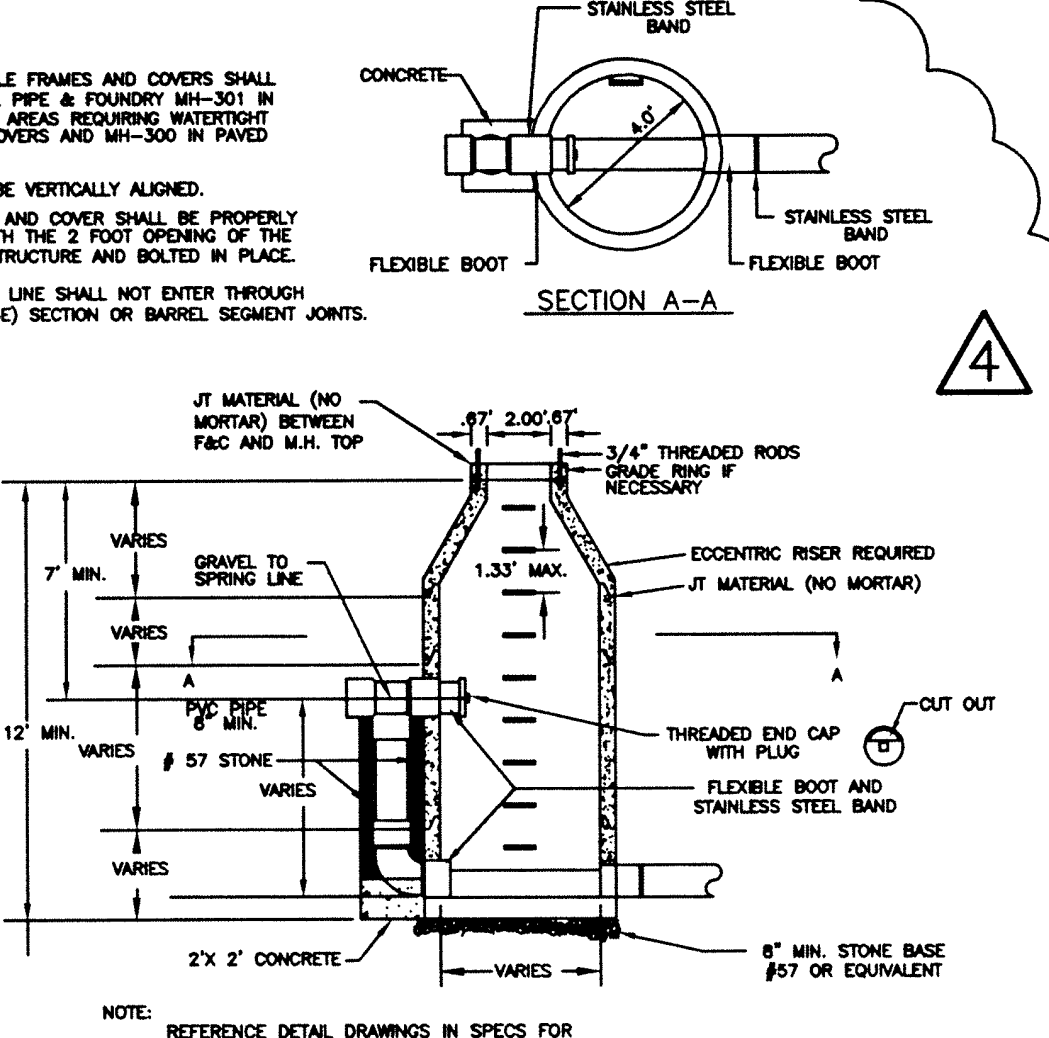


NOTE: REFERENCE DETAIL DRAWINGS IN SPECS FOR DROP CONNECTION USING DUCTILE IRON PIPE.



20 South Roanoke St.
Fincastle, Virginia 24090
540.473.1253 540.473.1254 (Fax)
email@engineeringconcepts.com
ECI PROJECT #02019

GENERAL NOTES

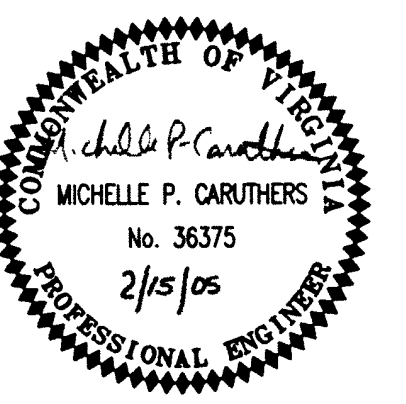

50' 0' 50' 100'
SCALE: 1"=50'

PROJECT TITLE

The Glebe

SFCs Architecture
Engineering
Planning
Interiors
SFCs Inc. • 305 South Jefferson Street
Roanoke, Virginia 24011.2003
540.344.6664 • Fax 540.343.6925
www.sfc.com

PROJECT DESIGNER	: SFCs
PROJECT ARCHITECT	: SFCs
PROJECT ENGINEER	: ECI
DRAWN BY	: ECI
CHECKED BY	: ECI
APPROVED BY	: ECI
NO.	REVISION DESCRIPTION DATE
1	REVISIONS PER BOT. CO. 11/12/03
2	SEWER ALIGNMENT REVISIONS 9/14/04
3	SEWER ALIGNMENT REVISIONS 2/09/05
4	SEWER ALIGNMENT REVISIONS 2/15/05

**OFFSITE GRAVITY
SANITARY SEWER
PLAN & PROFILE**

COMM. NO.	91115.00	DATE	11/12/03
DRAWING		SHEET	

C41