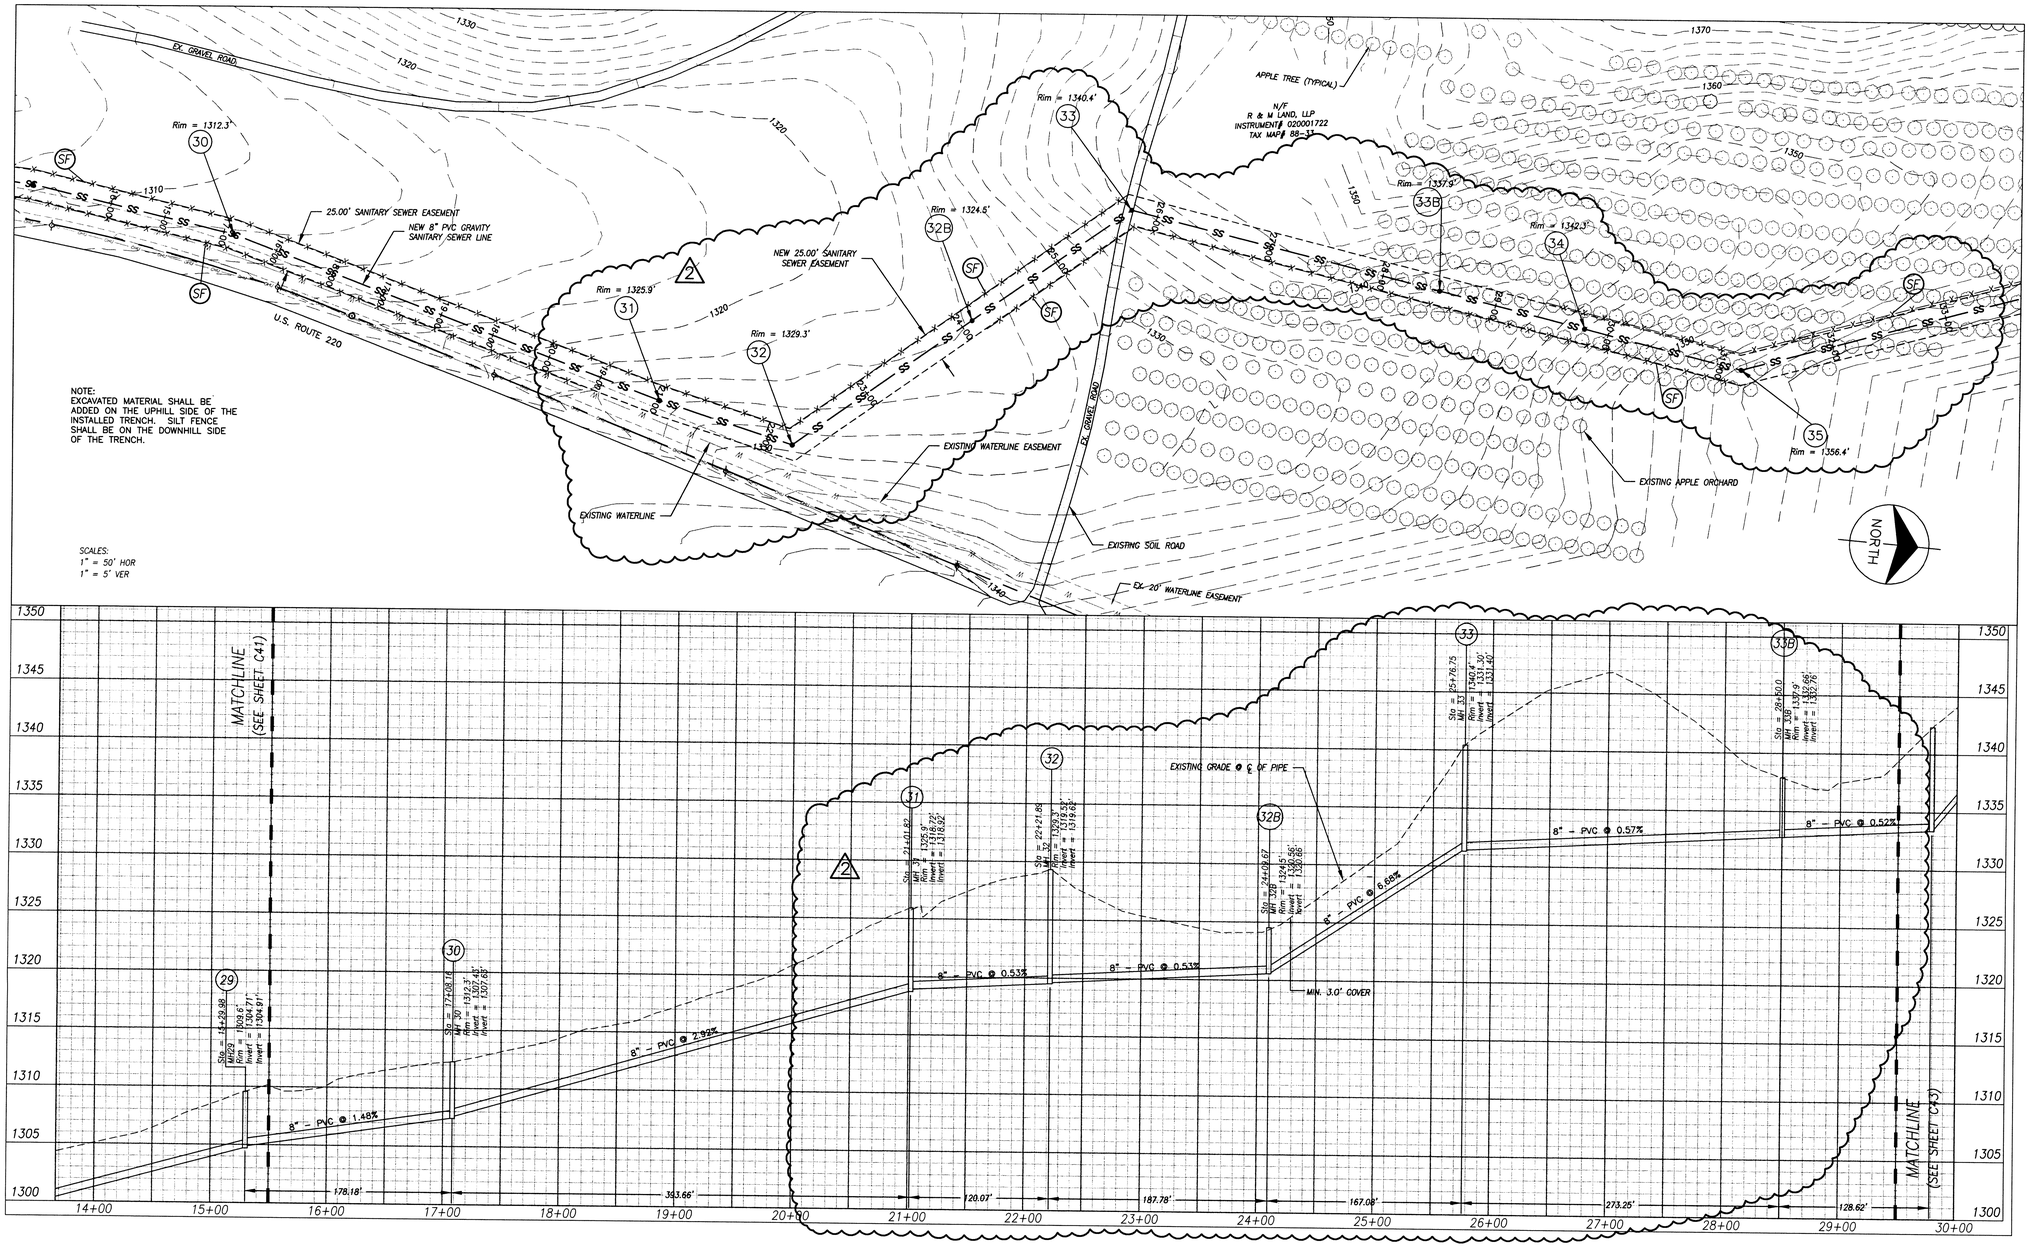

MENU

CADD VERSION	ACADR-14
PLOT SCALE	1:1
PLOT DATE	
COMM NO.	
DRAWING NO.	

SLOPE CALCULATION NOTE:

ALL PIPE SLOPES ARE CALCULATED FROM INSIDE FACE OF MANHOLE TO INSIDE FACE OF MANHOLE.

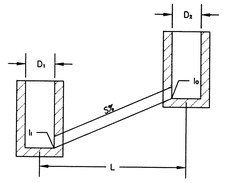

$S\% = (I_u - I_l)/(L - D_u/2 - D_l/2)$

KEYPLAN

20 South Roanoke St.
Fincastle, Virginia 24090
540.473.1253 540.473.1254(Fax)
email@engineeringconcepts.com
ECI PROJECT #02019

GENERAL NOTES

COMMONWEALTH OF VIRGINIA
MICHELLE P. CARUTHERS
No. 36375
9/14/04
PROFESSIONAL ENGINEER

50' 0' 50' 100'
SCALE: 1"=50'

PROJECT TITLE

The Glebe

SFCS Architecture Engineering Planning Interiors
SFCS Inc. • 305 South Jefferson Street
Roanoke, Virginia 24011.2003
540.344.6664 • Fax 540.343.6925
www.sfcs.com

PROJECT DESIGNER	: SFCS
PROJECT ARCHITECT	: SFCS
PROJECT ENGINEER	: ECI
DRAWN BY	: ECI
CHECKED BY	: ECI
APPROVED BY	: ECI

NO.	REVISION DESCRIPTION	DATE
1	REVISIONS PER BOT. CO.	11/12/03
2	REVISIONS SEWER ALIGNMENT	09/14/04

DRAWING TITLE

OFFSITE GRAVITY SANITARY SEWER PLAN & PROFILE

COMM. NO.	DATE
97115.00	11/12/03
DRAWING	SHEET
C42	42 OF 43