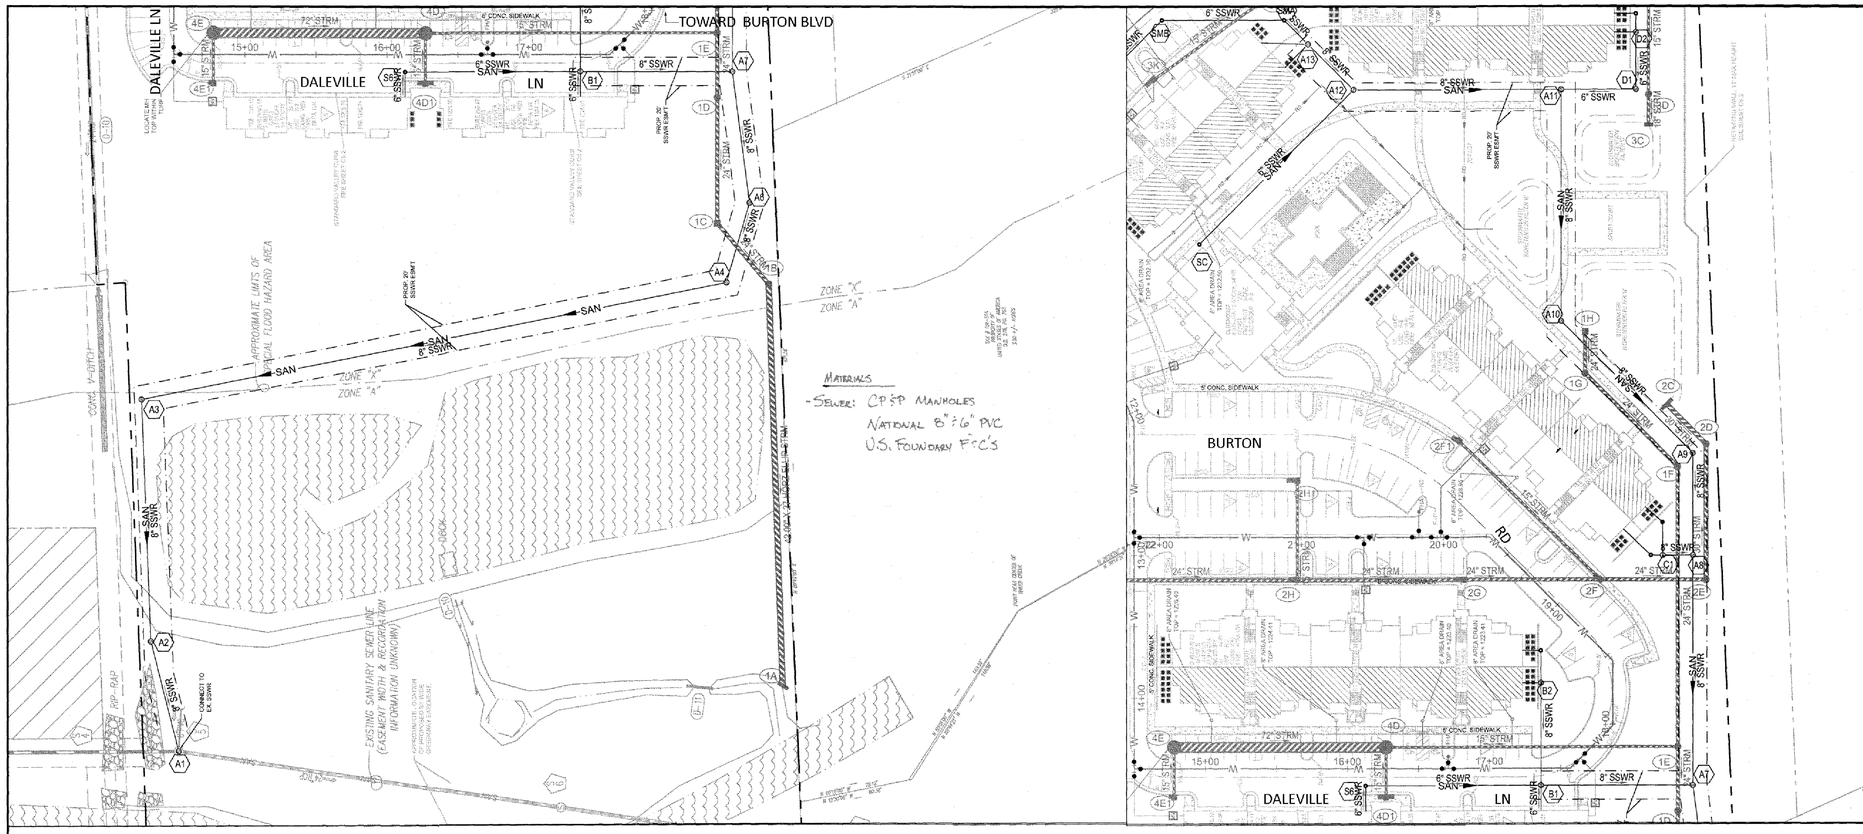

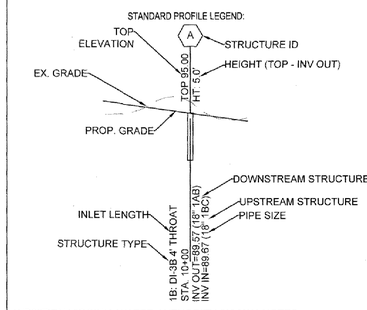

WESTERN VIRGINIA WATER AUTHORITY (WVWA) NOTES:

1. ALL CONSTRUCTION METHODS AND MATERIALS SHALL CONFORM TO THE LATEST WVWA DESIGN AND CONSTRUCTION STANDARDS.
2. THE CONTRACTOR OR DEVELOPER IS REQUIRED TO NOTIFY THE WVWA IN WRITING AT LEAST THREE (3) DAYS PRIOR TO ANY CONSTRUCTION. PLEASE CONTACT MARK SINK AT 537-3460.
3. ALL WORK SHALL BE SUBJECT TO INSPECTION BY THE WVWA.
4. FIELD CORRECTIONS SHALL BE APPROVED BY THE WVWA PRIOR TO SUCH CONSTRUCTION.
5. THE CONTRACTOR SHALL MAINTAIN A MINIMUM OF 18" CLEARANCE VERTICALLY AND 2' MINIMUM HORIZONTALLY FROM OUTSIDE OF PIPE TO OUTSIDE OF PIPE AT ALL WATER, SANITARY SEWER CROSSINGS OF ANY OTHER UTILITIES. WHERE THIS CANNOT BE ACHIEVED ADDITIONAL MEASURES IN ACCORDANCE WITH WVWA STANDARDS SHALL BE ENFORCED.
6. ANY EXISTING APPURTENANCES SHOULD BE ADJUSTED TO GRADE AND NEW FRAME AND COVERS INSTALLED WHERE REQUIRED.
7. IT IS THE CONTRACTOR'S RESPONSIBILITY TO HAVE ALL EXISTING UTILITIES LOCATED AND POTHOLED TO VERIFY LOCATIONS. THIS PLAN REVIEW DOES NOT REMOVE THE CONTRACTOR'S RESPONSIBILITY TO RELOCATE ANY EXISTING CONFLICTS FOUND DURING CONSTRUCTION.

SEWER NOTES:

1. ALL SANITARY SEWER CONNECTIONS TO EXISTING LINES SHALL BE COORDINATED WITH AND PERFORMED BY THE WVWA.
2. ALL WATER AND SANITARY SEWER FACILITIES ARE TO BE INSTALLED ACCORDING TO THE WVWA DESIGN AND CONSTRUCTION STANDARDS.
3. SANITARY SEWER TAP TO EXISTING MANHOLE TO BE MADE BY CONTRACTOR. MANHOLE CONNECTION MUST BE CORED WITH A BOOT INSTALLED.
4. ALL MANHOLE ARE 48" IN DIAMETER UNLESS OTHERWISE NOTED.

NAD 83

SCALE 1"=30'

0 30' 60'

PLAN VIEW
(FOR REFERENCE ONLY)

0 5
0 50
PROFILE SCALE

COMMONWEALTH OF VIRGINIA
CLINT W. SHIFFLETT
Lic. No. 54380
9/7/18
PROFESSIONAL ENGINEER

THIS DRAWING PREPARED AT THE
CHARLOTTESVILLE OFFICE
608 Preston Avenue, Suite 200 | Charlottesville, VA 22903
TEL 434.295.5624 FAX 434.295.8317 www.timmons.com

YOUR VISION ACHIEVED THROUGH OURS.

DATE	REVISION DESCRIPTION
2018-09-07	REVISED PER COMMENTS

DATE	2018-05-23
DRAWN BY	J WILSON
DESIGNED BY	J WILSON
CHECKED BY	C SHIFFLETT
SCALE	AS SHOWN

TIMMONS GROUP

THE RESERVE AT DALEVILLE

BOTETOURT COUNTY, VA

SANITARY PROFILES

JOB NO. 40062

SHEET NO. C7.1

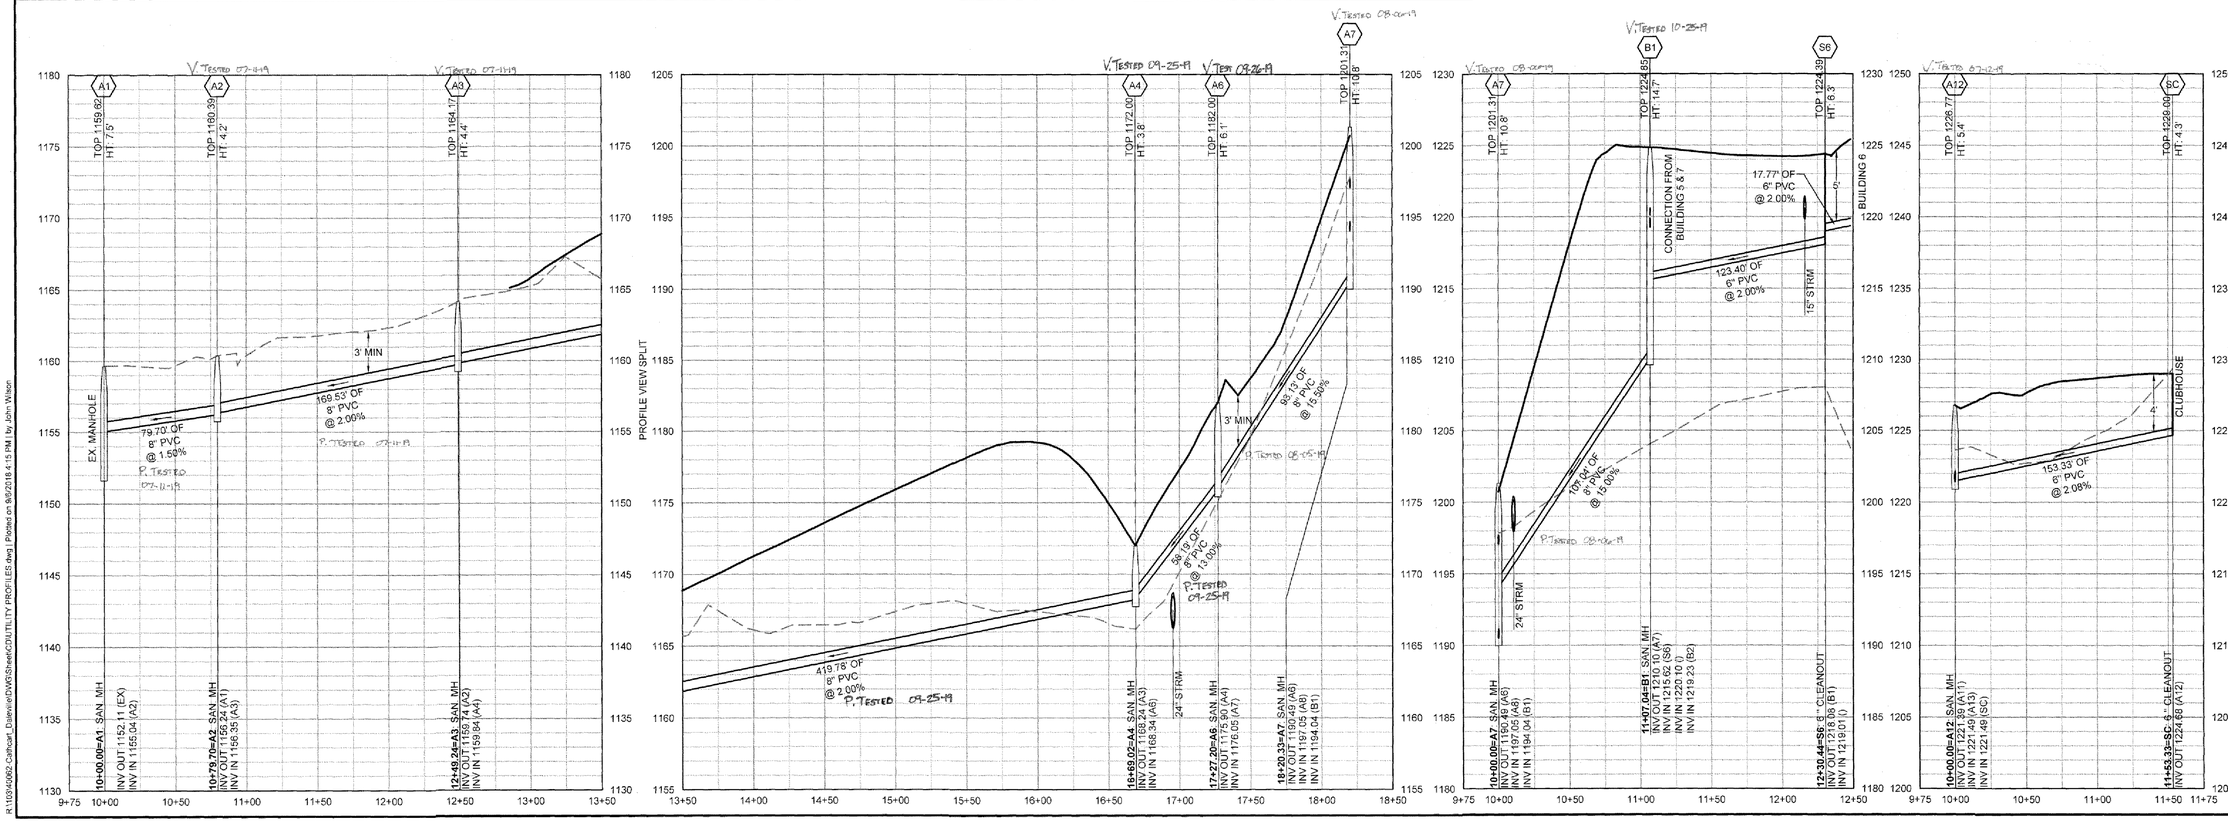

These plans and other data, documents and the application thereto of TIMMONS GROUP and may not be reproduced in whole or in part and shall not be used for any purpose whatsoever, inclusive, but not limited to, construction, bidding, and/or construction staking, without the express written consent of TIMMONS GROUP.

R:\10340062-Cathcart_Daleville\DWG\Sheet\CD\UTILITY PROFILES.dwg | Plotted on 9/6/2018 4:15 PM | by: John Wilson